

SEE SHEET 2 FOR
INDEX OF SHEETS AND
LIST OF STANDARDS

STATE OF VERMONT AGENCY OF TRANSPORTATION



PROPOSED IMPROVEMENT BRIDGE PROJECT




TOWN OF ROCKINGHAM
COUNTY OF WINDHAM

ROUTE NO : VT 103 RURAL PRINCIPAL ARTERIAL NATIONAL HIGHWAY SYSTEM BRIDGE NO : 4

PROJECT LOCATION : 2.4 MILES NORTH OF JUNCTION US 5

PROJECT DESCRIPTION : REPLACE EXISTING 6' CORRUGATED METAL PIPE CULVERT WITH 14' X 8' CONCRETE BOX CULVERT WITH NECESSARY APPROACH WORK. THE PROJECT ALSO INCLUDES REMOVAL OF AN ADDITIONAL CULVERT WITHIN THE PROJECT LIMITS AND ASSOCIATED CHANNEL WORK.

LENGTH OF STRUCTURE : N/A
LENGTH OF ROADWAY : 125.00 FEET.
LENGTH OF PROJECT : 125.00 FEET.

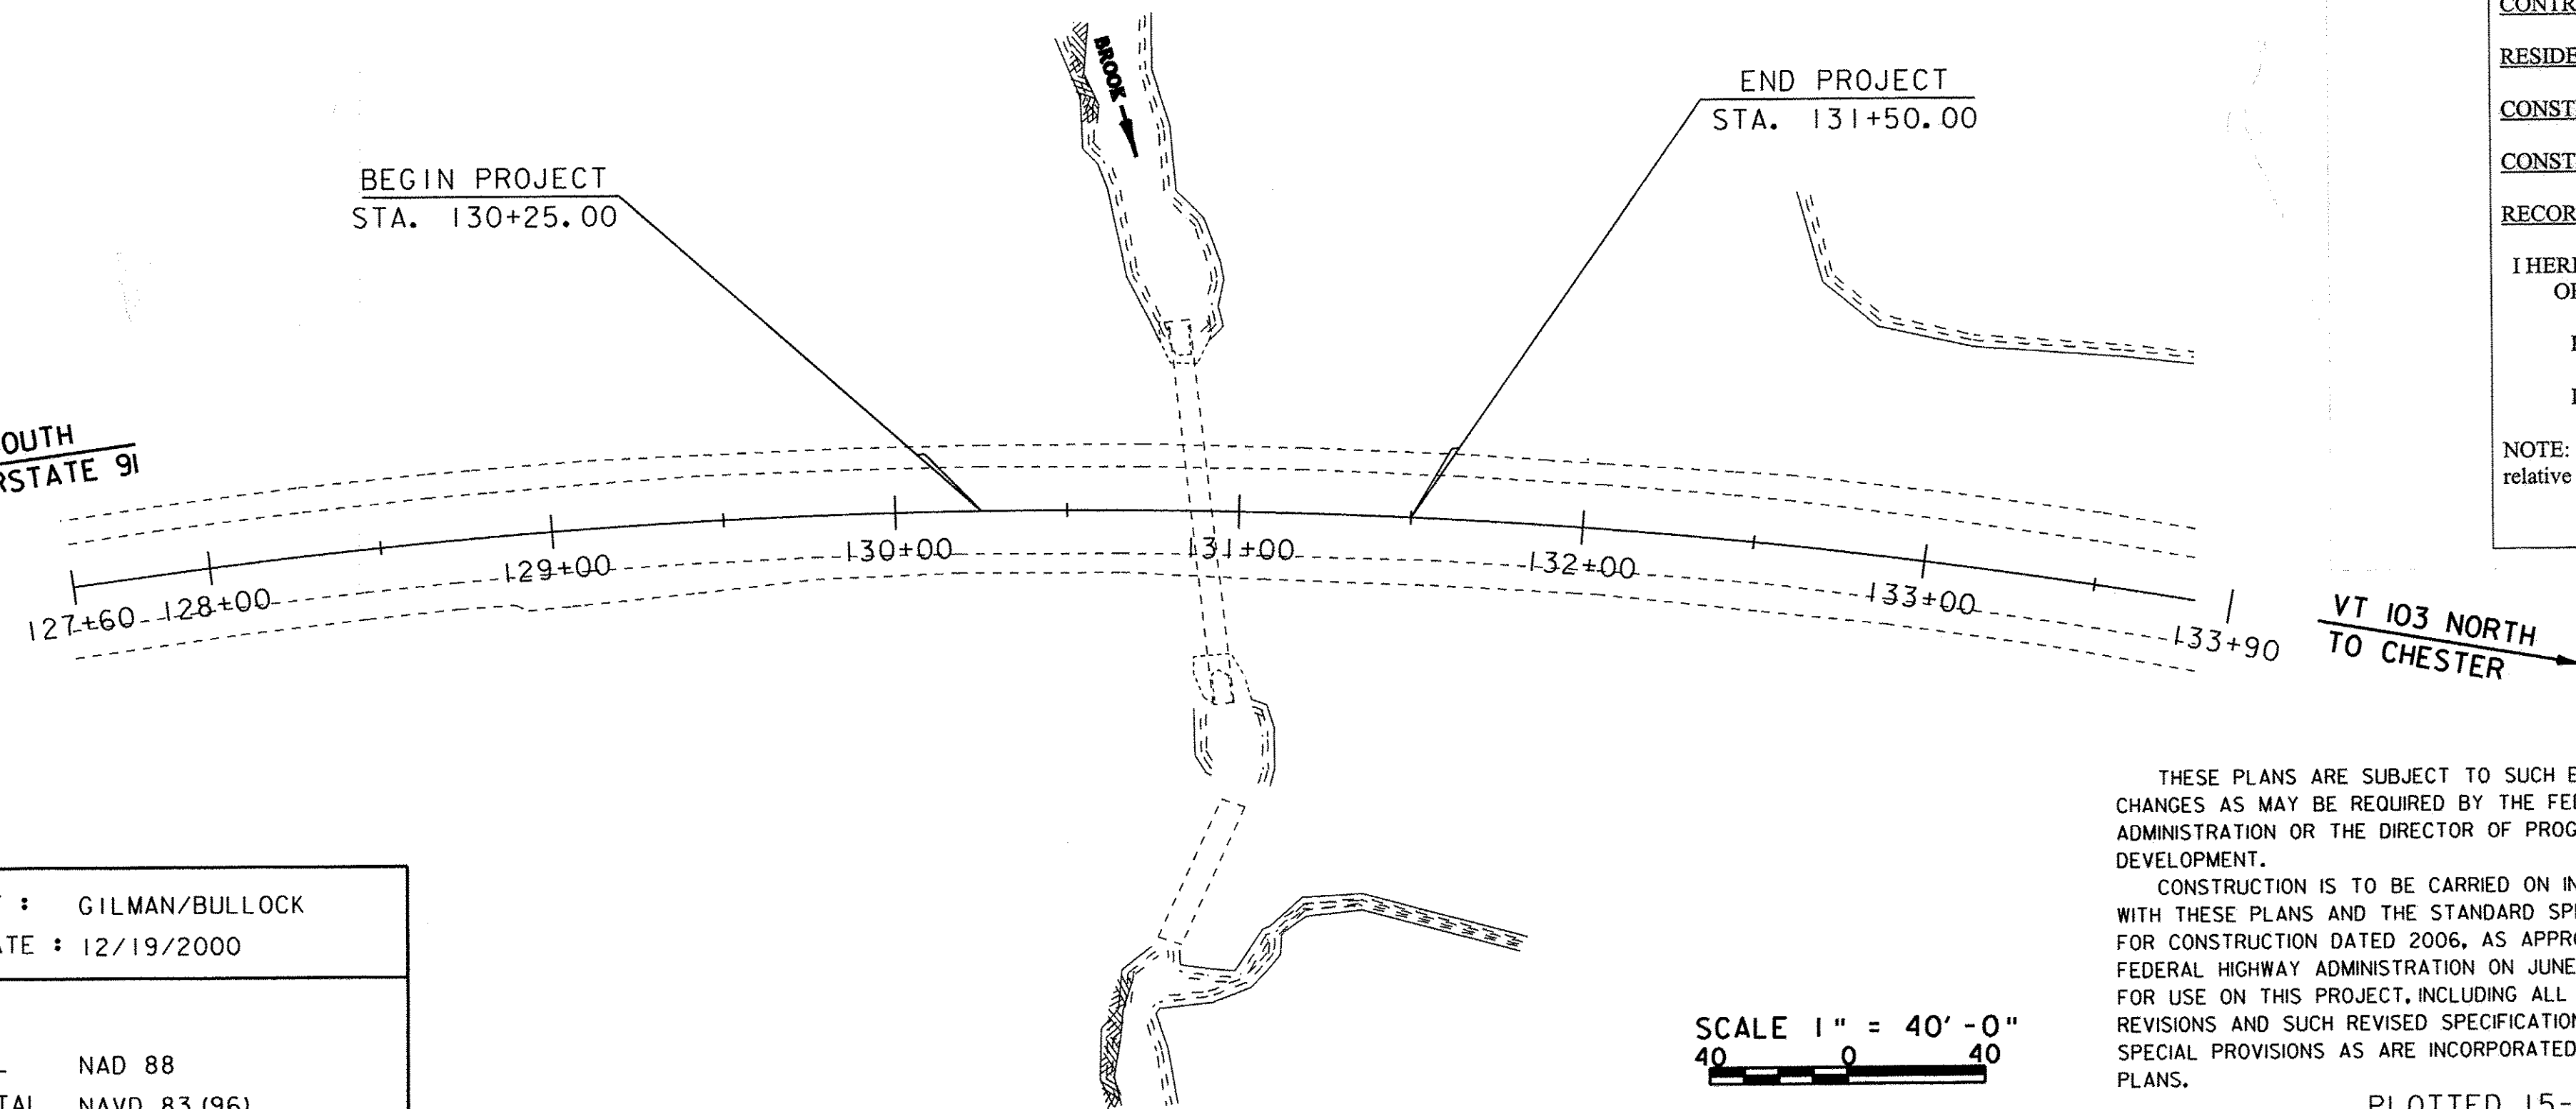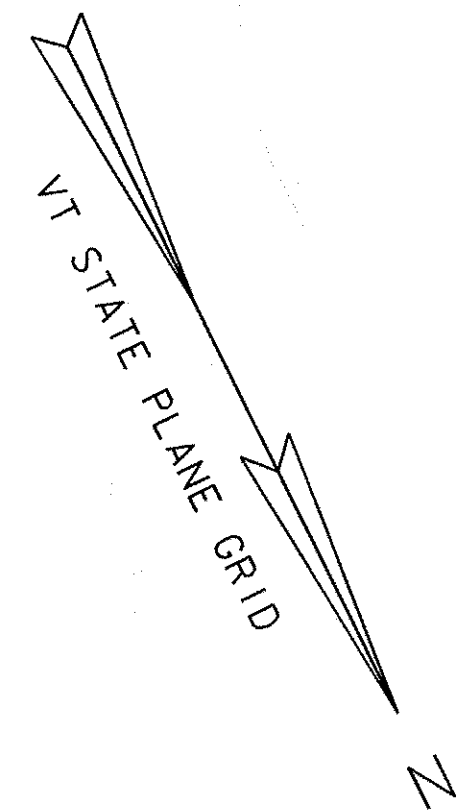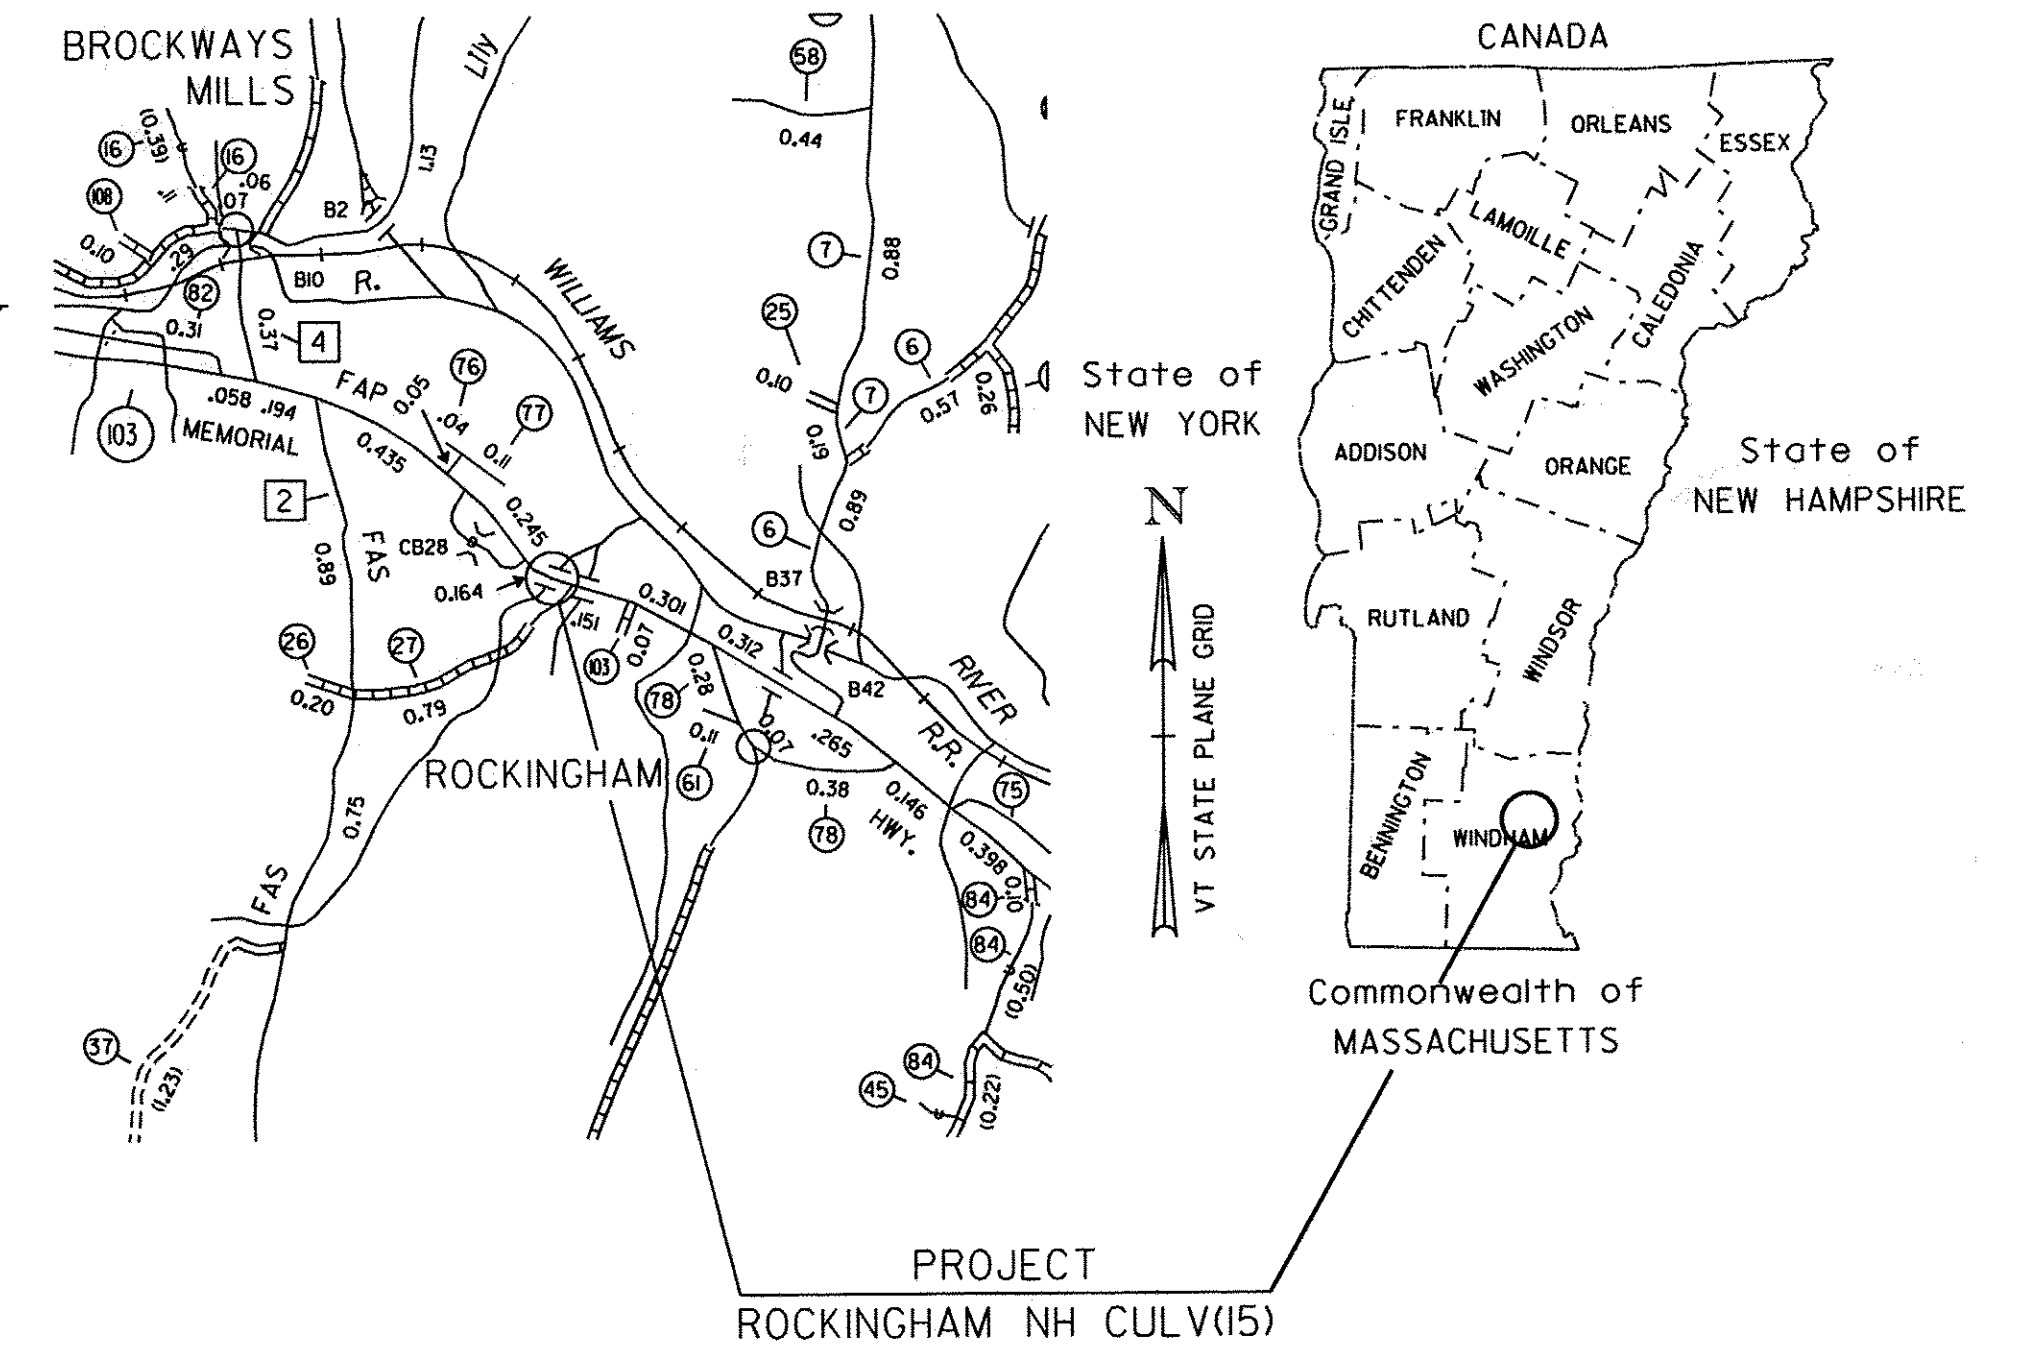

RECORD PLANS	
CONTRACTOR:	RENAUD BROTHERS, INC. - VERNON, VT
RESIDENT ENGINEER:	BUTCH COLBY
CONSTRUCTION BEGAN:	AUGUST 20, 2009
CONSTRUCTION COMPLETE:	JUNE 2, 2010
RECORD PLANS BY:	BUTCH COLBY & AMOS KEMPTON
I HEREBY CERTIFY THAT ALL THE CONSTRUCTION REQUIRED BY THIS SET OF DRAWINGS HAS BEEN ACCOMPLISHED AS INDICATED HEREIN.	
BY:	<i>[Signature]</i> RESIDENT ENGINEER
DATE:	7/22/11
NOTE: Any further information concerning final quantities, amounts or other details relative to this project may be found at Central Files in the electronic archives.	

CONVENTIONAL SYMBOLS	
COUNTY LINE	
TOWN LINE	
LIMITS OF ACCESS	
POINT OF ACCESS	
FENCE LINE	
STONE WALL	
TRAVELED WAY	
GUARD RAIL	
RAILROAD	
SURVEY LINE	
CULVERT	
POWER POLE	
TELEPHONE POLE	
TREES	
CONTROL OF ACCESS	
PROPERTY LINE	
R.O.W. TAKING LINE	
SLOPE RIGHTS	
TOP OF CUT	
TOE OF SLOPE	

SURVEYED BY : GILMAN/BULLOCK
SURVEYED DATE : 12/19/2000
DATUM
VERTICAL NAD 88
HORIZONTAL NAVD 83 (96)

THESE PLANS ARE SUBJECT TO SUCH ENGINEERING CHANGES AS MAY BE REQUIRED BY THE FEDERAL HIGHWAY ADMINISTRATION OR THE DIRECTOR OF PROGRAM DEVELOPMENT.
CONSTRUCTION IS TO BE CARRIED ON IN ACCORDANCE WITH THESE PLANS AND THE STANDARD SPECIFICATIONS FOR CONSTRUCTION DATED 2006, AS APPROVED BY THE FEDERAL HIGHWAY ADMINISTRATION ON JUNE 15, 2006 FOR USE ON THIS PROJECT, INCLUDING ALL SUBSEQUENT REVISIONS AND SUCH REVISED SPECIFICATIONS AND SPECIAL PROVISIONS AS ARE INCORPORATED IN THESE PLANS.
PLOTTED 15-APR-2009

DIRECTOR OF PROGRAM DEVELOPMENT
APPROVED *[Signature]* DATE 4/15/09
PROJECT MANAGER : K. M. HIGGINS
PROJECT NAME : ROCKINGHAM
PROJECT NUMBER : NH CULV (15)
SHEET 1 OF 27 SHEETS

SCALE 1" = 40'-0"
40 0 40