


MATERIAL TOLERANCES
(IF USED ON PROJECT)

SURFACE	
- PAVEMENT (TOTAL THICKNESS)	+/- 1/4"
- AGGREGATE SURFACE COURSE	+/- 1/2"
SUBBASE	
	+/- 1"
SAND BORROW	
	+/- 1"

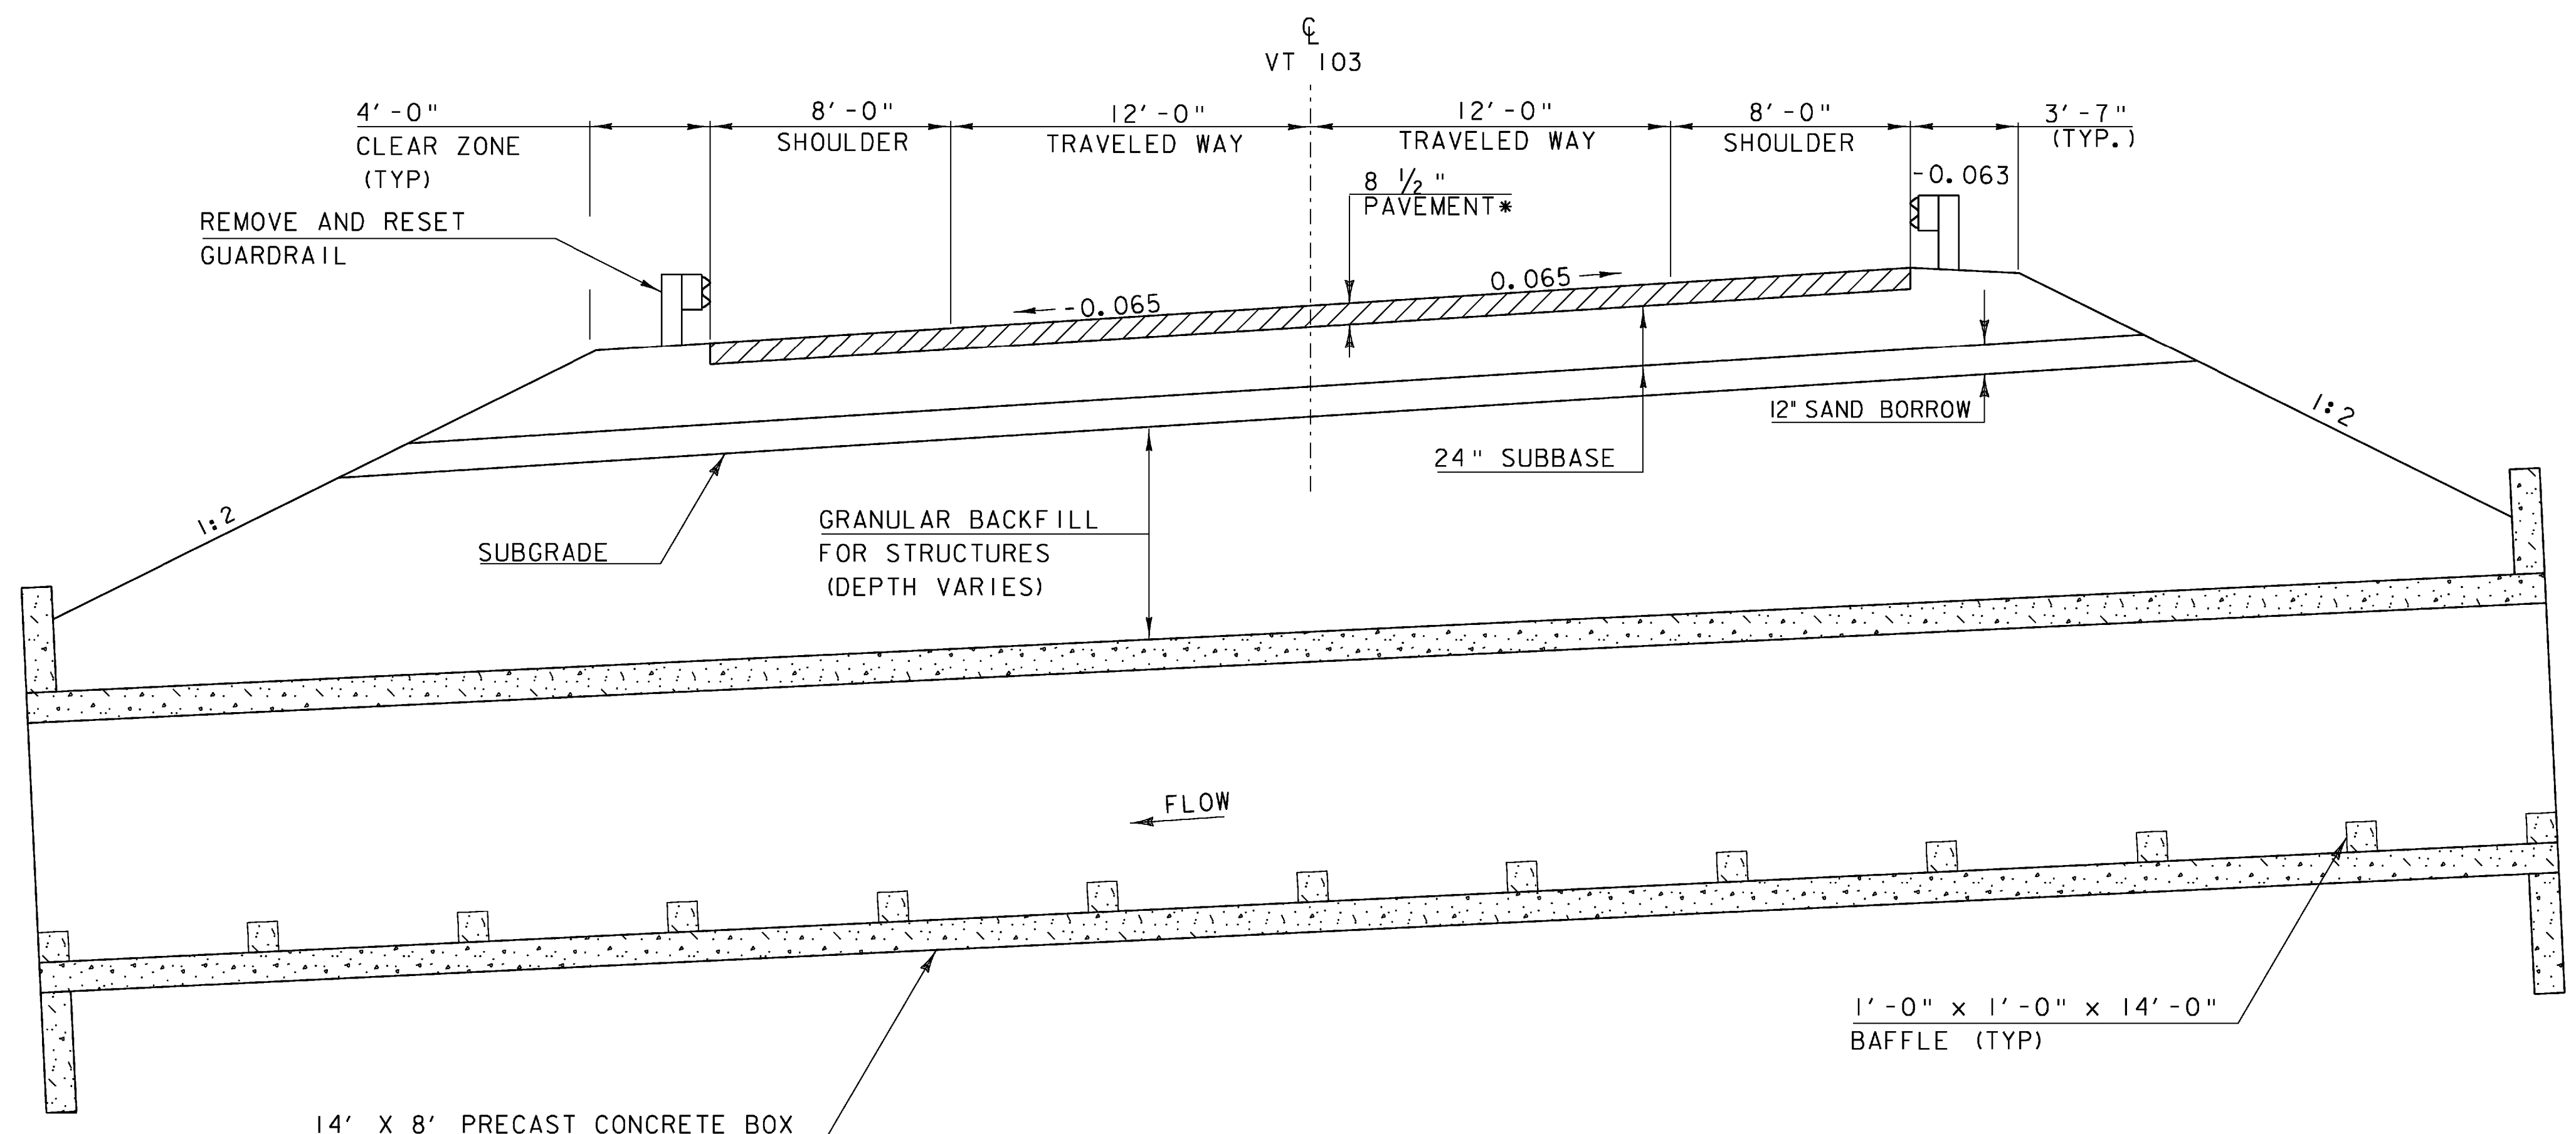


* 1 3/4" TYPE ~~IVS~~ SUPERPAVE BCP WEARING COURSE, OVER
 1 3/4" TYPE ~~IVS~~ SUPERPAVE BCP BINDER COURSE, OVER
 2 1/2" TYPE IIS SUPERPAVE BCP BASE COURSE, OVER
 2 1/2" TYPE IIS SUPERPAVE BCP BASE COURSE, OVER
 24" DENSE GRADED CRUSHED STONE SUBBASE, OVER
 12" SAND BORROW


BCP = BITUMINUS CONCRETE PAVEMENT AND SHALL BE PAID FOR UNDER ITEM 900.680 SPECIAL PROVISION (BITUMINUS CONCRETE PAVEMENT, SMALL QUANTITY)

NOTE: NUMBER OF GYRATION (N^{DESIGN}) = 75


TYPICAL ROADWAY SECTION
SCALE: 1/4" = 1'-0"

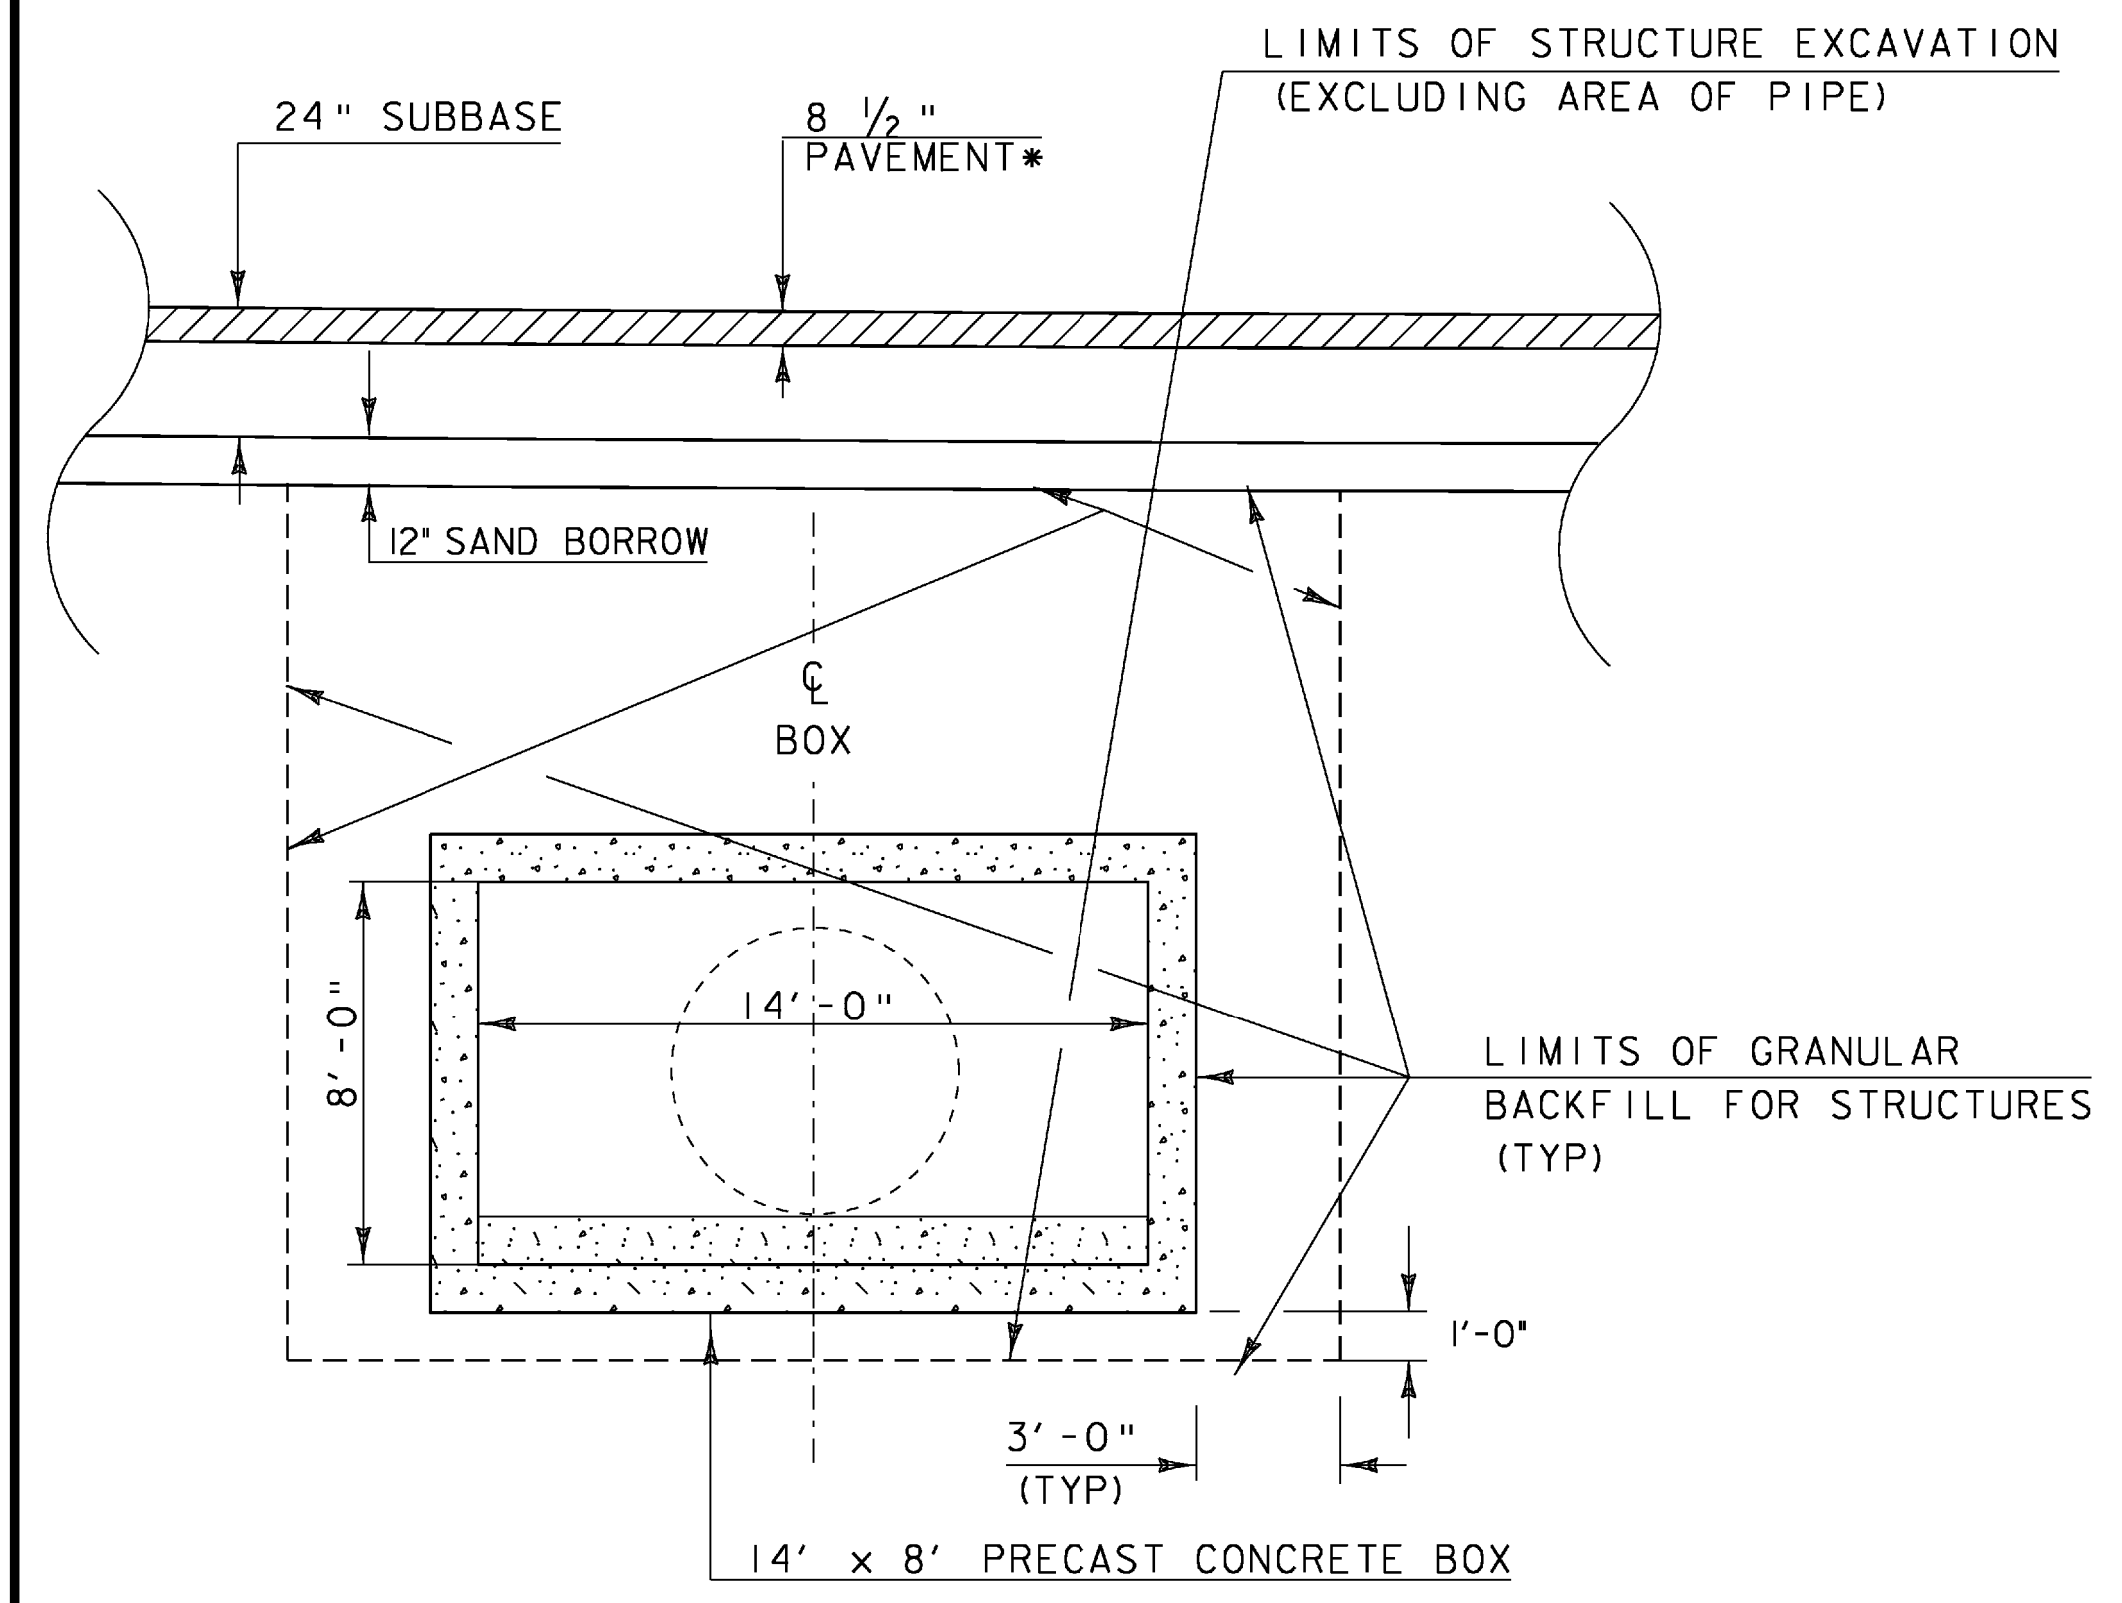

PROPOSED BOX CULVERT SECTION
SCALE: 1/4" = 1'-0"

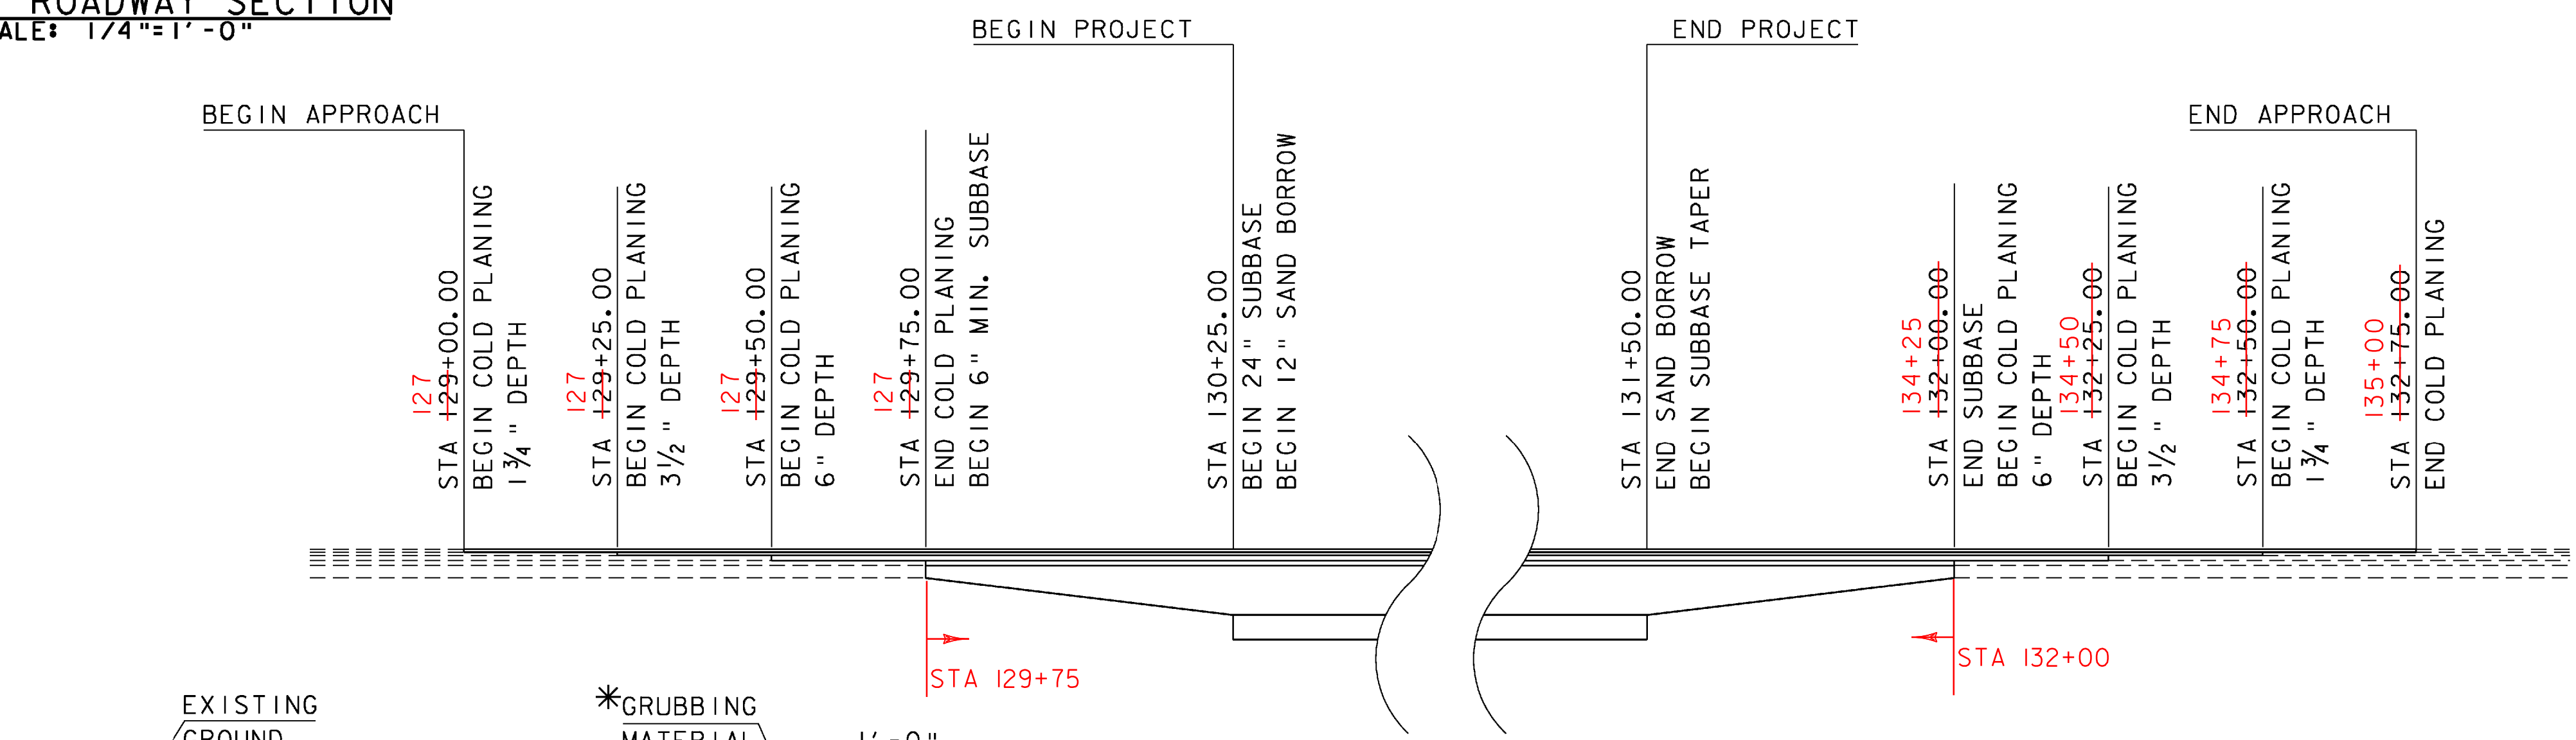


MATERIAL TRANSITION
NOT TO SCALE

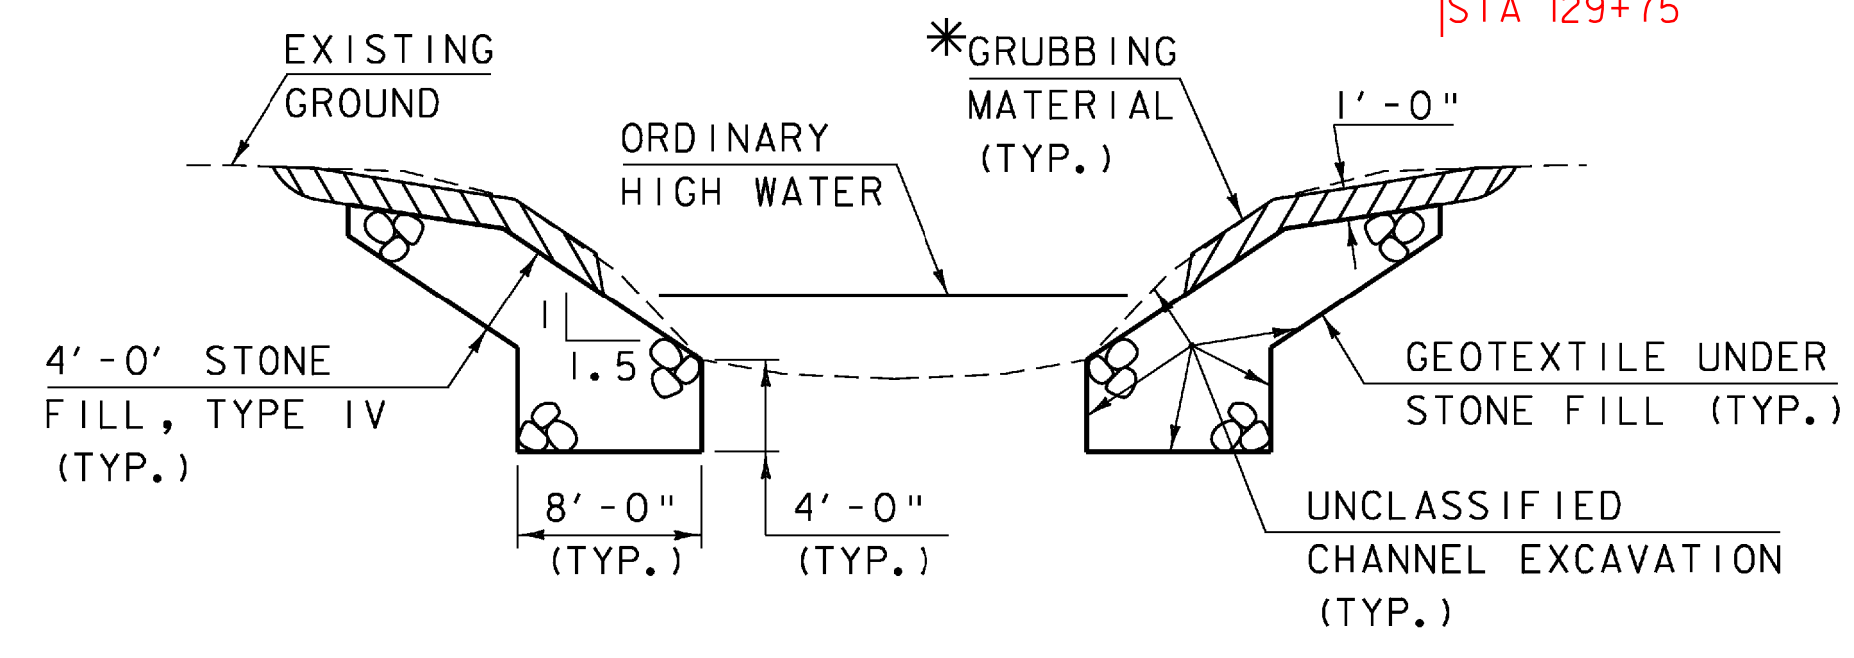

TYPICAL CHANNEL SECTION
(NOT TO SCALE)

*GRUBBING MATERIAL SHALL NOT BE PLACED ON THE STONE FILL IN THE AREA UNDER THE BRIDGE. WHENEVER CHANNEL SLOPE INTERSECTS ROADWAY SUBBASE, GRUBBING MATERIAL SHALL BEGIN AT THE BOTTOM OF SUBBASE.

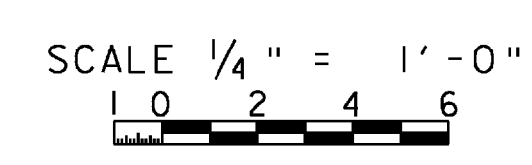

PROJECT NAME: ROCKINGHAM	PROJECT NUMBER: NH CULV(15)
DESIGN FILE NAME: M:\Projects\08b064\Structures\08b064typ.dgn	PLOT DATE: 13-MAY-2009
IPARM FILE NAME: s08b064typ.i	DRAWN BY: M.FESSEL
SQUAD LEADER: K.M.HIGGINS	CHECKED BY: J.SALVATORI
DESIGNED BY: J.SALVATORI	TYPICAL SECTIONS
	SHEET 6 OF 27