


BANKING DIAGRAM

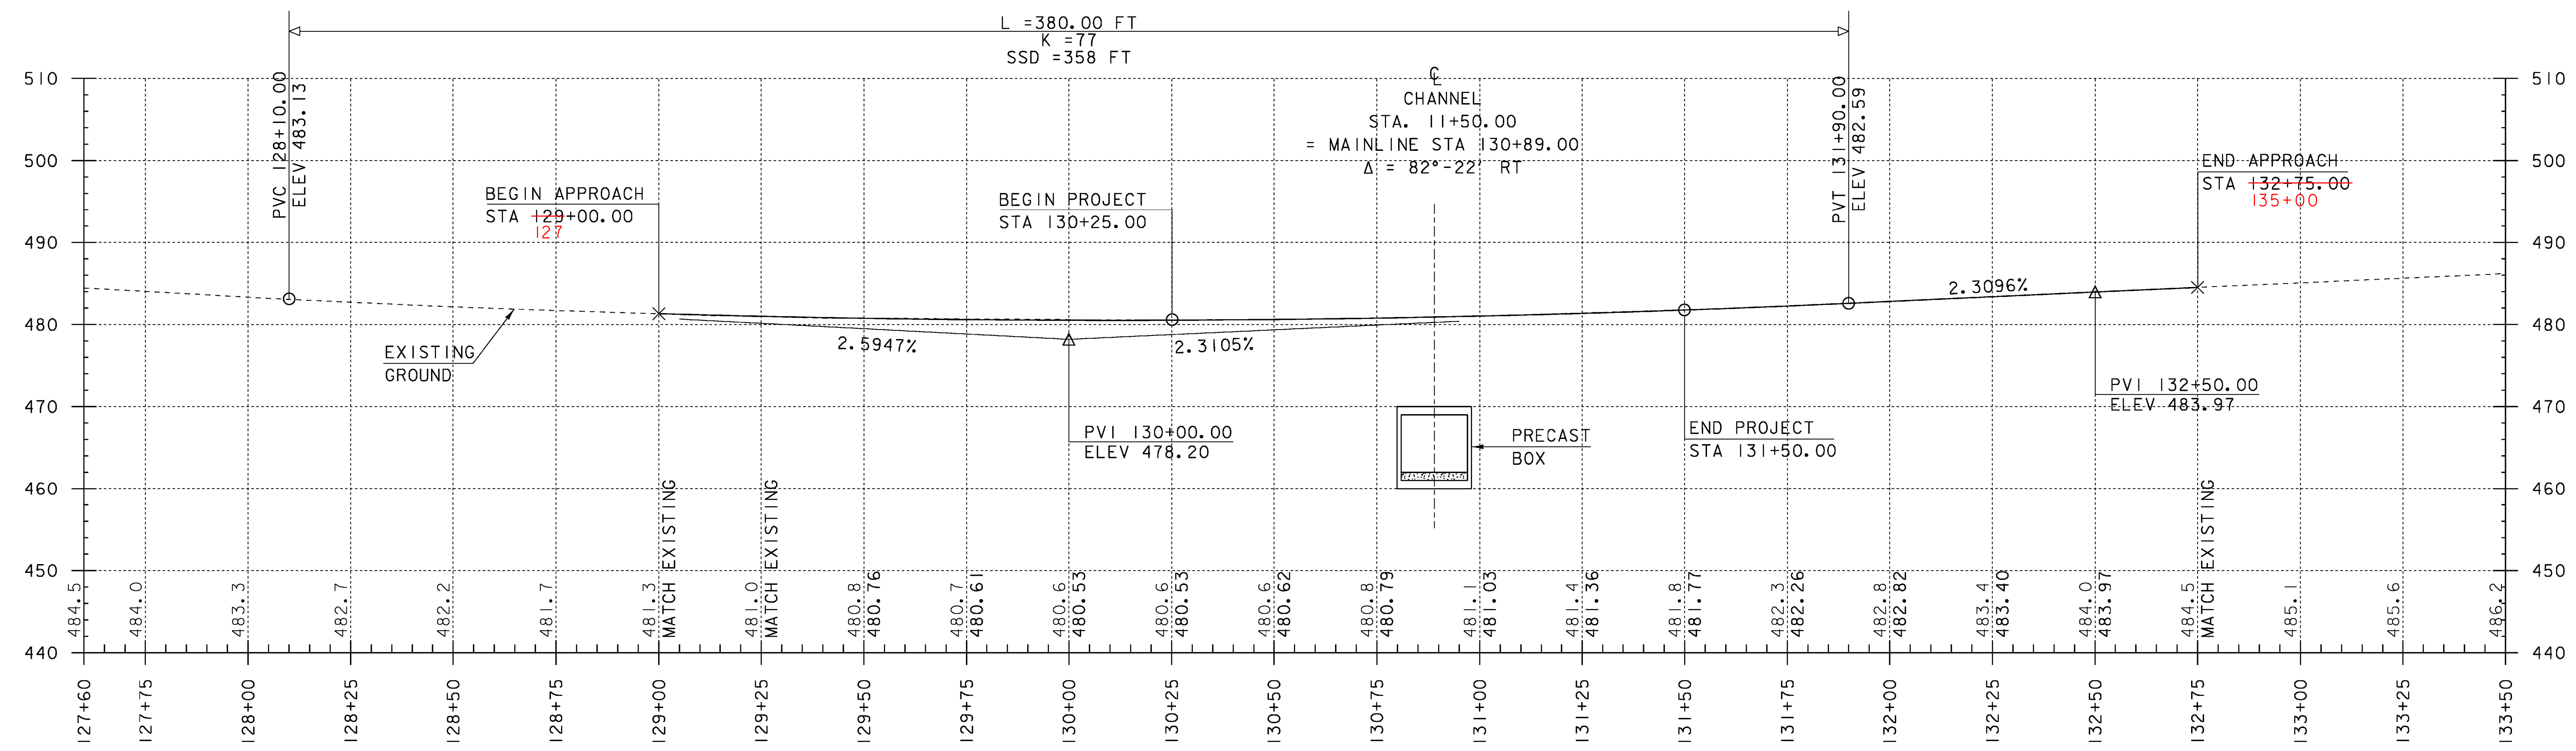


VT 103 MAINLINE

HOR. SCALE 1" = 20'-0"
 VER. SCALE 1" = 10'-0"

THE GRADES SHOWN TO THE NEAREST TENTH ARE THE ORIGINAL GROUND ELEVATIONS ALONG THE PROPOSED ALIGNMENT.

THE GRADES SHOWN TO THE NEAREST HUNDREDTH ARE THE FINISH GRADES ALONG THE PROPOSED ALIGNMENT.

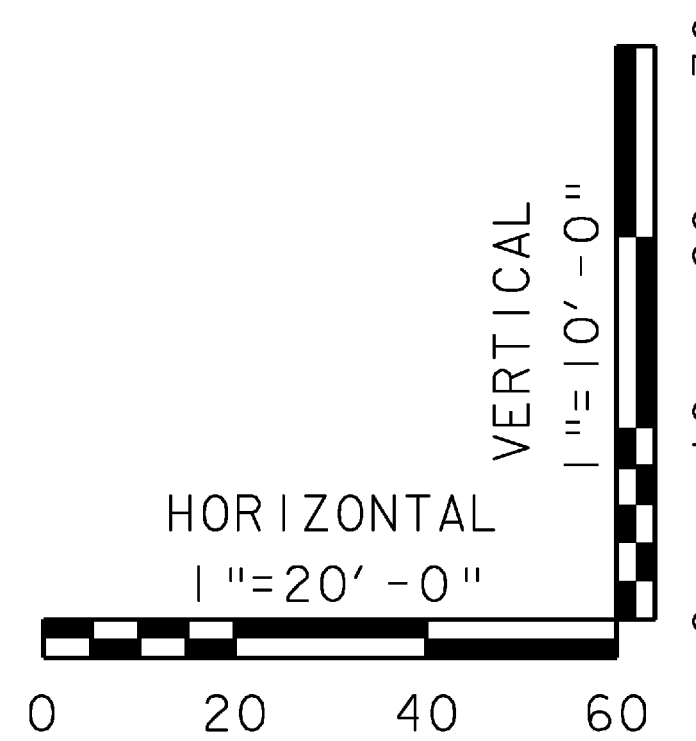

PROJECT: ROCK INGHAM	PROJECT NO.: NH CULV (15)
DESIGN FILE NAME: M:\Projects\08b064\Structures\08b064pro.dgn	PLOT DATE: 16-APR-2009
IPARM FILE NAME: s08b064pro.i	DESIGNED BY: J. SALVATORI
SQUAD LEADER: K. M. HIGGINS	DRAWN BY: M. FESSEL
MAINLINE PROFILE	CHECKED BY: J. SALVATORI
	SHEET: 9 OF 27