


25B WESTBURY FINE SANDY LOAM
3 - 8% SLOPE
"K FACTOR" = 0.24

3E QUONSET & WARWICK SOILS
25 - 70% SLOPE
"K FACTOR" = 0.17

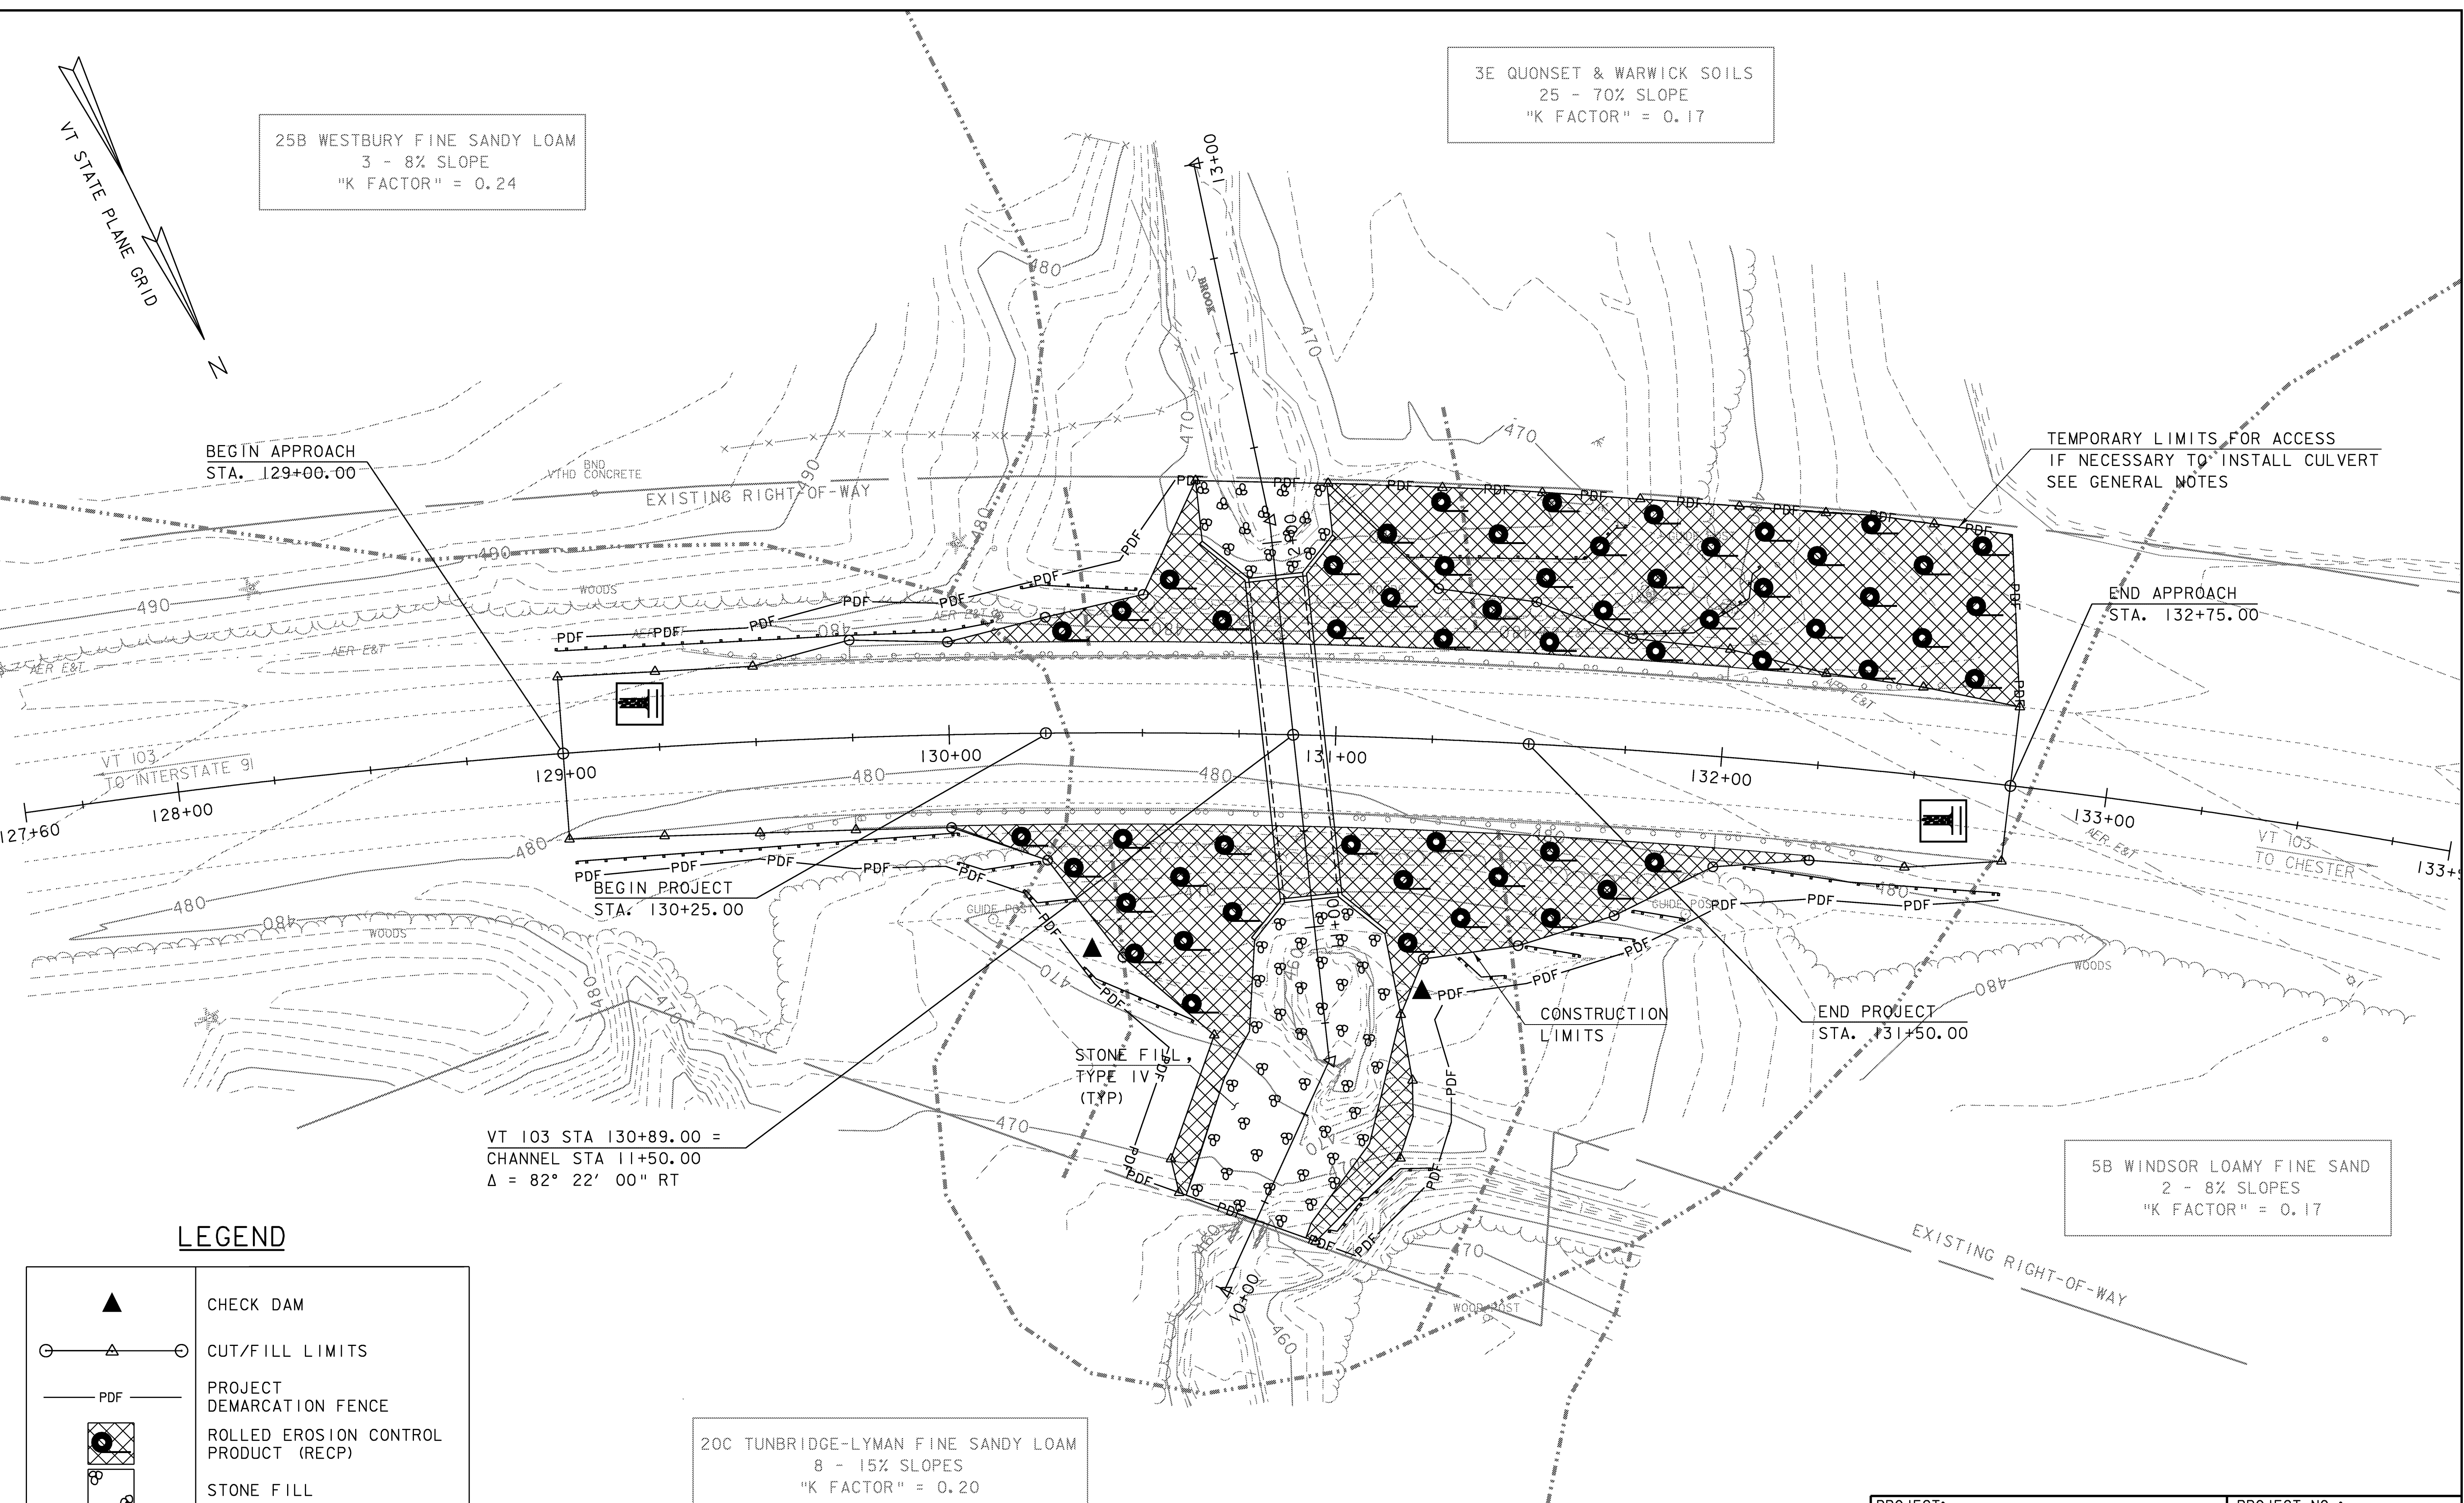

LEGEND

	CHECK DAM
	CUT/FILL LIMITS
	PROJECT DEMARCATION FENCE
	ROLLED EROSION CONTROL PRODUCT (RECP)
	STONE FILL
	SILT FENCE
	STABILIZED CONSTRUCTION ENTRANCE

20C TUNBRIDGE-LYMAN FINE SANDY LOAM
8 - 15% SLOPES
"K FACTOR" = 0.20

5B WINDSOR LOAMY FINE SAND
2 - 8% SLOPES
"K FACTOR" = 0.17

EPSC CONSTRUCTION SITE PLAN

SCALE 1" = 20'-0"
20 0 20

PROJECT: ROCKINGHAM	PROJECT NO.: NH CULV (15)
DESIGN FILE NAME: M:\Projects\08b064\Structures\08b064epsc_ex.c	PLOT DATE: 16-APR-2009
IPARM FILE NAME: s08b064epsc_dur.i	DESIGNED BY: J. SALVATORI
SQUAD LEADER: K. M. HIGGINS	DRAWN BY: M. FESSEL
EPSC CONSTRUCTION SITE PLAN	CHECKED BY: J. SALVATORI
	SHEET: 16 OF 27