




129+75

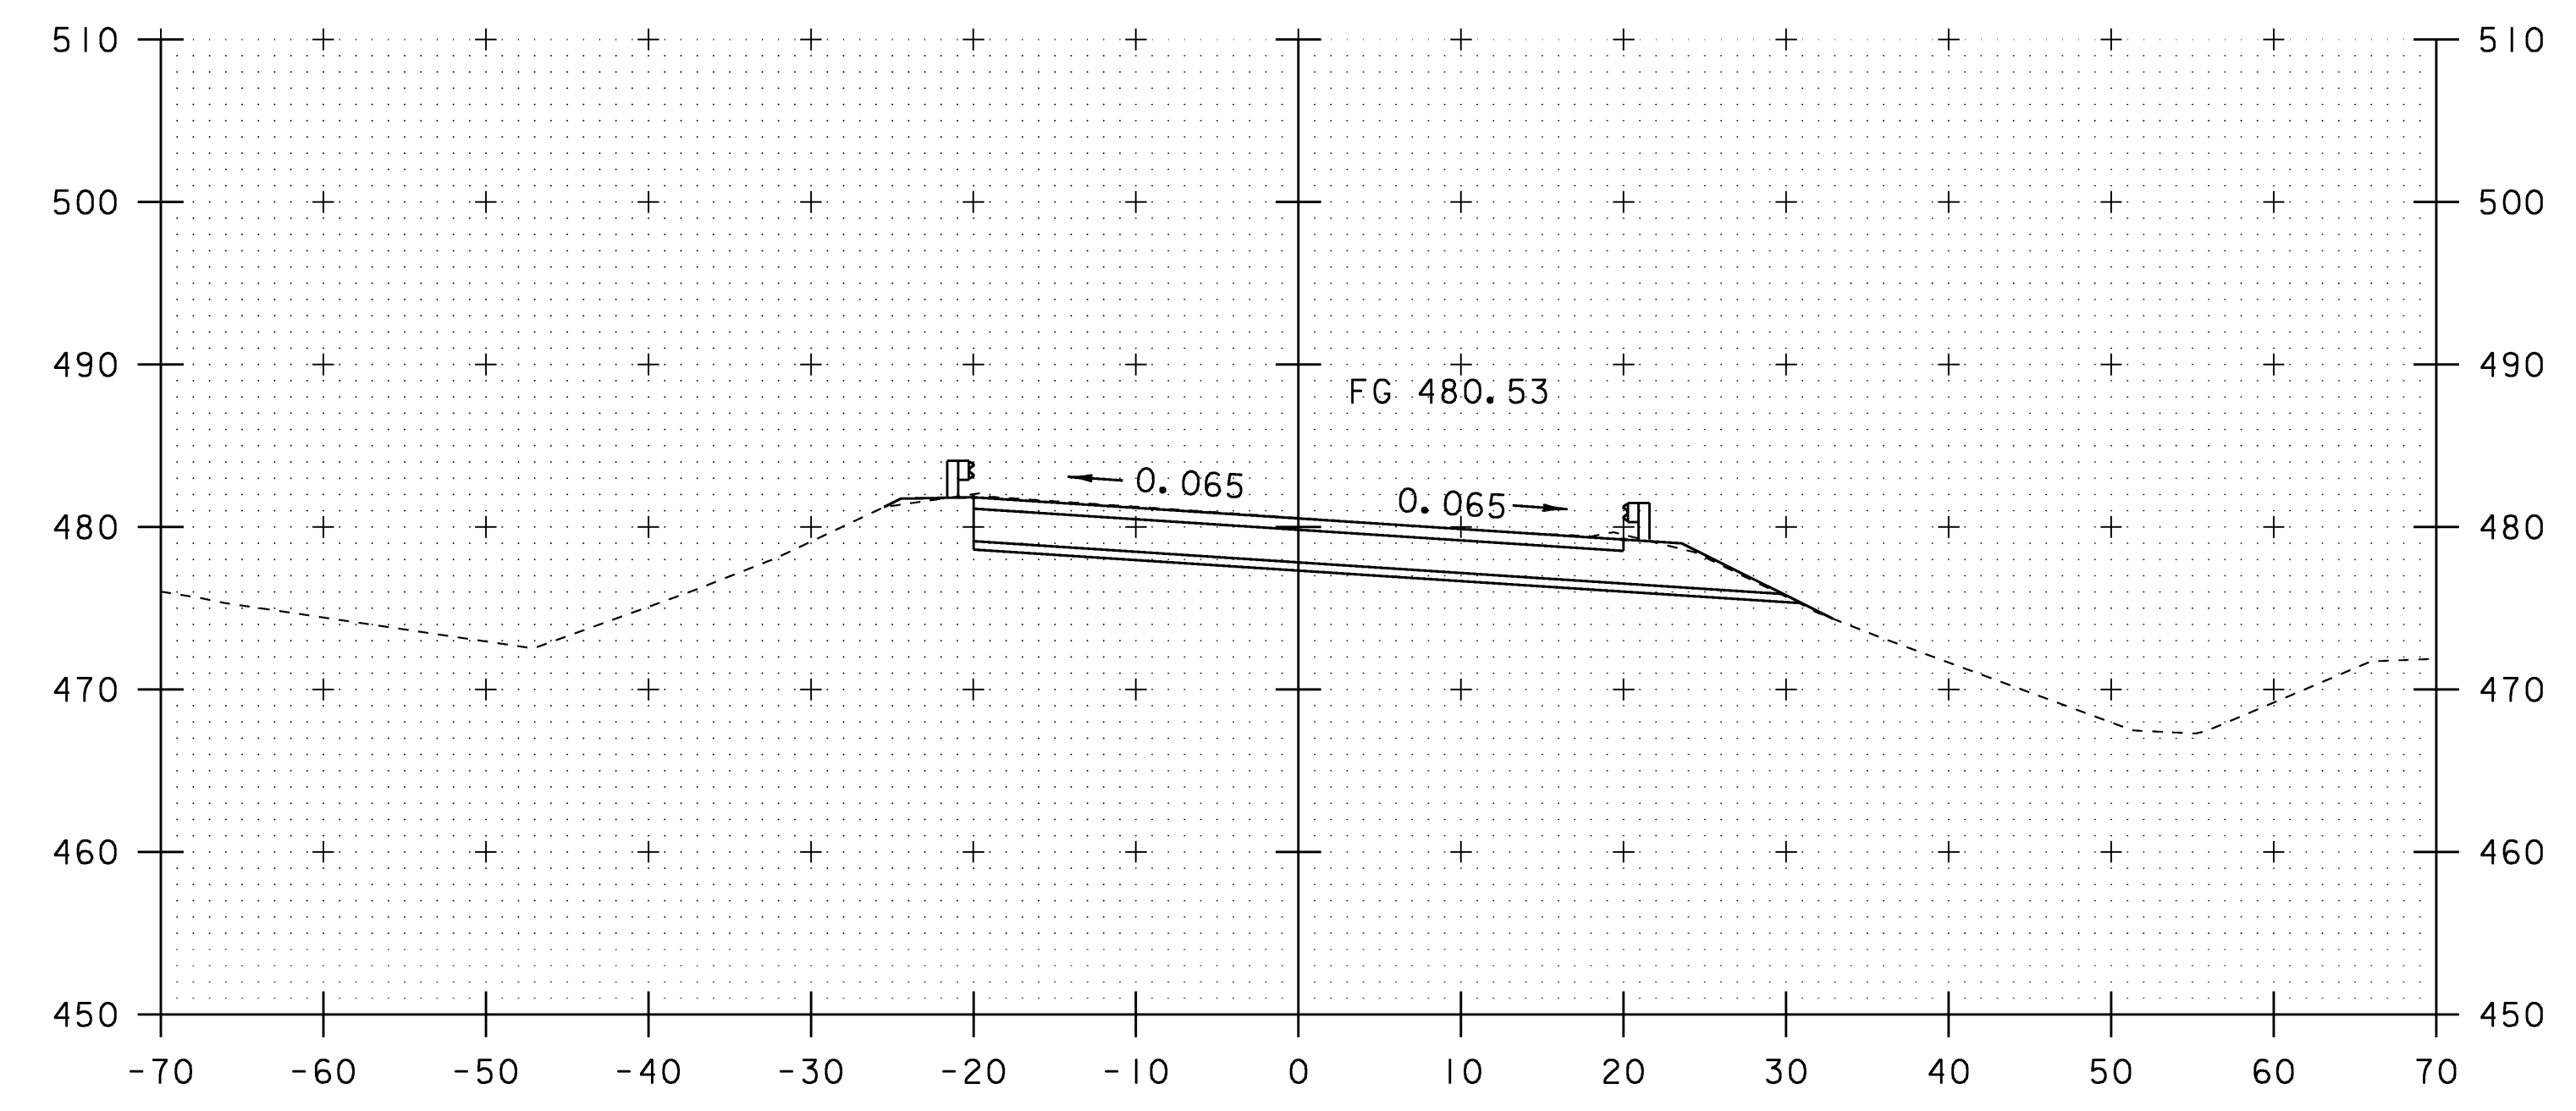


130+25

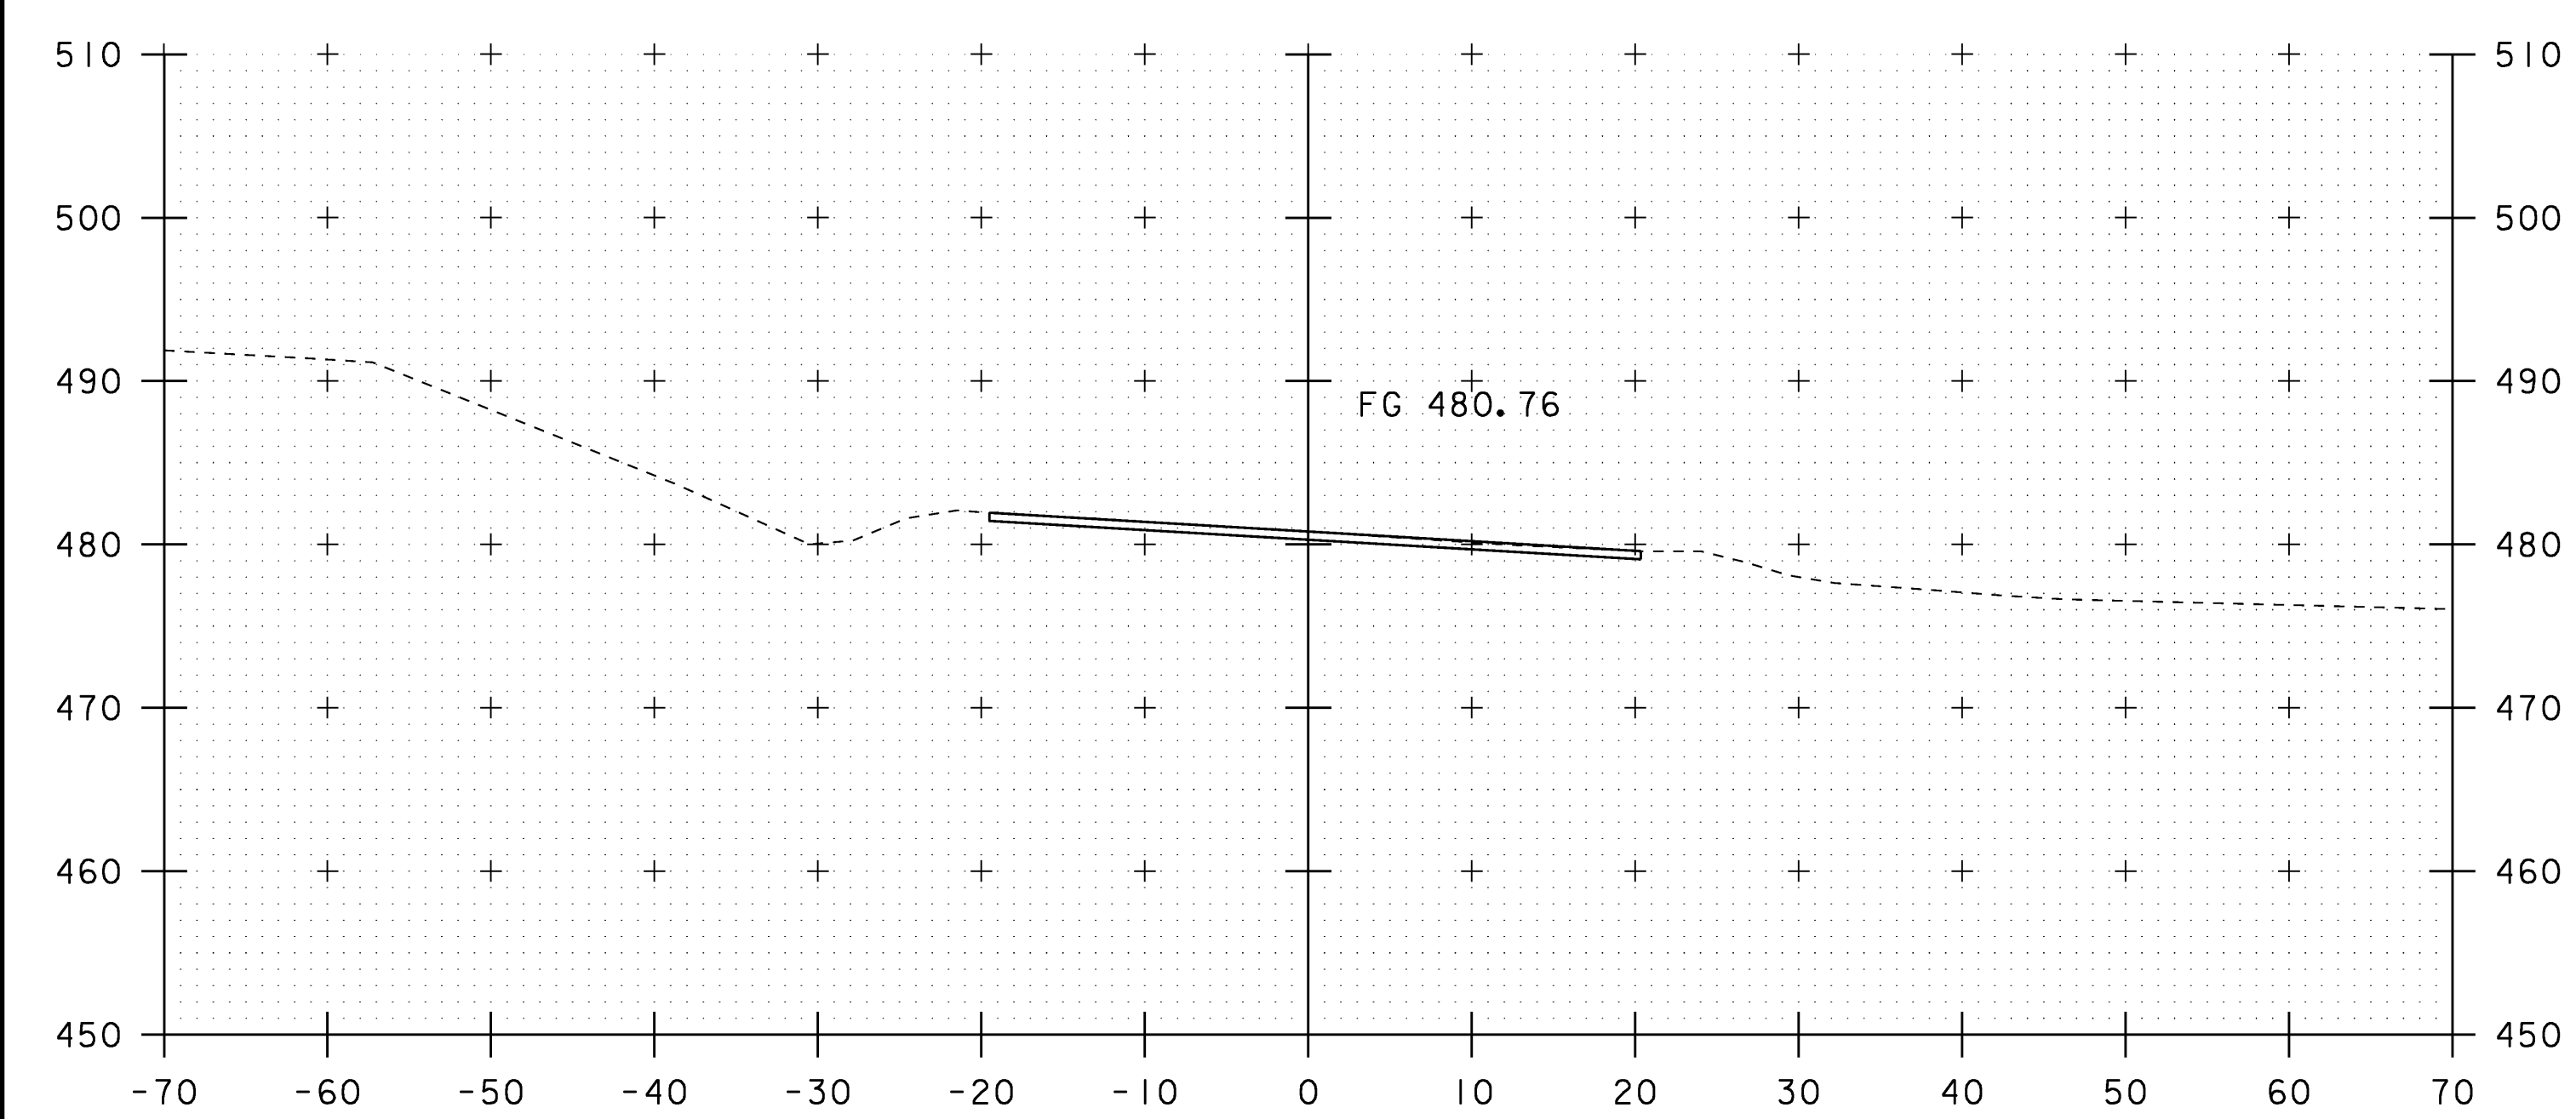

129+50

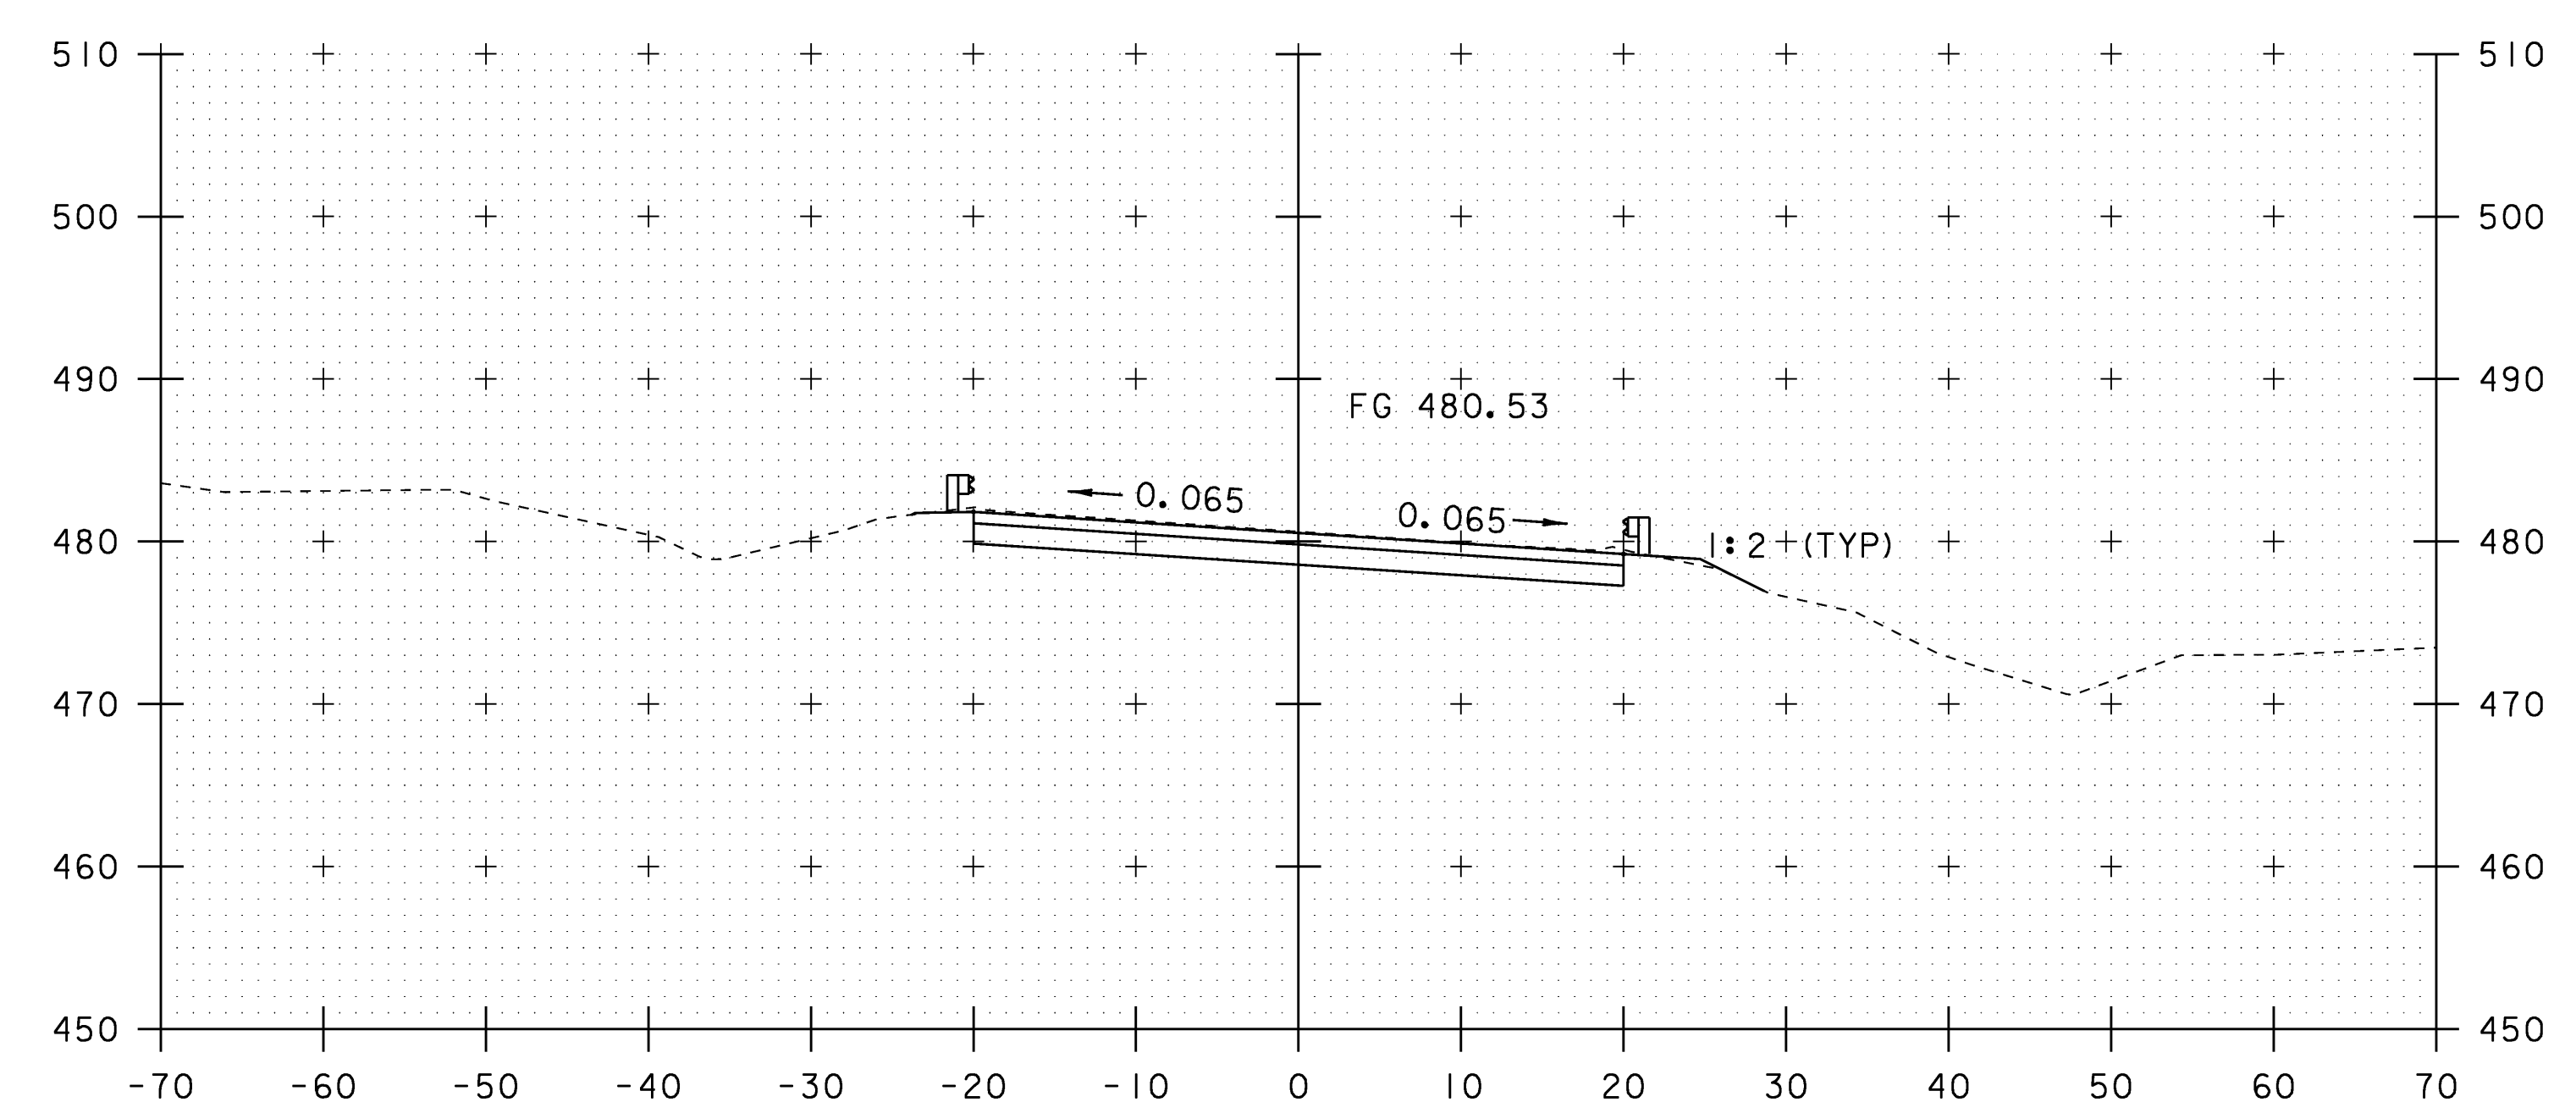

130+00

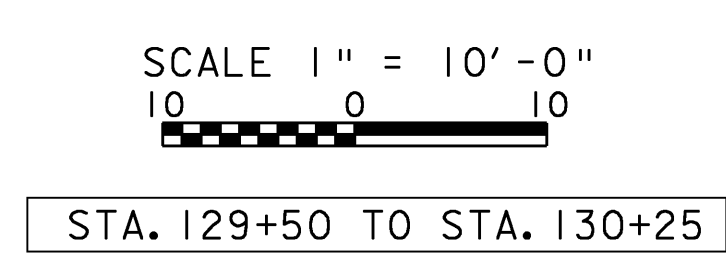

PROJECT NAME: ROCKINGHAM	PROJECT NUMBER: NH CULV(15)
DESIGN FILE NAME: M:\Projects\08b064\Structures\08b064xsl.dgn	PLOT DATE: 16-APR-2009
IPARM FILE NAME: s08b064mx2.i	DRAWN BY: M.FESSEL
SQUAD LEADER: K.M.HIGGINS	CHECKED BY: J.SALVATORI
DESIGNED BY: J.SALVATORI	SHEET 21 OF 27
MAINLINE SECTION - SHEET 2	

STA. 129+50 TO STA. 130+25