




130+75

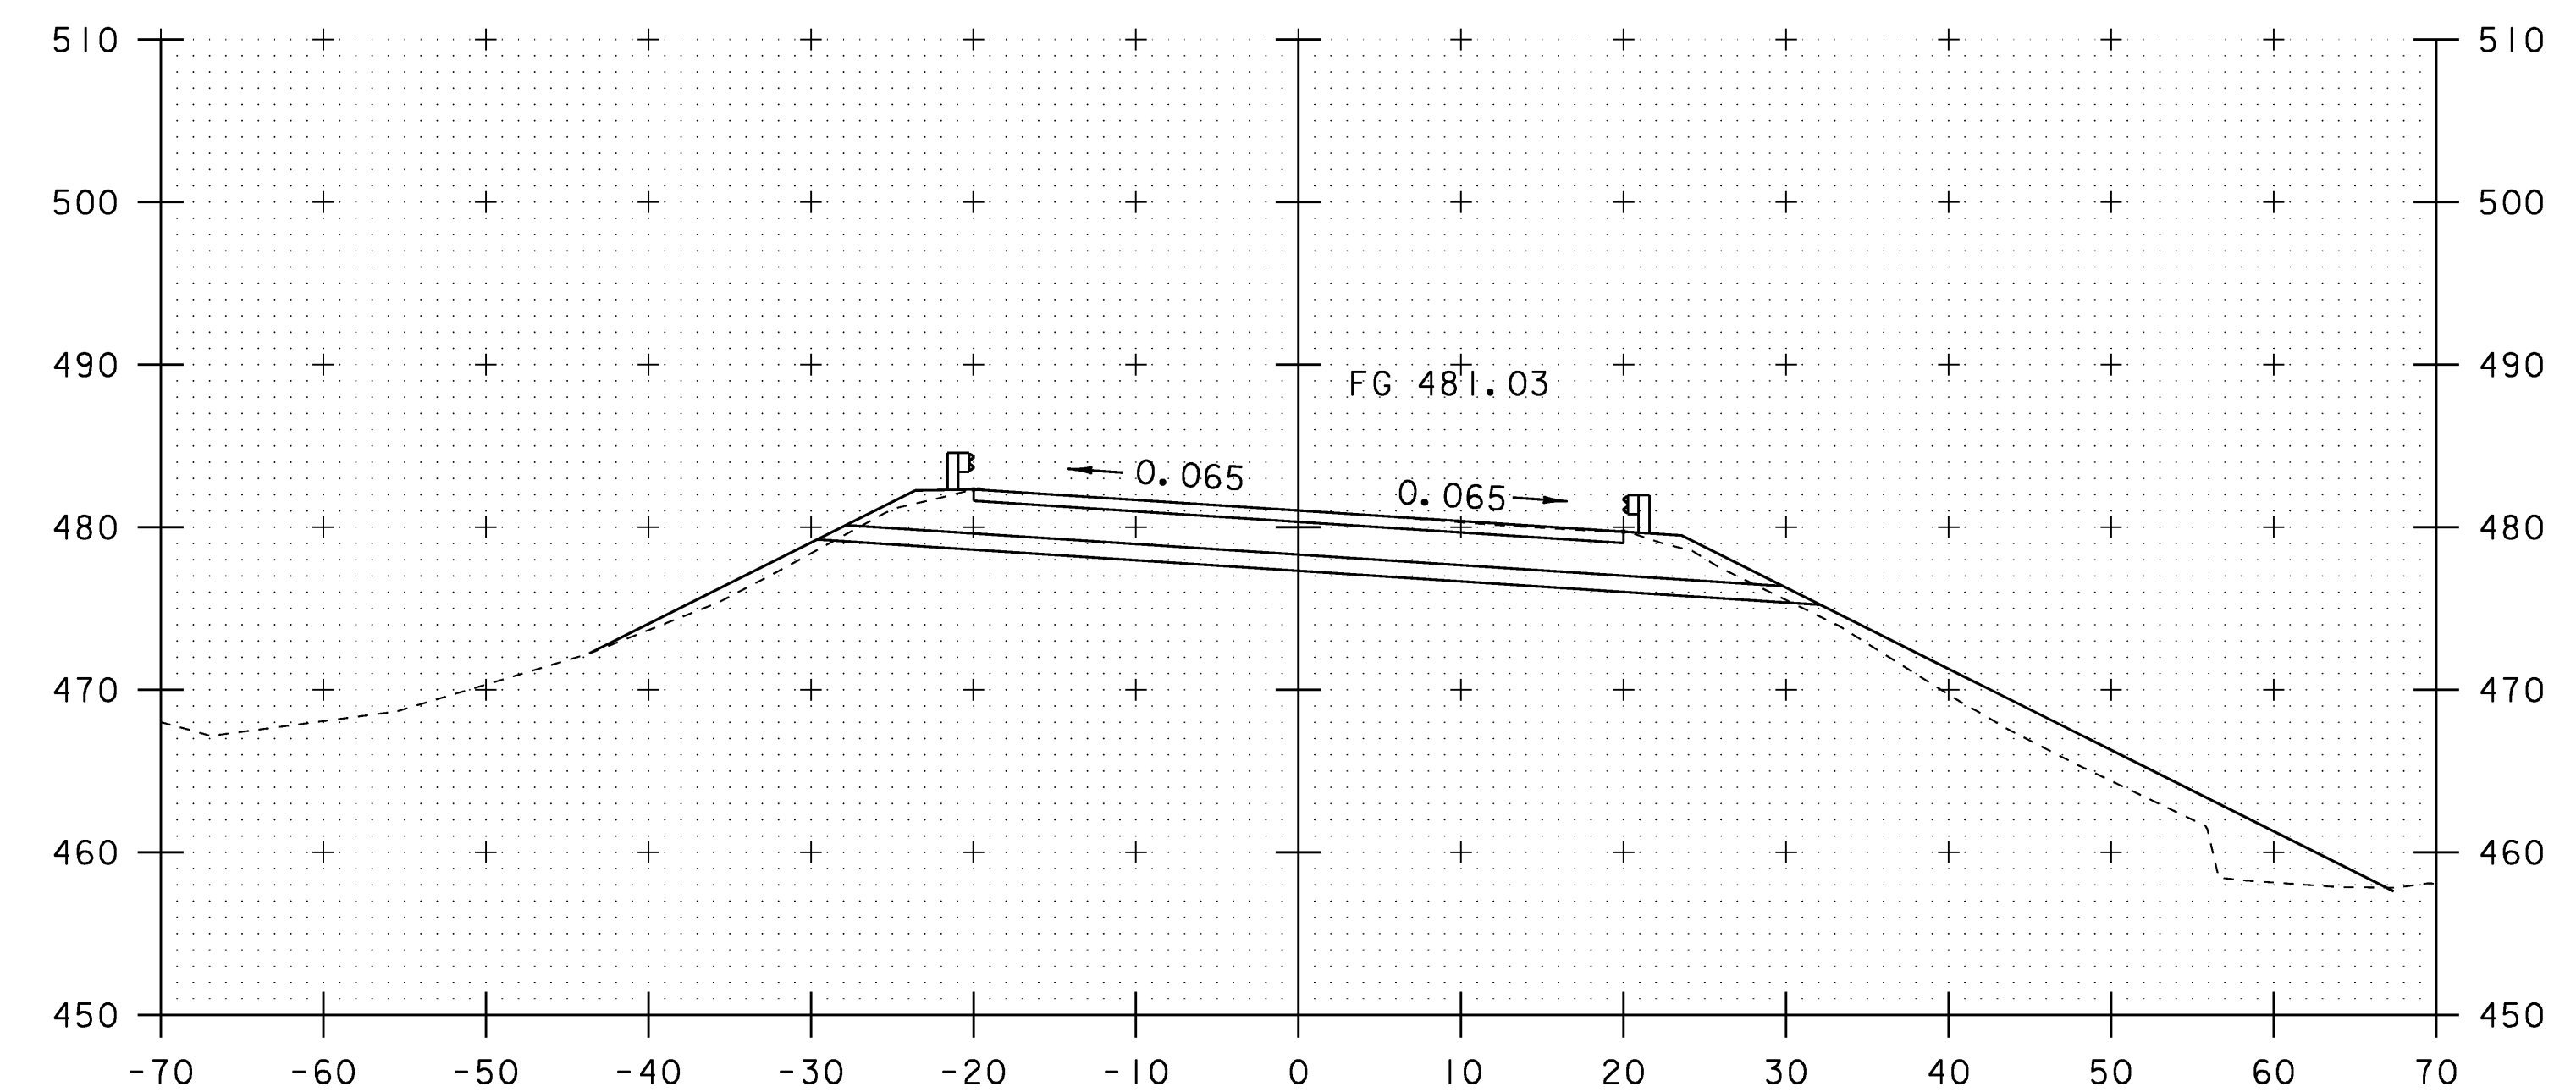


131+00

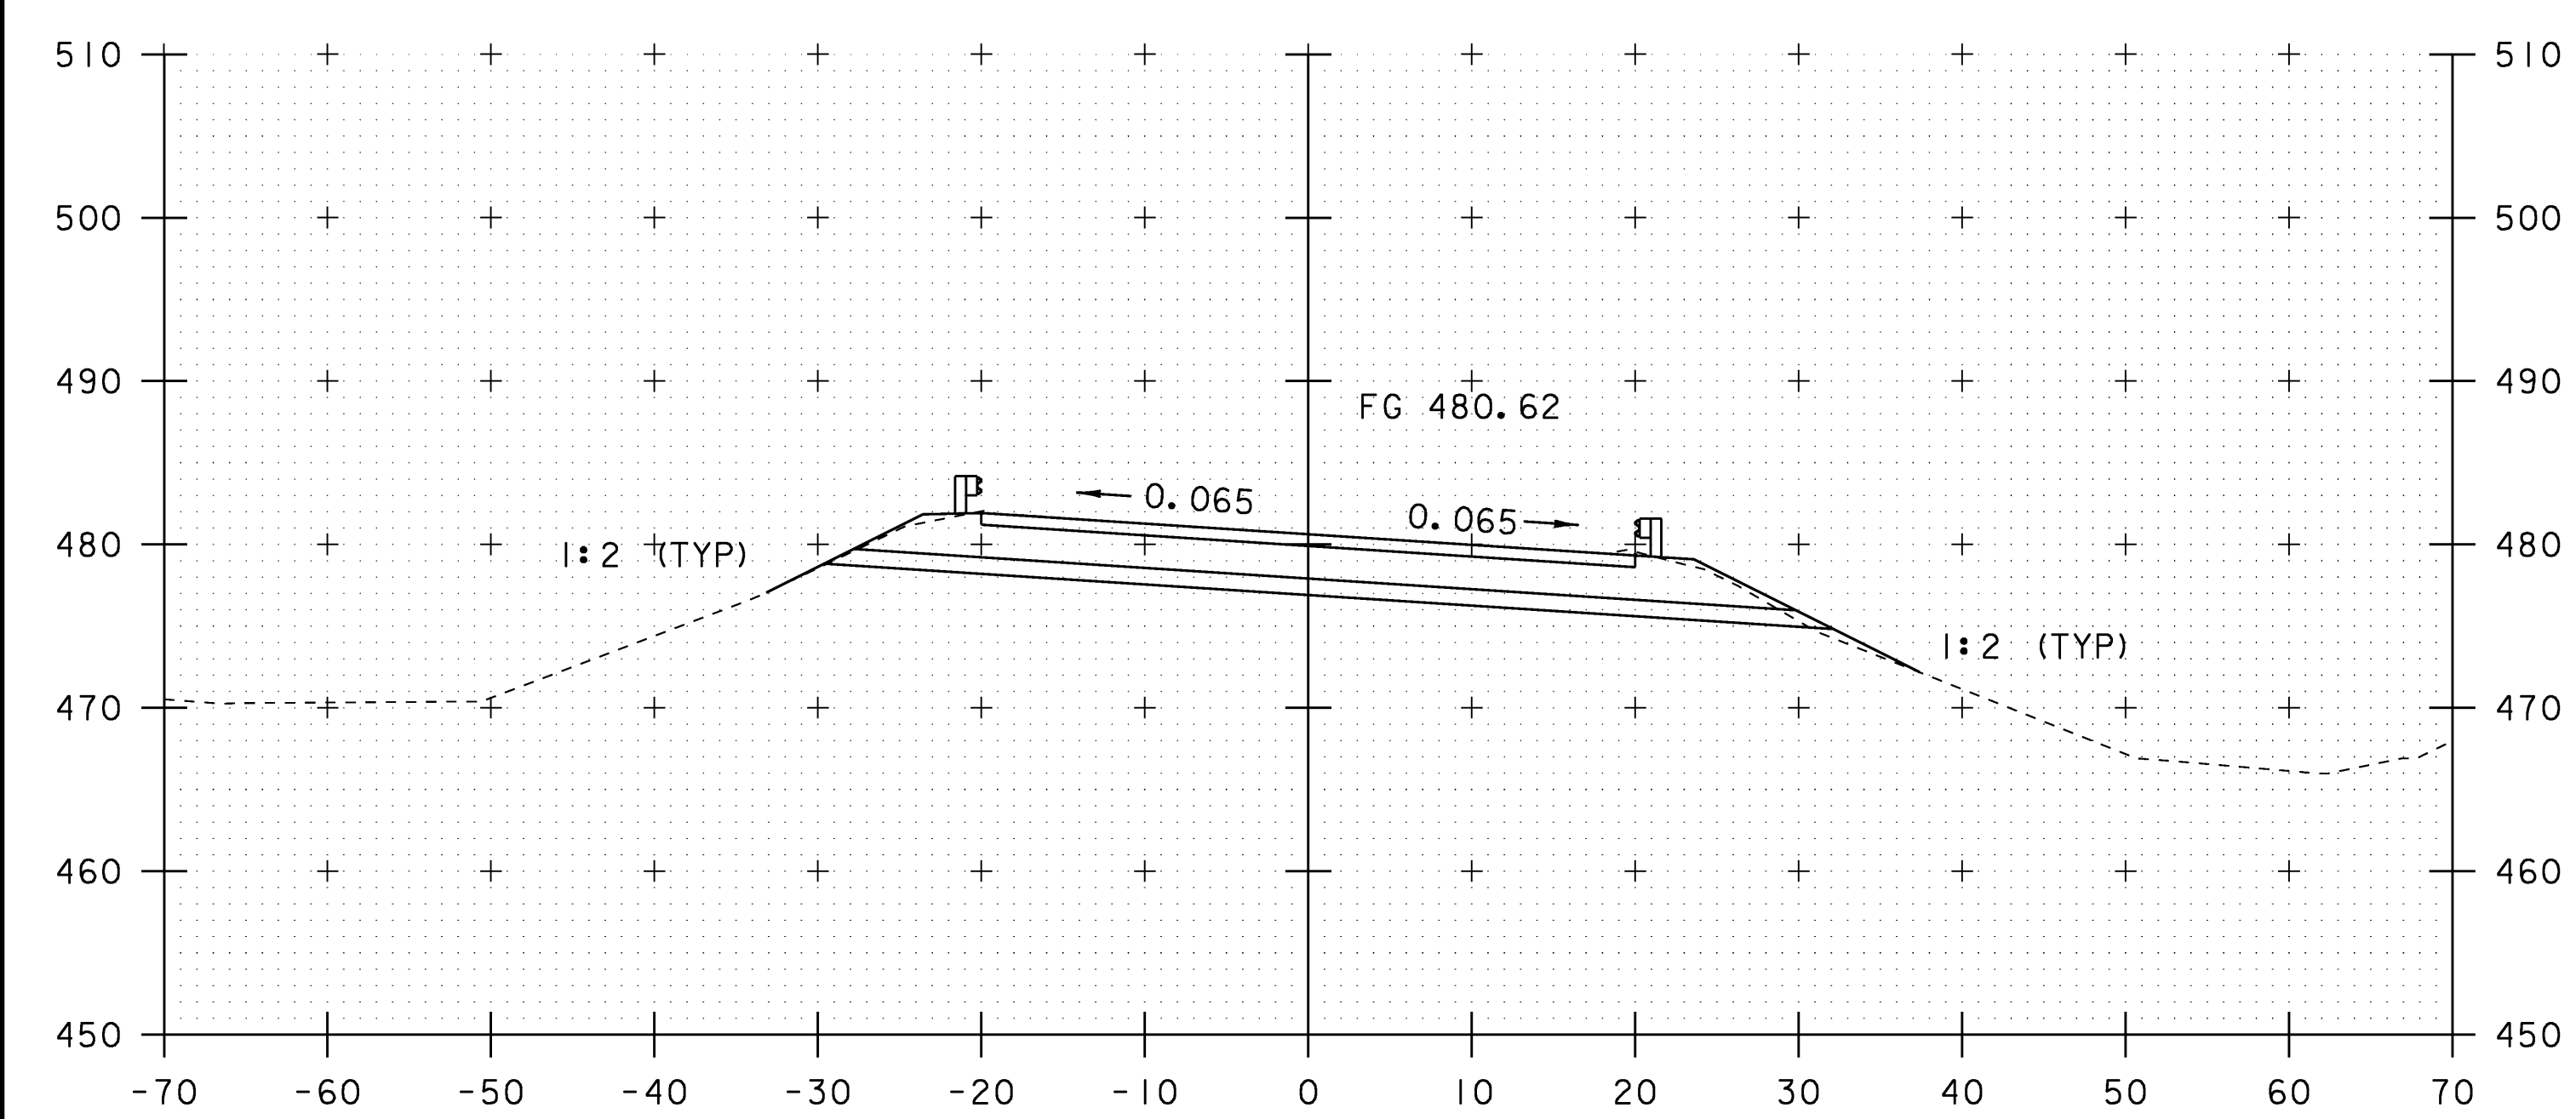

130+50

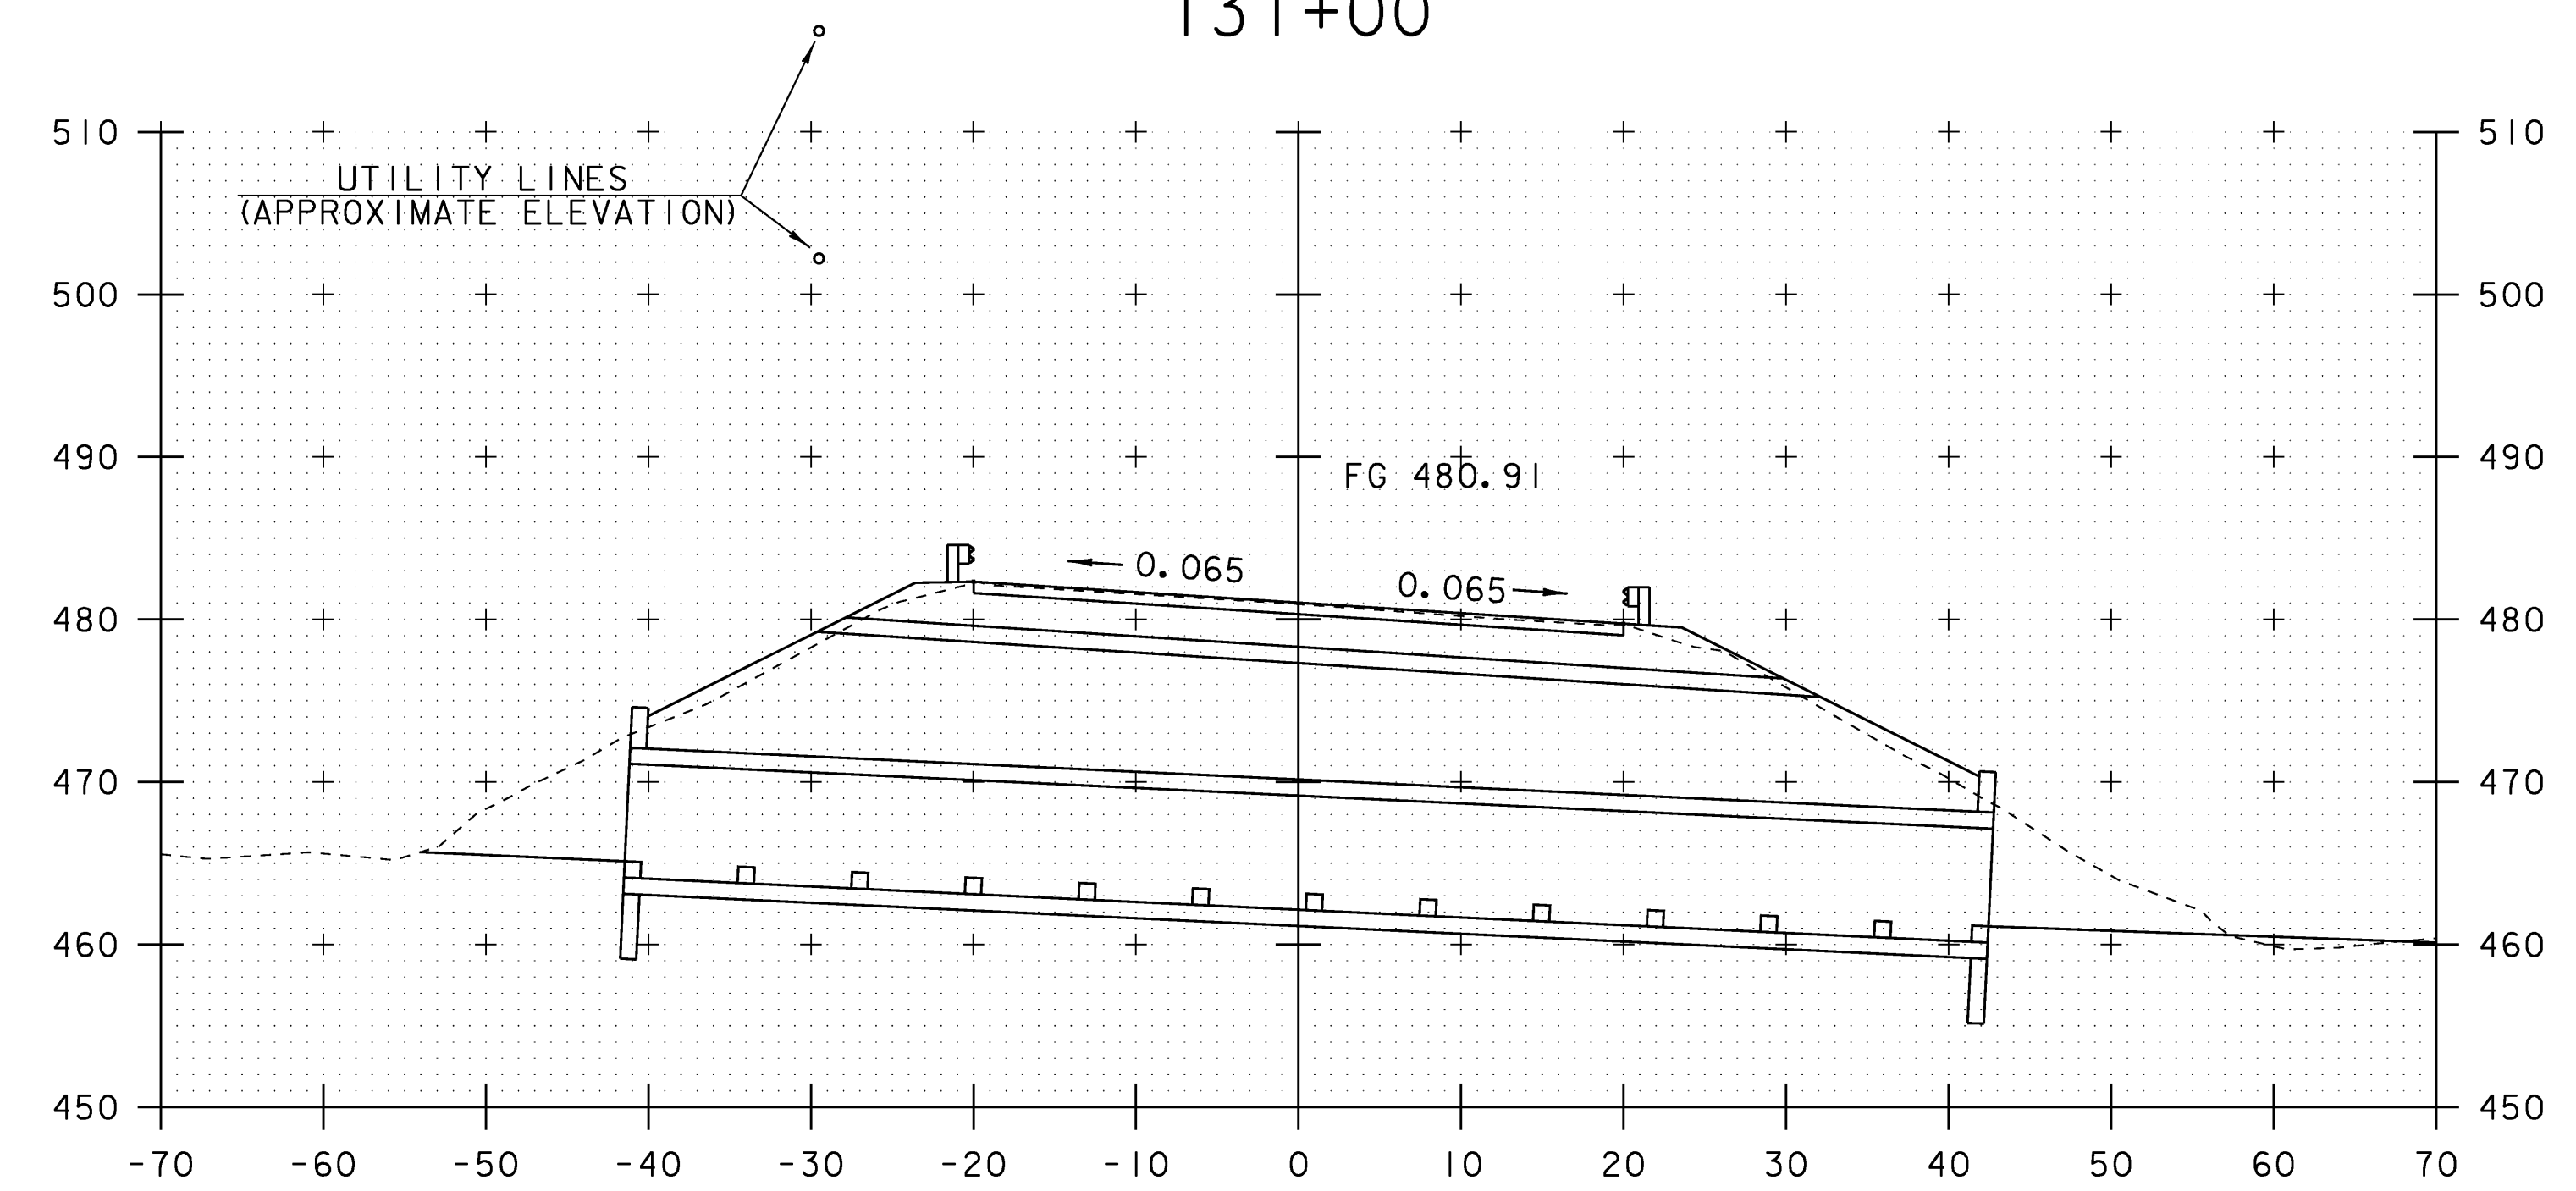

130+89

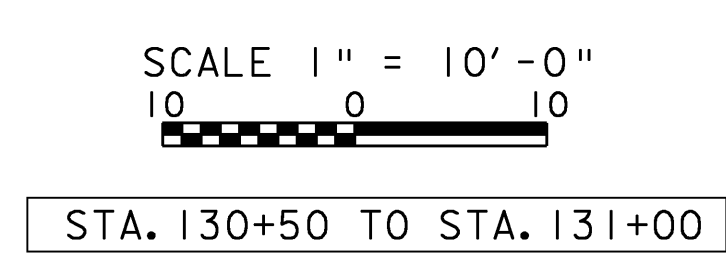

| | |
|---|--------------------------------|
| PROJECT NAME: ROCKINGHAM | PROJECT NUMBER: NH CULV(15) |
| DESIGN FILE NAME: M:\Projects\08b064\Structures\08b064xsl.dgn | PLOT DATE: 16-APR-2009 |
| IPARM FILE NAME: s08b064mx3.l | DRAWN BY: M.FESSEL |
| SQUAD LEADER: K.M.HIGGINS | CHECKED BY: J.SALVATORI |
| DESIGNED BY: J.SALVATORI | SHEET 22 OF 27 |
| MAINLINE SECTION - SHEET 3 | |