




END PROJECT
131+50

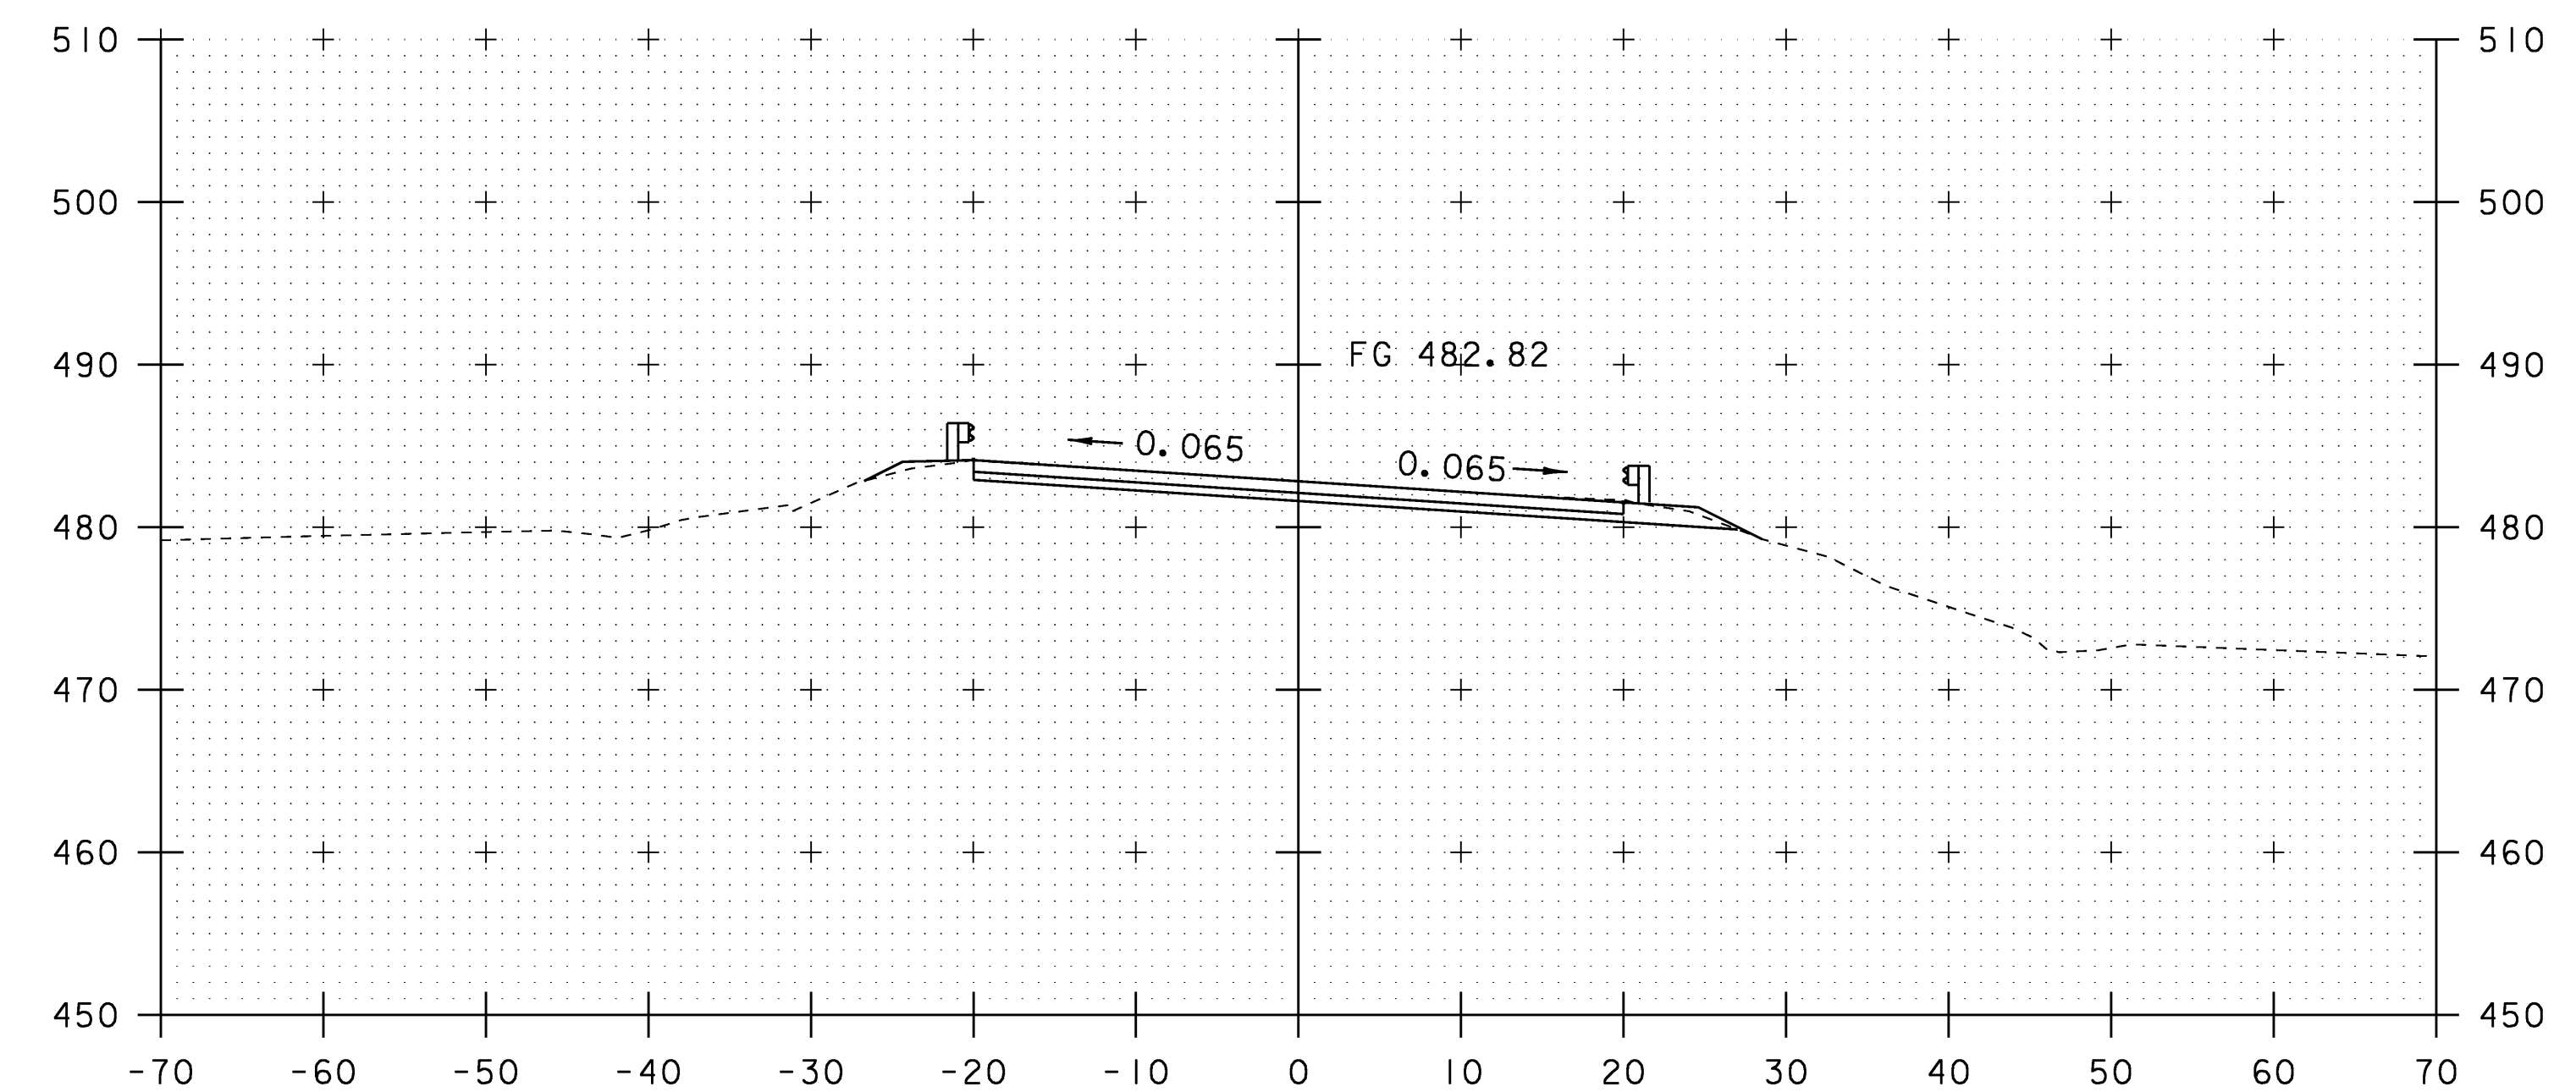


132+00

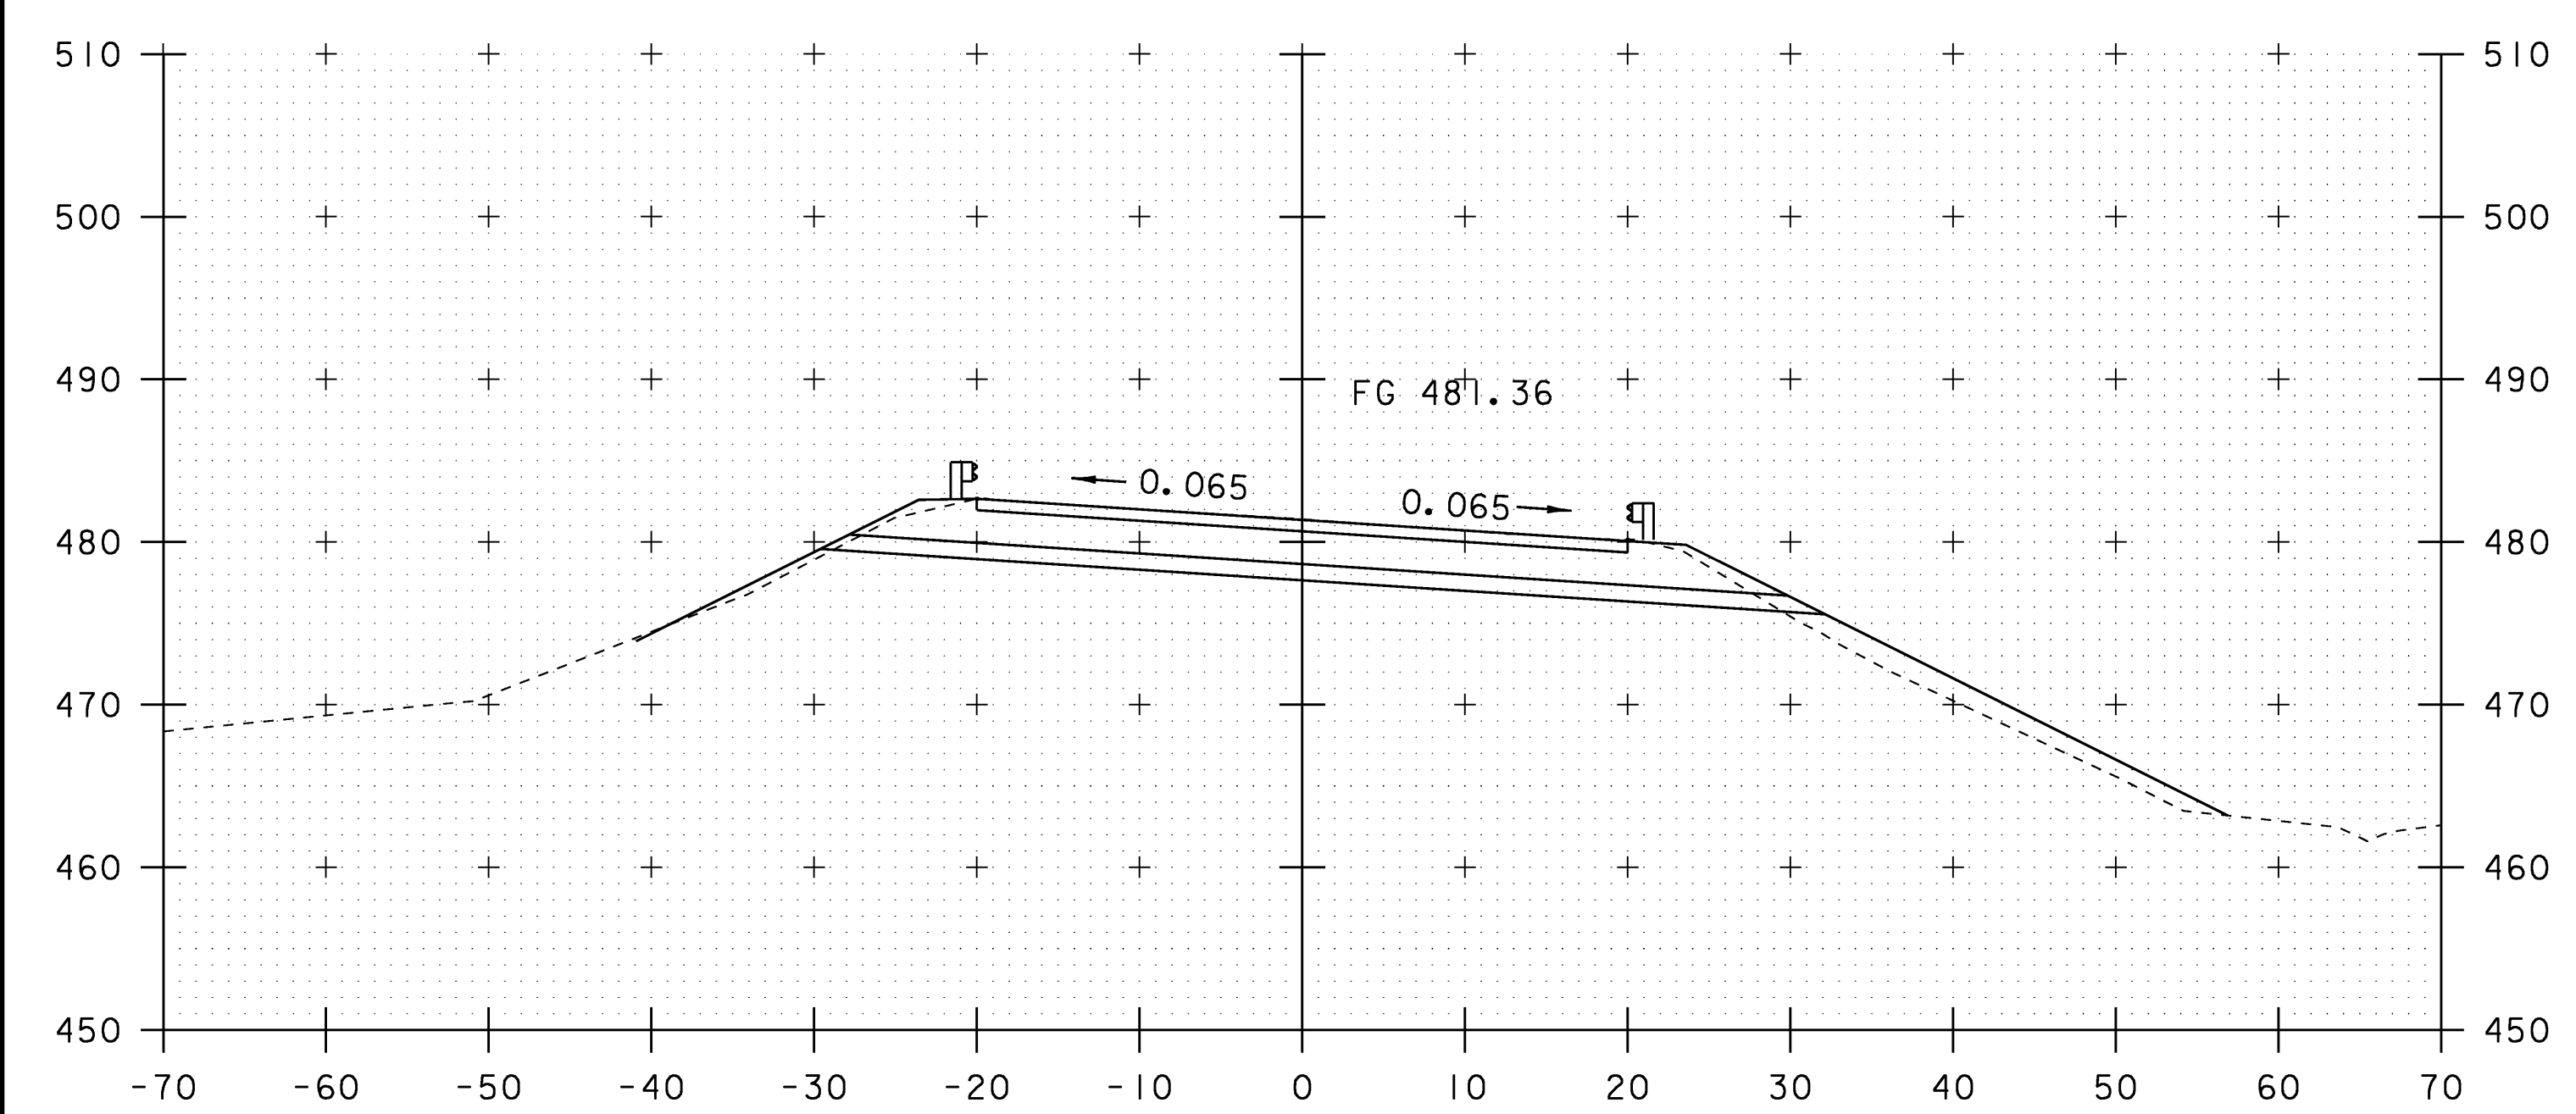

131+25

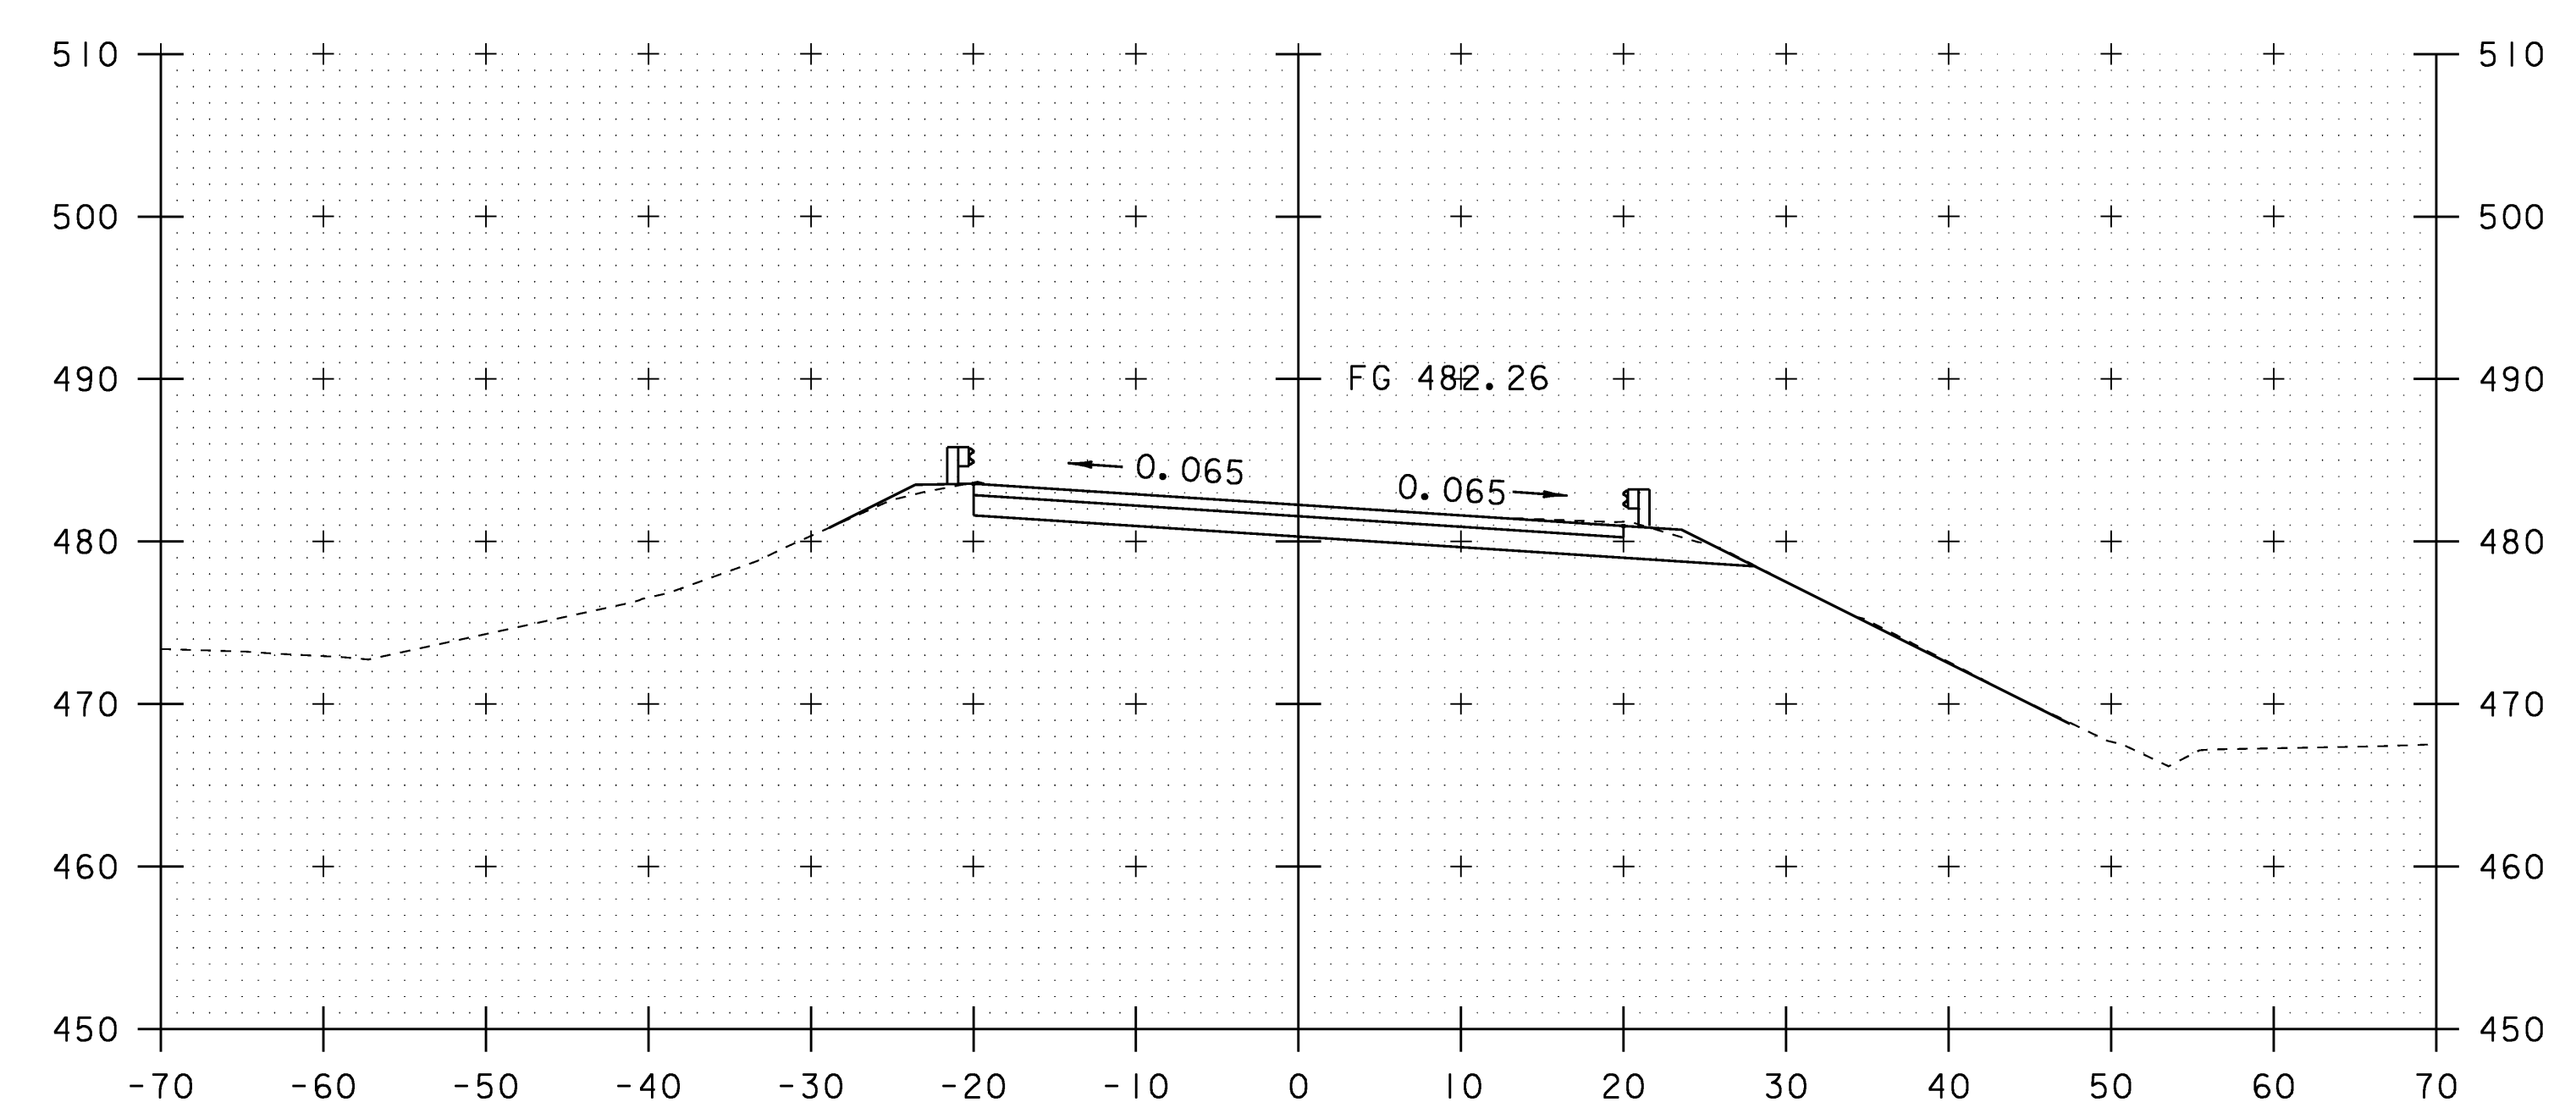

131+75

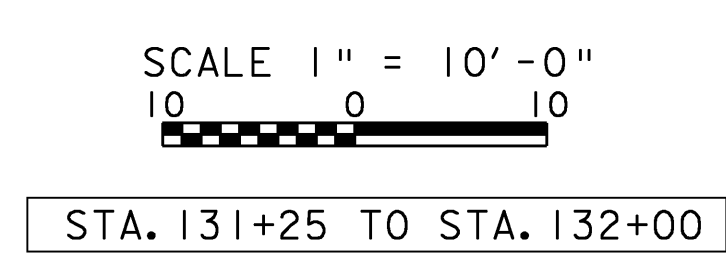

PROJECT NAME: ROCKINGHAM	PROJECT NUMBER: NH CULV(15)
DESIGN FILE NAME: M:\Projects\08b064\Structures\08b064.dgn	PLOT DATE: 16-APR-2009
IPARM FILE NAME: s08b064mx4.l	DRAWN BY: M.FESSEL
SQUAD LEADER: K.M.HIGGINS	CHECKED BY: J.SALVATORI
DESIGNED BY: J.SALVATORI	SHEET 23 OF 27
MAINLINE SECTION - SHEET 4	