




132+50

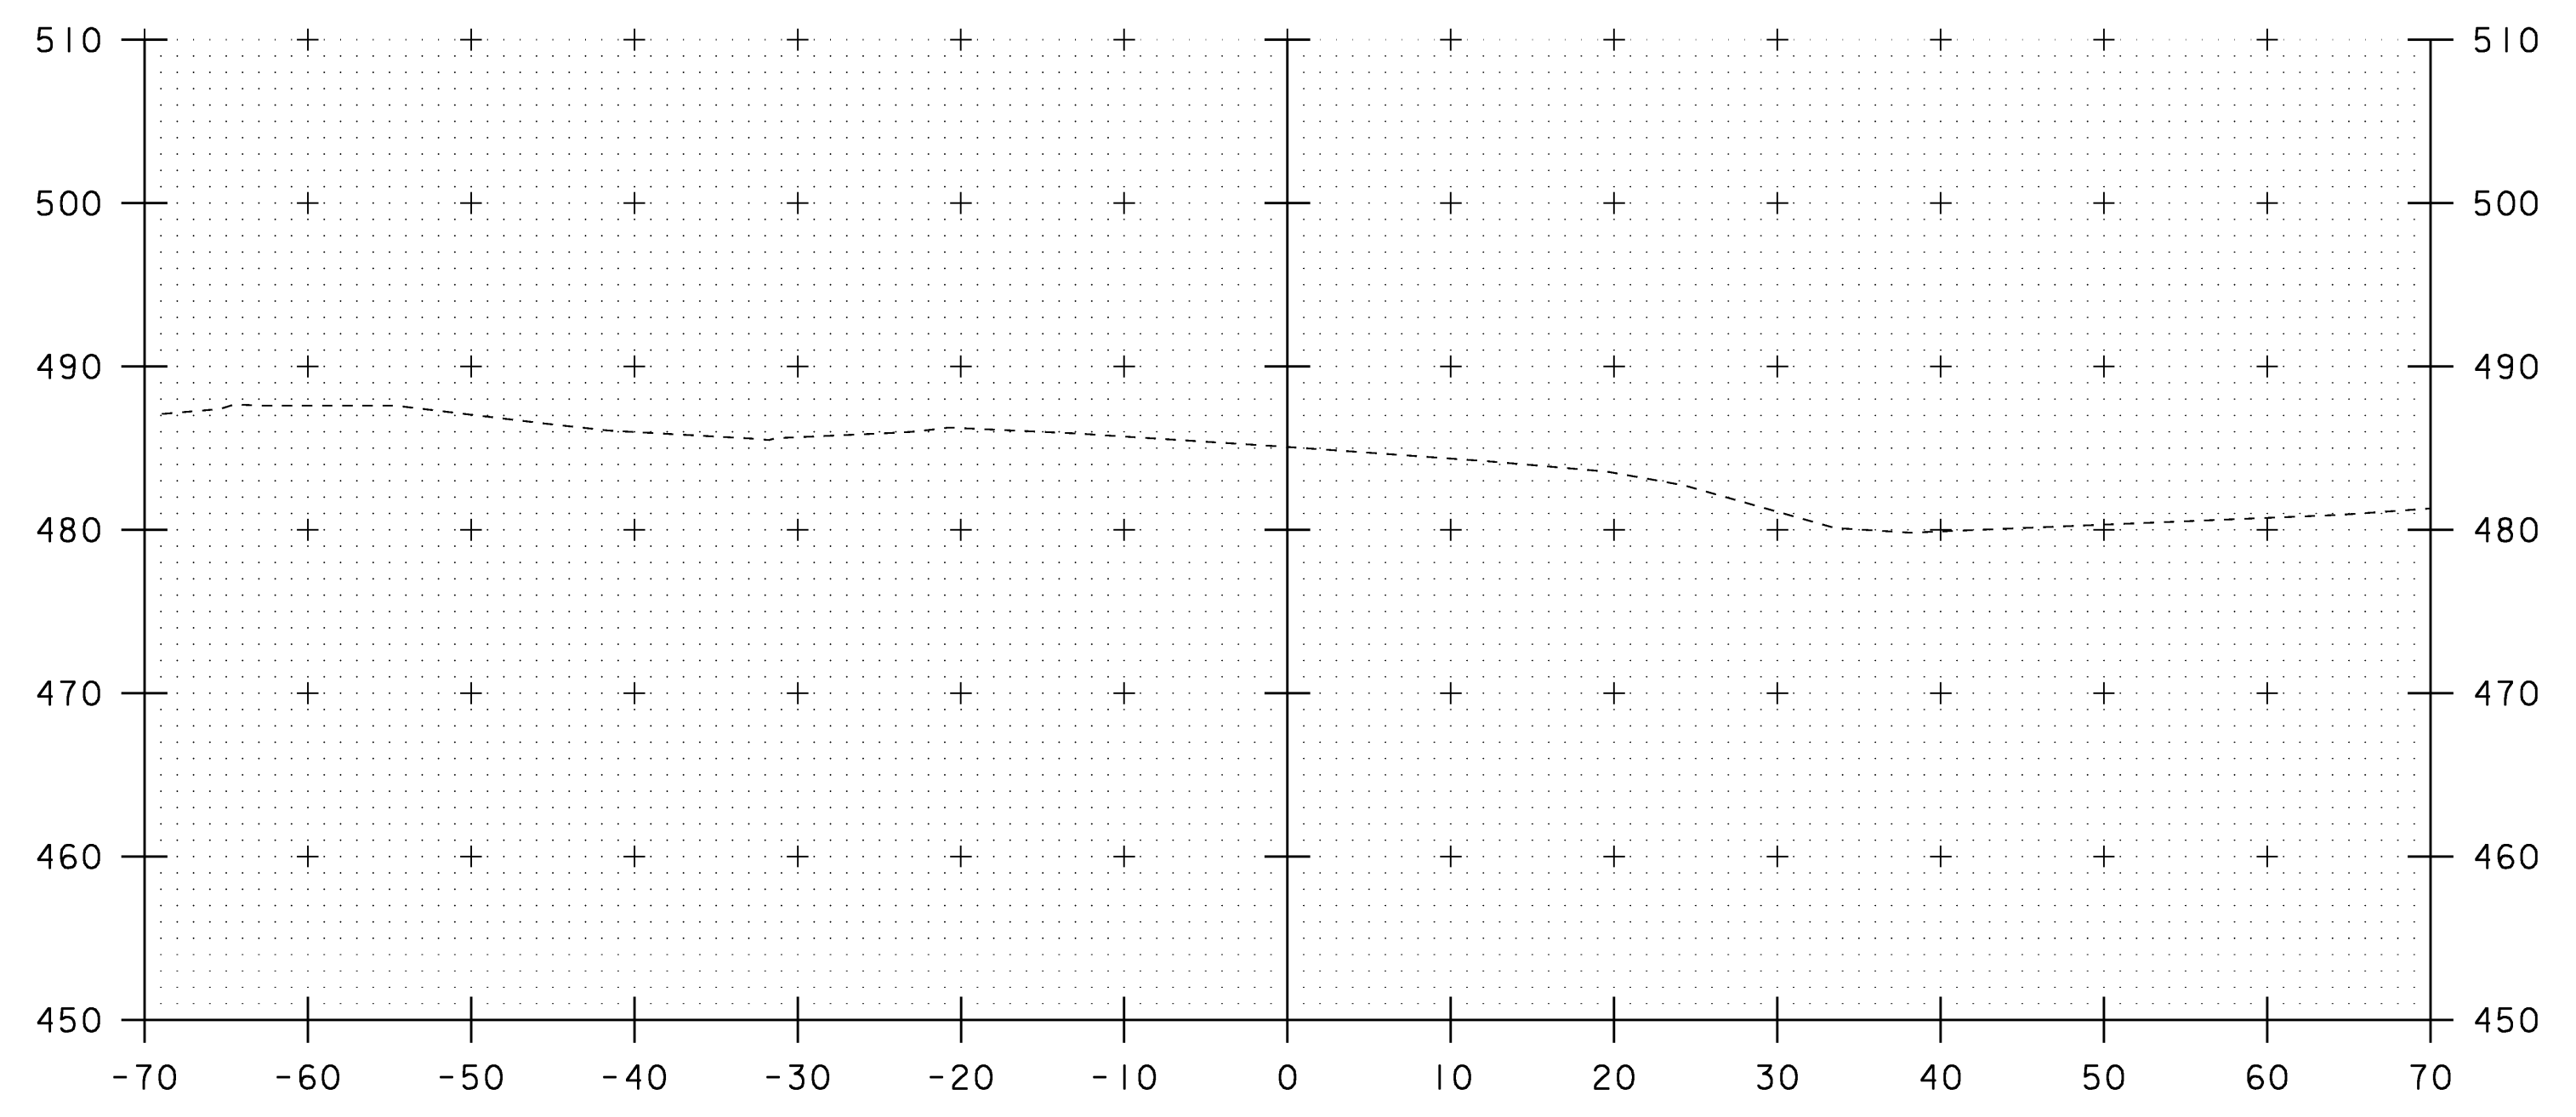


133+00

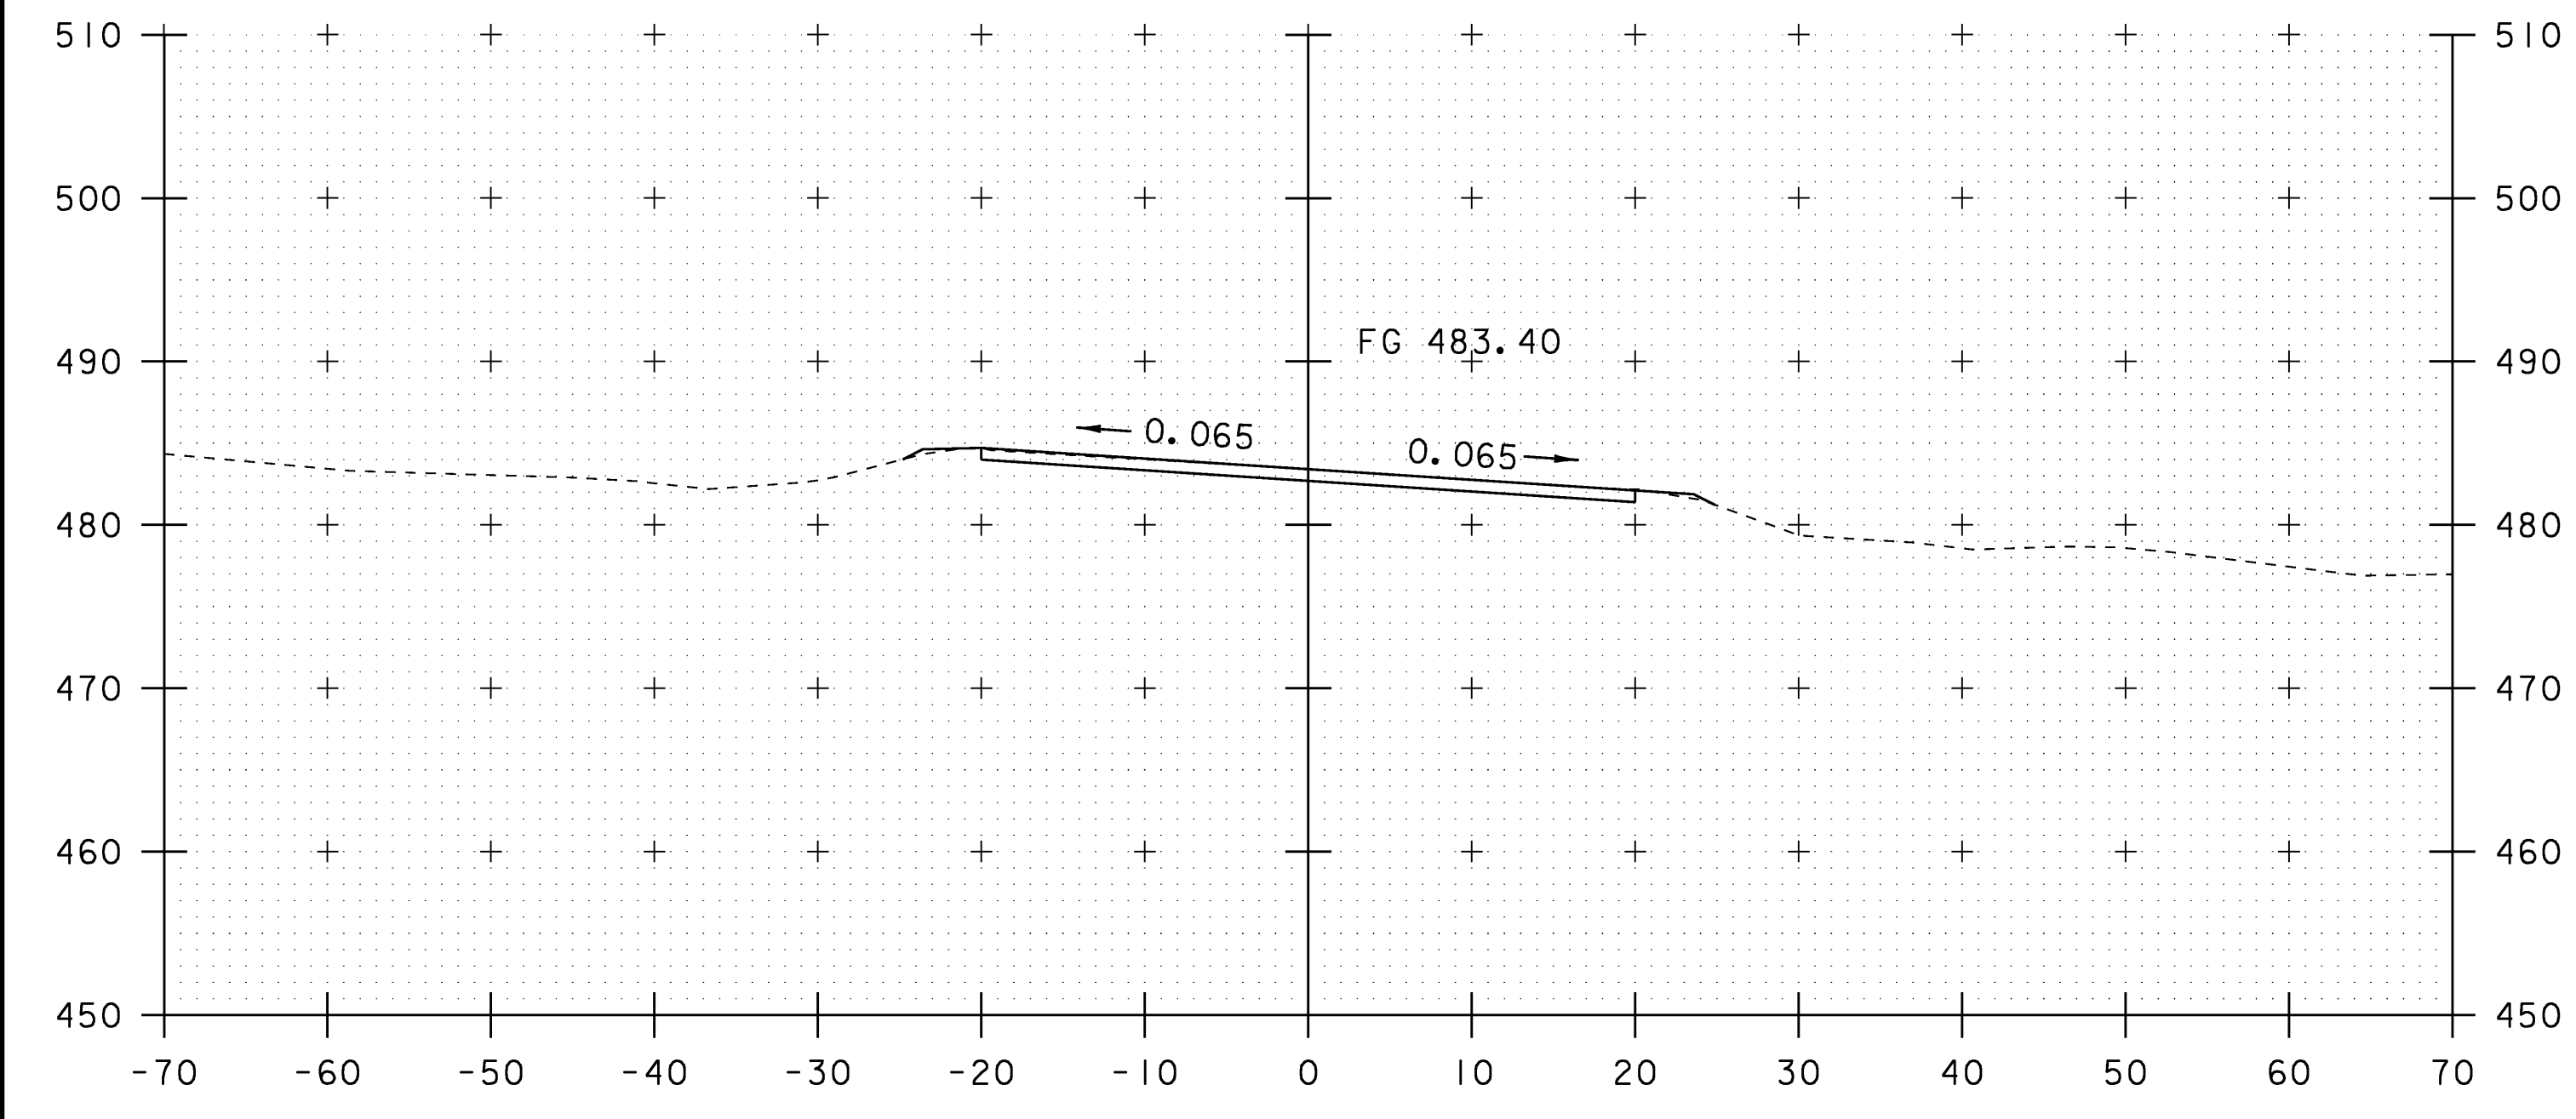

132+25

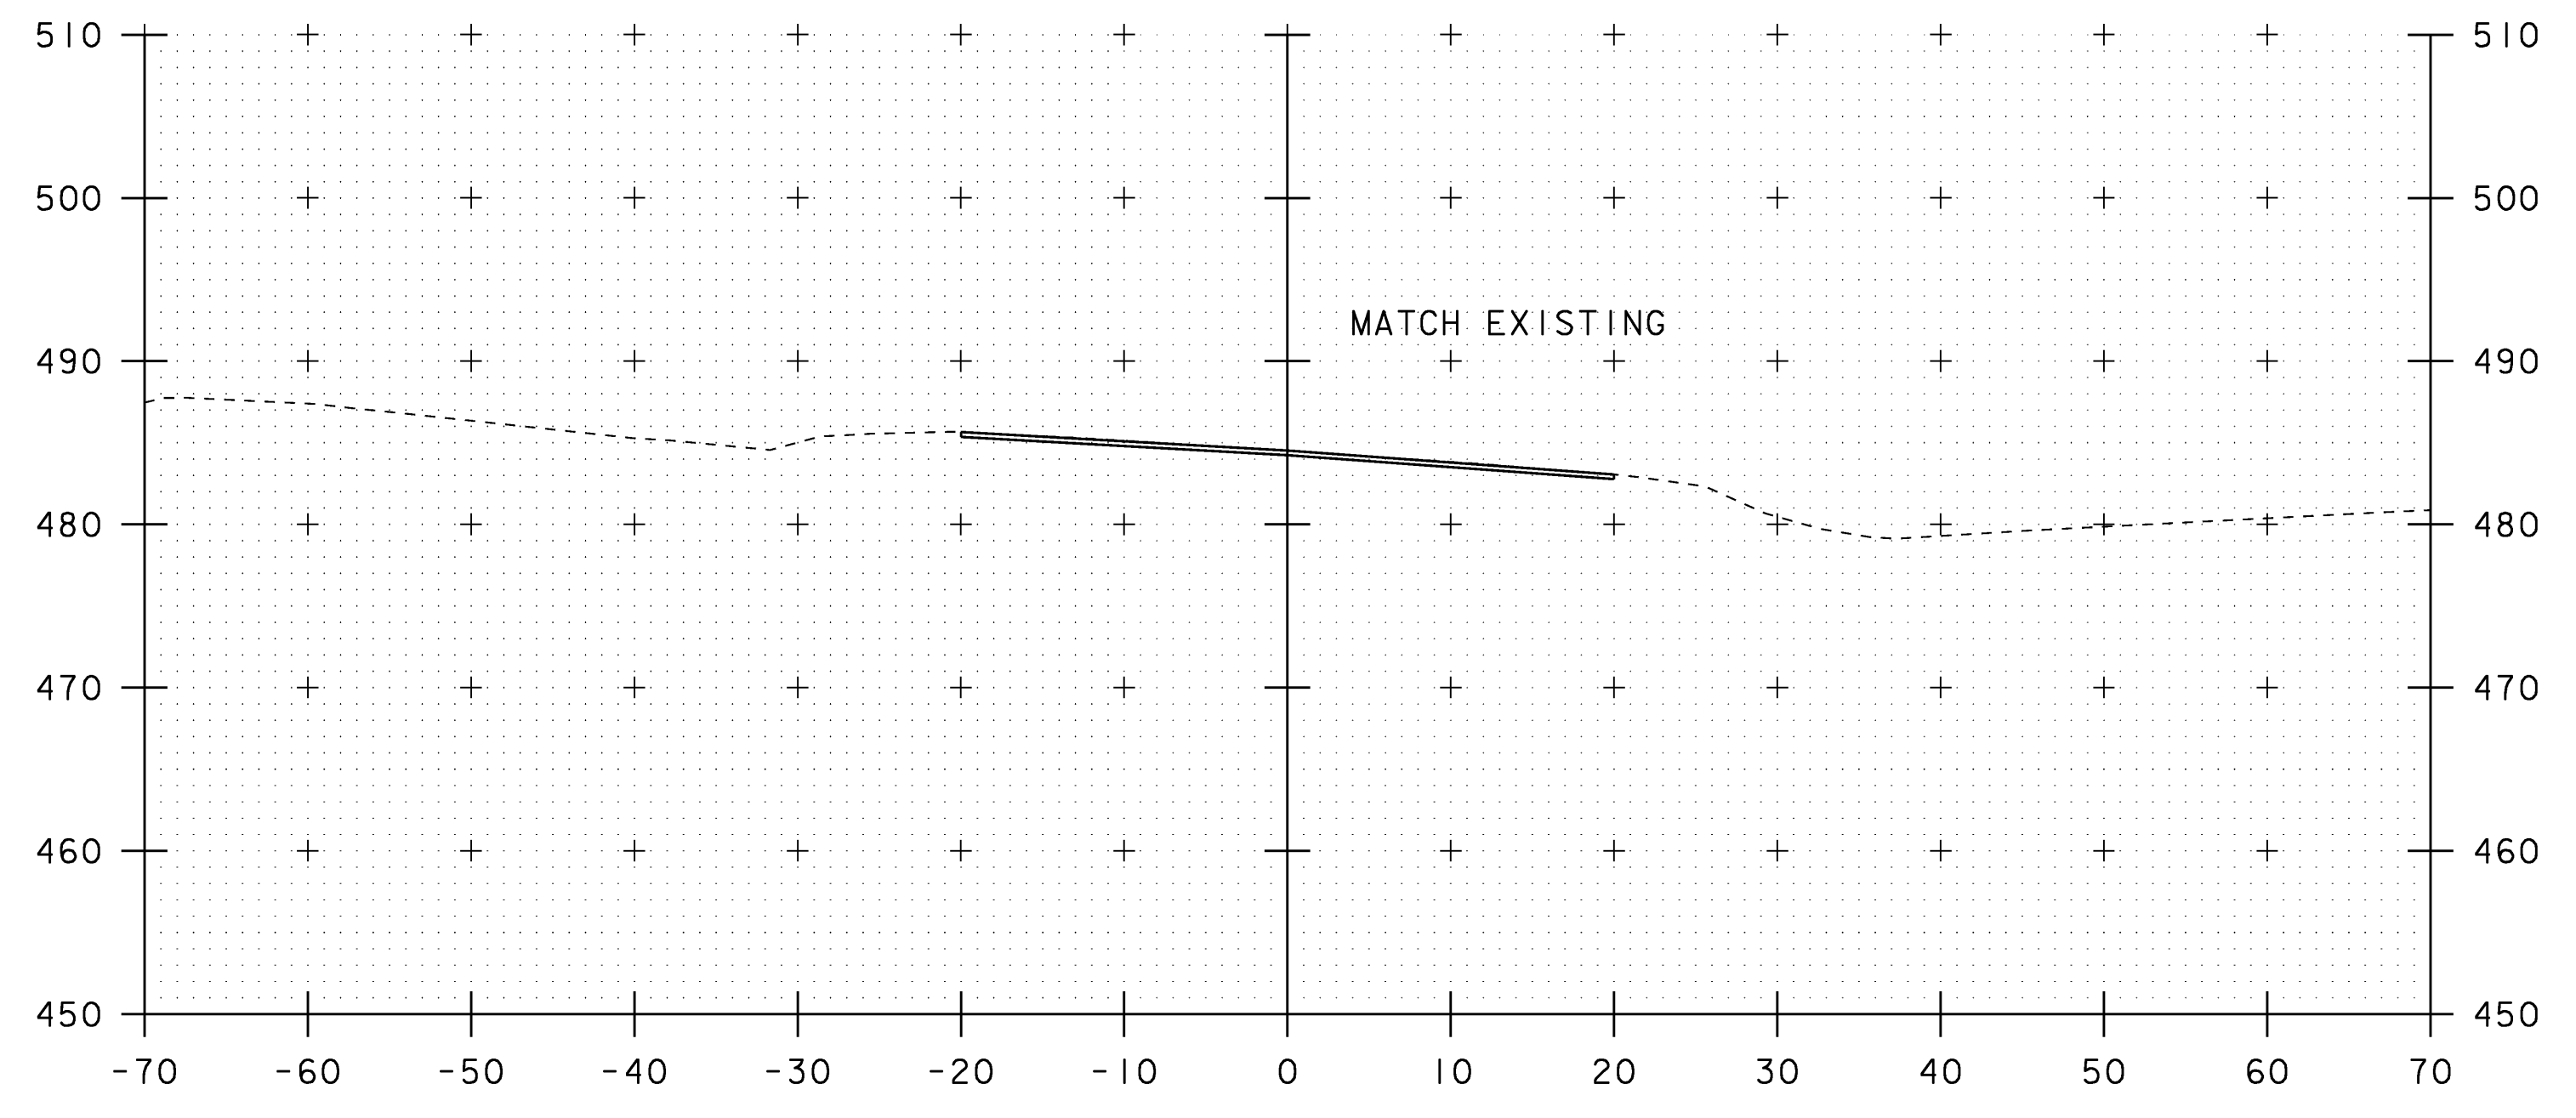

132+75

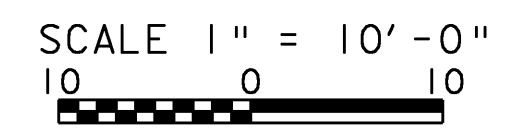

STA. 132+25 TO STA. 133+00

PROJECT NAME: ROCKINGHAM	PROJECT NUMBER: NH CULV(15)
DESIGN FILE NAME: M:\Projects\08b064\Structures\08b064.dgn	PLOT DATE: 16-APR-2009
IPARM FILE NAME: s08b064mx5.l	DRAWN BY: M.FESSEL
SQUAD LEADER: K.M.HIGGINS	CHECKED BY: J.SALVATORI
DESIGNED BY: J.SALVATORI	SHEET 24 OF 27
MAINLINE SECTION - SHEET 5	