



STA 10+18.00 LT    BEGIN STONE FILL, TYPE IV  
 BEGIN GRUBBING MATERIAL  
 BEGIN UNCLASSIFIED CHANNEL EXCAVATION  
 BEGIN GEOTEXTILE UNDER STONE FILL


STA 10+20.00 RT    BEGIN STONE FILL, TYPE IV  
 BEGIN GRUBBING MATERIAL  
 BEGIN UNCLASSIFIED CHANNEL EXCAVATION  
 BEGIN GEOTEXTILE UNDER STONE FILL

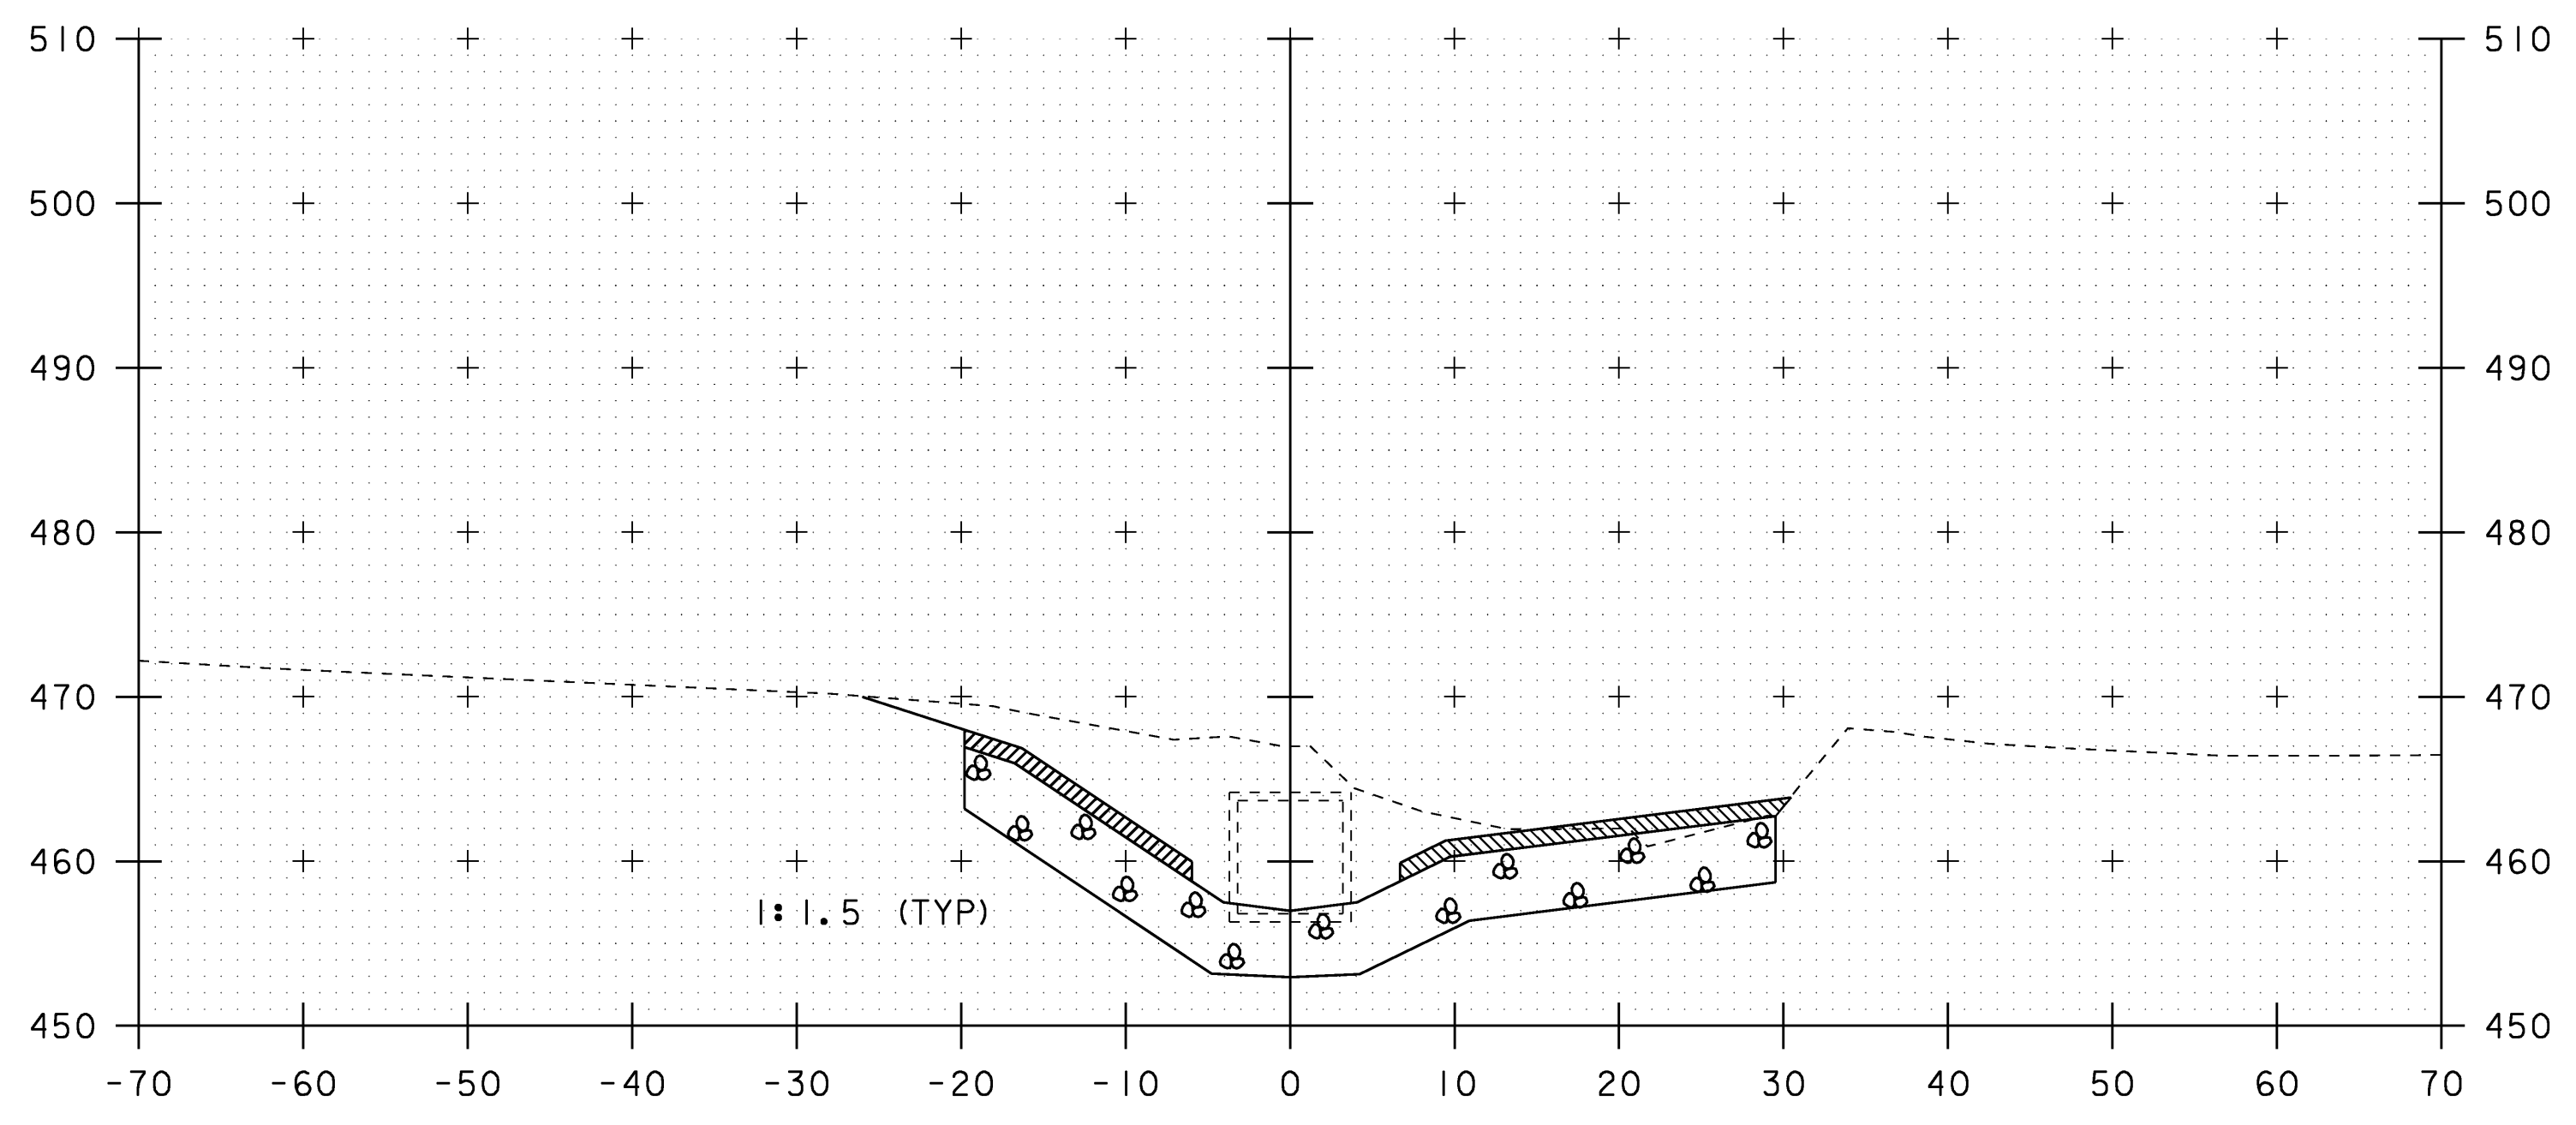


10+25

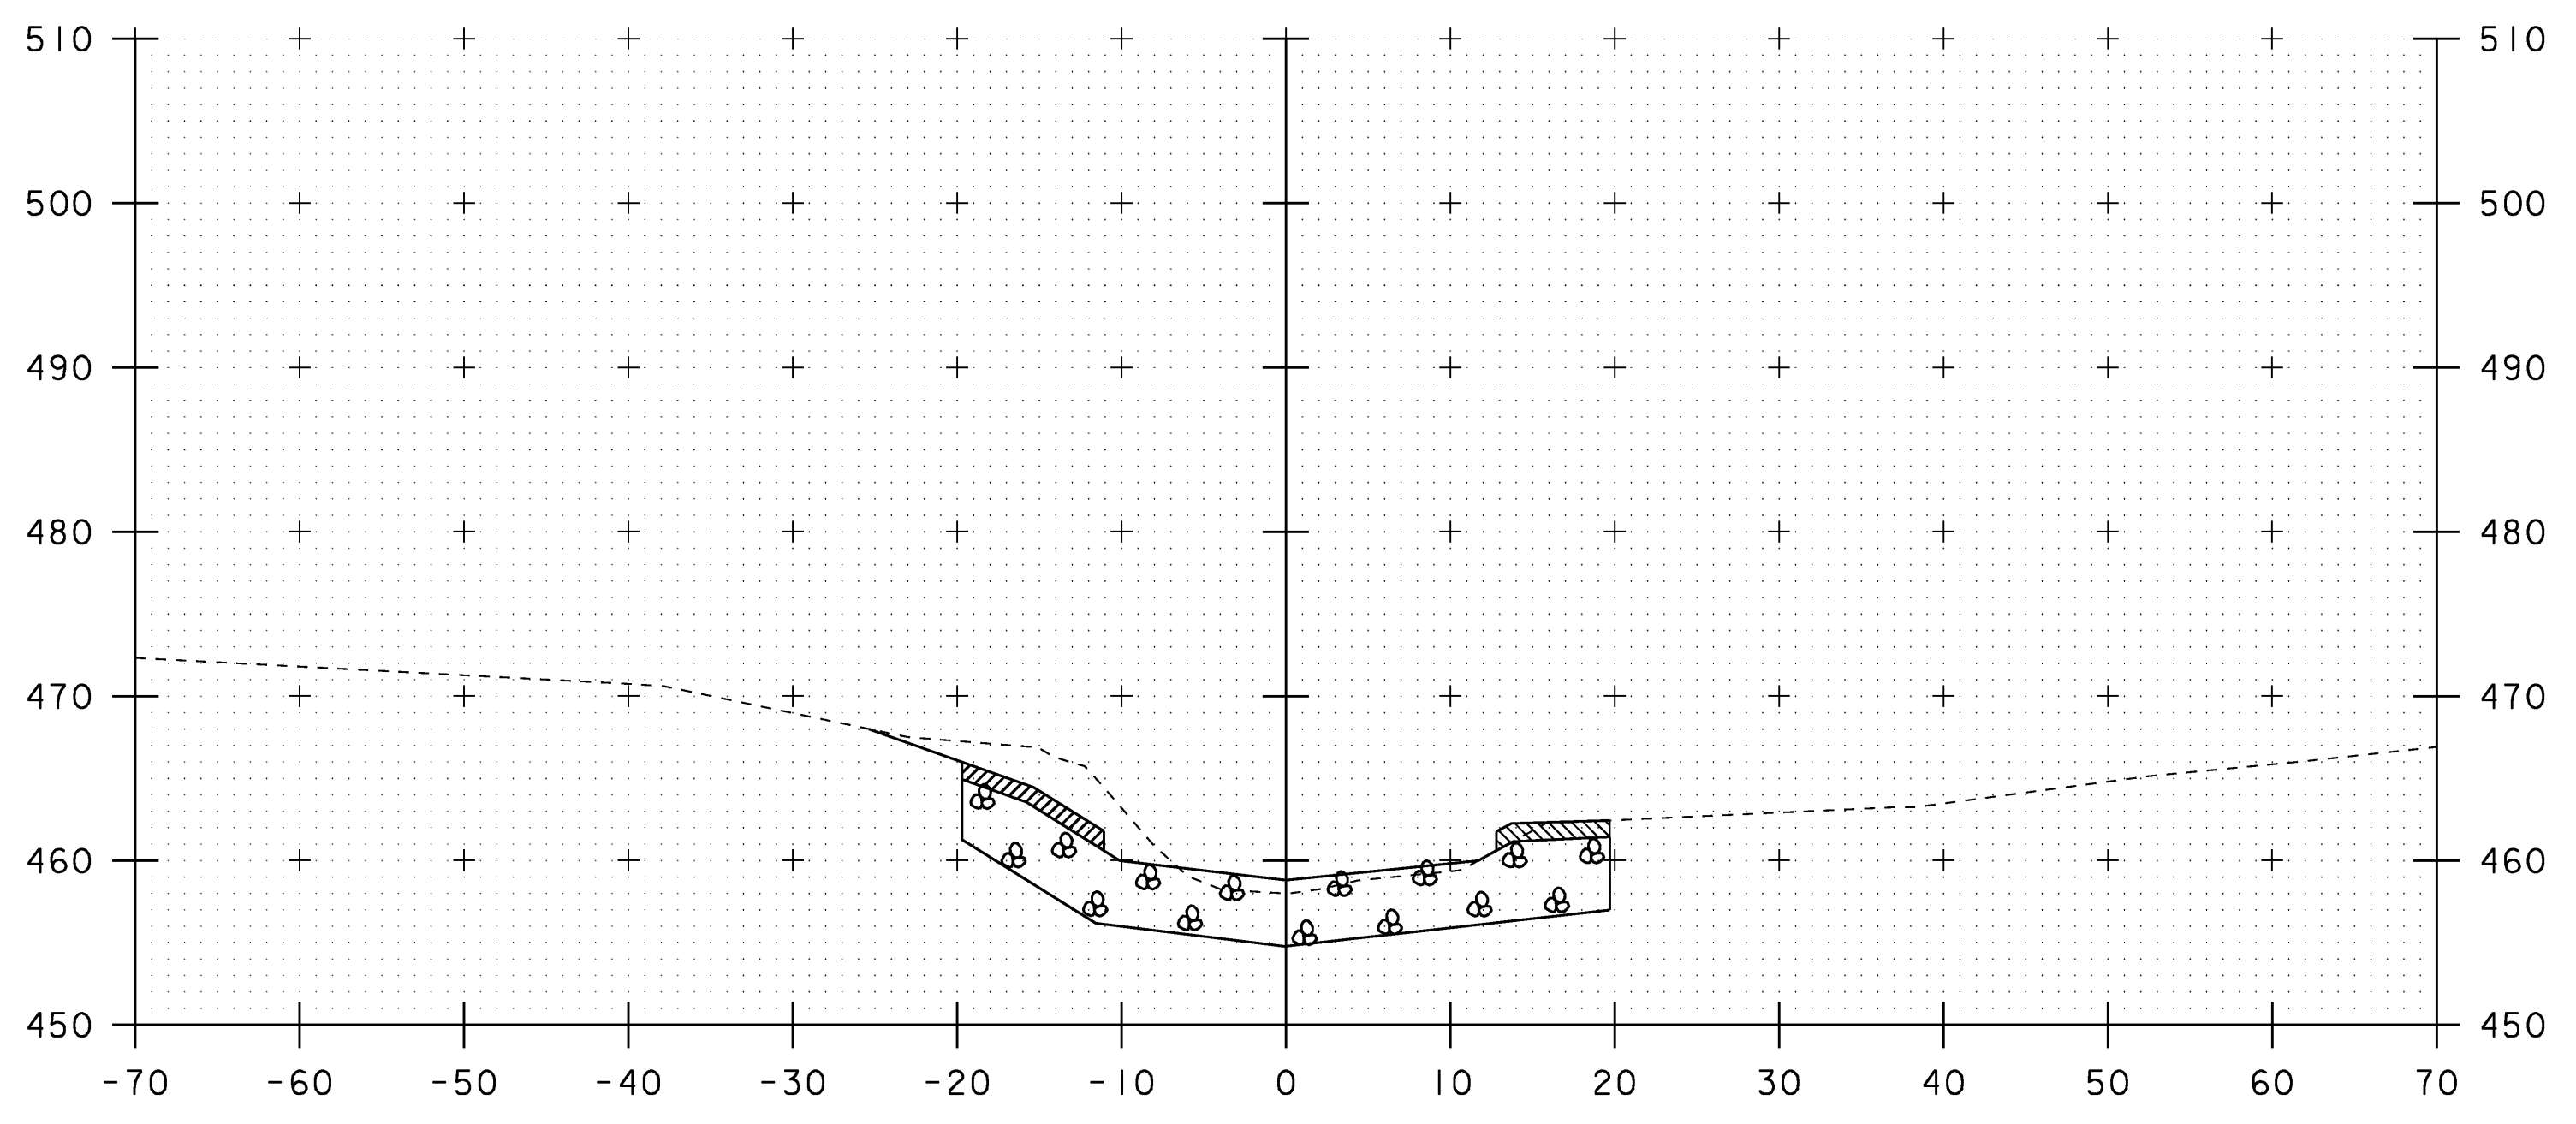

10+75

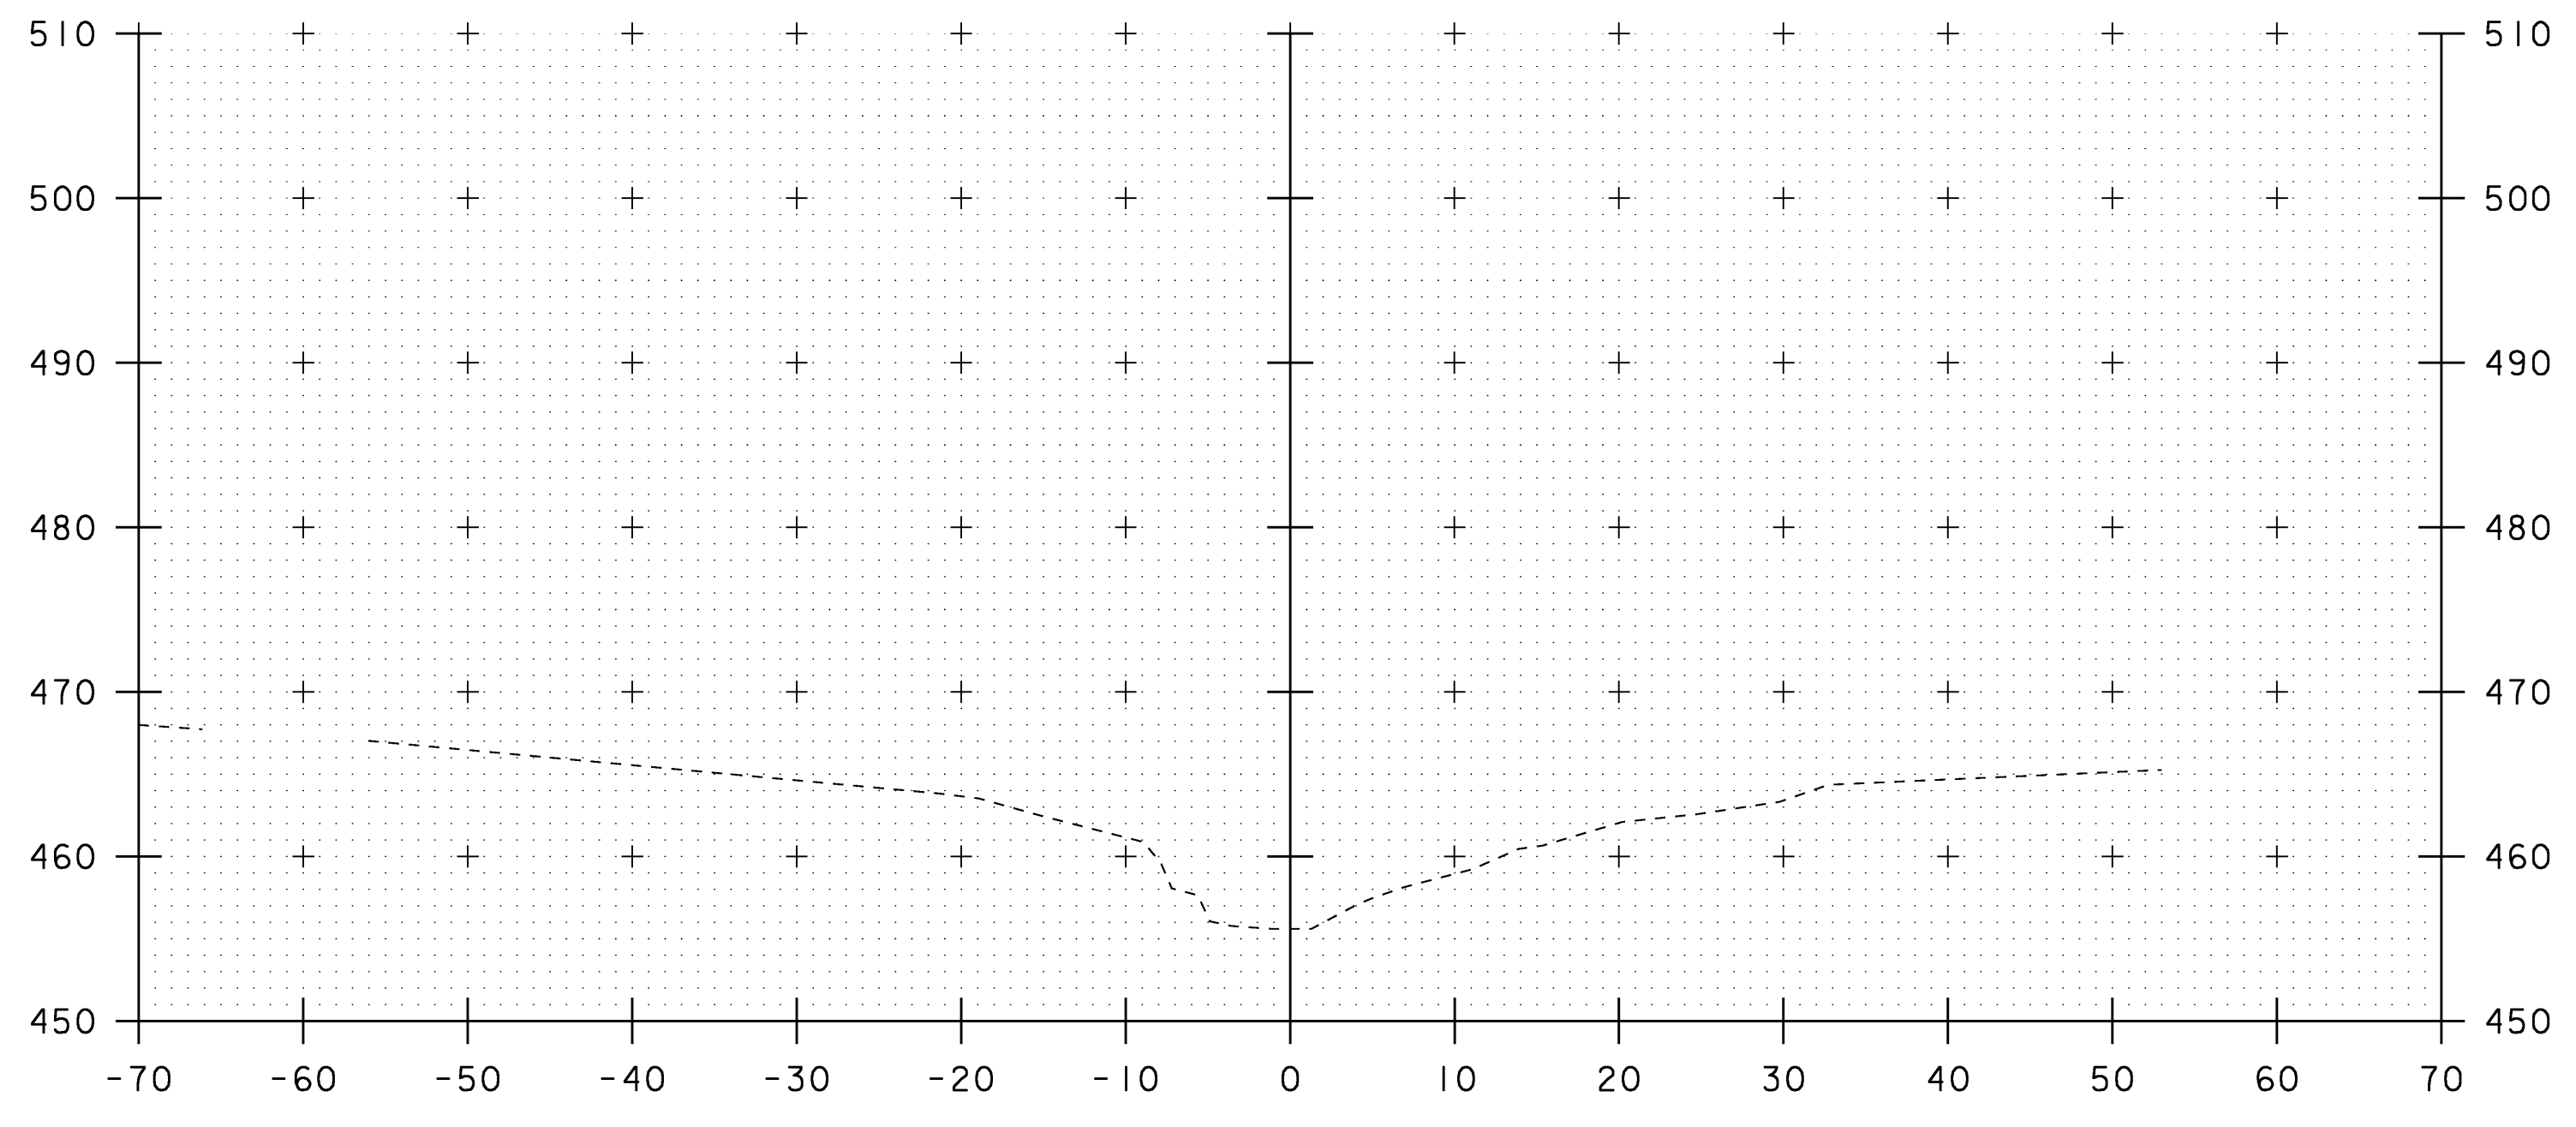

10+00

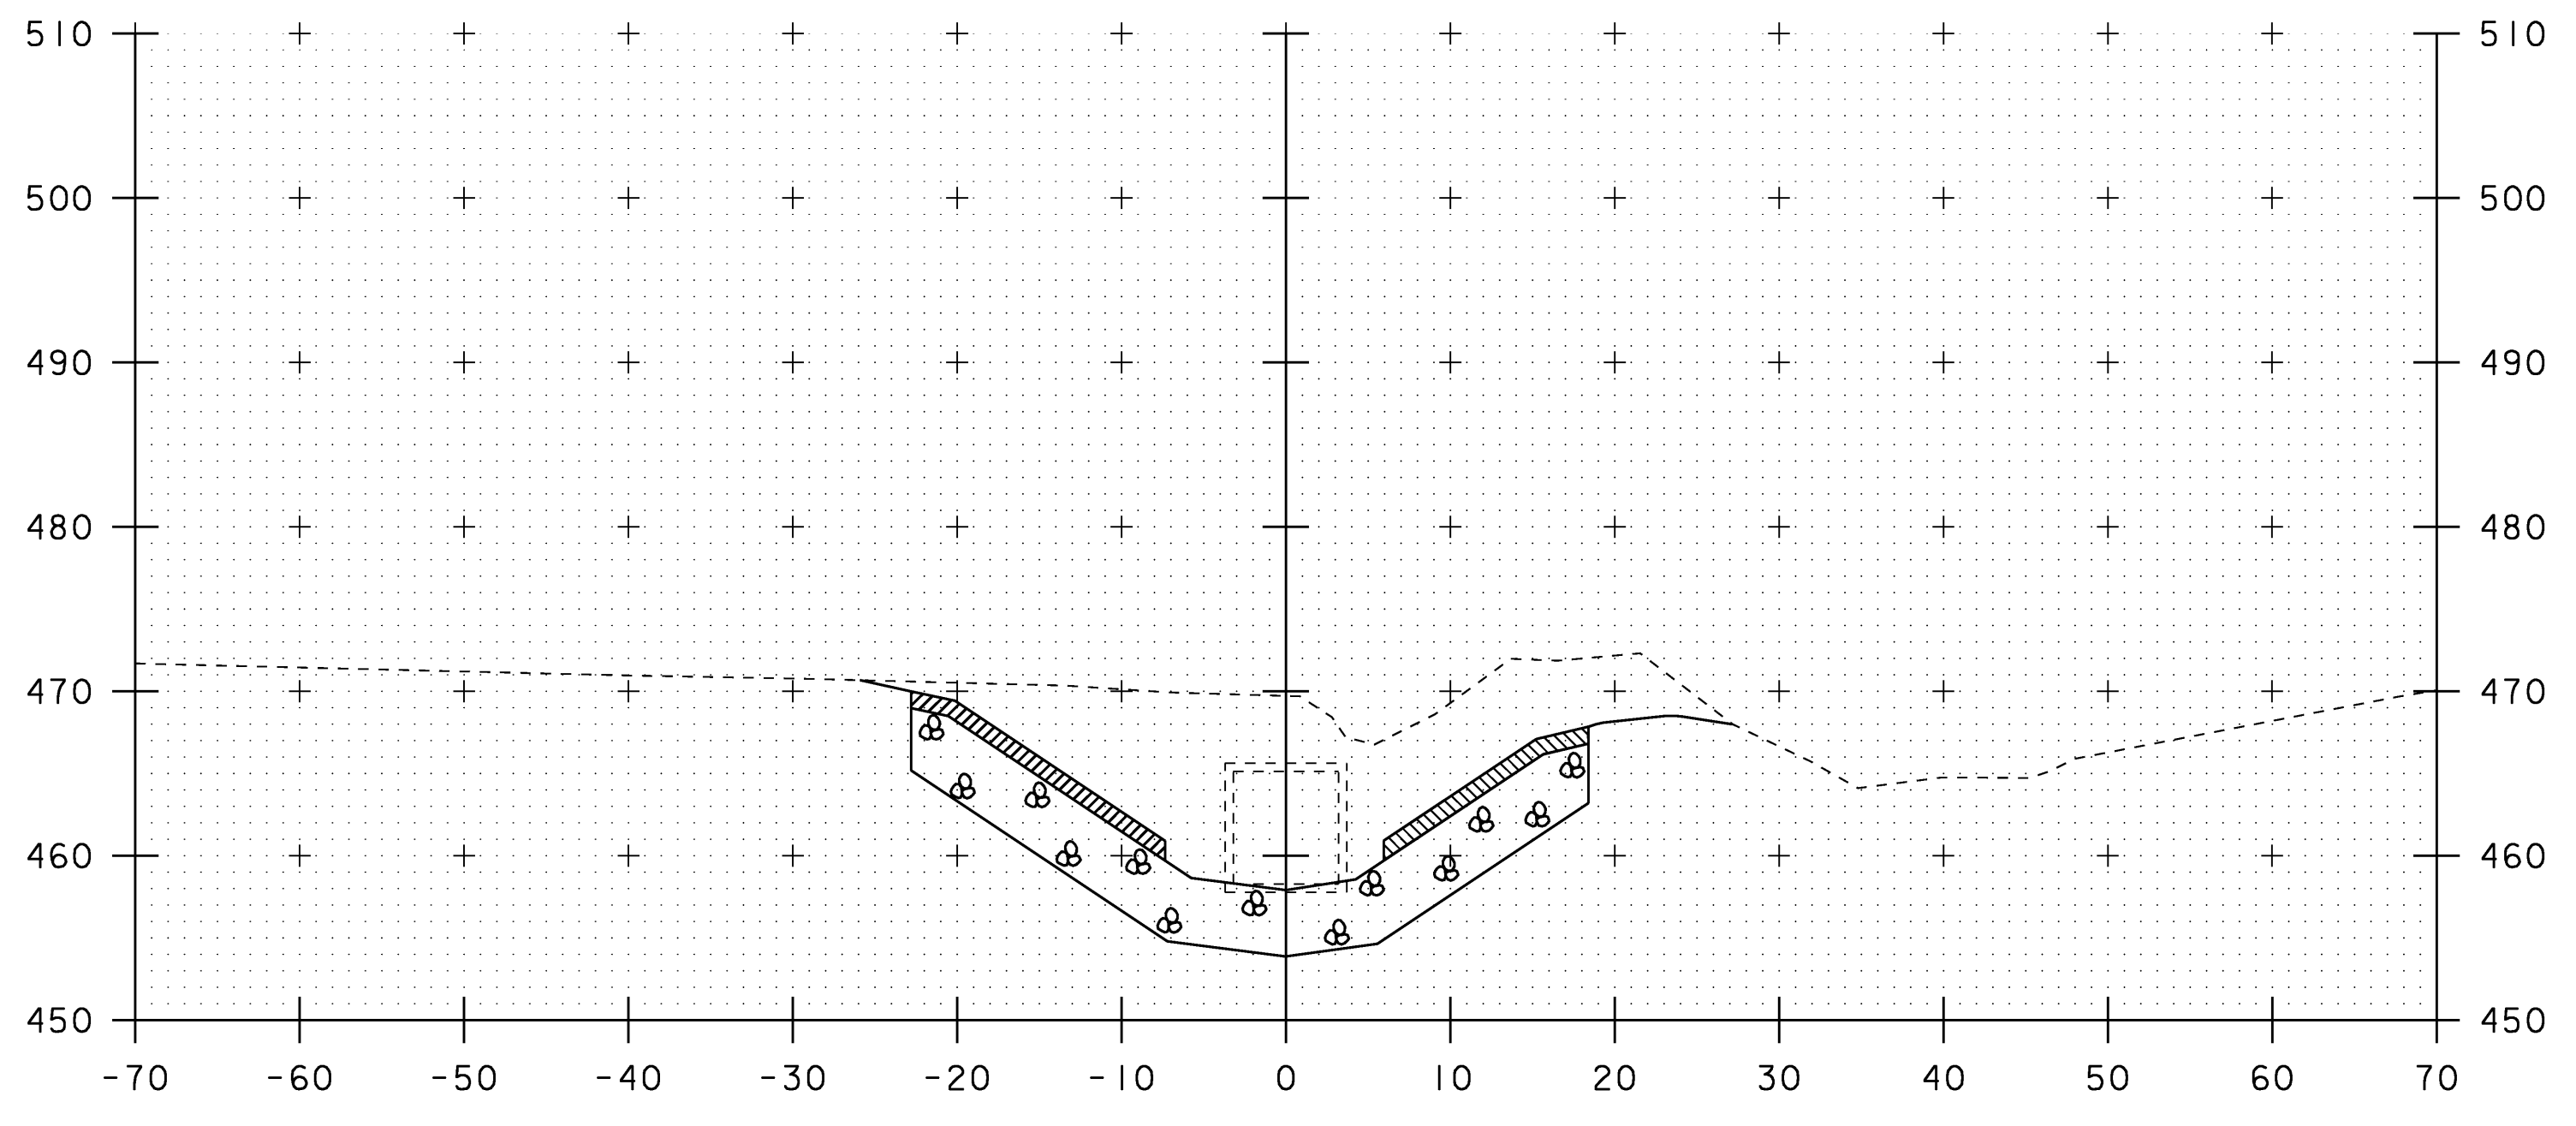

10+50

SCALE 1" = 10'-0"  
 10 0 10

STA. 10+00 TO STA. 10+75

PROJECT NAME: ROCKINGHAM	PROJECT NUMBER: NH CULV(15)
DESIGN FILE NAME: M:\Projects\08b064\Structures\08b064xsl.dgn	PLOT DATE: 16-APR-2009
IPARM FILE NAME: s08b064cxl.l	DRAWN BY: M.FESSEL
SQUAD LEADER: K.M.HIGGINS	CHECKED BY: J.SALVATORI
DESIGNED BY: J.SALVATORI	SHEET 25 OF 27
CHANNEL SECTION - SHEET 1	