




11+25

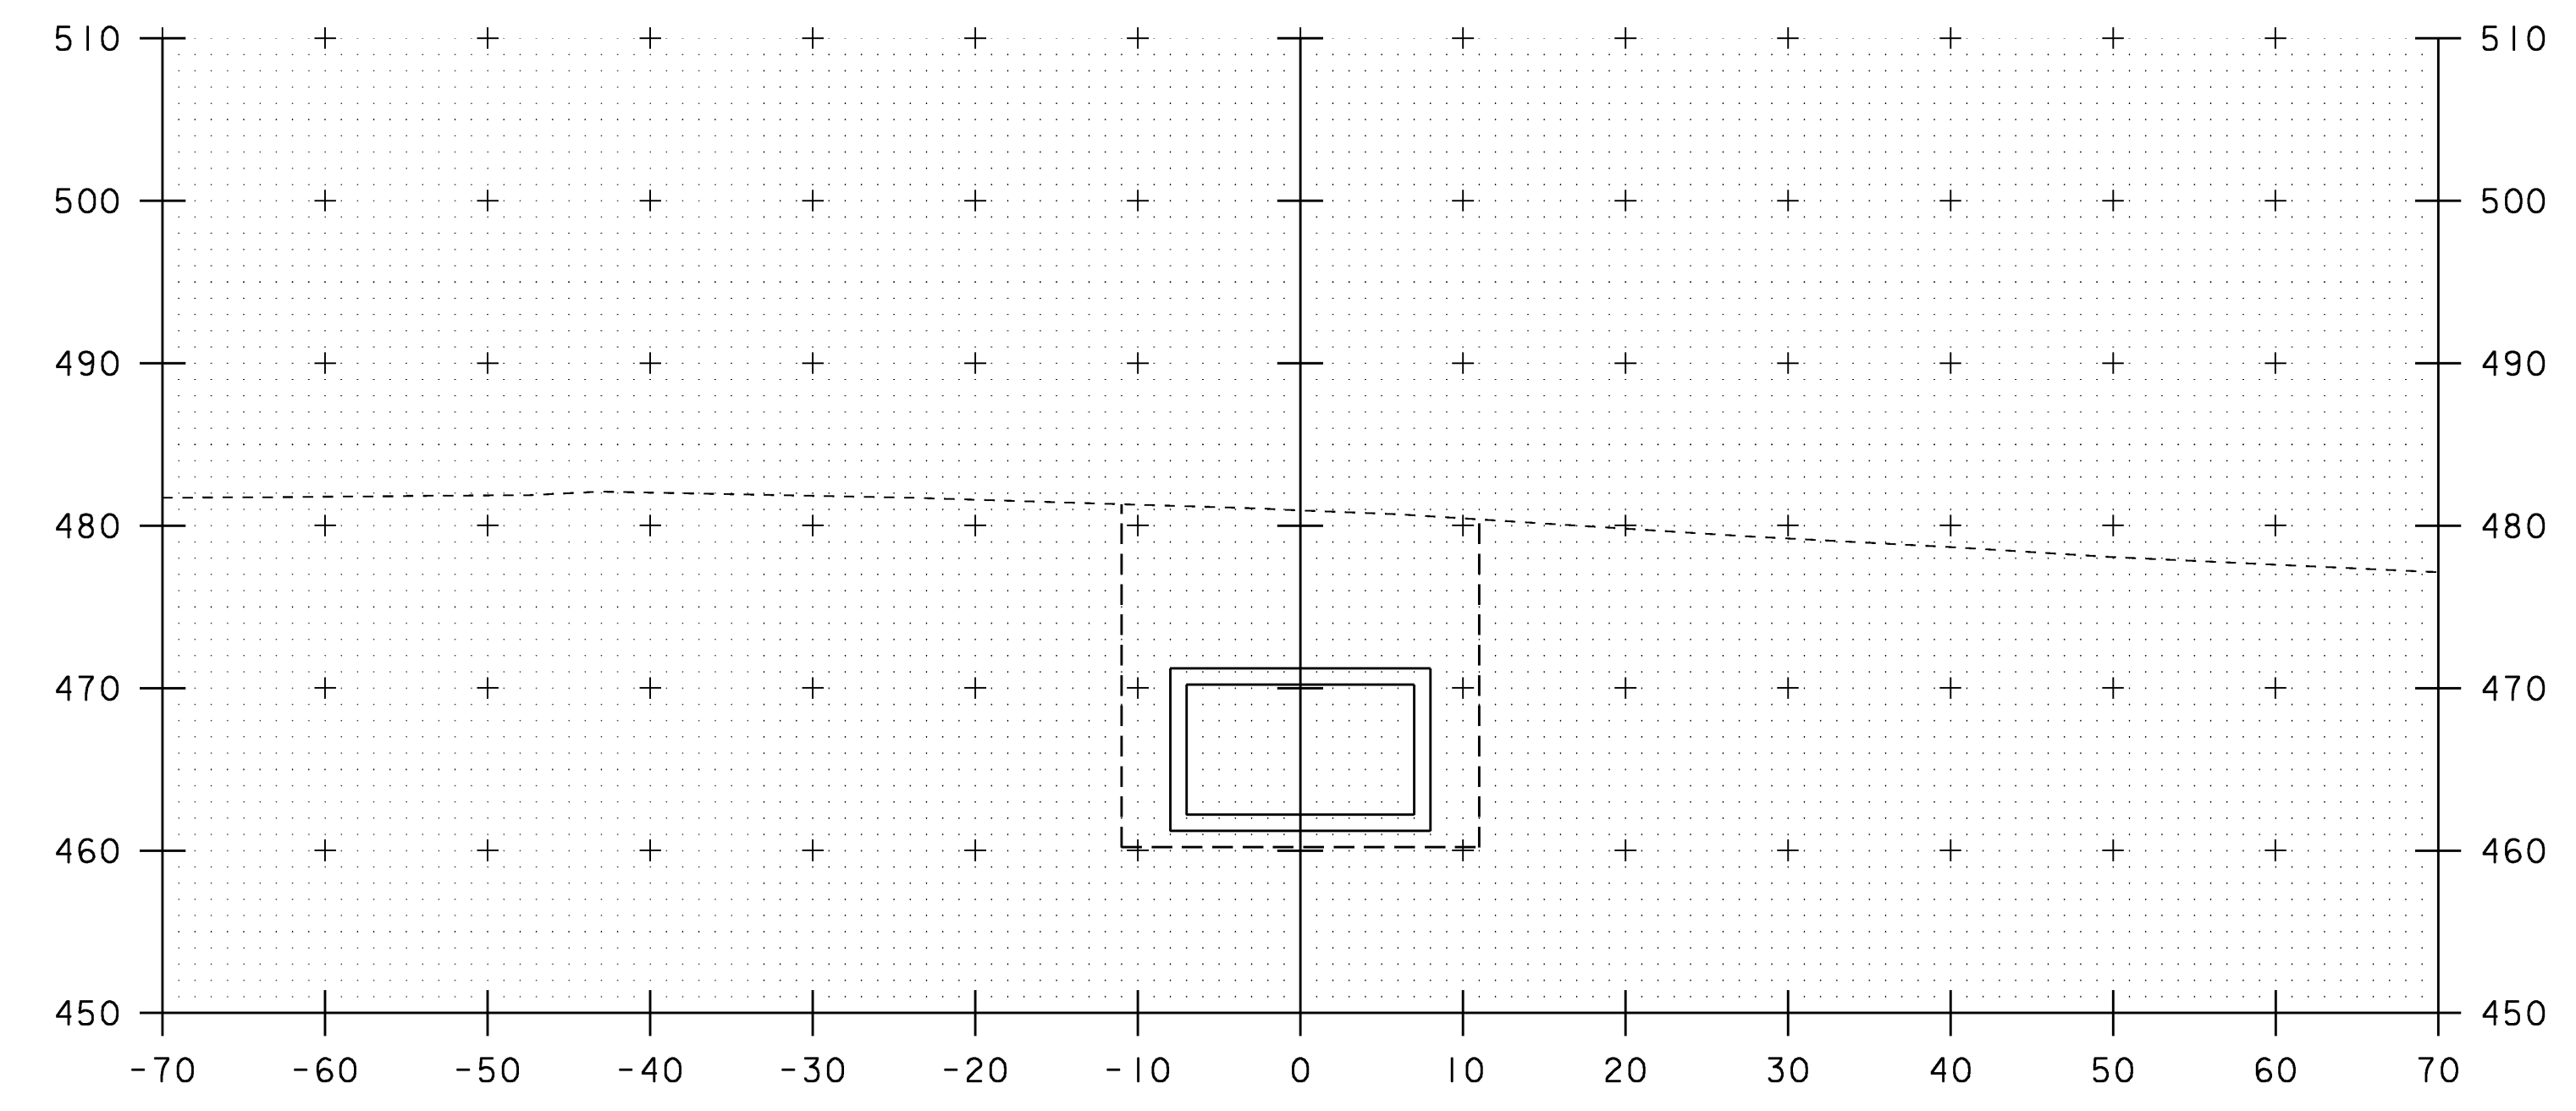

11+75

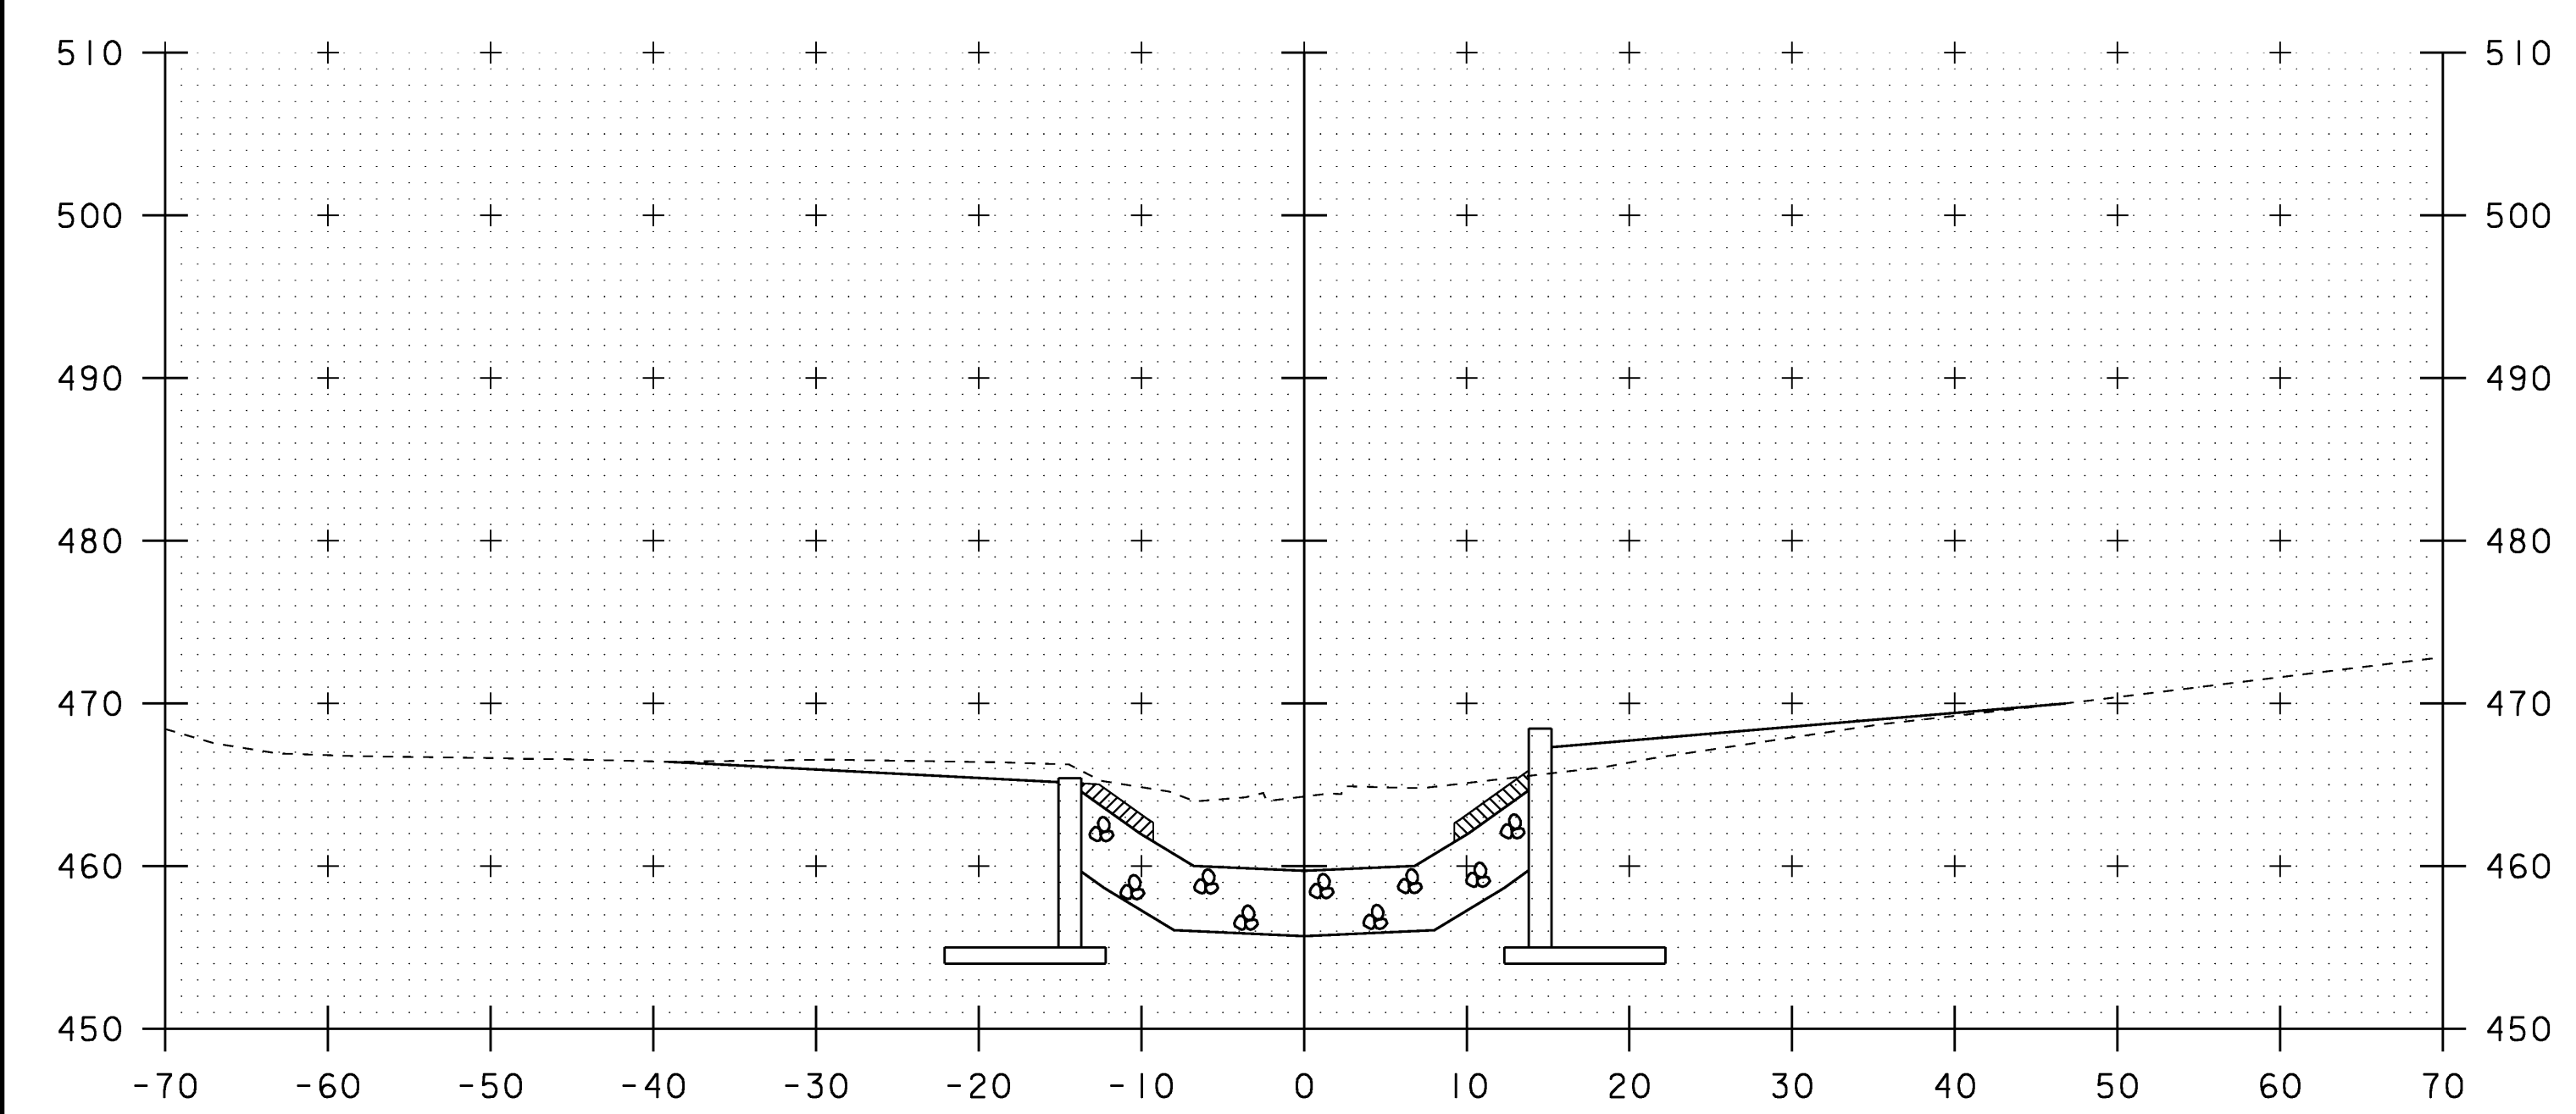


11+00

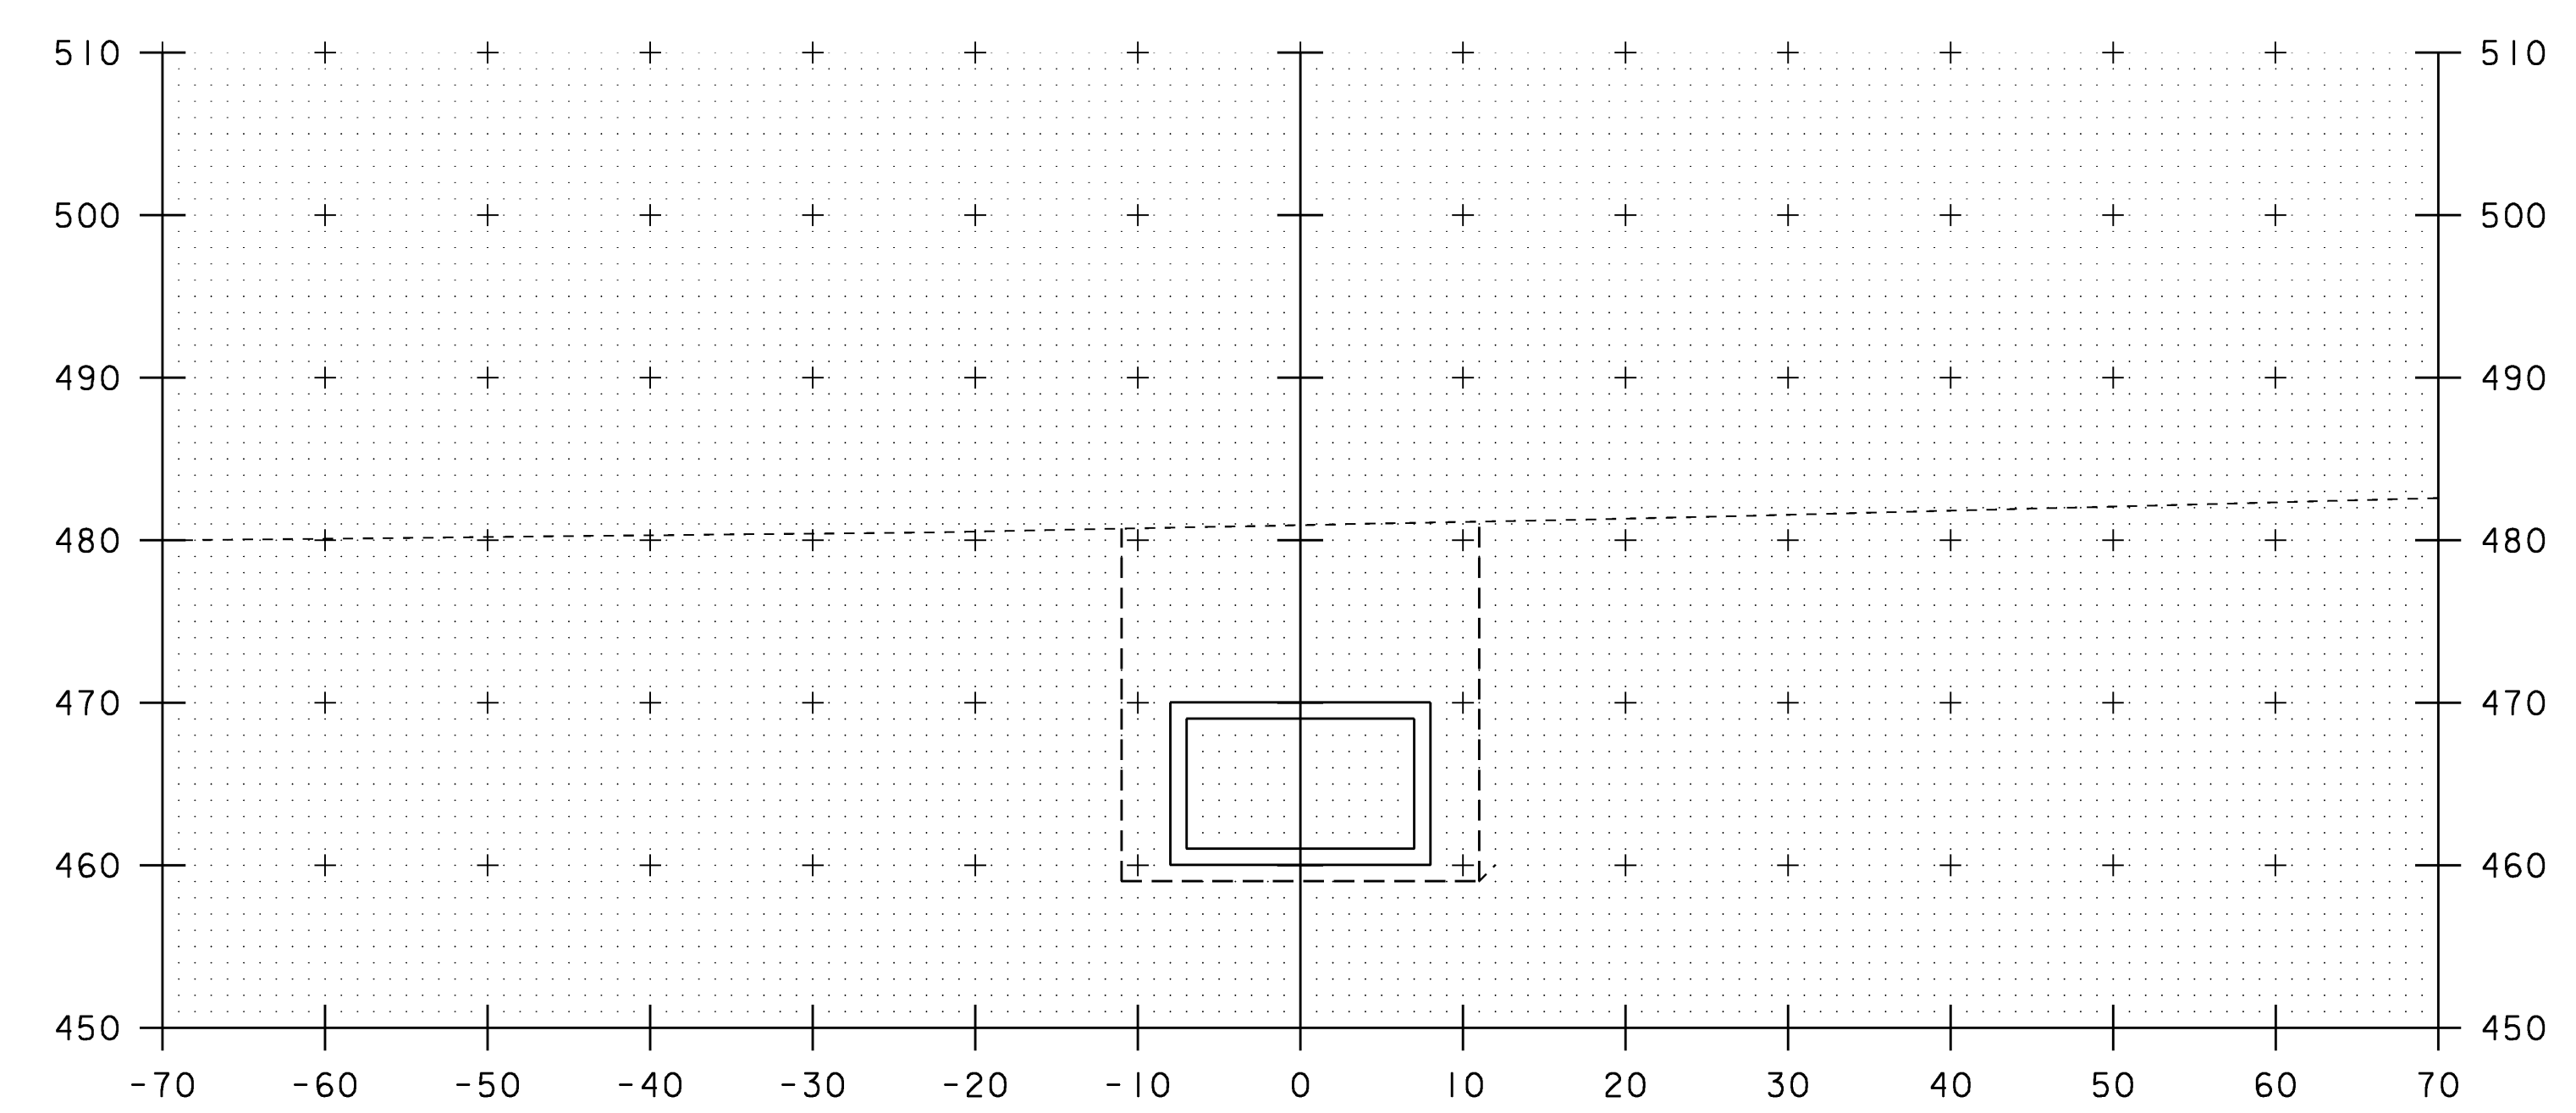

11+50

STA 11+07.50 LT/RT END STONE FILL, TYPE IV
 END GRUBBING MATERIAL
 END UNCLASSIFIED CHANNEL EXCAVATION
 END GEOTEXTILE UNDER STONE FILL

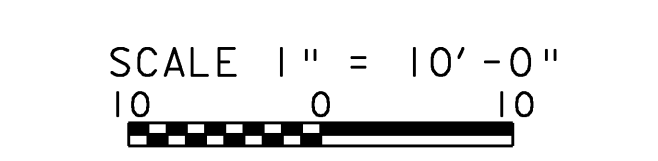

STA. 11+00 TO STA. 11+75

PROJECT NAME: ROCKINGHAM	PROJECT NUMBER: NH CULV(15)
DESIGN FILE NAME: M:\Projects\08b064\Structures\08b064xsl.dgn	PLOT DATE: 16-APR-2009
IPARM FILE NAME: s08b064cx2.i	DRAWN BY: M.FESSEL
SQUAD LEADER: K.M.HIGGINS	CHECKED BY: J.SALVATORI
DESIGNED BY: J.SALVATORI	SHEET 26 OF 27
CHANNEL SECTION - SHEET 2	