

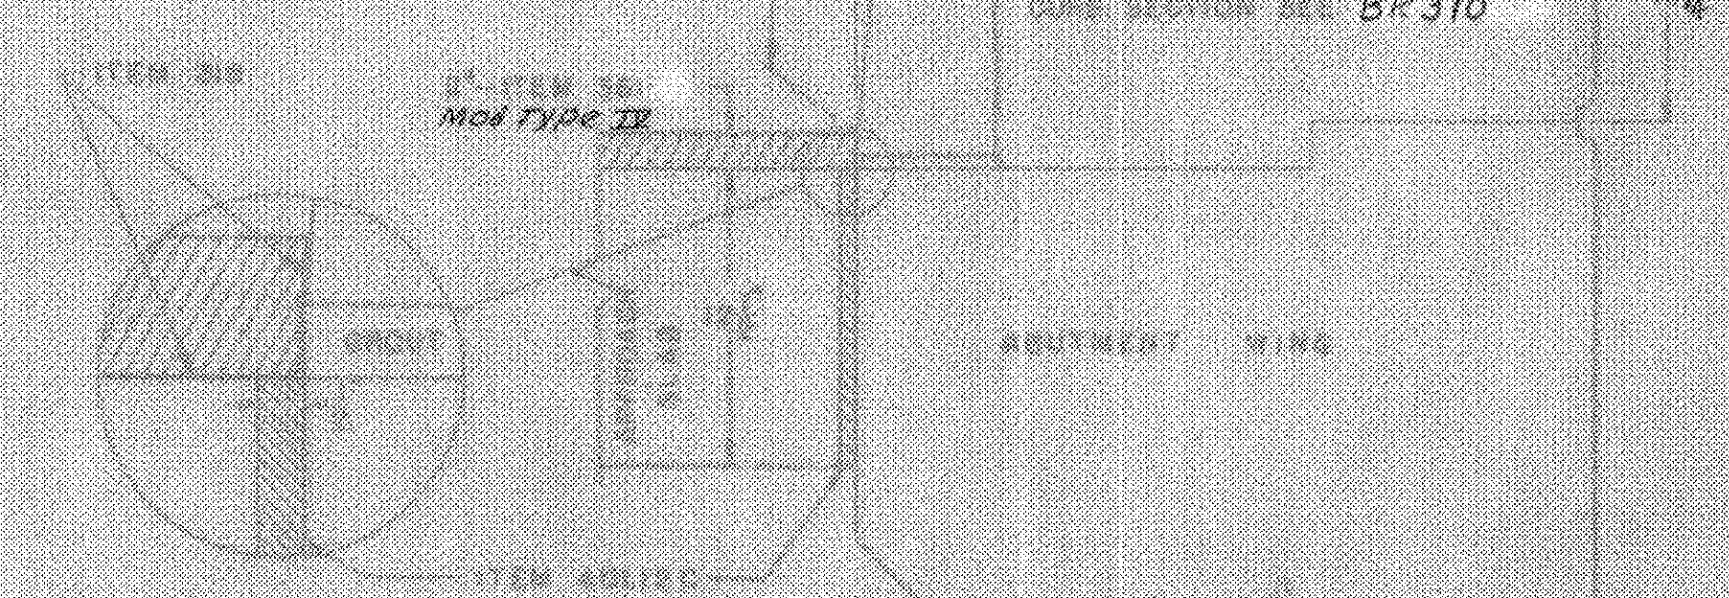
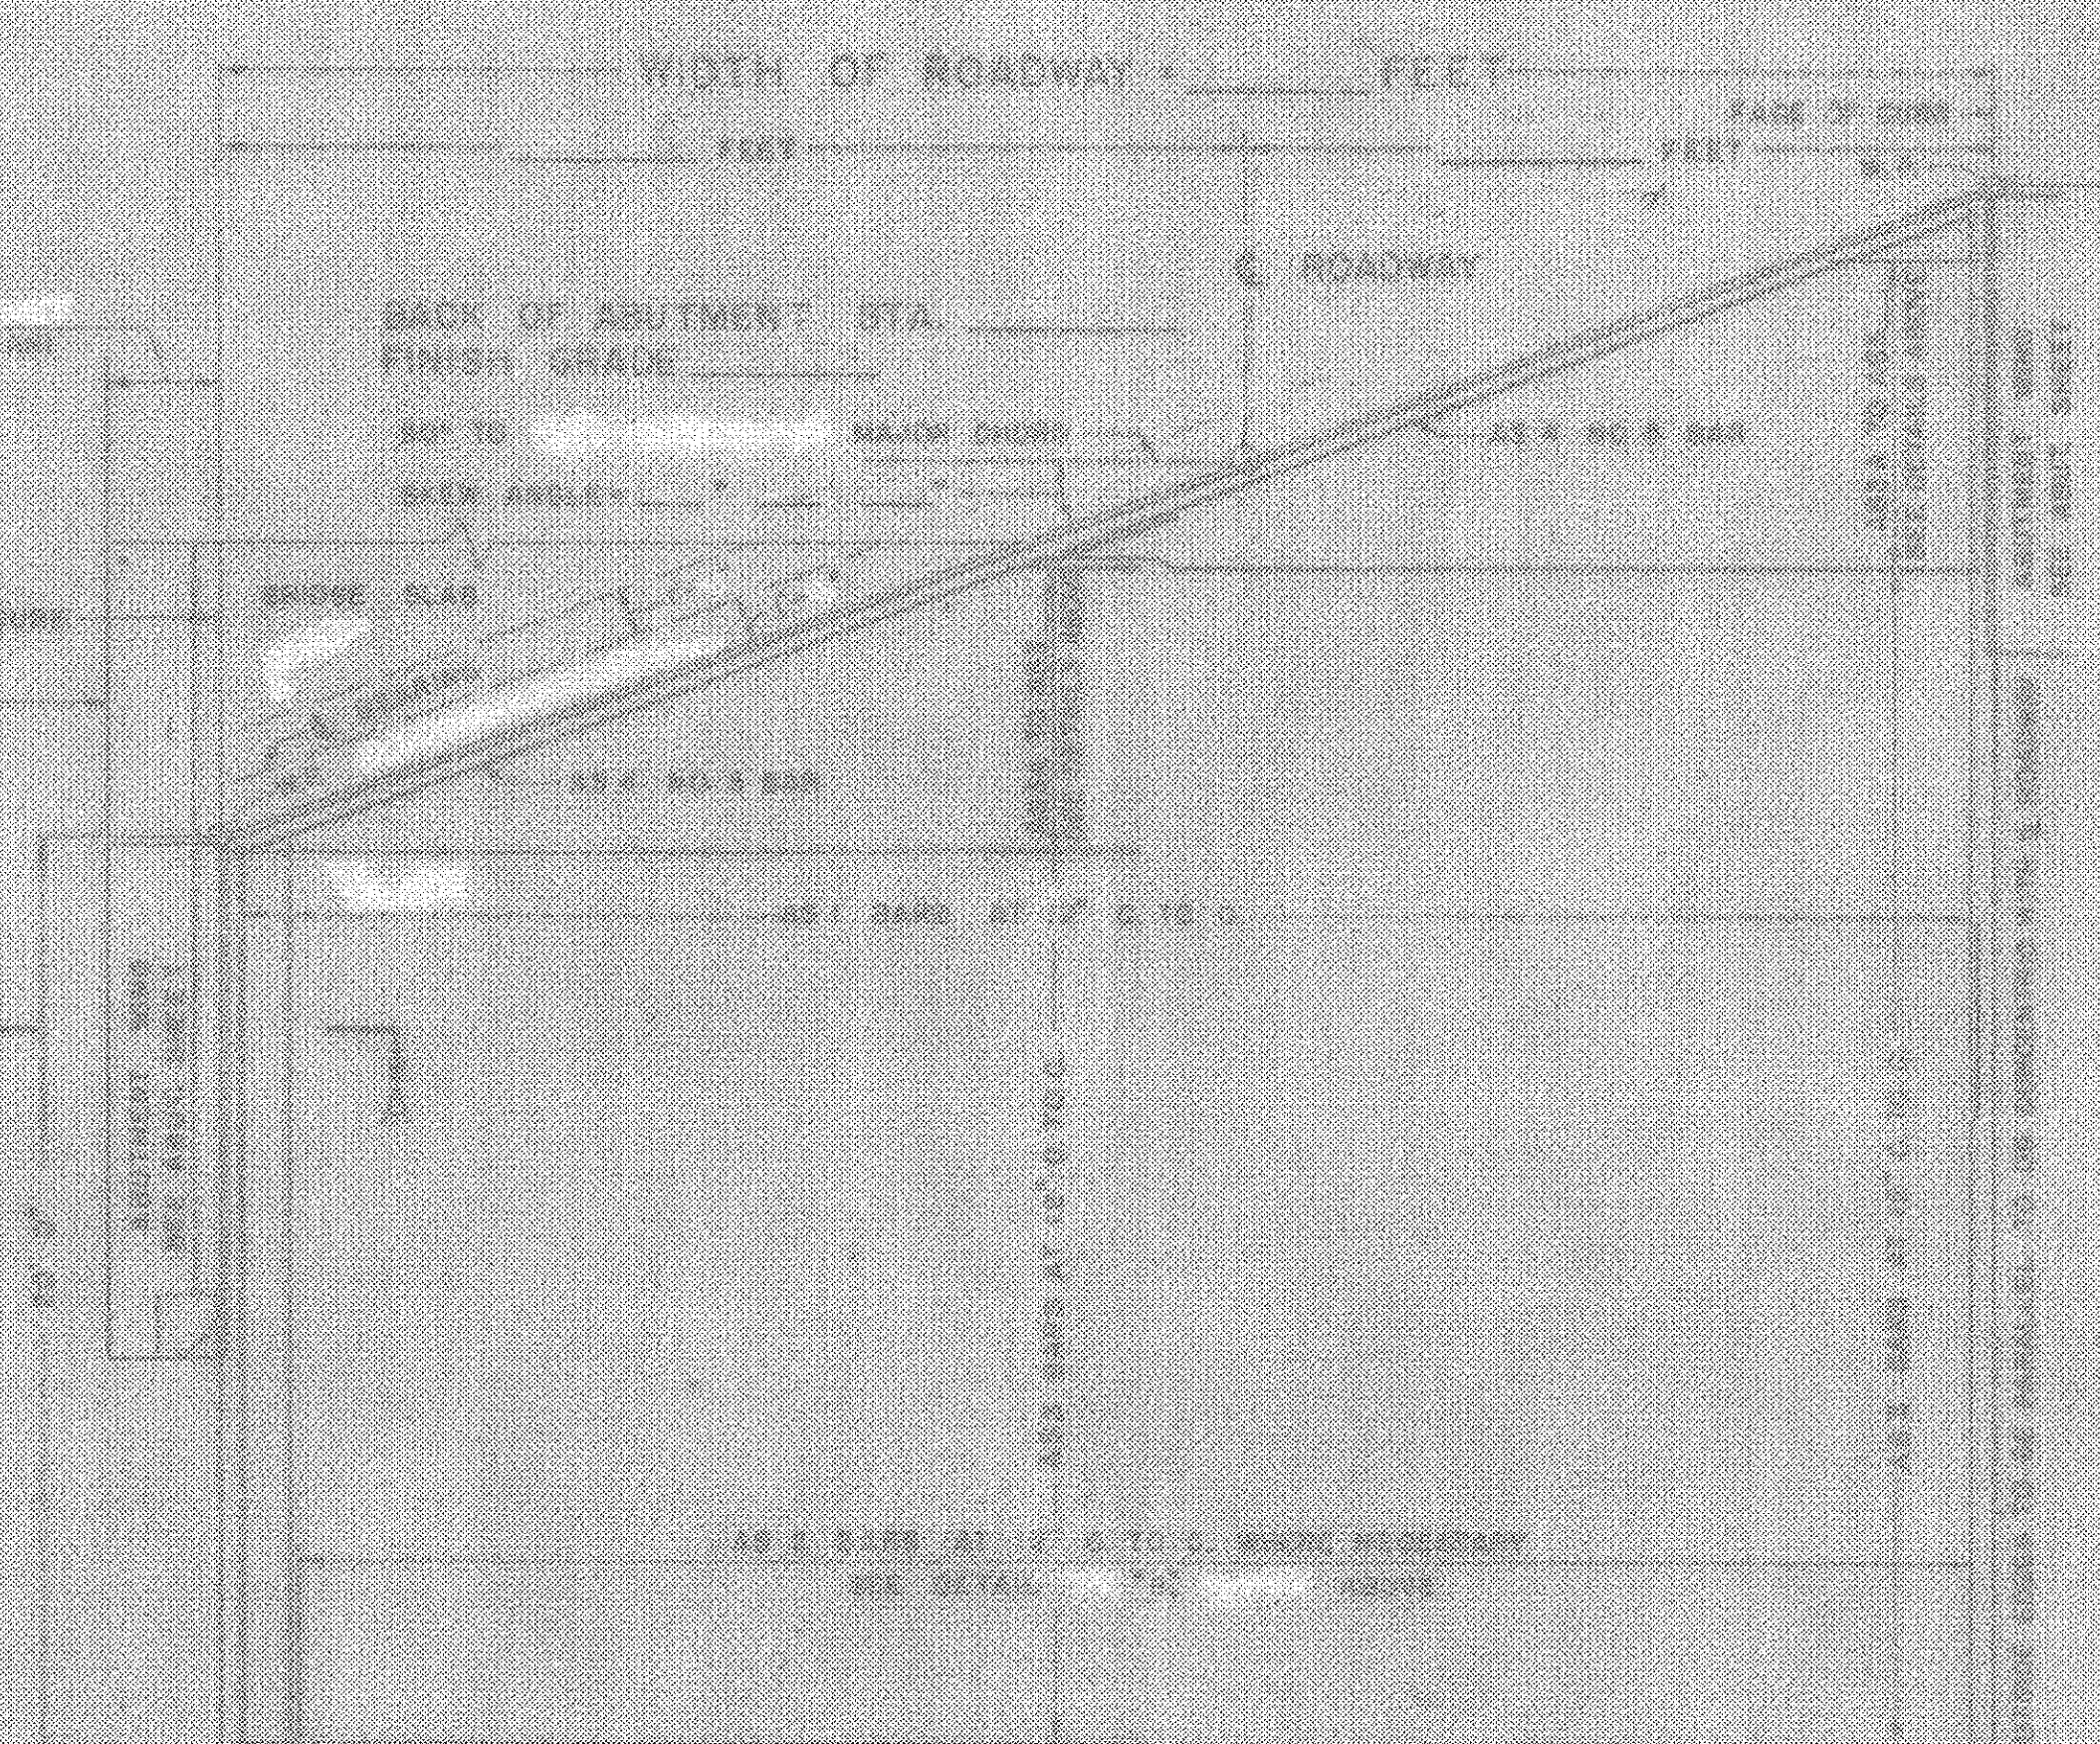
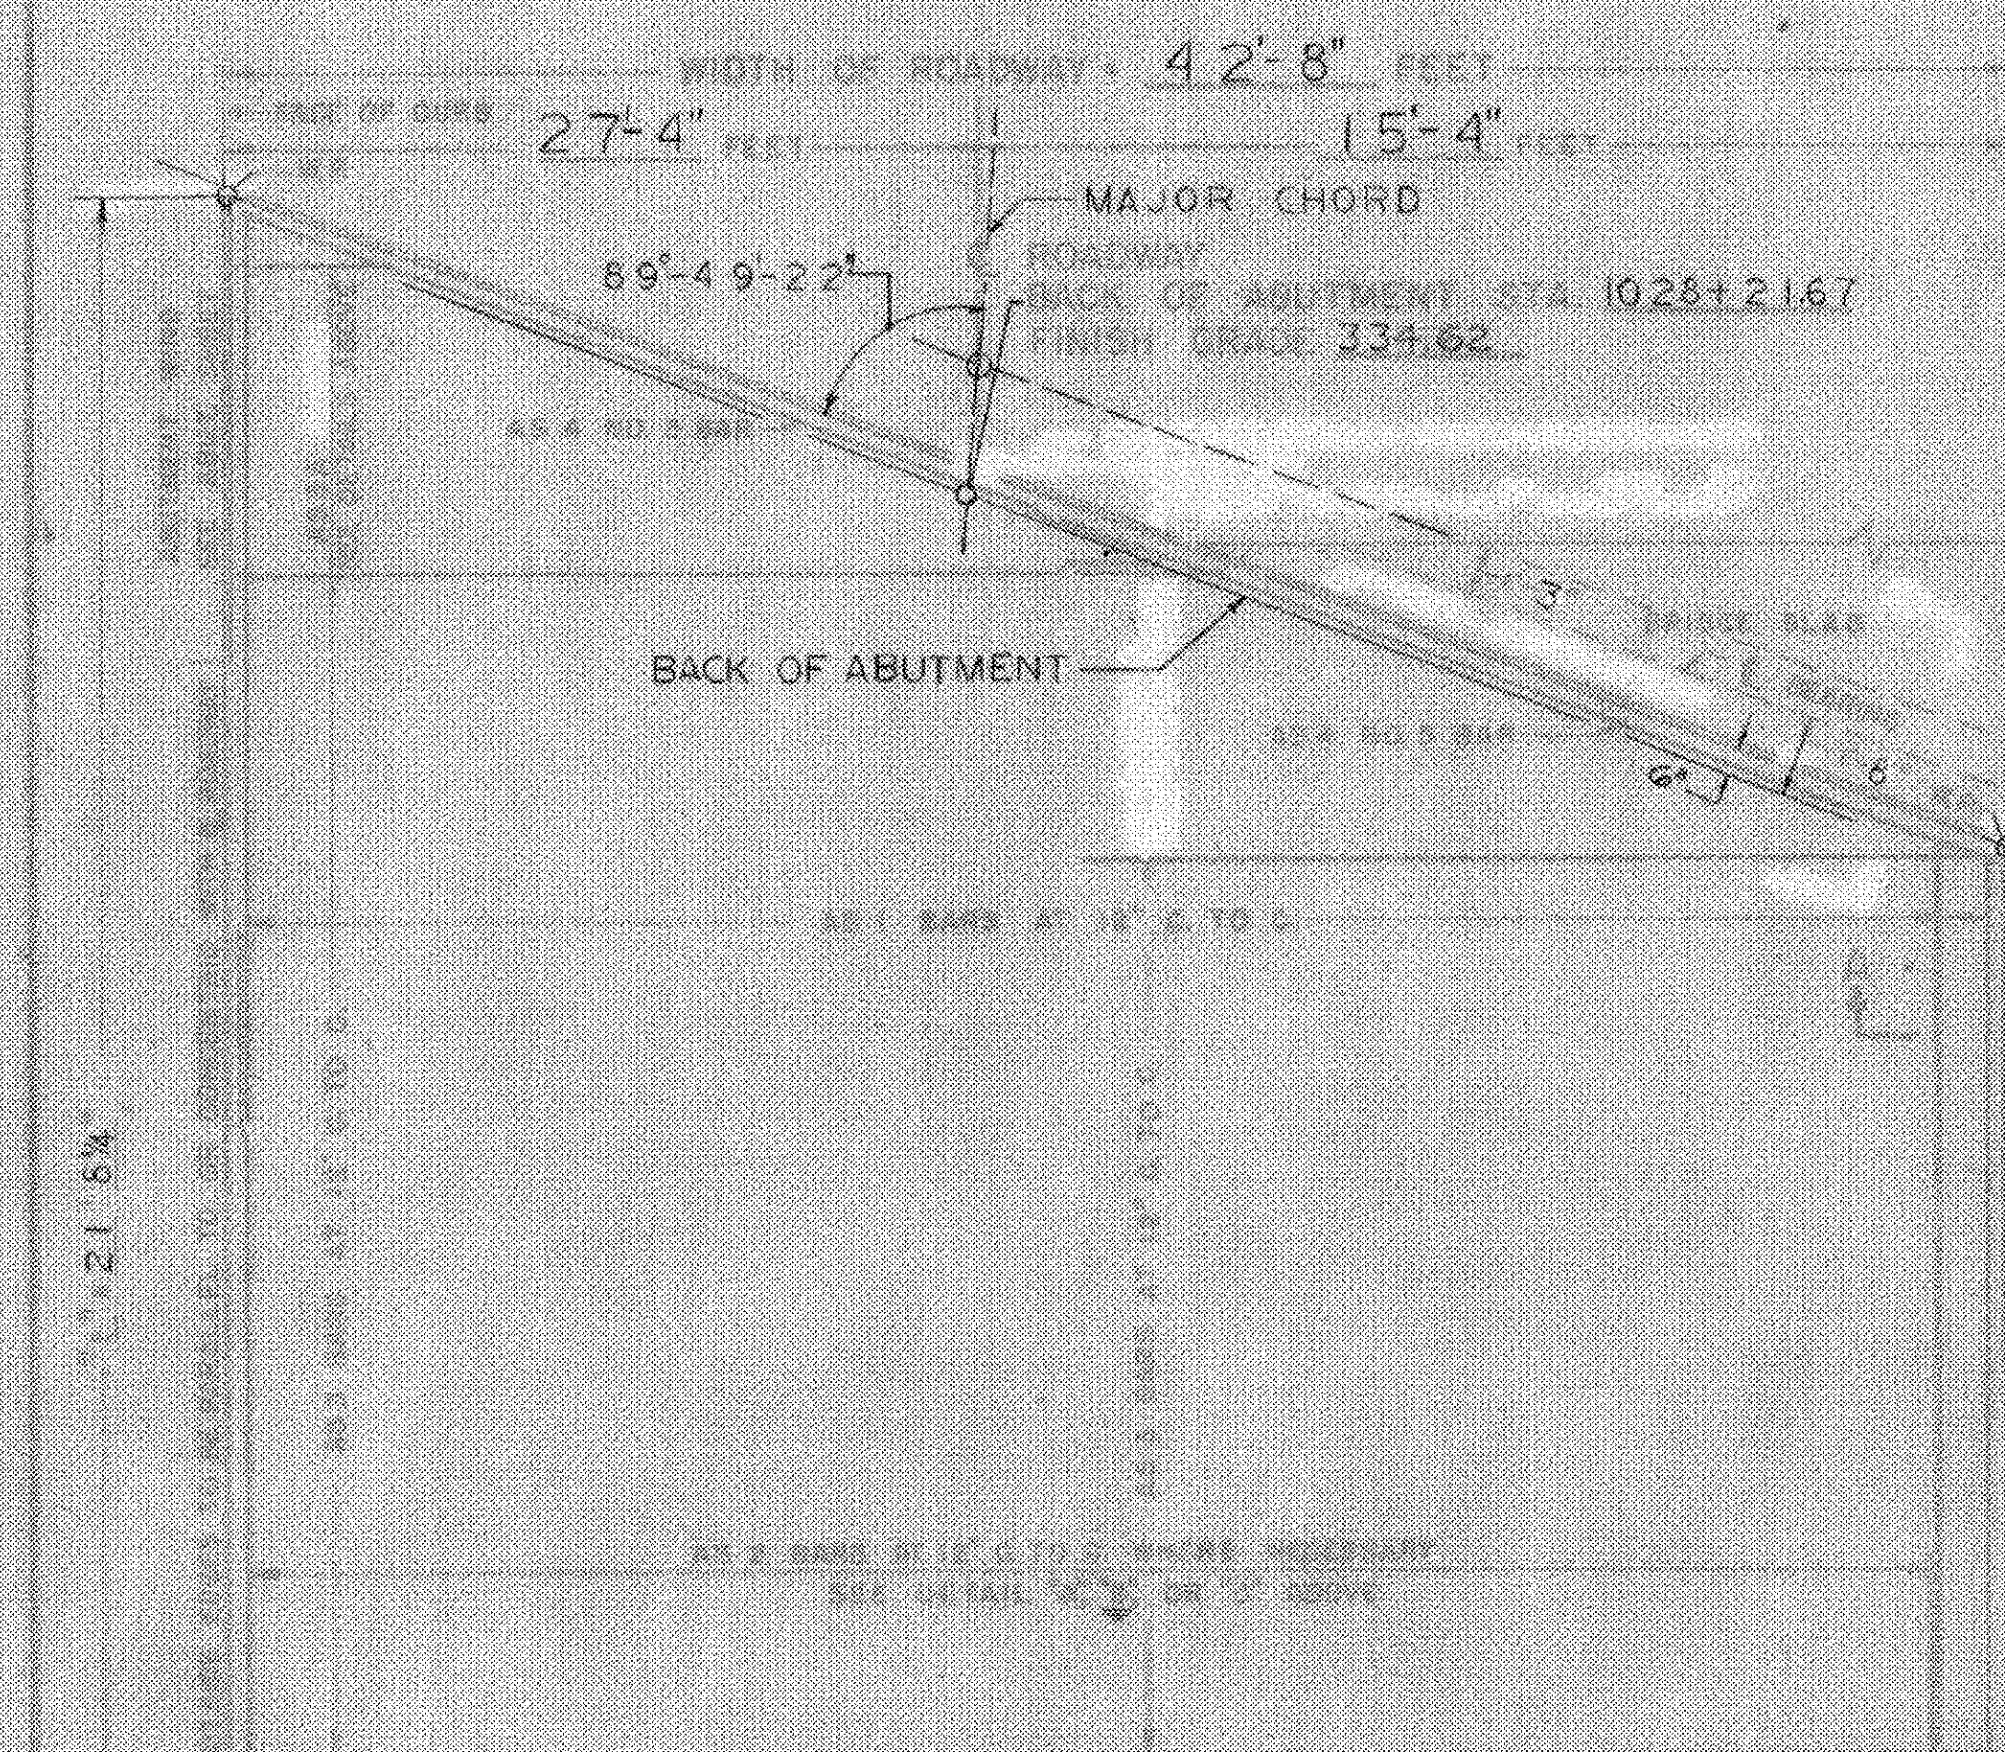
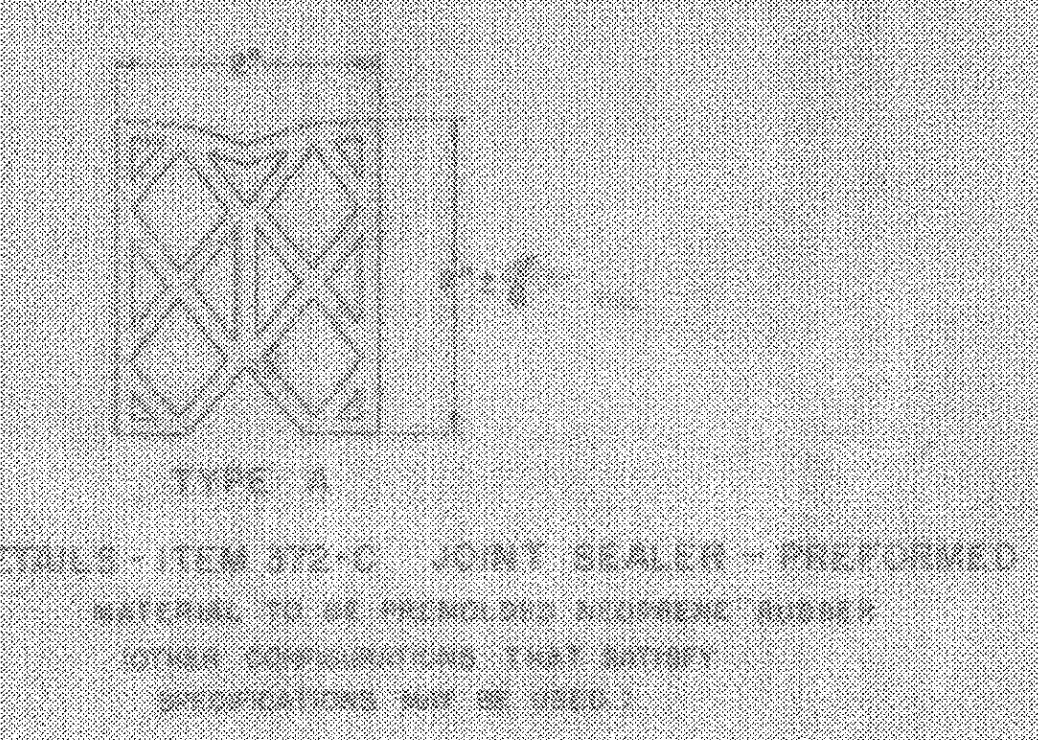
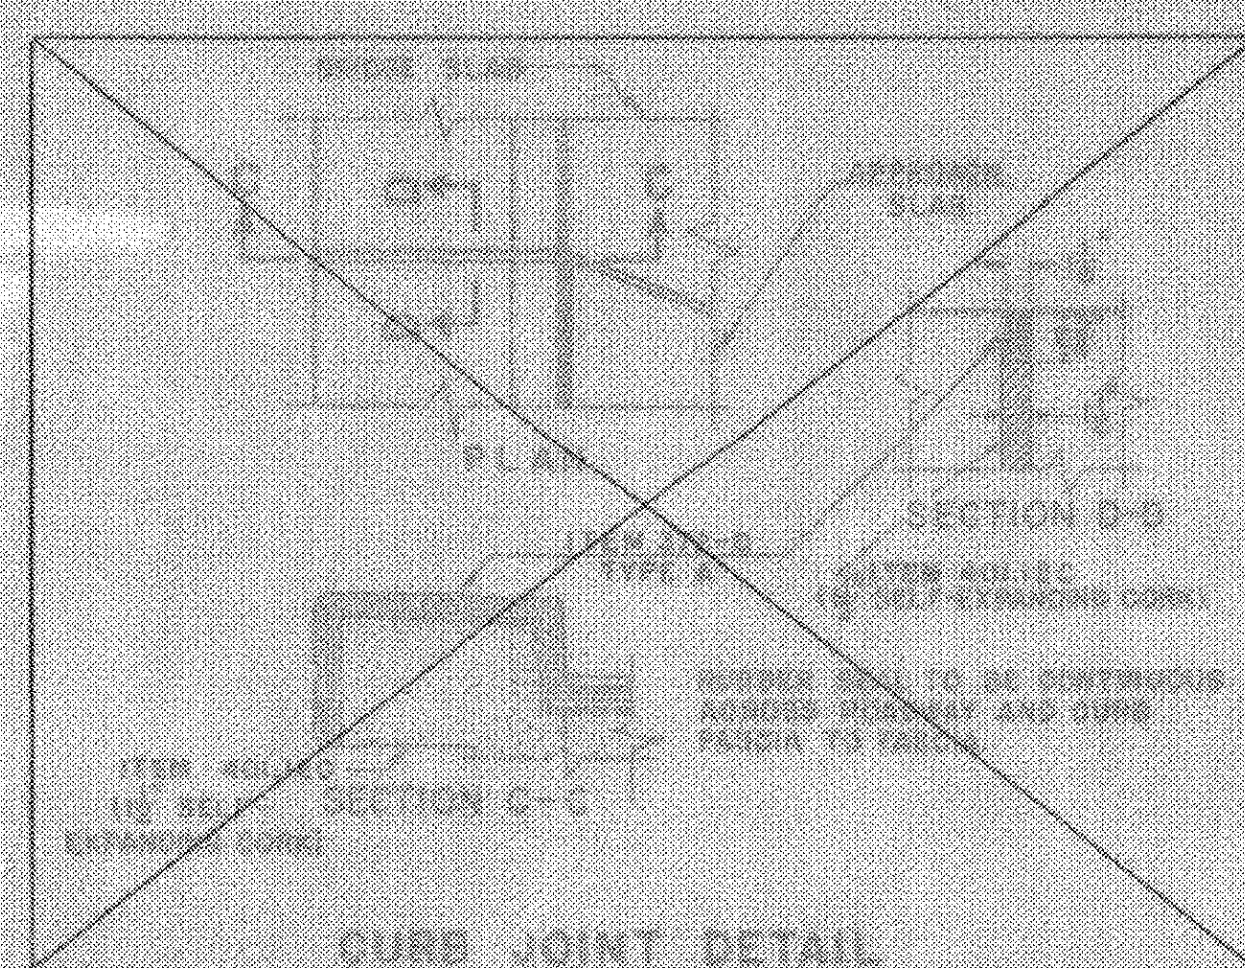


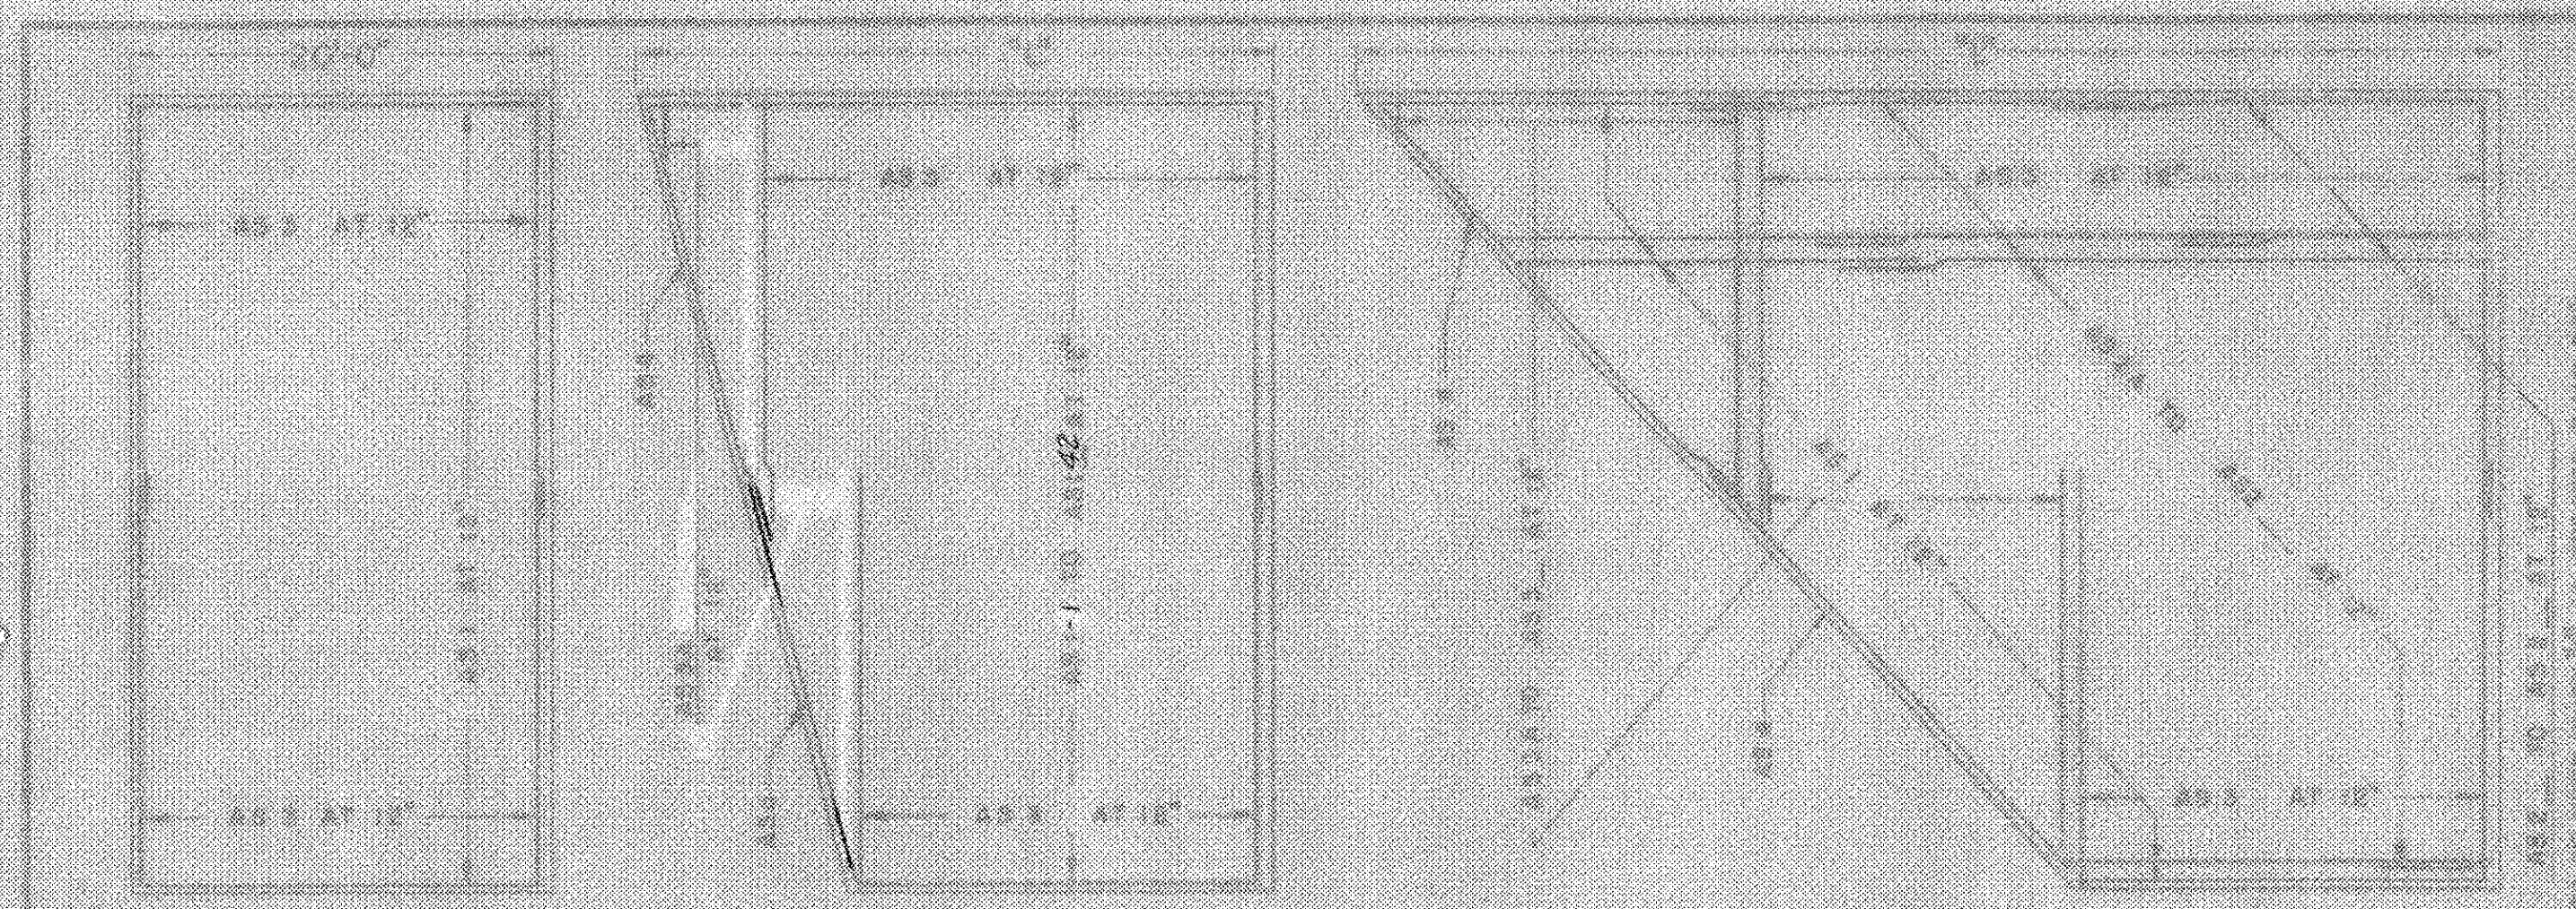


- GENERAL NOTES
- ALL WORK AND MATERIALS SHALL CONFORM TO THE STATE OF VERMONT DEPARTMENT OF HIGHWAYS STANDARD SPECIFICATIONS FOR HIGHWAY AND BRIDGE CONSTRUCTION (SEVEN APRIL 1969) AND THE A.A.S.H.O. SPECIFICATIONS (LATEST EDITION) REVISIONS FOR 1970-1974 (LATEST).
 - ALL REINFORCING STEEL SHALL BE DETAILED ON THE REINFORCING STEEL SCHEDULE. ALL SPACERS SHALL BE 1/2" MINIMUM 2" MAXIMUM.
 - BITUMINOUS CONCRETE PAVEMENT DEPTH SHALL BE 2" AT BRIDGE END AND VARY TO 3" AT THE ROADWAY END.

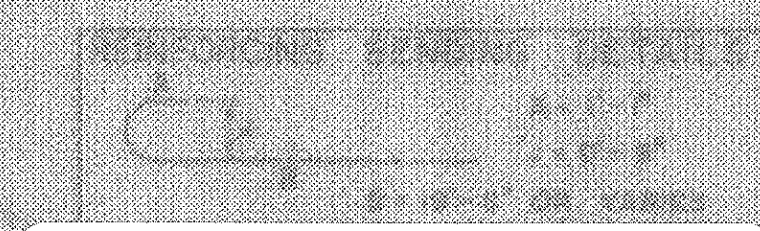

LIST OF QUANTITIES

ITEM NO.	DESCRIPTION	QUANTITY	UNIT
110	TAR EMULSION FOR BRIDGE FLOORS	100	CU YD
301	BITUMINOUS CONCRETE PAVEMENT	100	TONS
372-C	JOINT SEALER - PREFORMED, TYPE A	100	FT
400	CONCRETE CLASS B	100	CU YD
401	REINFORCING STEEL	100	LB

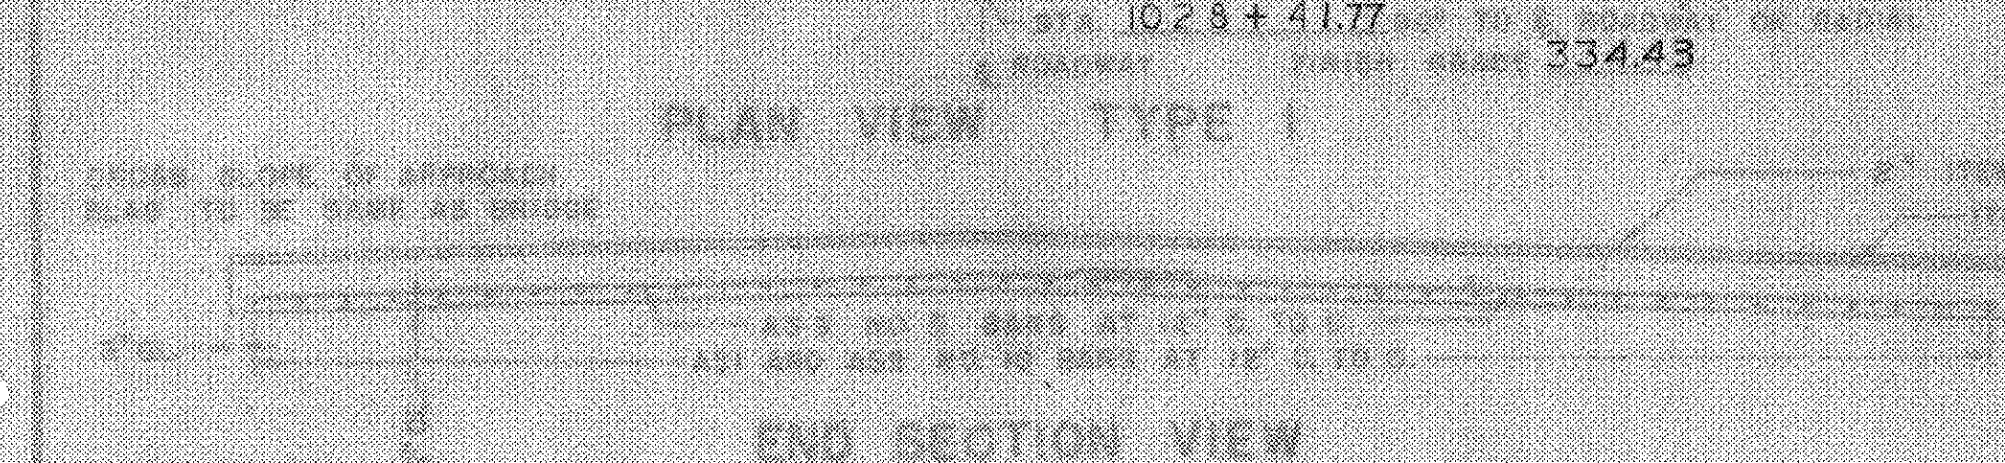

REVISIONS AND CORRECTIONS

DESIGNED BY: *[Signature]*
 CHECKED BY: *[Signature]*
 APPROVED BY: *[Signature]*

DETAILS OF APPROACH SLAB
 FOR 42'-8" FOOT BRIDGE
 TO BE USED FOR BRIDGE AT STATION 1028+20
 LOCATION U.S. ROUTE 4 RELOCATED OVER CASTLETON RIVER
 (APPROACH SLAB NO. 4)

STATE OF VERMONT
 DEPARTMENT OF HIGHWAYS
 STANDARD STRUCTURE
 SB-AS-65

PROJECT FAIR HAVEN - CASTLETON
 TOWN OF FAIR HAVEN
 ROUTE NO. U.S. 4
 U.S. RTE. 4 REL. OVER CASTLETON RIVER
 RIVER APPROACH SLAB NO. 4
 NOT TO SCALE
 H.G.C.
 DESIGNED BY AM'D CHECKED BY R.C.
 PROJECT NO. F020-1 (8)
 SHEET 152 OF 255
 CONTRACT NO. 321

FAIR HAVEN - RUTLAND
 BHF MEMB(2)
 SHEET 19 OF 45
 BRIDGE 3 E & W
 FOR REFERENCE ONLY