



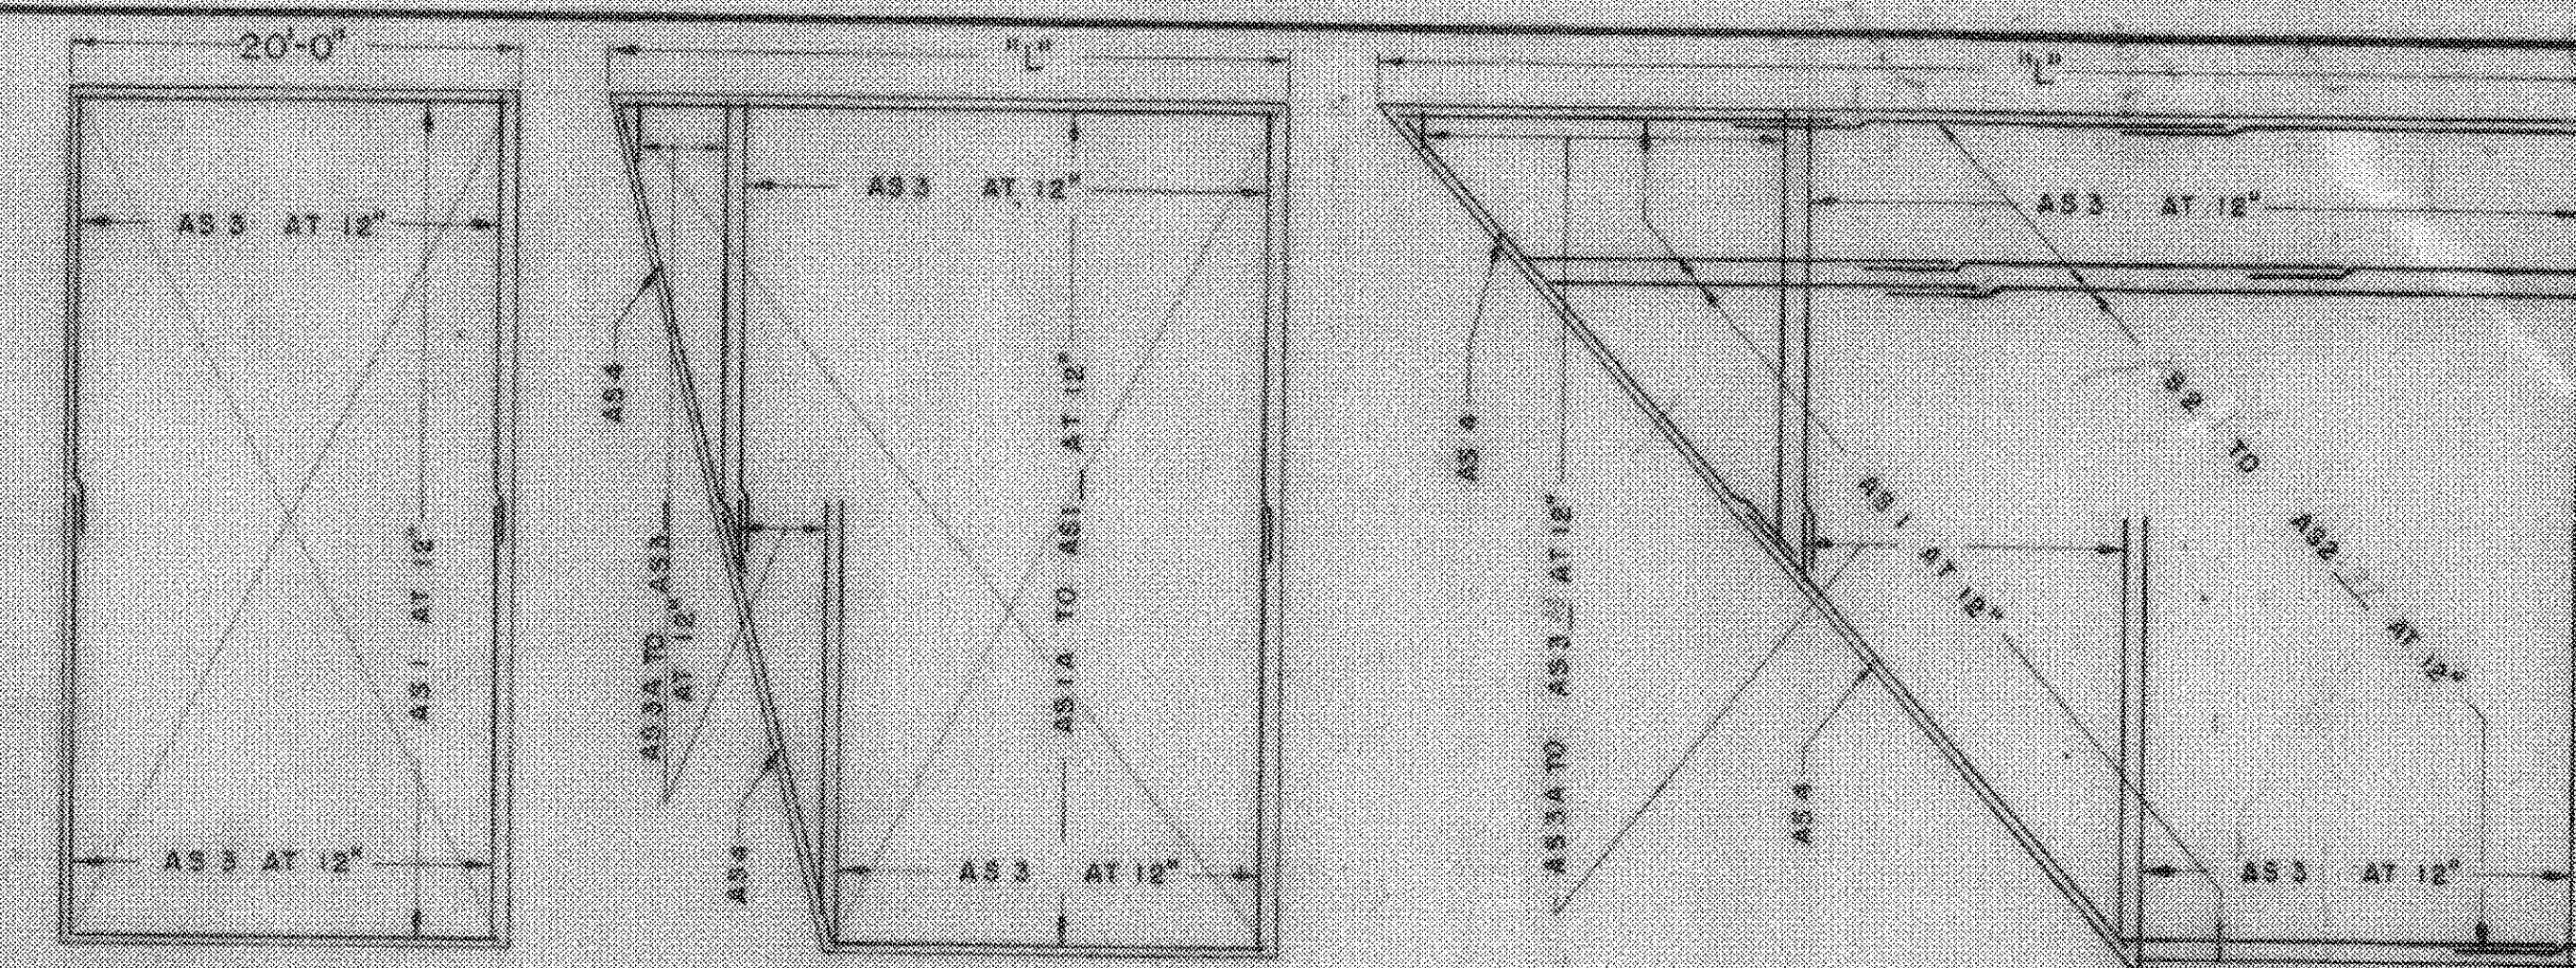


SECTION B-B

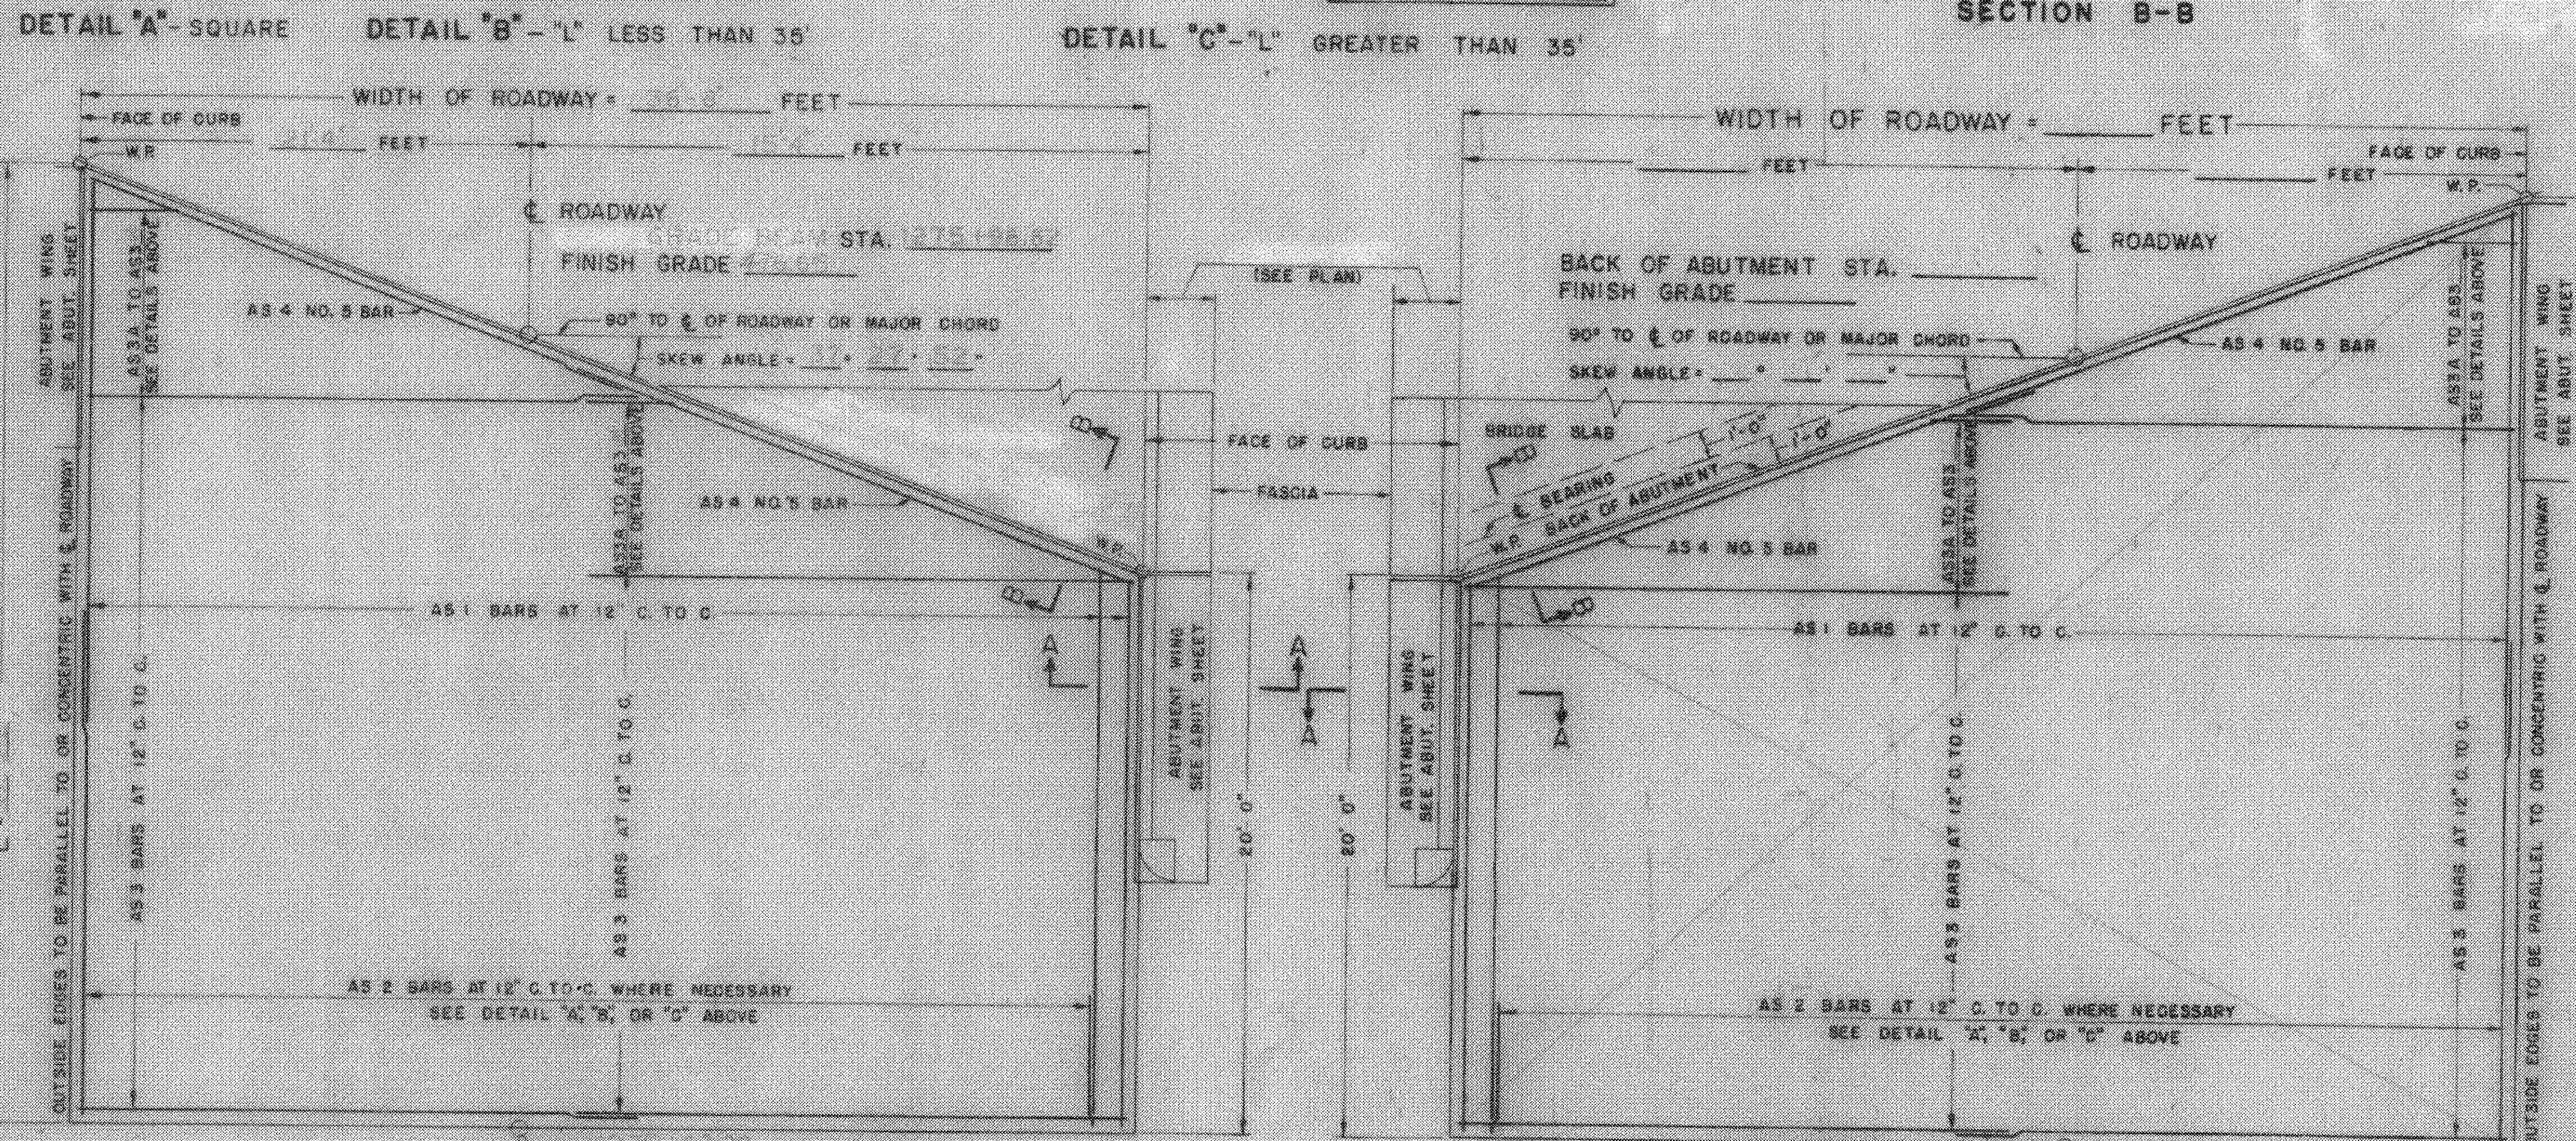


PLAN VIEW TYPE 1

PLAN VIEW TYPE 2

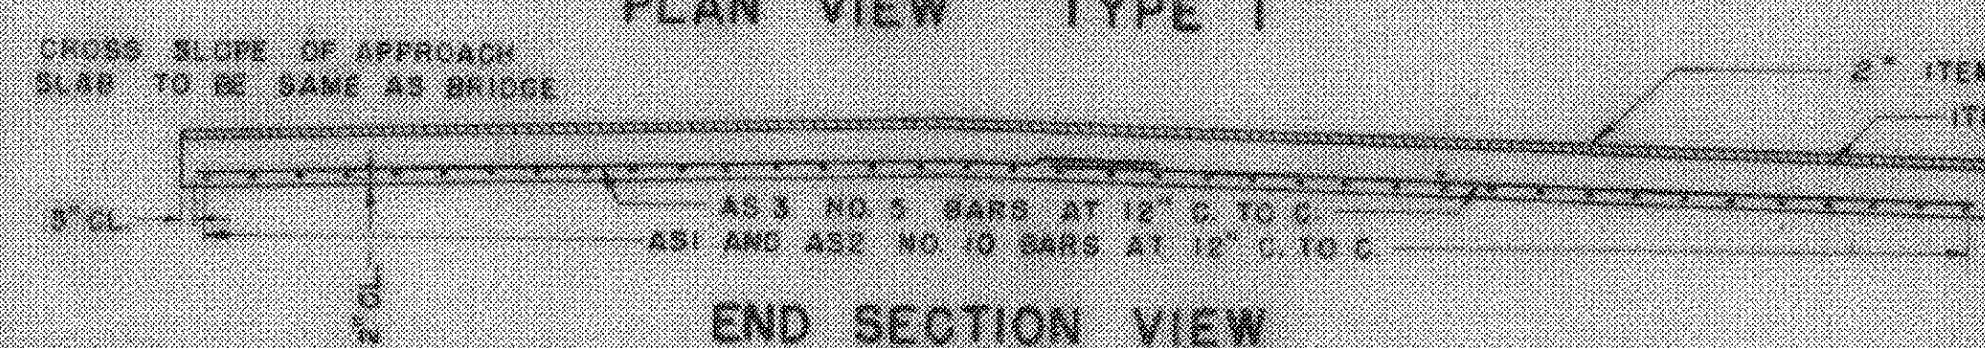


END SECTION VIEW

OTHER CONFIGURATIONS
THAT SATISFY SPECIFICATIONS
MAY BE USED

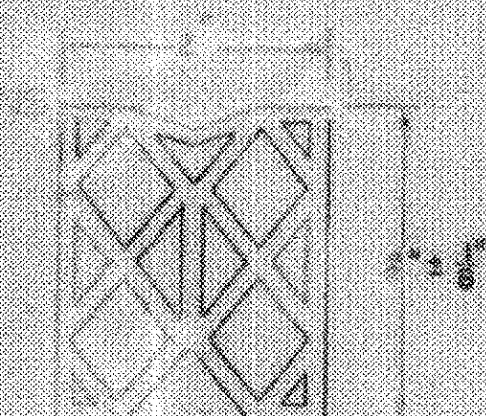


TYPE A
DETAILS ITEM 372-C JOINT SEALER - PREFORMED
MATERIAL TO BE PREMOULDED
NEOPRENE RUBBER

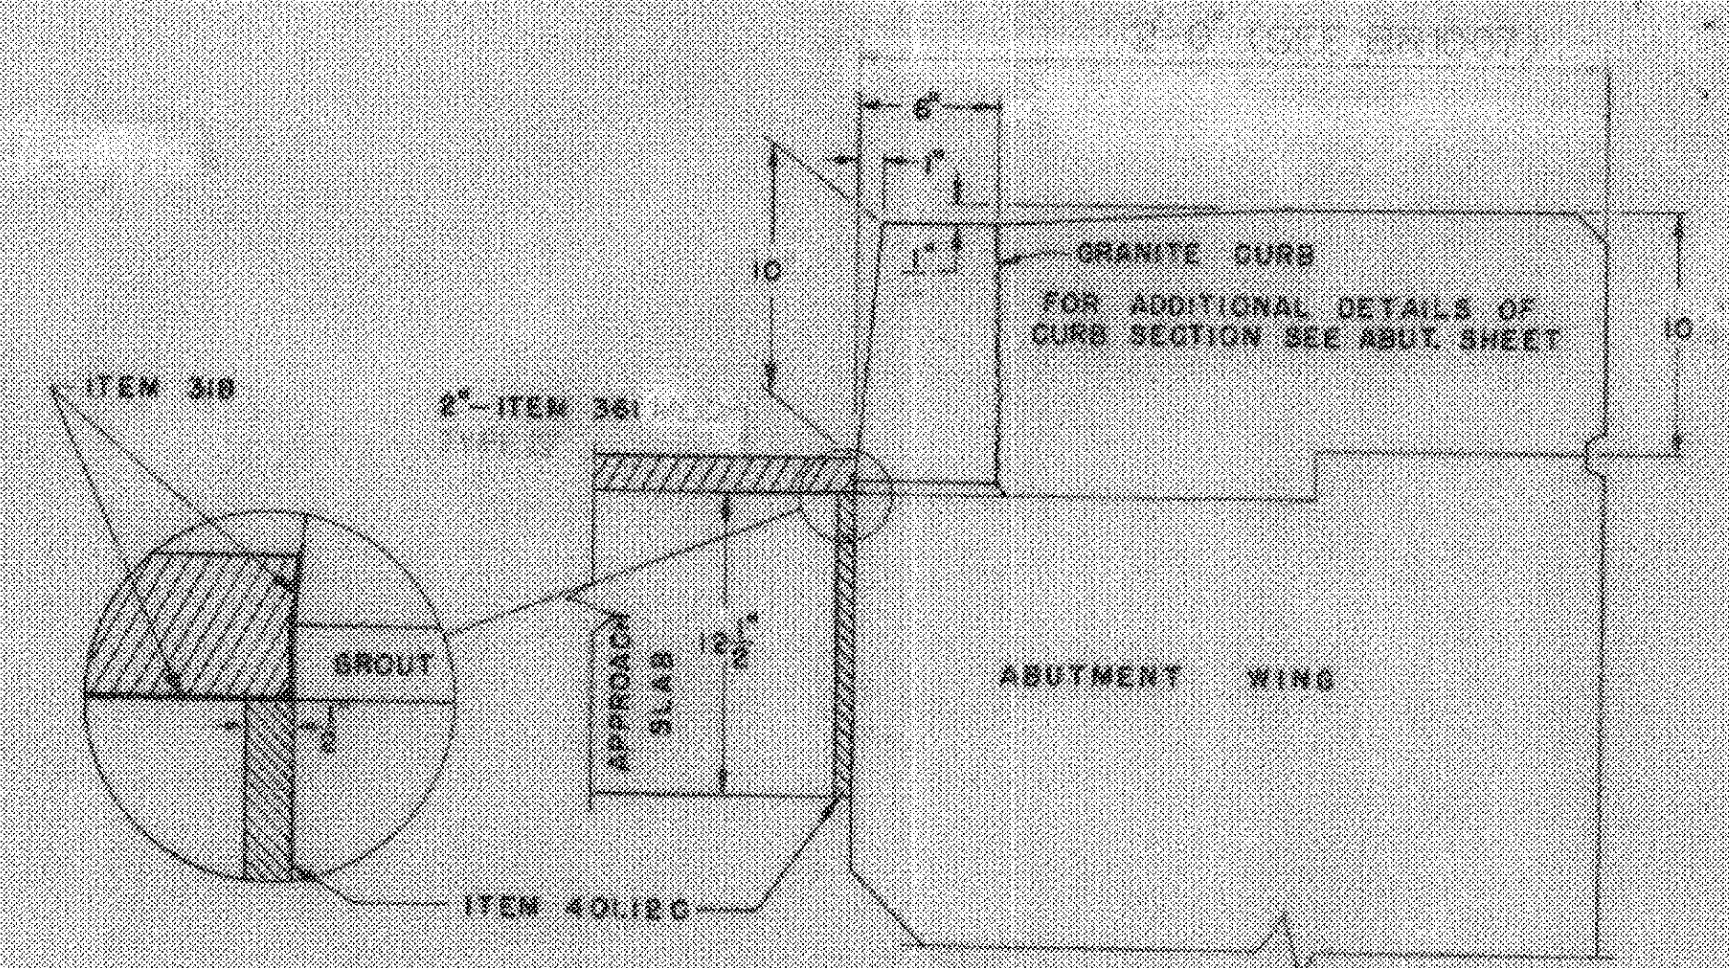

SECTION A-A

- GENERAL NOTES**
1. ALL WORK AND MATERIALS SHALL CONFORM TO THE STATE OF VERMONT, DEPARTMENT OF HIGHWAYS, STANDARD SPECIFICATIONS FOR HIGHWAY AND BRIDGE CONSTRUCTION, DATED APRIL 1964, AND THE A.A.S.H.O. SPECIFICATIONS DATED 1961, DESIGNED FOR HS 20-44 LOADING.
 2. ALL REINFORCING STEEL SHALL BE DETAILED ON THE REINFORCING STEEL SCHEDULE. ALL SPLICES SHALL BE A MINIMUM OF 40 BAR DIAMETERS.

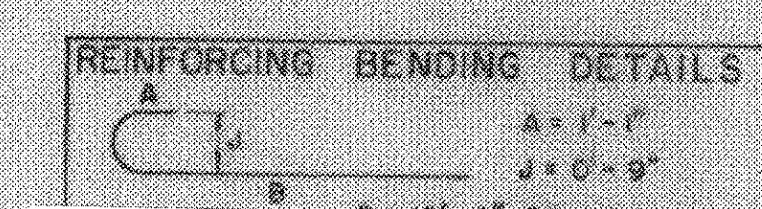

FAIR HAVEN - RUTLAND
BHF MEMB(2)
SHEET 25 OF 45
BRIDGE 10 E & W
FOR REFERENCE ONLY

LIST OF QUANTITIES

ITEM NO.	ITEM	UNIT
318	TAR EMULSION FOR BRIDGE FLOORS	GAL.
361	BITUMINOUS CONCRETE PAVEMENT	TONS
372-A	JOINT SEALER - HOT POURED	L.F.
372-C	JOINT SEALER - PREFORMED, TYPE A	L.F.
401-B	CONCRETE CLASS B	CY.
402	REINFORCING STEEL	LB.

DETAILS OF APPROACH SLAB
FOR 35.8 FOOT BRIDGE
(WIDTH)
TO BE USED FOR BRIDGE AT STATION 1275+09.67
LOCATION US ROUTE 4 RELOCATION OVER RTE 30 RELOCATION

STATE OF VERMONT
DEPARTMENT OF HIGHWAYS
STANDARD STRUCTURE
SB-AS-65

REVISIONS AND CORRECTIONS

1. DIMENSIONS OF JOINT FOR SEALER TYPE A REVISED 6/15/66 W.B.T.
2. DIMENSIONS OF JOINT SEALER TYPE B REVISED 6/23/65 W.B.T.
3. JOINT BETWEEN CURB AND SLAB REVISED, BITUMINOUS CONCRETE REVISED TO 2" QUANTITY TOTALS REMOVED, 12/7/65 W.B.T.

DRAWN BY: W.B.T. Jan 1965
TRACED BY: W.B.T. Jan 1965
CHECKED BY: W.M.S. Feb 1965

RECOMMENDED FOR APPROVAL: [Signature] 2/4/65
DATE
BRIDGE ENGINEER

RECOMMENDED FOR APPROVAL: [Signature] 2/4/65
DATE
ASSISTANT CHIEF ENGINEER

APPROVED BY: [Signature] 2/4/65
DATE
CHIEF ENGINEER

PROJECT FAIR HAVEN
TOWN OF CASTLETON
ROUTE NO. US 4 STA. 1275+09.67
APPROACH SLAB NO. 1
NOT TO SCALE
IN CHARGE W.B.C.
DESIGNED BY W.B.T. CHECKED BY [Signature]
PROJECT NO. AP020-150
SHEET 25 OF 45 BR