


FAIR HAVEN - RUTLAND
 BHF MEMB(2)
 SHEET 31 OF 45
 BRIDGES 19 E & W
 FOR REFERENCE ONLY

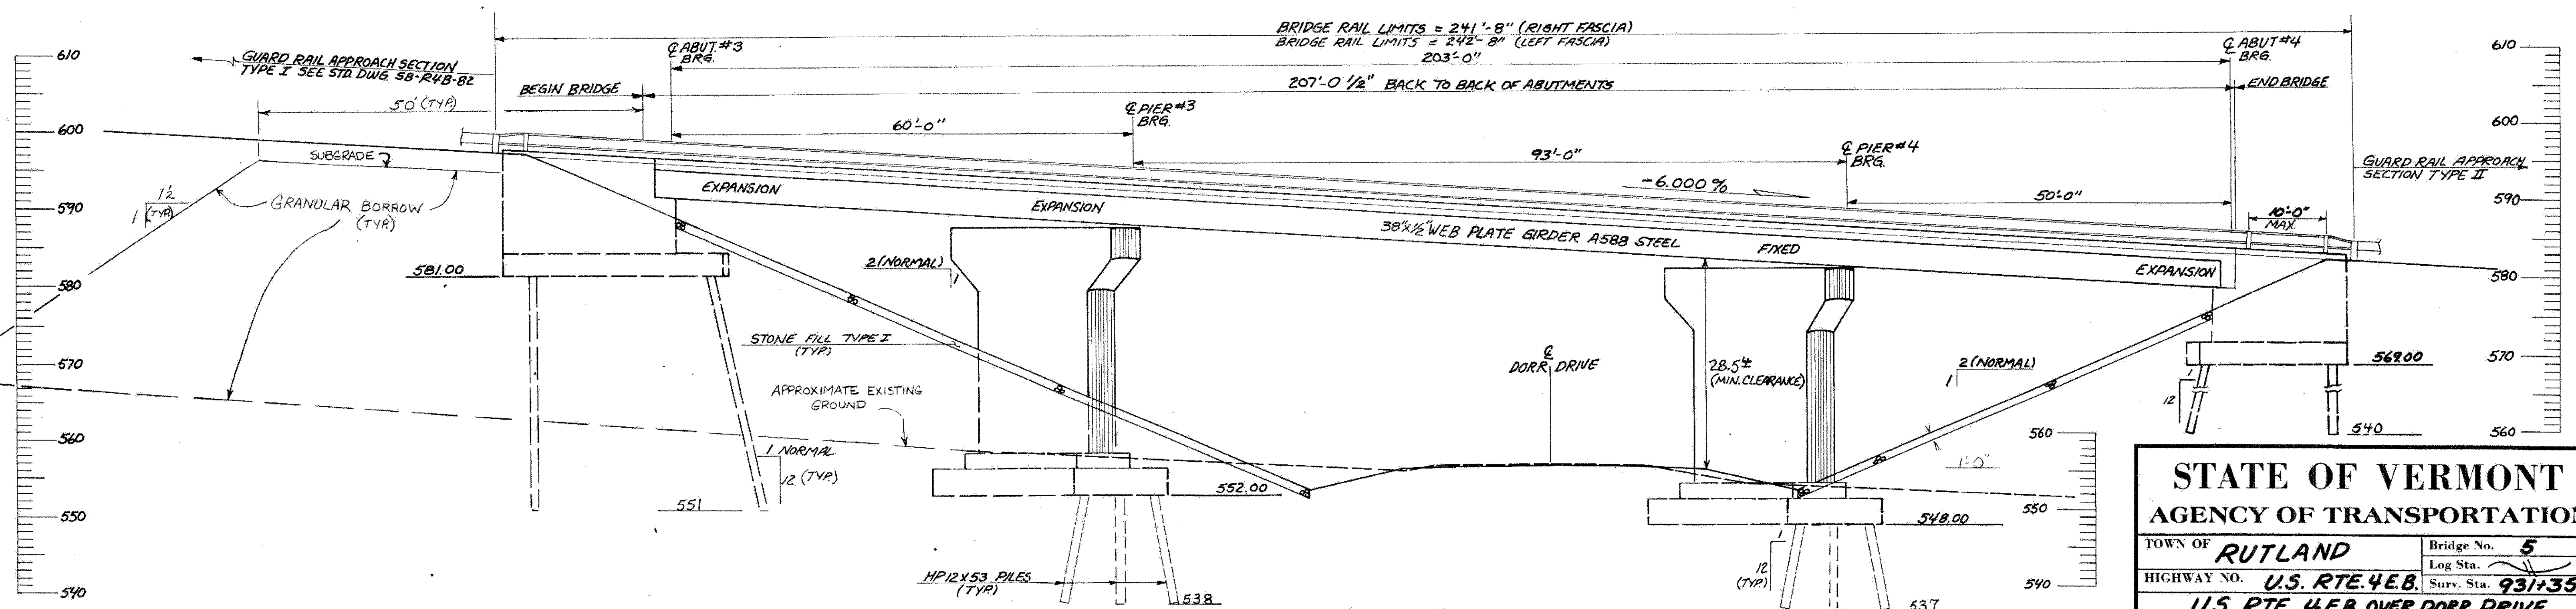

ELEVATION @ RIGHT FASCIA
 SCALE: 1" = 10'-0"

NOTE: FOR LENGTH OF PILES UNDER ABUTS., SEE SHEET BR-578.
 FOR LENGTH OF PILES UNDER PIERS SHEETS BR-579 & BR-520.

STATE OF VERMONT	
AGENCY OF TRANSPORTATION	
TOWN OF RUTLAND	Bridge No. 5
HIGHWAY NO. U.S. RTE. 4 E.B.	Log Sta. 931+35
U.S. RTE. 4 E.B. OVER DORR DRIVE	
PLAN AND ELEVATION	
Designed by J.B. MC CARTHY	Drawn by L.C. GATES
Checked by J.B. MC CARTHY date 3/83	Bridge Design Supervisor F.W. Bolkom date 4/83
PROJECT NO. WEST RUTLAND - RUTLAND	PROJECT NO. FECC 020-1(15)
Bridge Sheet No. BR 505	Sheet 85 of 377