


Sta. 8+46 20' RT 30' E
(Remove)
by Town

Sta. 11+30 LT. Construct Drive

CURVE DATA
 Δ 13° 01' 30" LT
 D 4' 15" LT
 R 1342.1
 T 153.9
 L 306.5
 E 8.7
 Bank $\frac{3}{16}$ / ft.

CONSTRUCT SATISFACTORY APPROACH
 STA. 8+93 BEGIN PROJECT SA 26, 1963

CONSTRUCT SATISFACTORY APPROACH
 STA. 11+62.0 END PROJECT SA 26, 1963

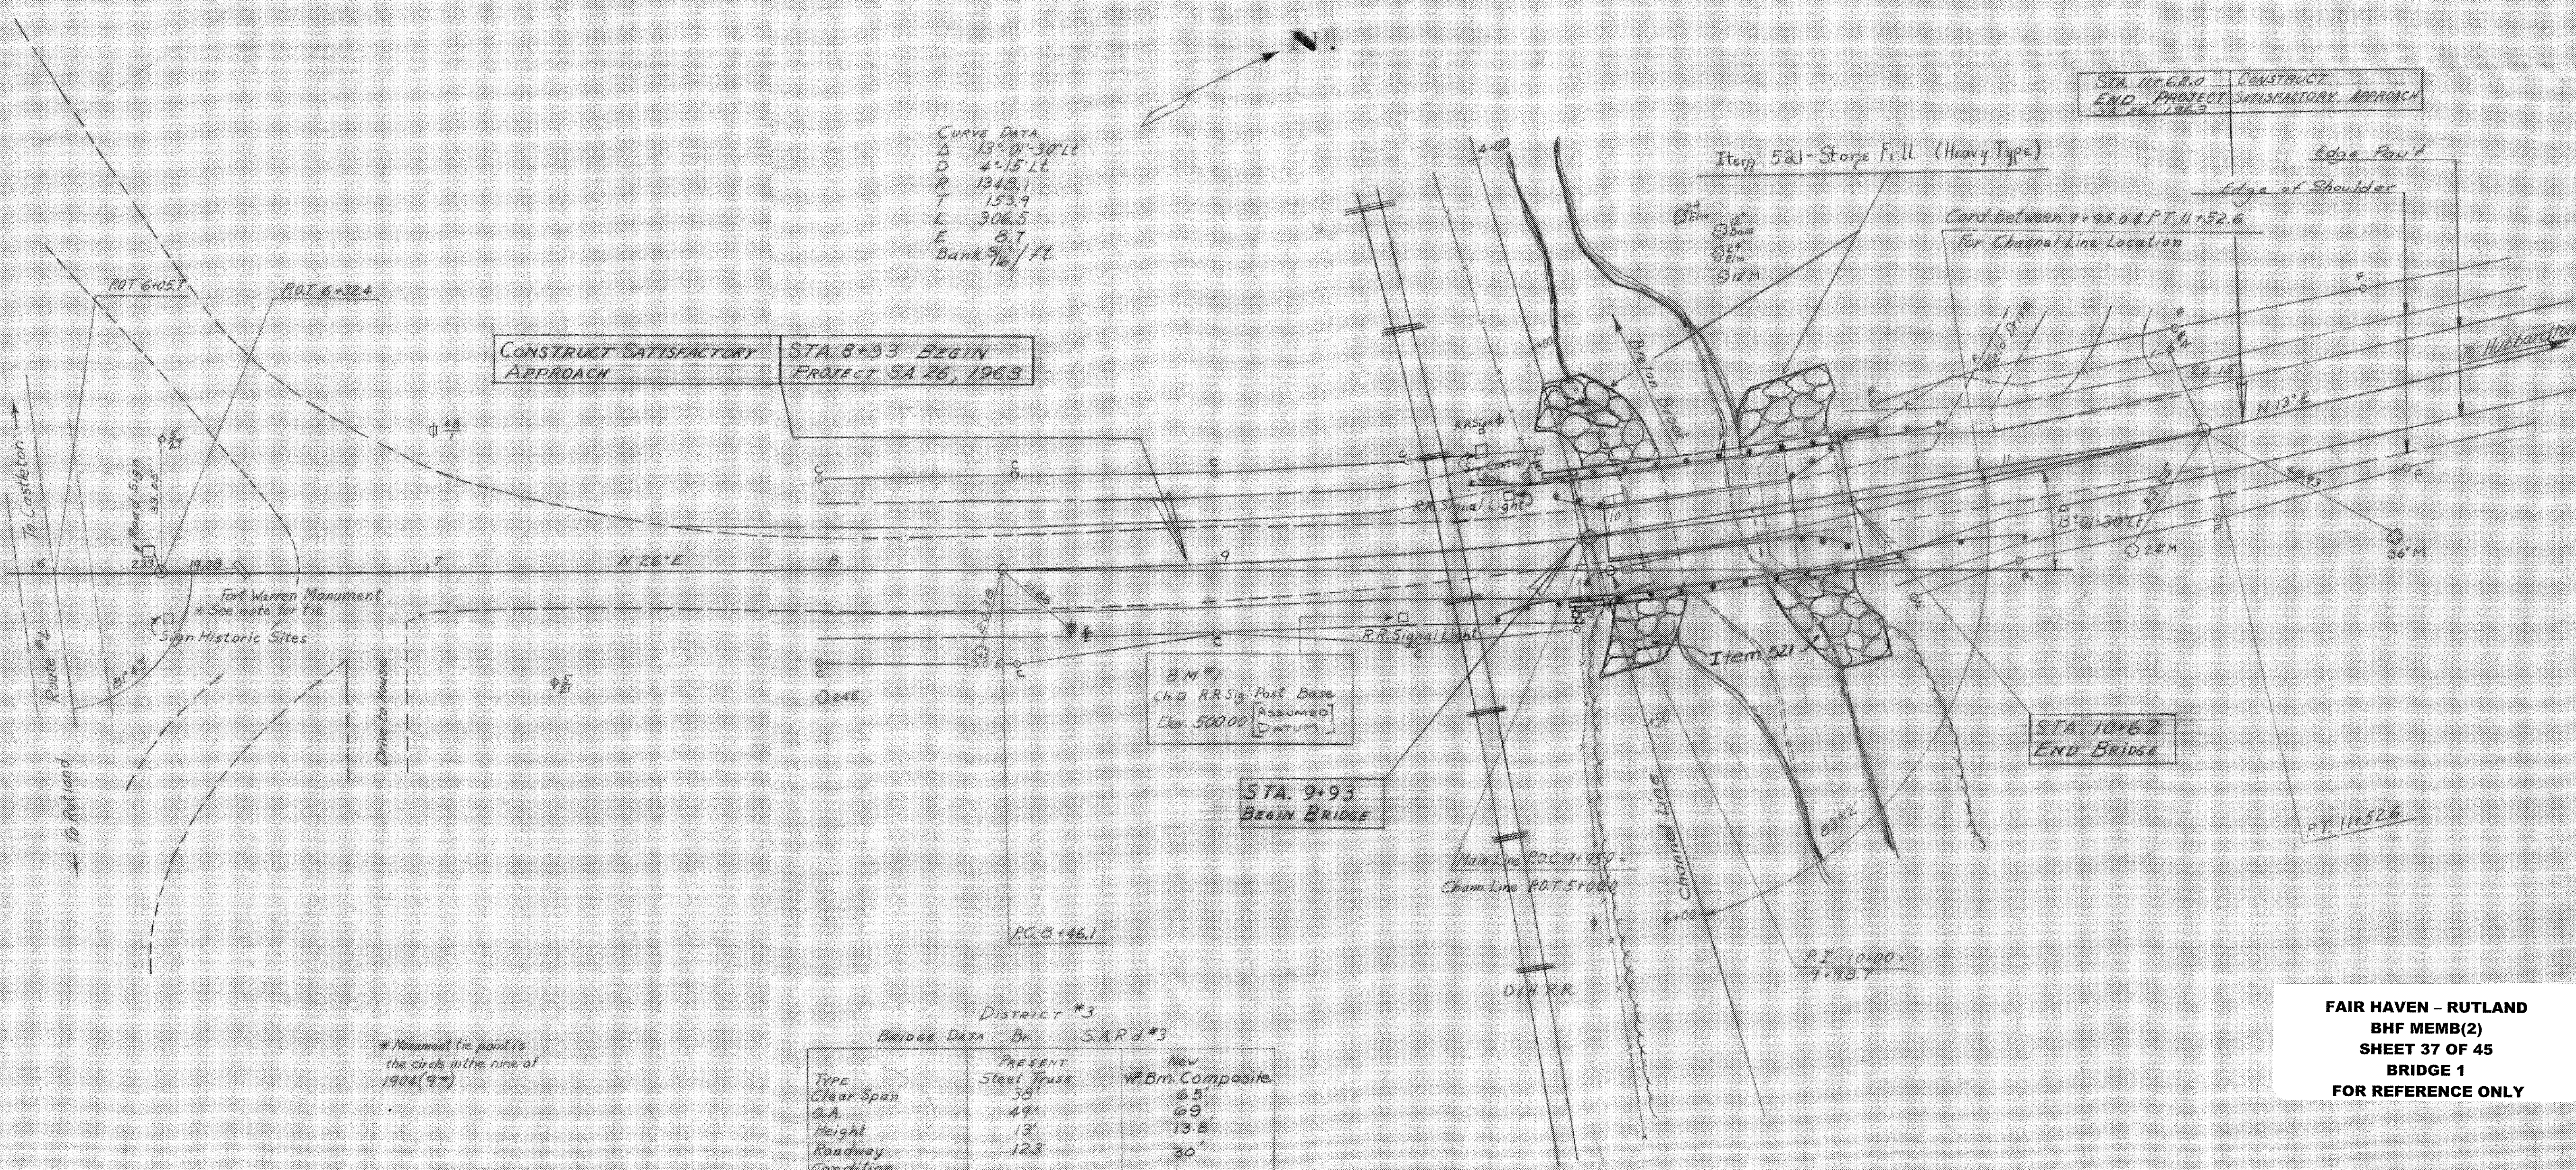

* Monument tie point is the circle in the ring of 1904 (9*)

District #3
 BRIDGE DATA Br. S.A.R.D.#3

	PRESENT	New
Type	Steel Truss	W. Brn. Composite
Clear Span	38'	65'
O.A.	49'	69'
Height	13'	13.8'
Roadway	123'	30'
Condition		

STA. 10+62
 END BRIDGE

FAIR HAVEN - RUTLAND
 BHF MEMB(2)
 SHEET 37 OF 45
 BRIDGE 1
 FOR REFERENCE ONLY

Scale 1"=20'

CASTLETON
 S.A. 26, 1963
 Sheet 3 of 35
 Revised by ATMS Checked by JCS