
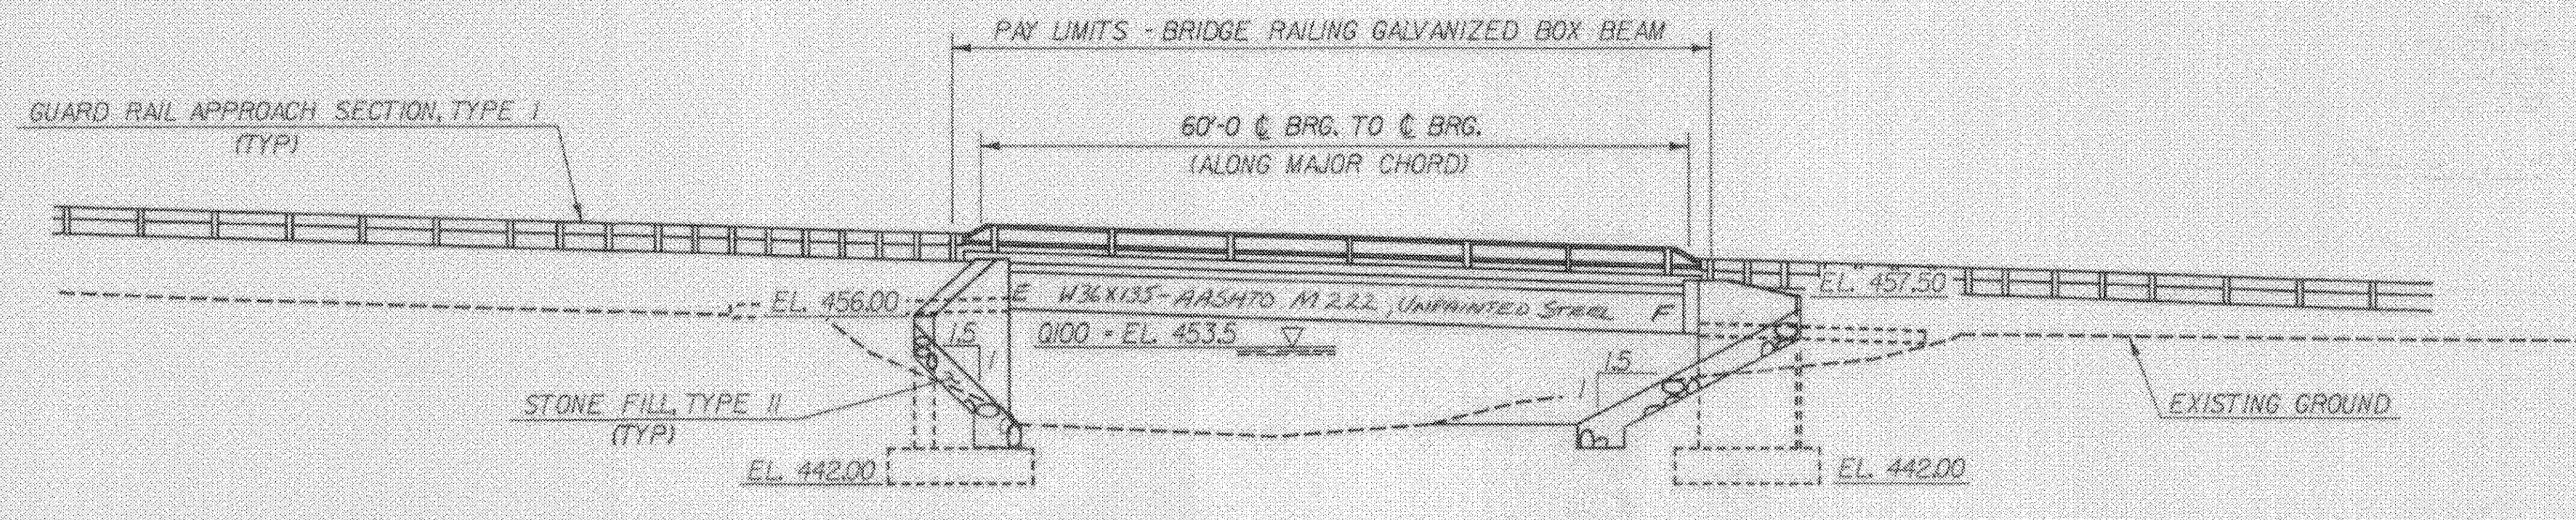


CURVE DATA

Δ	= 18° 03' LT.
D	= 5'
R	= 1145.92
T	= 182.00'
L	= 361.00'
E	= 14.36'
BANK	0.060 FT./FT.

PVI
302+50
EL. 459.60
V.C. 160'
-1.7524% Δ -3.1739%

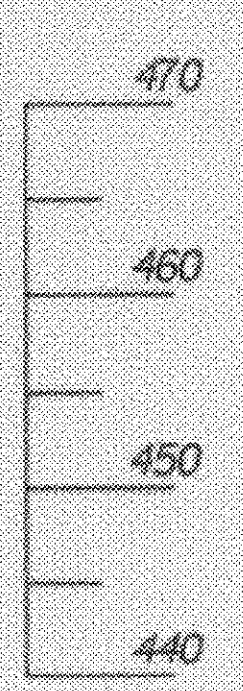

**FAIR HAVEN - RUTLAND
BHF MEMB(2)
SHEET 41 OF 45
BRIDGE 11
FOR REFERENCE ONLY**

STATE OF VERMONT AGENCY OF TRANSPORTATION	
Town Of CASTLETON	Bridge No. 11
Highway No. VT. 4A	Log Sta. 302+49
PLAN AND ELEVATION	
VT. RTE. 4A OVER THE CASTLETON RIVER	
Designed By G. V. SPILAK	Drawn By D. C. WILLEY
Checked By G. V. SPILAK	Bridge Design Supervisor R. S. HAUPT Date 3/87
PROJECT CASTLETON	PROJECT NO. RS 0142 (11)
I.G.C. info. QSAIT30.2578F194PI.DGN	
Bridge Sheet No. BRIDGE	Sheet 28 of 90

DRAWING: 44-232-B4442