

REV. CURVE DATA  
 $\Delta = 35^\circ$   
 $D = 7'$   
 $R = 818.5'$   
 $T = 258.08'$   
 $L = 500.00'$


INDEX OF BRIDGE STANDARDS

SB-R4A-82	R 12-13-84
SB-R4B-82	R 12-13-84

INDEX OF BRIDGE SHEETS

BR100	PRELIMINARY INFORMATION
BR101	QUANTITY SHEET
BR102	BORING SHEET
BR103	REFERENCE SHEET/GENERAL NOTES
BR104	REFERENCE SHEET
BR105	SLAB DETAILS
BR106	APPROACH SLAB DETAILS
BR107	ABUTMENT NO.1 DETAILS
BR108	ABUTMENT NO.2 DETAILS
BR109	WINGWALL DETAILS
BR110	REINFORCING SCHEDULE
BR111-113	CHANNEL CROSS SECTIONS

PLAN  
SCALE 1" = 10'

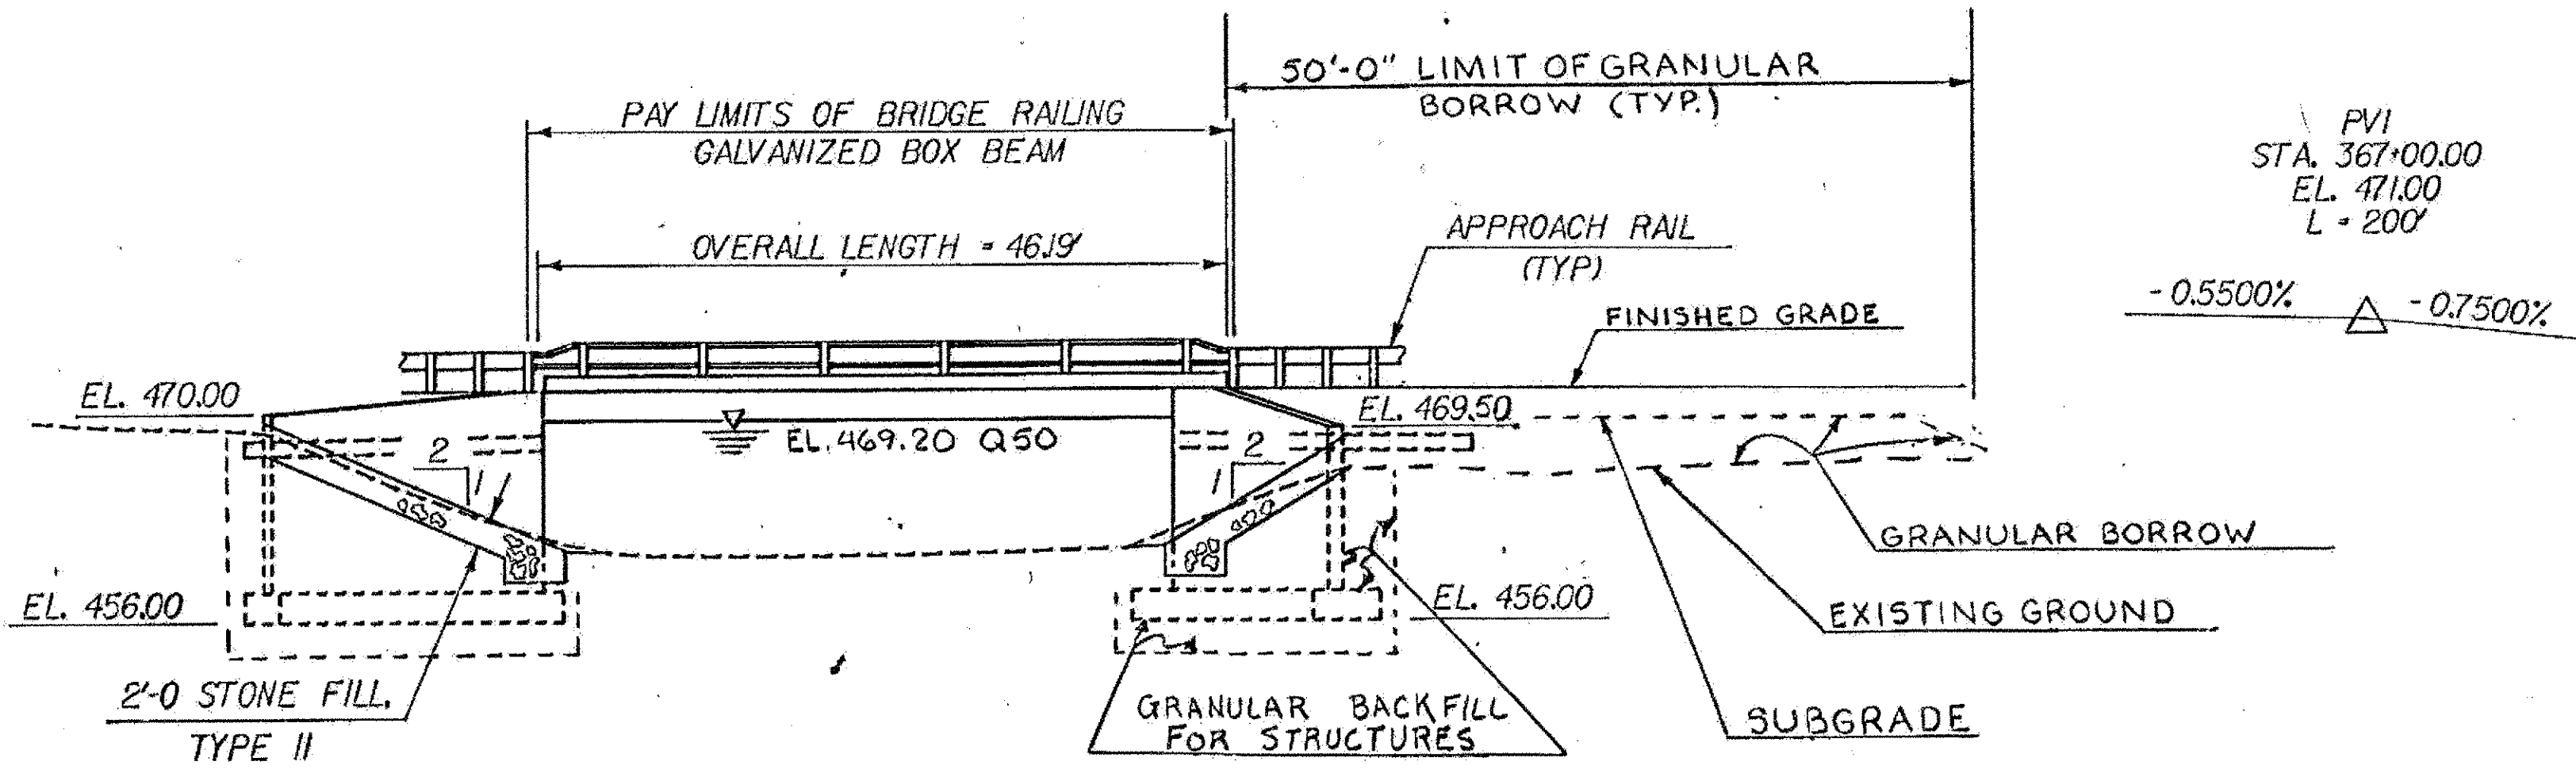

ELEVATION  
SCALE 1" = 10'

EXISTING STRUCTURE

1. STRUCTURE TYPE	SINGLE SPAN CONCRETE SIDE GIRDER	OVERALL LENGTH	45'-2"	INVENTORY RATING	H15	
2. SPAN LENGTH(S) CENTER TO CENTER OF BEARINGS	34' 11"					
3. CLEAR SPAN LENGTH(S) NORMAL TO STREAM	34' 11"					
4. WATERWAY AREA OF FULL OPENING (NORMAL TO STREAM)	2204 SQ. FT.					
5. WATER SURFACE ELEVATION @ Q 2.33	465.6	WATER SURFACE ELEVATION @ Q 50	468.8	VERTICAL CLEARANCE ABOVE STREAMBED		6'-2"
6. WATER SURFACE ELEVATION AT FLOOD OF RECORD	UNKNOWN	YEAR	1922	ESTIMATED DISCHARGE		
7. DOES ALL WATER PASS THROUGH EXISTING STRUCTURE?	NO IF NOT, AT WHAT FREQUENCY AND ELEVATION DOES RELIEF OCCUR? 0.5, 467.8'					
8. TYPE OF SUBSTRUCTURE FOUNDATION MATERIAL	SILT, SAND					
9. DISPOSITION OF STRUCTURE	REMOVE					

NEW STRUCTURE

1. STRUCTURE TYPE	SINGLE SPAN LIGHT WEIGHT CONCRETE SLAB	OVERALL LENGTH	46.19'
2. SPAN LENGTH(S) CENTER TO CENTER OF BEARINGS	43.88'		
3. VERTICAL CLEARANCE ABOVE STREAMBED OR ROAD UNDER	8'		
4. CLEAR SPAN LENGTH(S) NORMAL TO STREAM	35'		
5. WATERWAY AREA OF FULL OPENING (NORMAL TO STREAM)	3320 SQ. FT.		
6. ARE PROVISIONS TO BE MADE FOR PUBLIC UTILITIES?	NO		

HYDRAULIC DATA:

1. Q 2.33	700 CFS (20 CM)	WATER ELEVATION	465.6	VELOCITY	1.4 FPS		
Q 10	1400 CFS (40 CM)	WATER ELEVATION	467.8	VELOCITY	6.1 FPS		
Q 25	1800 CFS (50 CM)	WATER ELEVATION	468.8	VELOCITY	7.0 FPS		
Q 50	2100 CFS (60 CM)	WATER ELEVATION	469.2	VELOCITY	7.6 FPS		
Q 100	2400 CFS (68 CM)	WATER ELEVATION	469.4	VELOCITY	7.9 FPS		
2. DRAINAGE AREA	22.0 SQ. MI.	CHARACTER OF TERRAIN	ROLLING TO MOUNTAINS				
3. ARE THERE OBJECTIONS TO A PIER IN THE STREAM?	N/A.						
4. DOES STREAM REACH ITS MAXIMUM HIGH WATER ELEVATION RAPIDLY?	NO				IS ORDINARY RISE RAPID?	NO	
5. NATURE OF NATURAL STREAMBED	SAND, SILT, GRAVEL						
6. ESTIMATED SCOUR DEPTH	4'-6"	COMMENT ON: DRIFT	MOD.	ICE	HEAVY		
7. WILL ALL WATER PASS THROUGH NEW STRUCTURE?	NO				IF NOT, WHAT FREQUENCY AND ELEVATION WILL RELIEF OCCUR?	0.25, 468.8	
8. VERTICAL CLEARANCE ABOVE Q 50 =	0.8'						
9. ALLOWABLE WATER SURFACE ELEVATION	470.0' LIMITED BY BOTTOM OF SLAB						
10. IS DESIGN STAGE AFFECTED BY UPSTREAM OR DOWNSTREAM CONDITIONS?	NO IF YES, DESCRIBE						
11. AVERAGE DAILY LOW FLOW	25 CFS	DEPTH	1.0'	AVERAGE DAILY HIGH FLOW	70 CFS	DEPTH	3.0'
12. STREAMBANK OR CHANNEL PROTECTION REQUIRED	STONE FILL, TYPE II						
13. DISTANCE TO EXISTING UPSTREAM STRUCTURE	2.6 MI	SPAN	300'	WATERWAY AREA OF FULL OPENING	N/A	Q	
14. DISTANCE TO EXISTING DOWNSTREAM STRUCTURE	0.8 MI	SPAN	25'	WATERWAY AREA OF FULL OPENING	160 SQ. FT.	Q	


ALLOWABLE STRESSES:

1. DESIGN LIVE LOAD	AASHTO HS20	ON LEDGE	N/A.
2. ALLOWABLE LOAD FOR SPREAD FOOTINGS ON SOIL	4.0 KSF	ESTIMATED LENGTH	N/A.
3. ALLOWABLE LOAD FOR PILING	N/A.	TYPE	N/A.
4. ALLOWABLE STRESS FOR STRUCTURAL STEEL ASTM A	N/A.	TENSION	N/A.
5. ALLOWABLE STRESS FOR REINFORCING STEEL GRADE 60 TENSION	24 KSI	COMPRESSION	20 KSI
6. ALLOWABLE STRESS FOR CONCRETE CLASS #	CLASS B 1c: 3.5 KSI	1c: 1.9 KSI	
	CLASS B 2c: 4.0 KSI	2c: 1.6 KSI	

TRAFFIC MAINTENANCE:

1. IS TRAFFIC TO BE MAINTAINED?	YES	IF YES, ON EXISTING STRUCTURE	NO	OR ON TEMPORARY BRIDGE	YES
2. TEMPORARY BRIDGE REQUIREMENTS: ONE WAY	NO	TRAFFIC CONTROL SIGNALS REQUIRED	YES		
MINIMUM CLEAR SPAN SEE BELOW MINIMUM CLEAR HEIGHT SEE BELOW MINIMUM WATERWAY AREA SEE BELOW					
ARE SIDEWALKS REQUIRED? NO IF SO, ON WHAT SIDE? N/A					

ADDITIONAL DESIGN CONSIDERATIONS

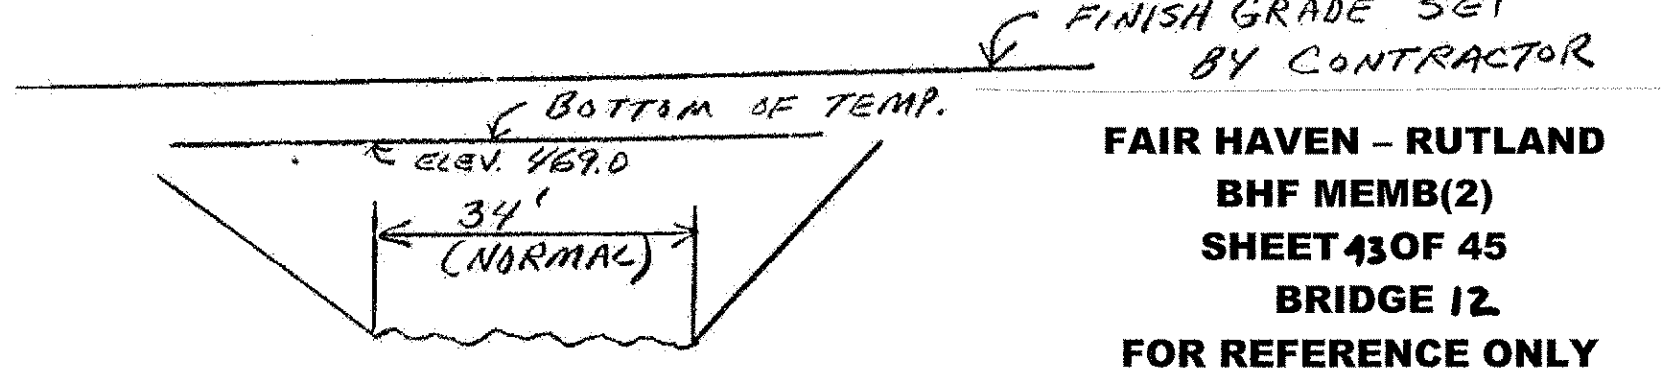

TEMP. BRIDGE WATERWAY REQUIREMENTS

LOAD RATING (TONS)

STRESS LEVELS	H	HS	362	TRUCK	SA. STR.	4A. STR.	5A. SEMI
INVENTORY							
0.55 Fy = POSTED							
0.67 Fy = OPERATING							

THE TEMPORARY BRIDGE WATERWAY REQUIREMENTS ALLOW THE INSTALLATION OF THE TEMPORARY BRIDGE AT ANYTIME AND IS ADEQUATE FOR WINTER USE PROVIDED THAT ALL ENVIRONMENTAL REGULATIONS ARE ADHERED TO.

RECOMMENDED FOR APPROVAL

Warren B. Davis	6/21/85	STRUCTURES ENGINEER	DATE
John E. Davis	6/24/85	CHIEF OF DESIGN	DATE
Acting		DIRECTOR OF ENGINEERING & CONSTRUCTION	DATE

STATE OF VERMONT AGENCY OF TRANSPORTATION

TOWN OF	CASTLETON	Bridge No.	12
HIGHWAY NO.	Vt. RTE. 4A	Log Sta.	
		Surv. Sta.	365

REVISIONS

NO.	DESCRIPTION	BY & DATE
1	ADDED NOTE	SP 6-88

PRELIMINARY INFORMATION

Designed by	G.V. SPILAK	Drawn by	D.C. WILLEY
Checked by	G.V. Spilak	Bridge Design Supervisor	R.S. HAUPT
date	6/85	date	5-85
PROJECT	CASTLETON-IRA	PROJECT NO.	RS 0142 (12)