


**NOTES:**

1. PHASE I CONSTRUCTION WITH LEFT LANE CLOSURE AND LEFT SIDE MEMBRANE SPLICE SHOWN, PHASE II CONSTRUCTION SIMILAR, RIGHT LANE CLOSURE AND RIGHT SIDE MEMBRANE SPLICE SIMILAR, CONTRACTOR TO DETERMINE LANE IN WHICH THE MEMBRANE SPLICE SHALL OCCUR, UNLESS THE BRIDGE IS SUPERELEVATED, BRIDGES WITH SUPERELEVATION SHALL HAVE THE MEMBRANE PLACED WITH THE HIGH SIDE OVERLAPPING THE LOW SIDE.
2. TWO WAY TRAFFIC AND TEMPORARY TRAVEL LANES WILL BE MAINTAINED AT ALL TIMES ON BRIDGE 9. FOR BRIDGE 9 TYPICAL BRIDGE SECTION SEE SHEET 9.
3. FOR PG BINDER GRADE SEE SECTION 406 OF THE GENERAL SPECIAL PROVISIONS.


**TYPICAL BRIDGE SECTION**  
NOT TO SCALE

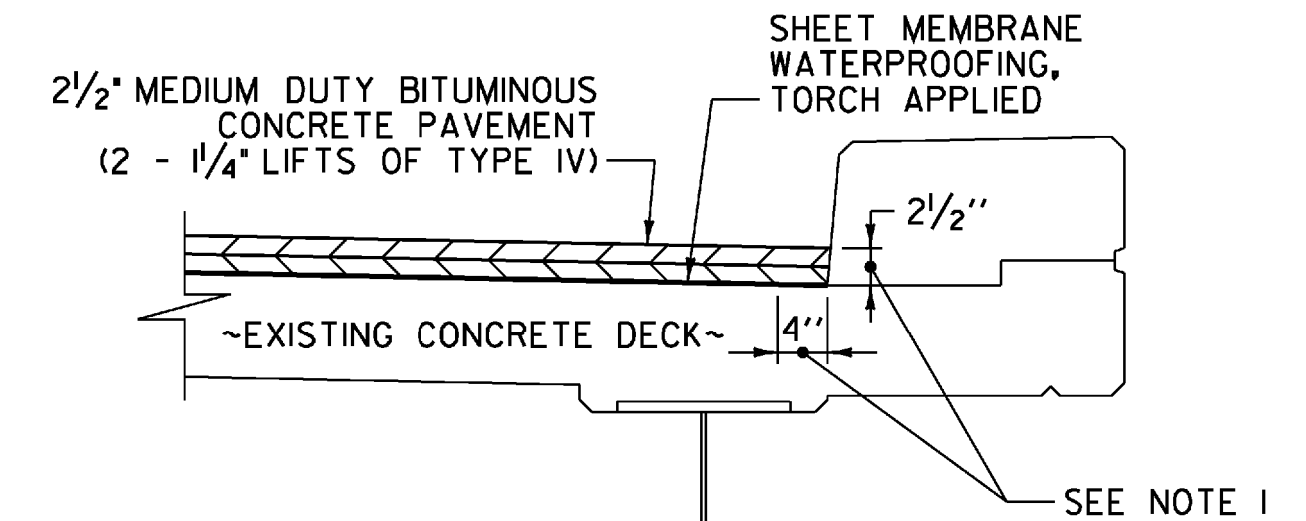

**DETAIL A NOTES:**

1. INDICATES AREA ALONG DECK AND UP FACE OF CURB FOR PLACEMENT OF TWO COATS OF POLYURETHANE MEMBRANE.
2. POLYURETHANE MEMBRANE AND BLAST CLEANING SHALL BE INCLUDED IN THE UNIT PRICE BID FOR SHEET MEMBRANE WATERPROOFING, TORCH APPLIED.
3. SHEET MEMBRANE WATERPROOFING SHALL EXTEND TO FACE OF CURB AS SHOWN.
4. IN ADDITION TO THE REQUIREMENTS OF SUBSECTION 519.04, BLAST CLEAN 2 1/2" UP THE FACE OF CURB PRIOR TO PLACING THE MEMBRANE.

**DETAIL A**  
NOT TO SCALE

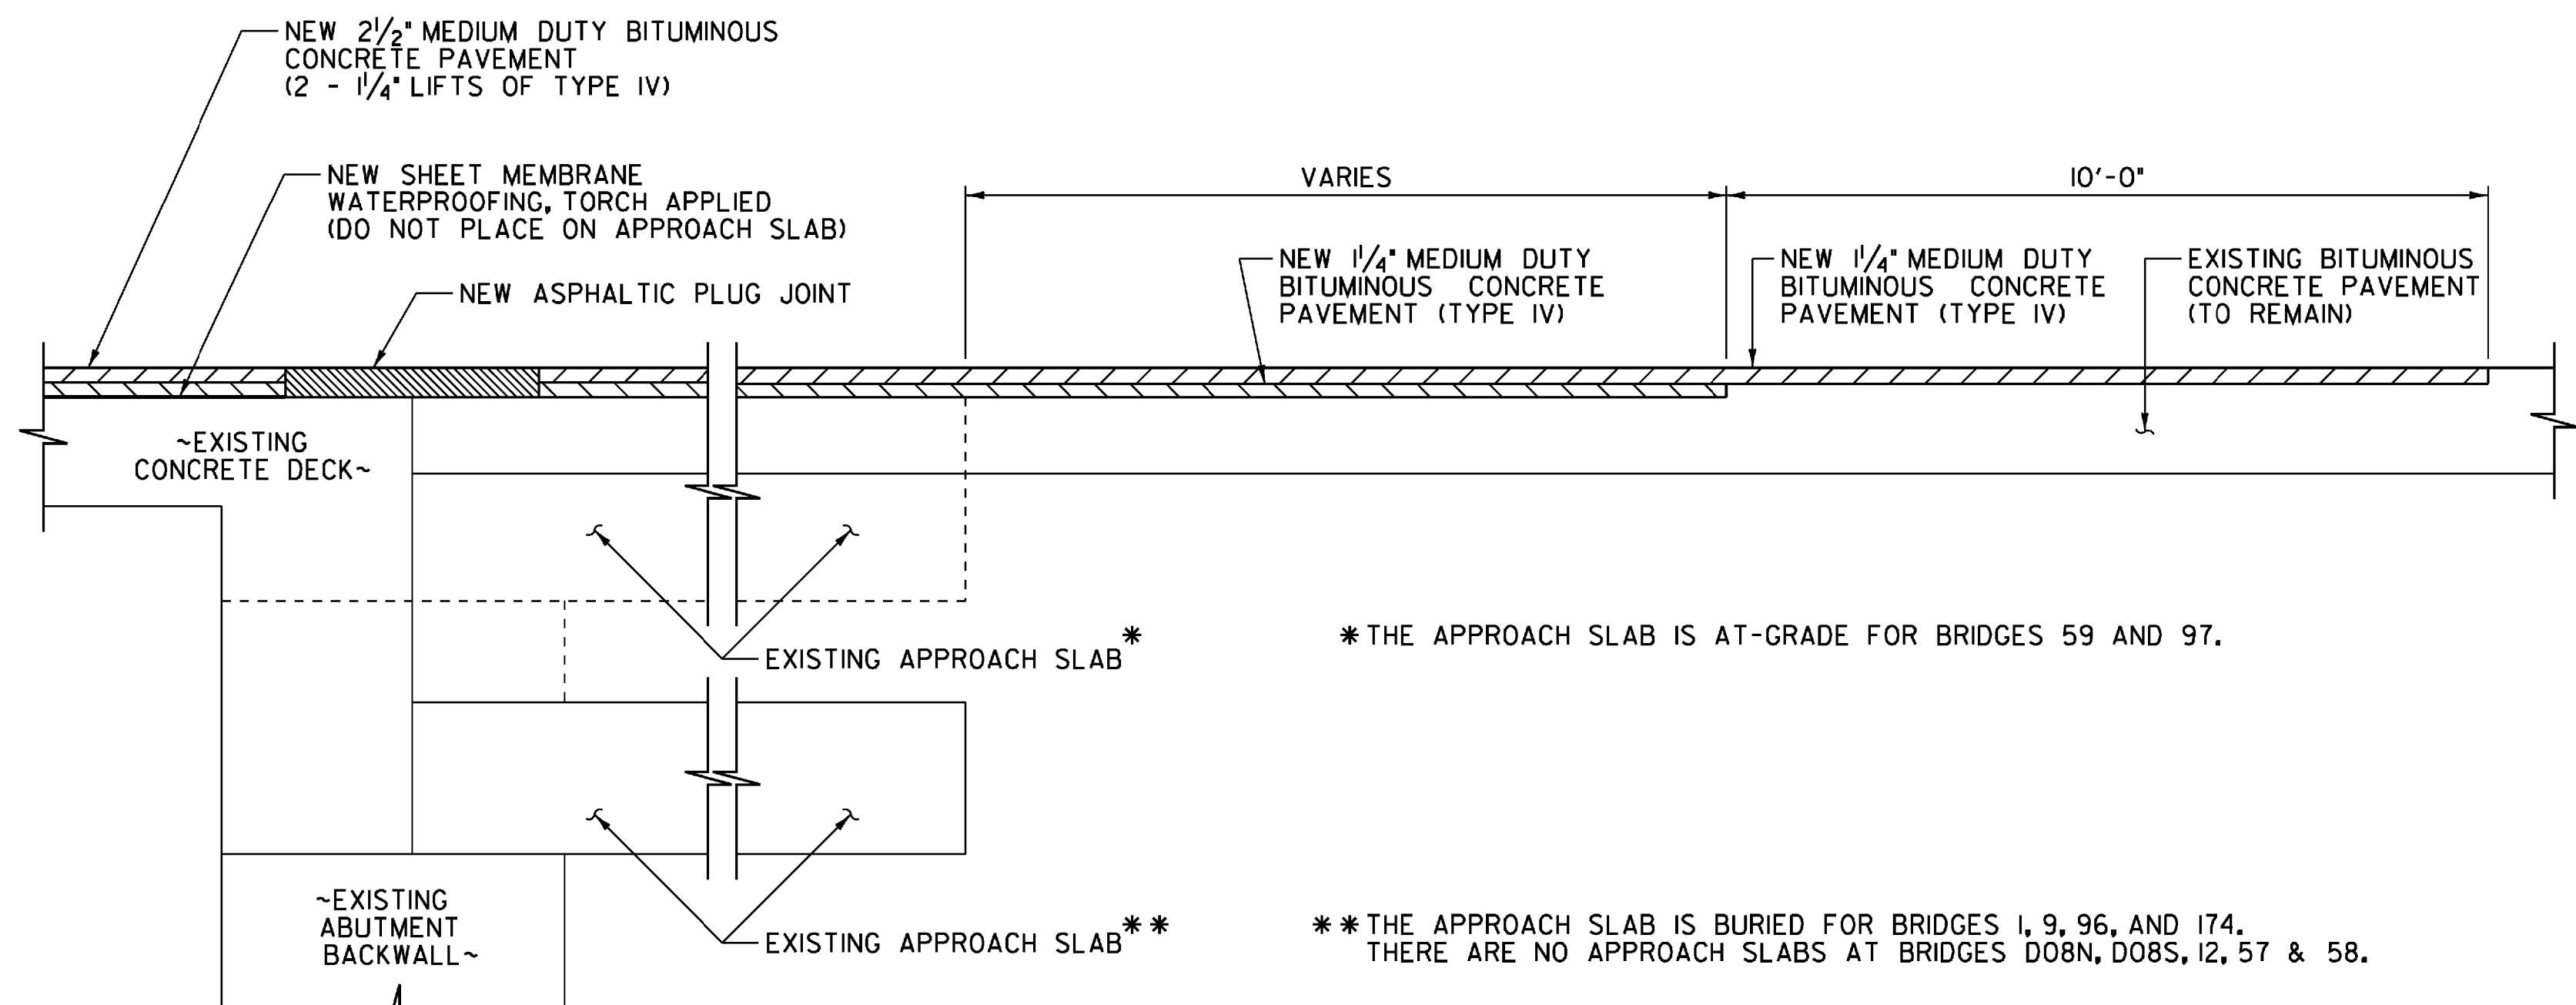

**TYPICAL APPROACH SECTION**  
NOT TO SCALE

BRIDGE LENGTH AND WIDTH (CURB TO CURB)		
BRIDGE NO.	WIDTH (CURB TO CURB) (FEET)	LENGTH (FEET)
1	32.83	59.00
9	50.67	213.67
12	32.67	92.01
57	34.00	54.00
58	30.00	99.00
59	34.00	33.00
96	38.67	73.72
97	41.7 39.5'	84.04 92.5'
174	32.83	141.74
D08N	31.34	123.76
D08S	31.34	123.76

ASPHALTIC PLUG JOINT REPLACEMENT SCHEDULE		
BRIDGE NO.	ABUT. 1	ABUT. 2
* 1	33 FT.	33 FT.
* 9	62 FT.	62 FT.
** 12	33 FT.	33 FT.
** 57	38 FT.	38 FT.
** 58	35 FT.	35 FT.
59	40 FT.	40 FT.
* 96	43 FT.	43 FT.
97	44 FT.	44 FT.
* 174	38 FT.	38 FT.
** D08N	34 FT.	34 FT.
** D08S	34 FT.	34 FT.

- \* - BURIED APPROACH SLAB, GALVANIZED STEEL PLATE NOT REQUIRED.
- \*\* - NO APPROACH SLAB, GALVANIZED STEEL PLATE NOT REQUIRED. (SEE ASPHALTIC PLUG-TYPE JOINT DETAIL ON SHEET 10).