


▲ CUT TO FIT

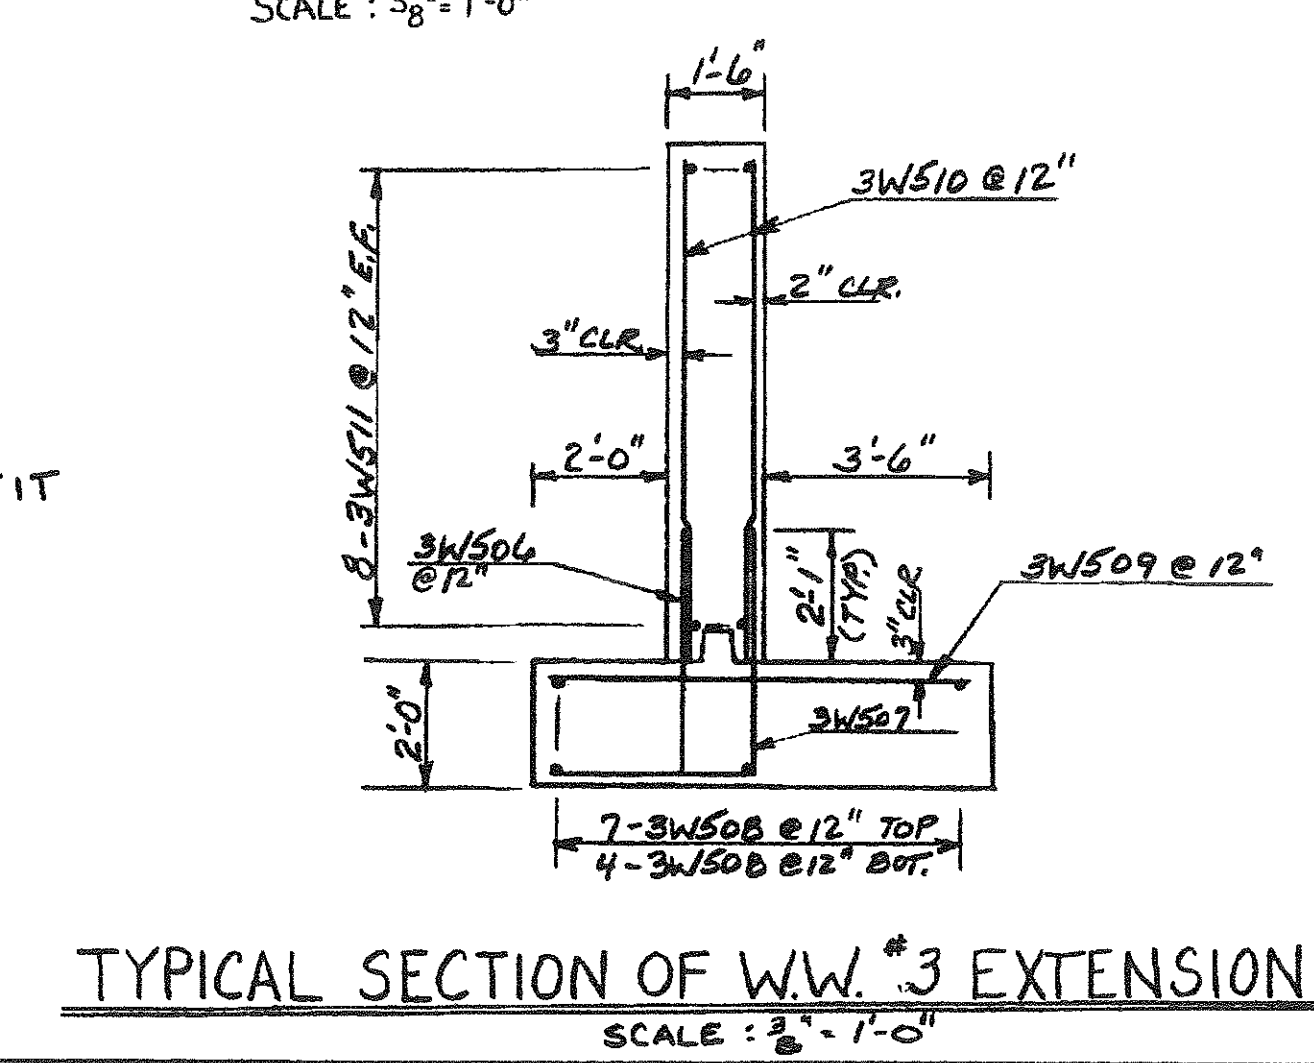

NOTE: 2' LAYER OF GRANULAR BACKFILL FOR STRUCTURES SHALL EXTEND 1' OUTSIDE EDGE OF FOOTING. THIS MATERIAL SHALL BE COMPACTED AS PER VT. STD. SPECIFICATION SECTION 203.10 (d).

STATE OF VERMONT AGENCY OF TRANSPORTATION	
Town Of BURKE	Bridge No. 1
Highway No. VT RTE 5A	Log Sta. 111+31.5
VT RTE 5A OVER SUTTON RIVER	
ABUTMENT #2 DETAILS	
Designed By J.B. MCCARTHY	Drawn By M. MARQUISE
Checked By J.B. MCCARTHY	Date 6/85
Bridge Design Supervisor E.L. DUFFLEY Date 6-85	
PROJECT BURKE	PROJECT NO. BRS 0287(3)S
L.S.C. Info.	
Bridge Sheet No. BR110	Sheet 26 of 81

BR-6