


ESTIMATED QUANTITIES

ITEM	DESCRIPTION	UNIT	NET	ORIG.	TOTAL	FINAL
405	SPIRAL REINFORCING	L.S.	1'	0'	1'	1'
301-B	BITUMINOUS CONCE. PREVENT (mod)	Ton	29	4	33	36
401-B	CONCRETE CLASS "B" (MOD)	C.Y.	69	4	73	64
402	REINFORCING STEEL (See Detail III Details)	100 LBS	-	-	-	12,625
404-A	STRUCTURAL STEEL	LBS	43,000	43,000	43,000	41,167
347-C	HEAVY DUTY WELDED CORRUGATED GALV. WITH STEEL TOP & F.	100 LBS	-	109	-	109

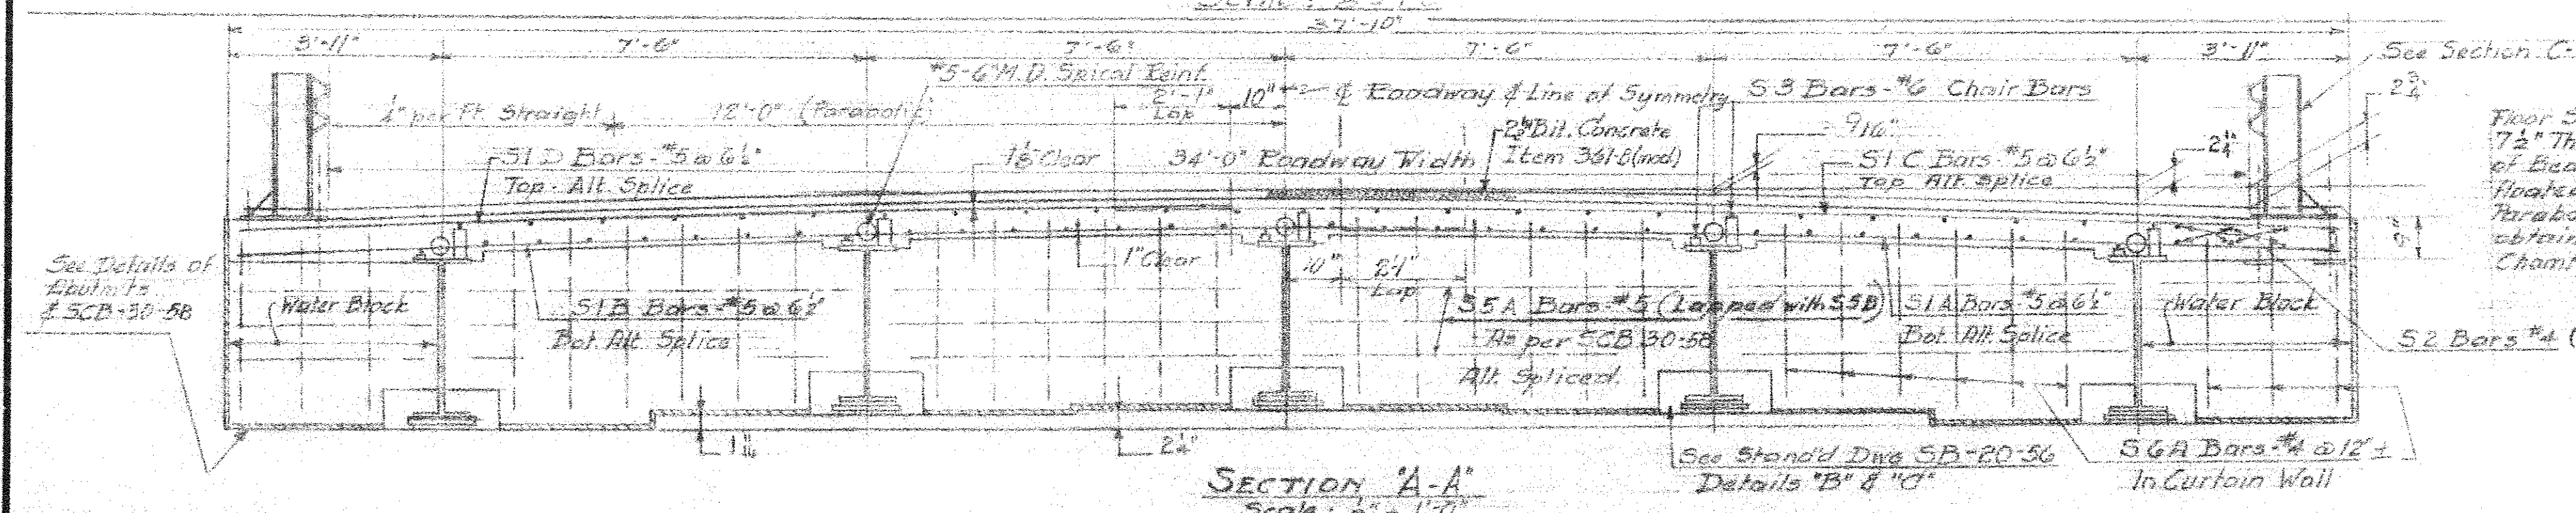

STATEWIDE - N.E. REGION
 BHF MEMB(19)
 SHEET 56 OF 80
 BRIDGE No. 57
 FOR REFERENCE ONLY

STATE OF VERMONT
 DEPARTMENT OF HIGHWAYS

TOWN OF NEWPORT-TROY
 ROUTE No. VT. 105 LOG STA. 9+06
 DETAILS OF SUPERSTRUCTURE

SCALE: As Noted
 SURVEYED BY:
 DRAWN BY: D.E.B. CHECKED BY: J.C.B.
 PROJECT No. F.034-2(2)
 SHEET 57 OF 156