


NOTE Concrete Class "C"
 Drilling & Grouting of DOWELS to be paid under price bid for Concrete
 Chamfer exposed edges 3/4"
 DOWELS to be paid for under unit price bid for Reinforcing Steel
 Weep holes to be paid under unit price bid for Concrete.
 For Estimated Quantities see Sheet No. F034-2(2) 5A & 6
 Sheet No. F034-2(2) 5A & 6

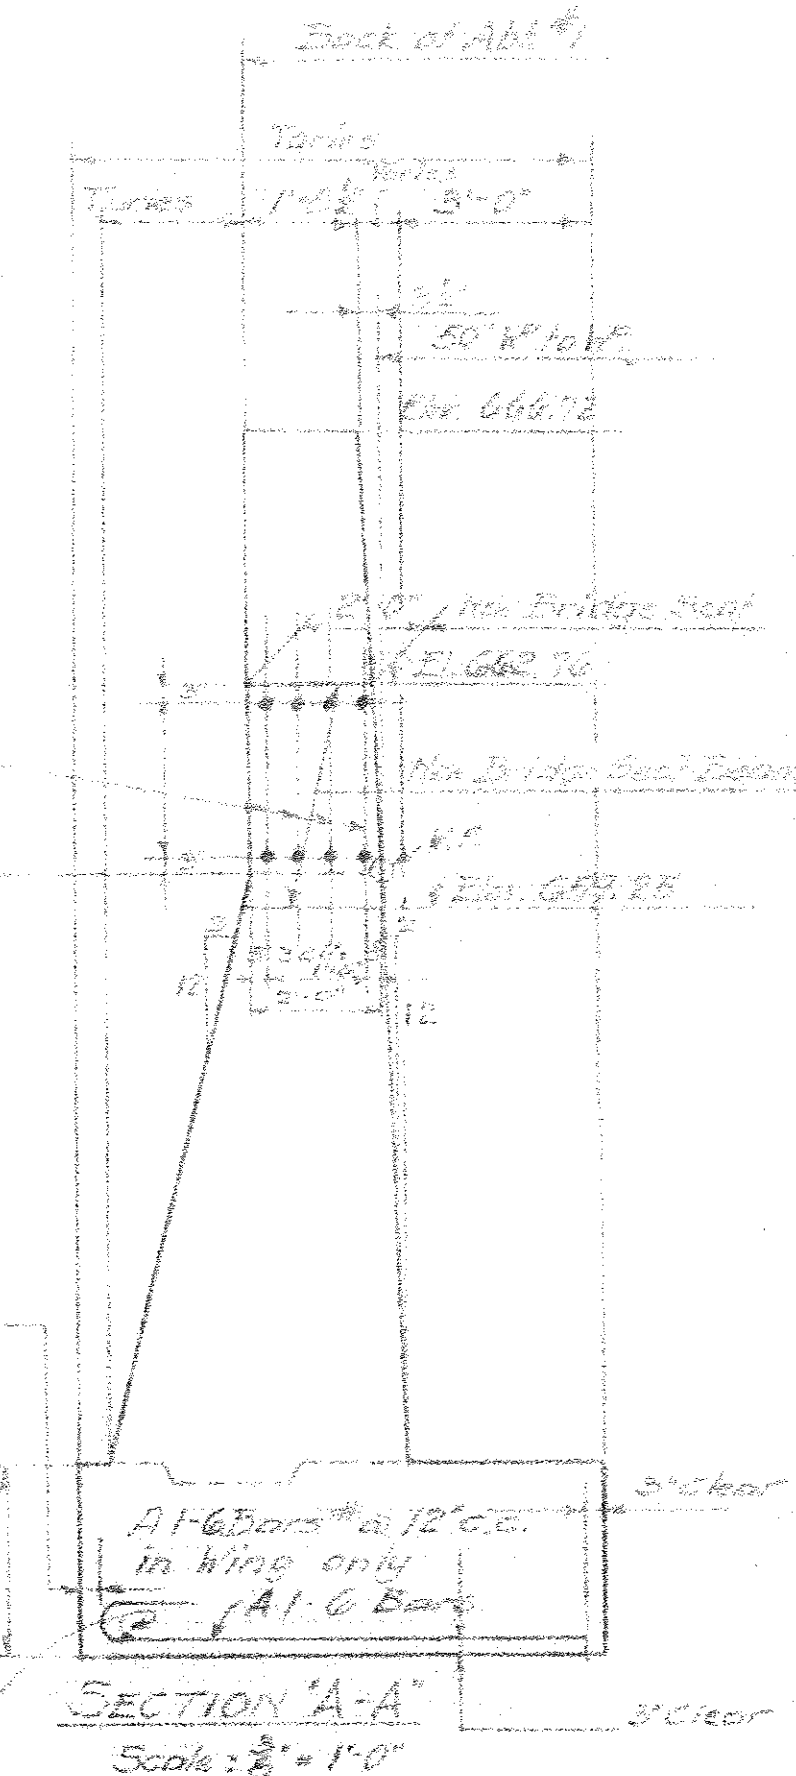

STATE OF VERMONT
 DEPARTMENT OF HIGHWAYS

TOWN OF NEWPORT-TROY
 ROUTE No. TT 105 LOG STA. 9+06
PLAN & ELEVATION OF ABUT. #1

SCALE 3/8" = 1'-0"
 SURVEYED BY _____
 DRAWN BY D.E.D. CHECKED BY J.C.B.
 PROJECT No. F.034-2(2)
 SHEET 22 OF 126

STATEWIDE - N.E. REGION
 BHF MEMB(19)
 SHEET 57 OF 80
 BRIDGE No. 57
 FOR REFERENCE ONLY