


STATEWIDE - N.E. REGION
 BHF MEMB(19)
 SHEET 58 OF 80
 BRIDGE No. 57
 FOR REFERENCE ONLY

NOTE: Concrete Class "C"
 Drilling & Grouting of Dowels to be paid under unit price bid for Concrete.
 Dowels to be paid for under unit price bid for Reinforcing Steel. Keep holes to be paid under unit price bid for Concrete.
 The Estimated Quantities See Div. 1 054-2 (C) SAF-C

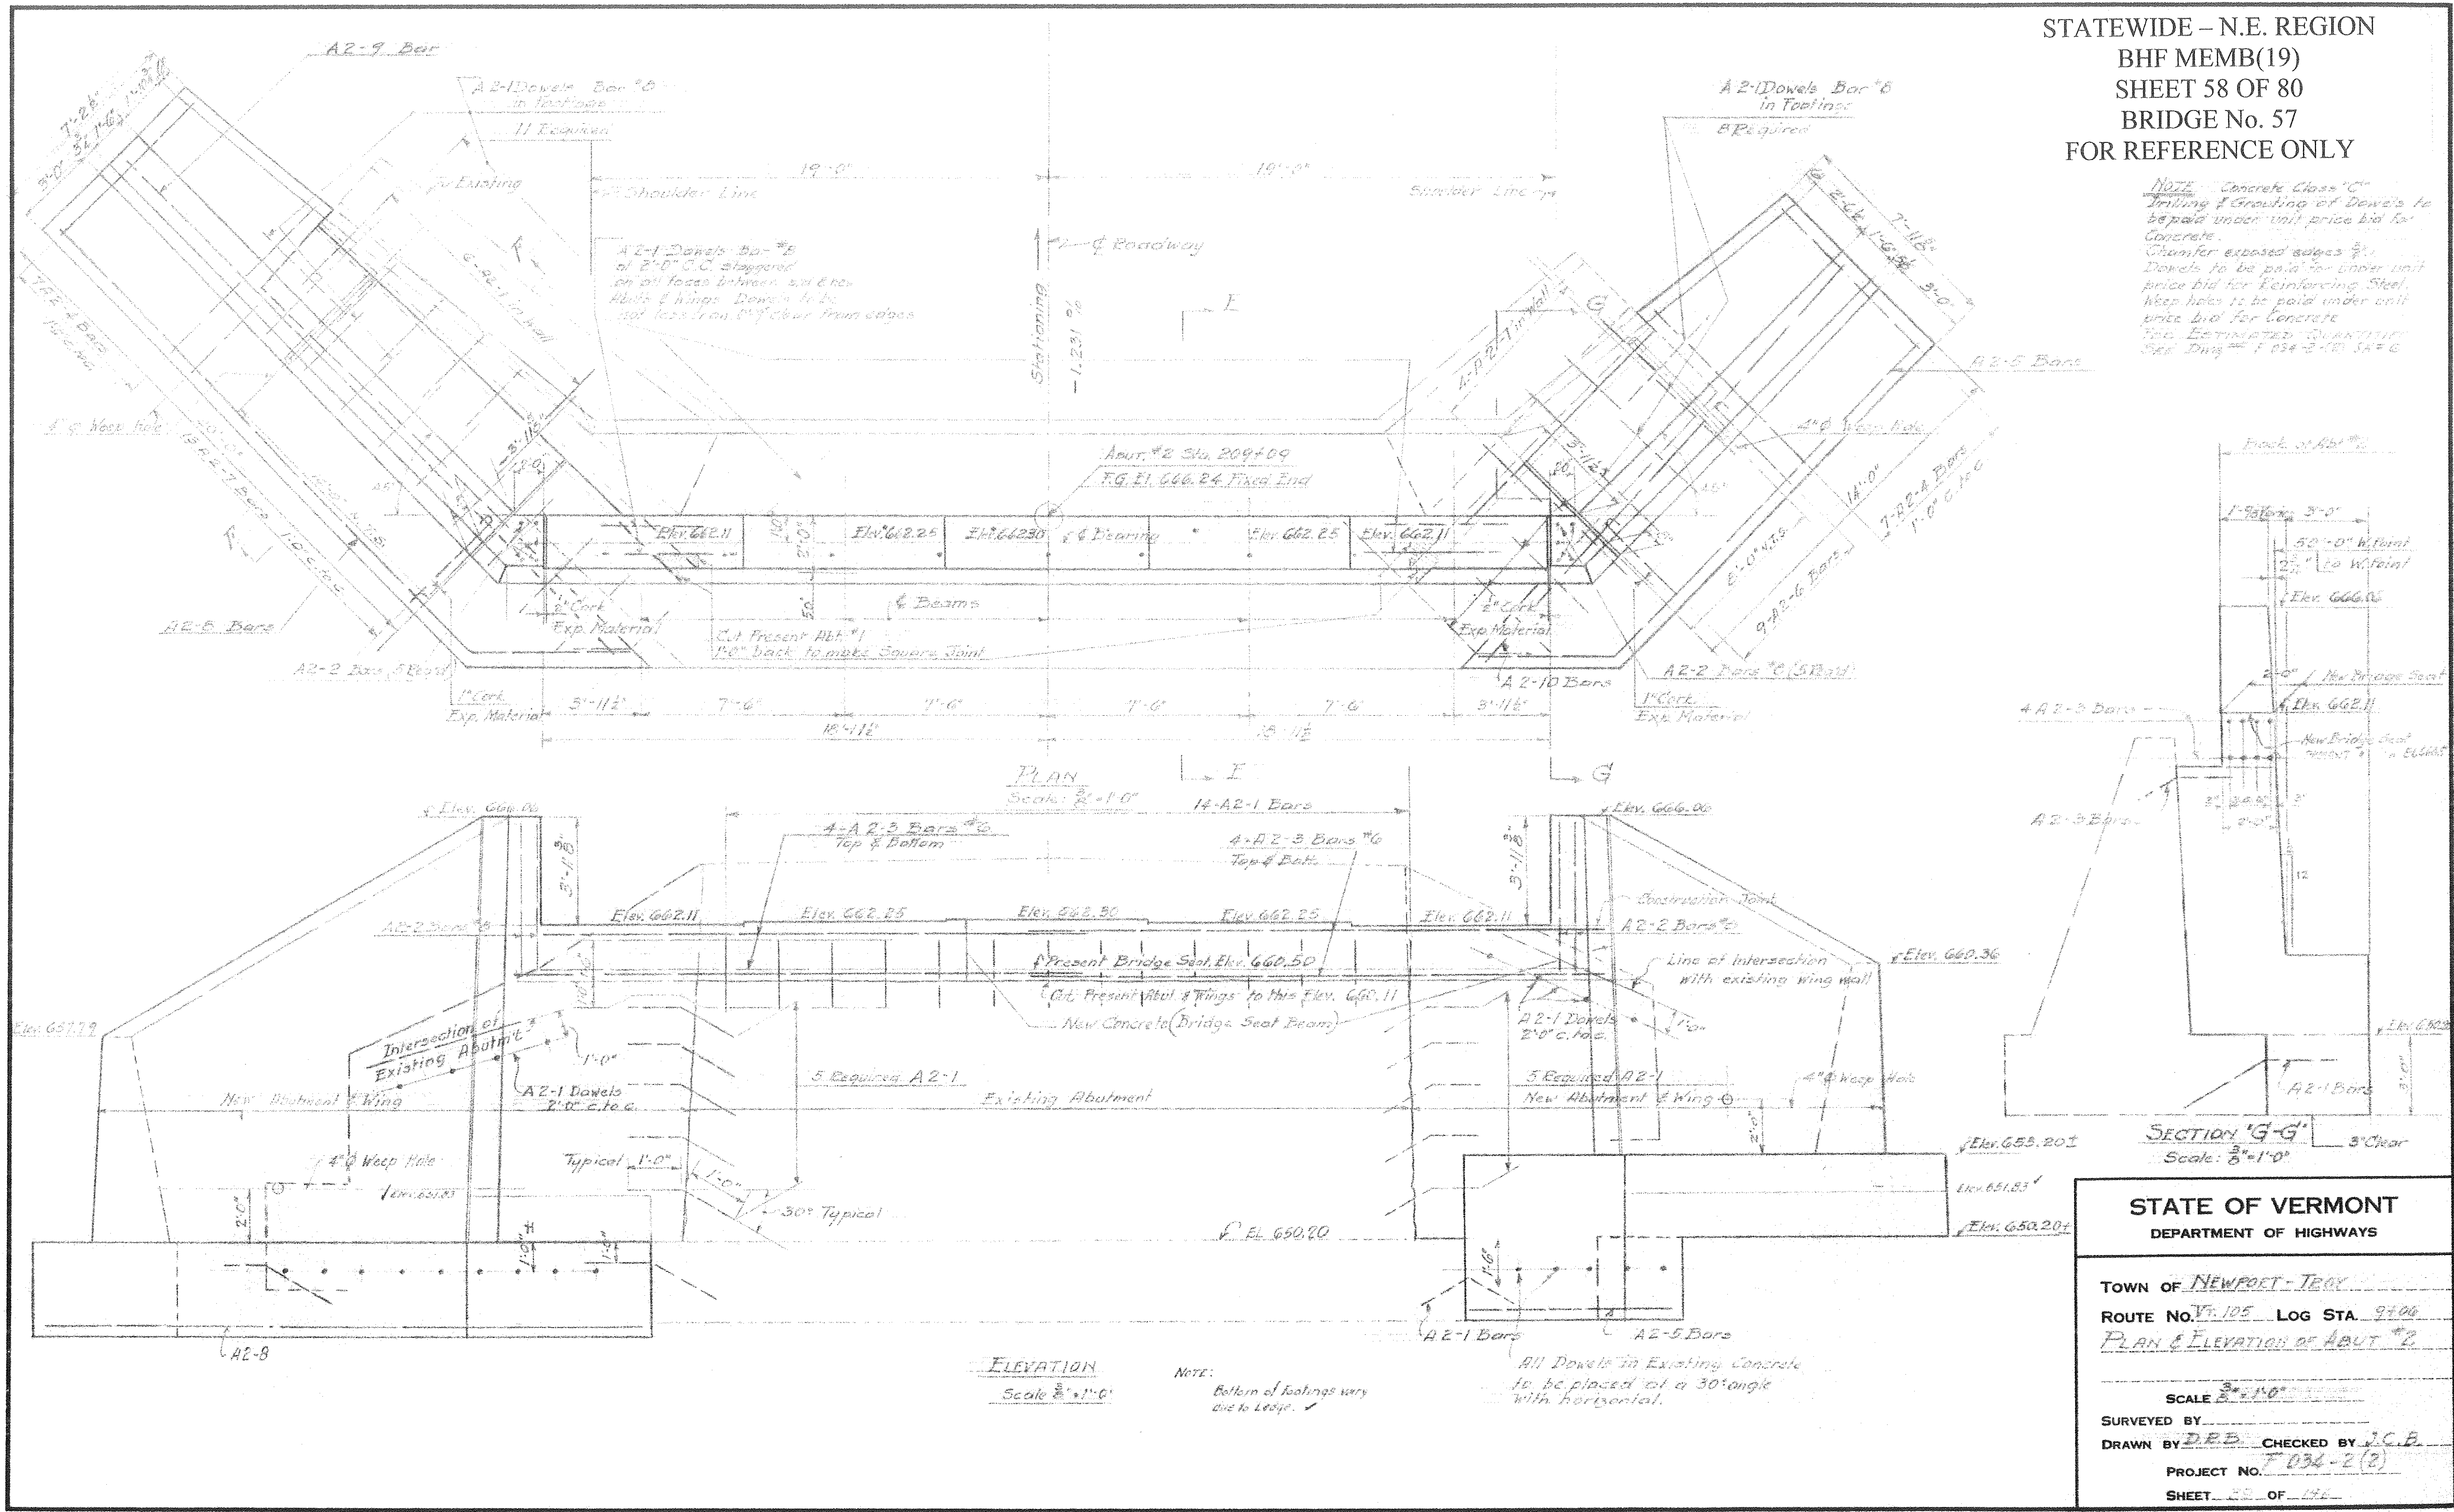

STATE OF VERMONT
 DEPARTMENT OF HIGHWAYS

TOWN OF NEWPORT-TERRY

ROUTE No. 105 LOG STA. 9406

PLAN & ELEVATION OF ABUT #2

SCALE $\frac{3}{8}'' = 1'-0''$

SURVEYED BY _____

DRAWN BY D.P.B. CHECKED BY J.C.B.

PROJECT No. F 036-2 (2)

SHEET 58 OF 146