


- NOTES:
- 1 BR. ST. EL. ARE FOR 6 BR.
 - 2 CUR. EXPOSED BR. ST. WITH ASPH.-ASB. COAT. TO 12\"/>
 - 3 DESIGNED FOR OVERLOADING
 - 4 TREATED TIMBER PILING DRIVEN TO 20 TON BRGAL

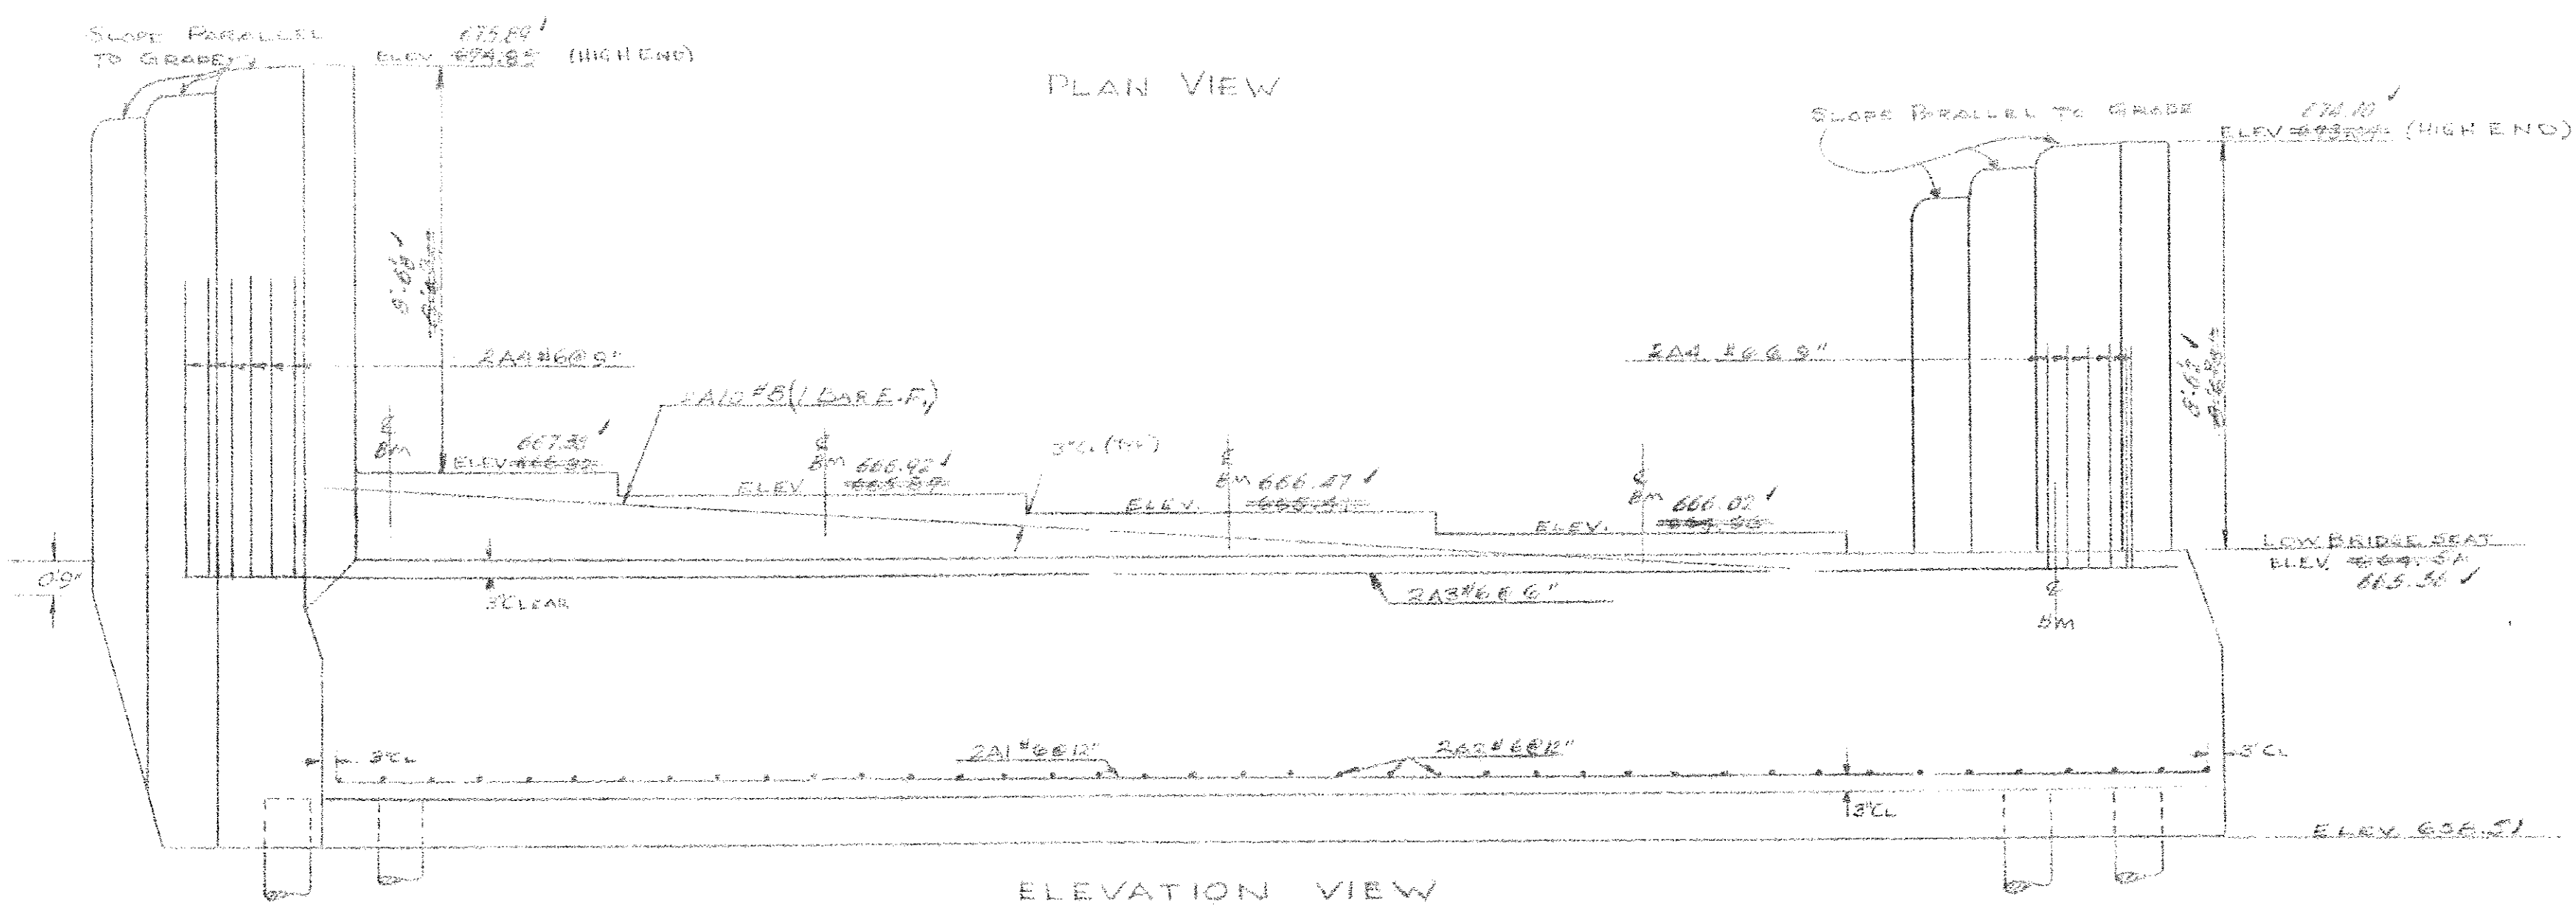

ESTIMATED QUANTITIES				
NO.	ITEM	UNIT	NET QUANTITY	TOTAL FINAL
106C	UNCLASS. GRAN. EXC.	C.Y.	1180	1180
107	STRUCTURE EXCAV.	C.Y.	50	50
401B	CONCRETE CLB (MOO)	C.Y.	60	60
407	ASPH. ASBESTOS COAT	S.Y.	4	4
101B	SOLID ROCK EXCAV.	C.Y.	120	120
508	TREATED TIMBER PILING	L.F.	950	950
521	STONE FILL HEAVY TYPE	C.Y.	504	504
402	REINF. STEEL	SEE REINF. STEEL SCHEDULE		

STATE OF VERMONT
DEPARTMENT OF HIGHWAYS

TOWN OF TECUMSEH
ROUTE NO. VT 105 LOG STA. 54.136
DETAILS OF ABUTMENT NO. 2

SCALE 3/8" = 1'-0"
SURVEYED BY _____
DRAWN BY EAB CHECKED BY WMS
PROJECT NO. P-574-2(2)
SHEET 22 OF 22

STATEWIDE - N.E. REGION
BHF MEMB(19)
SHEET 63 OF 80
BRIDGE No. 58
FOR REFERENCE ONLY