


ESTIMATED QUANTITIES

ITEM	DESCRIPTION	UNIT	NET	WASTE	TOTAL	TOTAL
101E	Ball's End Excavation	C.Y.	5	1	6	0
102	Borrow	"	15	2	17	15
105C	Unclassified Channel Excavation	"	117	3	120	121
107	Structure Excavation	"	205	21	226	238
222	Gravel Bankfill	"	15	1	16	0
401B	Concrete Class "B" (Inst.)	"	114	9	123	176
402	Reinforcing Steel (See Steel Sched.)	Lbs	1453		1453	1452
521	Stone Fill	C.Y.	5	1	6	0

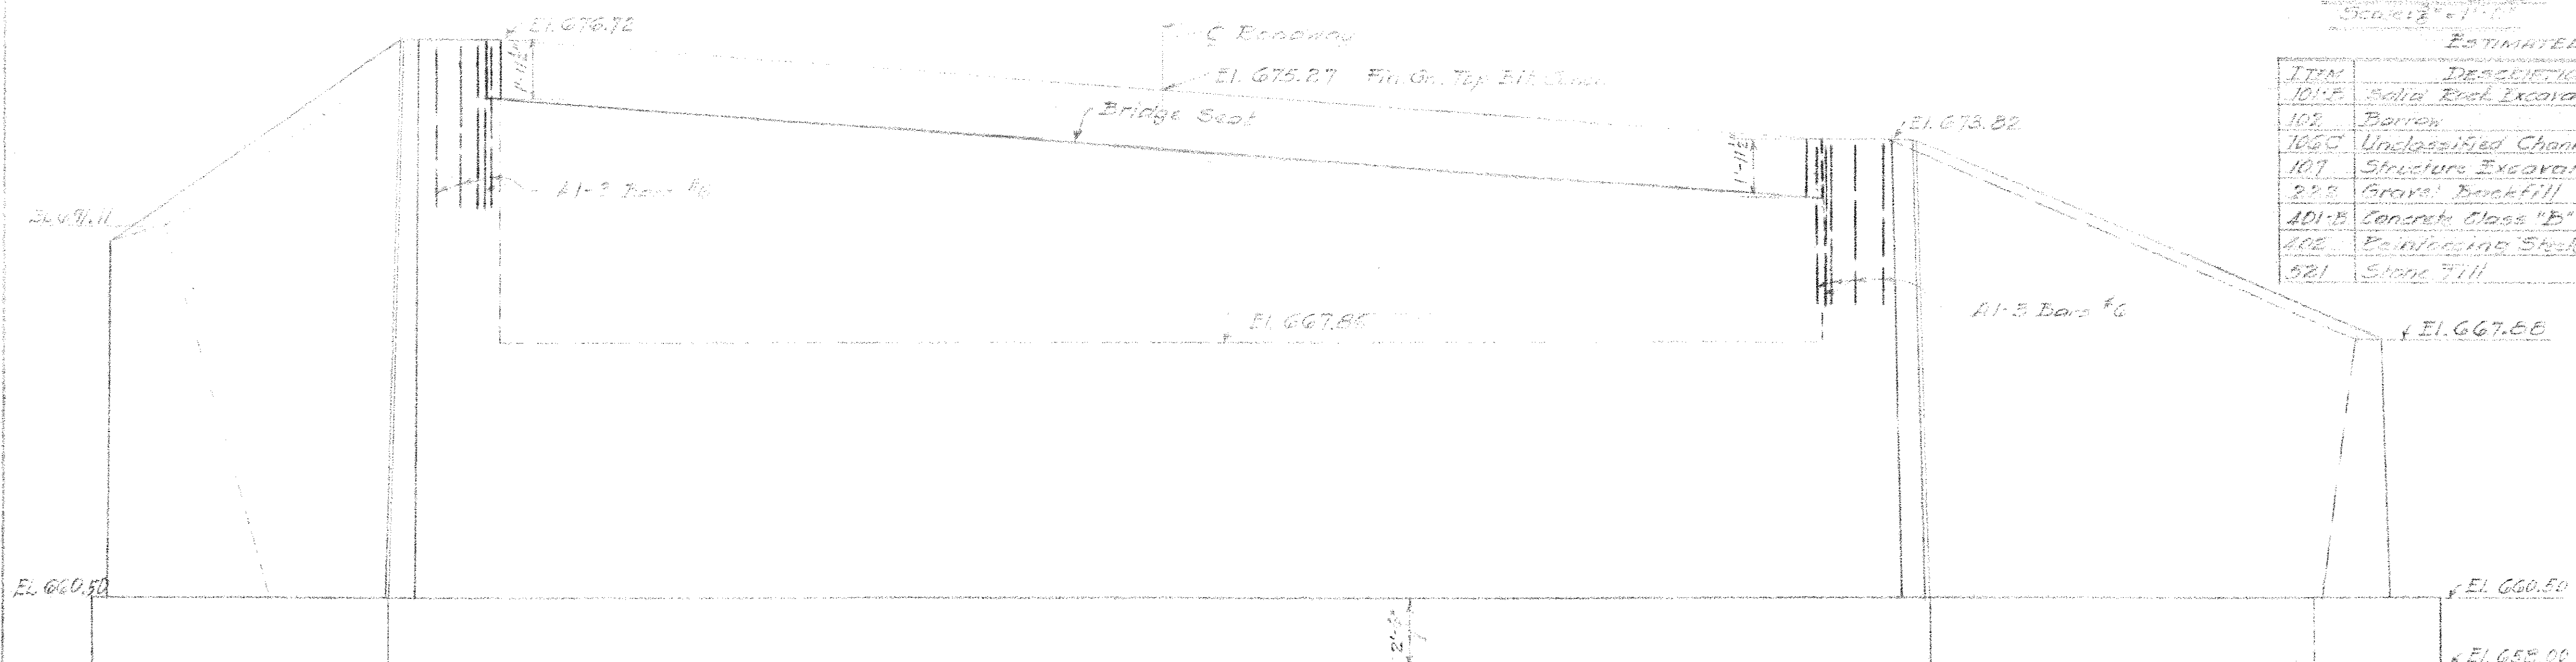

ELEVATION  
Scale: 3/8" = 1'-0"

STATEWIDE - N.E. REGION  
BHF MEMB(19)  
SHEET 65 OF 80  
BRIDGE No. 59  
FOR REFERENCE ONLY

NOTE:  
Bottom of footing  
irregular due to boulders. ✓

STATE OF VERMONT  
DEPARTMENT OF HIGHWAYS

TOWN OF NEWPORT - TROY  
ROUTE No. Vt. 105 LOG STA 64+80  
PLAN & ELEVATION OF ABUT. No. 1

SCALE: As Noted  
SURVEYED BY:  
DRAWN BY: D.E.B. CHECKED BY: EDWARDS  
PROJECT NO. F 032-2(2)  
SHEET 25 OF 176