


NOTE: PROVIDE #5 BARS AT 10\"/>

SUMMARY QUANTITIES

ITEM	DESCRIPTION	UNIT	NET	D-RUN	TOTAL	FINAL
101B	SOLID ROCK EXCAVATION	CY	47	47	47	7
10E	BORROW	CY	50	50	50	45
106C	UNCLASSIFIED CHANNEL EXCAVATION	CY	25	25	25	25
107	STRUCTURE EXCAVATION	CY	453	453	453	530
222	GRAVEL BACKFILL	CY	5	5	5	112
301-B	BITUMINOUS CONC PAVEMENT	TON	20	20	20	20
401-B	CONCRETE CLASS "B" (MOD.)	CY	119	119	119	113
402	REINFORCING STEEL	LBS	17,081	-	17,081	17,701
441	TEMPORARY BRIDGE	L.S.	4	-	4	0
442	REMOVAL OF SUPERSTRUCTURE	L.S.	1	-	1	1
521	STONE FILL (HEAVY TYPE)	CY	40	4	44	0
547.C	HEAVY DUTY ST. BM GRAIL/STL POINT (MOD.)	LINFT	70	-	70	60

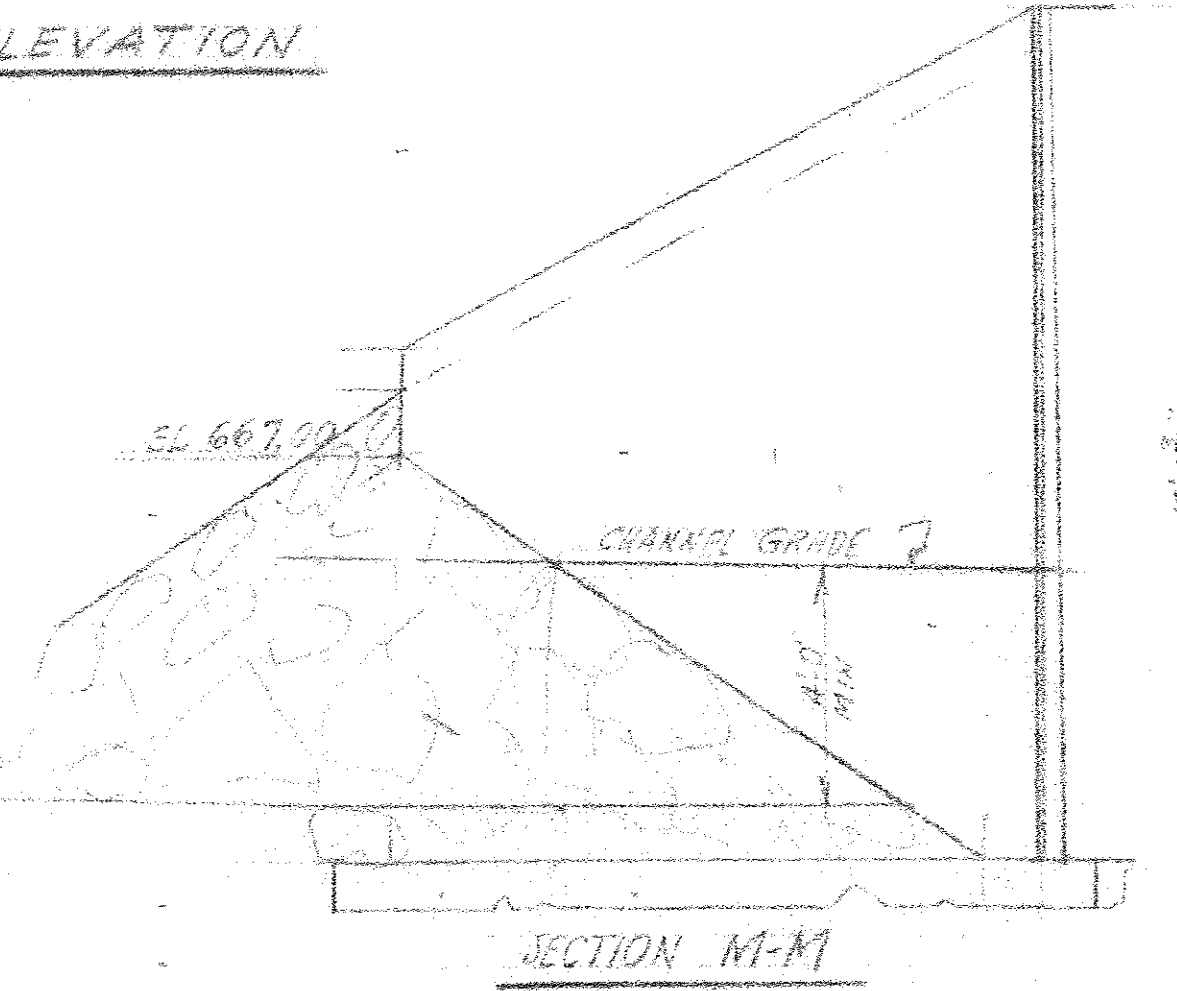

ESTIMATED QUANTITIES

ITEM	DESCRIPTION	UNIT	NET	D-RUN	TOTAL	FINAL
101B	SOLID ROCK EXCAVATION	CY	40	4	44	7
10E	BORROW	"	30	5	35	30
106C	UNCLASSIFIED CHANNEL EXCAVATION	"	23	2	25	23
107	STRUCTURE EXCAVATION	"	245	25	270	270
222	GRAVEL BACKFILL	"	2	-	2	112
401B	CONCRETE CLASS "B" (MOD.)	"	175	4	179	167
402	REINFORCING STEEL	LBS	17,081	-	17,081	17,701
521	STONE FILL (HEAVY TYPE)	CY	5	2	7	0

STATEWIDE - N.E. REGION
 BHF MEMB(19)
 SHEET 66 OF 80
 BRIDGE No. 59
 FOR REFERENCE ONLY

STATE OF VERMONT
 DEPARTMENT OF HIGHWAYS

TOWN OF NEWPORT TROY
 ROUTE No. VT 105 LOG STA. 64+80
 DETAILS OF ABUTMENT No. 2

SCALE 3/8" = 1'-0"

SURVEYED BY _____
 DRAWN BY J.C.B. CHECKED BY HAUPT
 PROJECT No. F-534-E (2)
 SHEET 66 OF 150