

GENERAL NOTES

1. SEE STANDARD SCB-DI-71 FOR ADDITIONAL GENERAL NOTES.
2. ALL STRUCTURAL STEEL SHALL BE ASTM A-588 UNPAINTED, UNLESS OTHERWISE NOTED.
3. ALL STRUCTURAL STEEL SHALL BE CLEANED PRIOR TO LEAVING THE FABRICATING SHOP USING ANY METHOD SPECIFIED IN SECTION 513.03. SURFACE PREPARATION AFTER THE BEAMS HAVE BEEN ERECTED AND ALL SUPERSTRUCTURE CONCRETE HAS BEEN PLACED, THE ENTIRE OUTSIDE SURFACE AND BOTTOM OF LOWER FLANGE OF THE FASCIA BEAMS SHALL BE CLEANED AS SPECIFIED IN SUBSECTION 506.50(B), CLEANING OF STEEL.
4. SUPERSTRUCTURE CONCRETE SHALL BE CONCRETE CLASS A. ALL OTHER CONCRETE SHALL BE CONCRETE CLASS B. ALL EXPOSED CONCRETE EDGES IN THE SUBSTRUCTURE AND SUPERSTRUCTURE SHALL BE CHAMFERED 1" x 1".
5. THE SLAB OVERHANG WILL BE 9" THICK. CARE SHALL BE TAKEN TO INSURE THAT BRACING FOR THE FORMWORK IS ADEQUATE TO PREVENT EXCESSIVE DEFLECTION. SUPPORT BRACKETS ARE TO BE SPACED AT 4'-0" MAX.
6. WINDWALL CONCRETE SHALL NOT BE PLACED ABOVE ADJACENT BRIDGE SEAT ELEVATIONS UNTIL BEAMS ARE PROFILED AND FINAL GRADE ESTABLISHED BY THE ENGINEER.
7. FOR ADDITIONAL CONSTRUCTION JOINT DETAILS, SEE STANDARD SCB-D6-73, DETAIL B.
8. REINFORCING STEEL SHALL HAVE 3" CLEAR COVER IN FOOTINGS AND 2" ELSEWHERE UNLESS OTHERWISE NOTED.
9. EPOXY COATING COMPOUND SHALL BE APPLIED TO EXPOSED BRIDGE SEAT SURFACES. ALL OTHER EXPOSED CONCRETE SURFACES INCLUDING THAT PORTION OF THE CURTAINWALL BETWEEN FASCIA BEAMS SHALL BE TREATED WITH WATER REPELLENT, EXCEPT FOR THE UNDERSIDE OF THE DECK BETWEEN FASCIA BEAMS.
10. UNCLASSIFIED CHANNEL EXCAVATION SHALL INCLUDE THOSE PORTIONS OF THE EXISTING ABUTMENTS WITHIN THE LIMITS SHOWN ON THE PLANS. THE EXISTING SUPERSTRUCTURE SHALL BE REMOVED UNDER THE ITEM REMOVAL OF EXISTING SUPERSTRUCTURE.
11. THE CONTRACTOR WILL BE PERMITTED TO UTILIZE THE EXISTING BAILEY BRIDGE IN HIS DETOUR. UPON COMPLETION OF THE PROJECT THE CONTRACTOR SHALL DISASSEMBLE THE BAILEY BRIDGE AND STOCKPILE IT AT AN ACCESSIBLE LOCATION ON THE PROJECT SITE. REFER TO SPECIAL PROVISIONS FOR THE PROJECT FOR FURTHER DETAILS.
12. EXPANSION ELASTOMERIC BEARINGS SHALL BE USED AT EACH END OF BEAMS. ALTERNATE BEARING PAD CONFIGURATIONS OR AN ALTERNATE TYPE OF BEARING DEVICE CAPABLE OF SUPPORTING INDICATED LOADS AND MOVEMENT AND DESIGNED IN ACCORDANCE WITH SECTION 731 AND AASHTO SPECIFICATIONS MAY BE SUBMITTED FOR APPROVAL. BRIDGE SEAT ELEVATIONS SHALL BE REVISED IF FINAL BEARING HEIGHT DIFFERS FROM THE 3" INDICATED BEARINGS TO BE PAID FOR AT UNIT PRICE BID PER LB. STRUCTURAL STEEL.

CURVE DATA
 REVISED "B" LINE
 CURVE #2
 Δ = 17°00' RT
 D = 3°45'
 R = 1527.89'
 T = 228.4'
 L = 453.3'
 E = 16.7'
 BANK .041 FT/FT


PLAN
 SCALE: 1" = 10'

INDEX OF SHEETS

- BR 100 PRELIMINARY INFORMATION
- 101 PLAN AND ELEVATION
- 102 QUANTITIES
- 103 FRAMING PLAN, TYPICAL SECTION & DETAILS
- 104 SUPERSTRUCTURE DETAILS & BEARINGS
- 105 ABUTMENTS #1 & 2
- 106 REINFORCING STEEL SCHEDULE
- 107-112 CHANNEL SECTIONS

STANDARD DRAWINGS

- SB-R1-71, SHEET 1 OF 2 1-28-74R
- SB-R1-71, SHEET 2 OF 2 1-28-74R
- SCB-DI-71 1-28-74R
- SCB-D6-73, DET. B & F 11-28-73
- E-3 11-7-73R

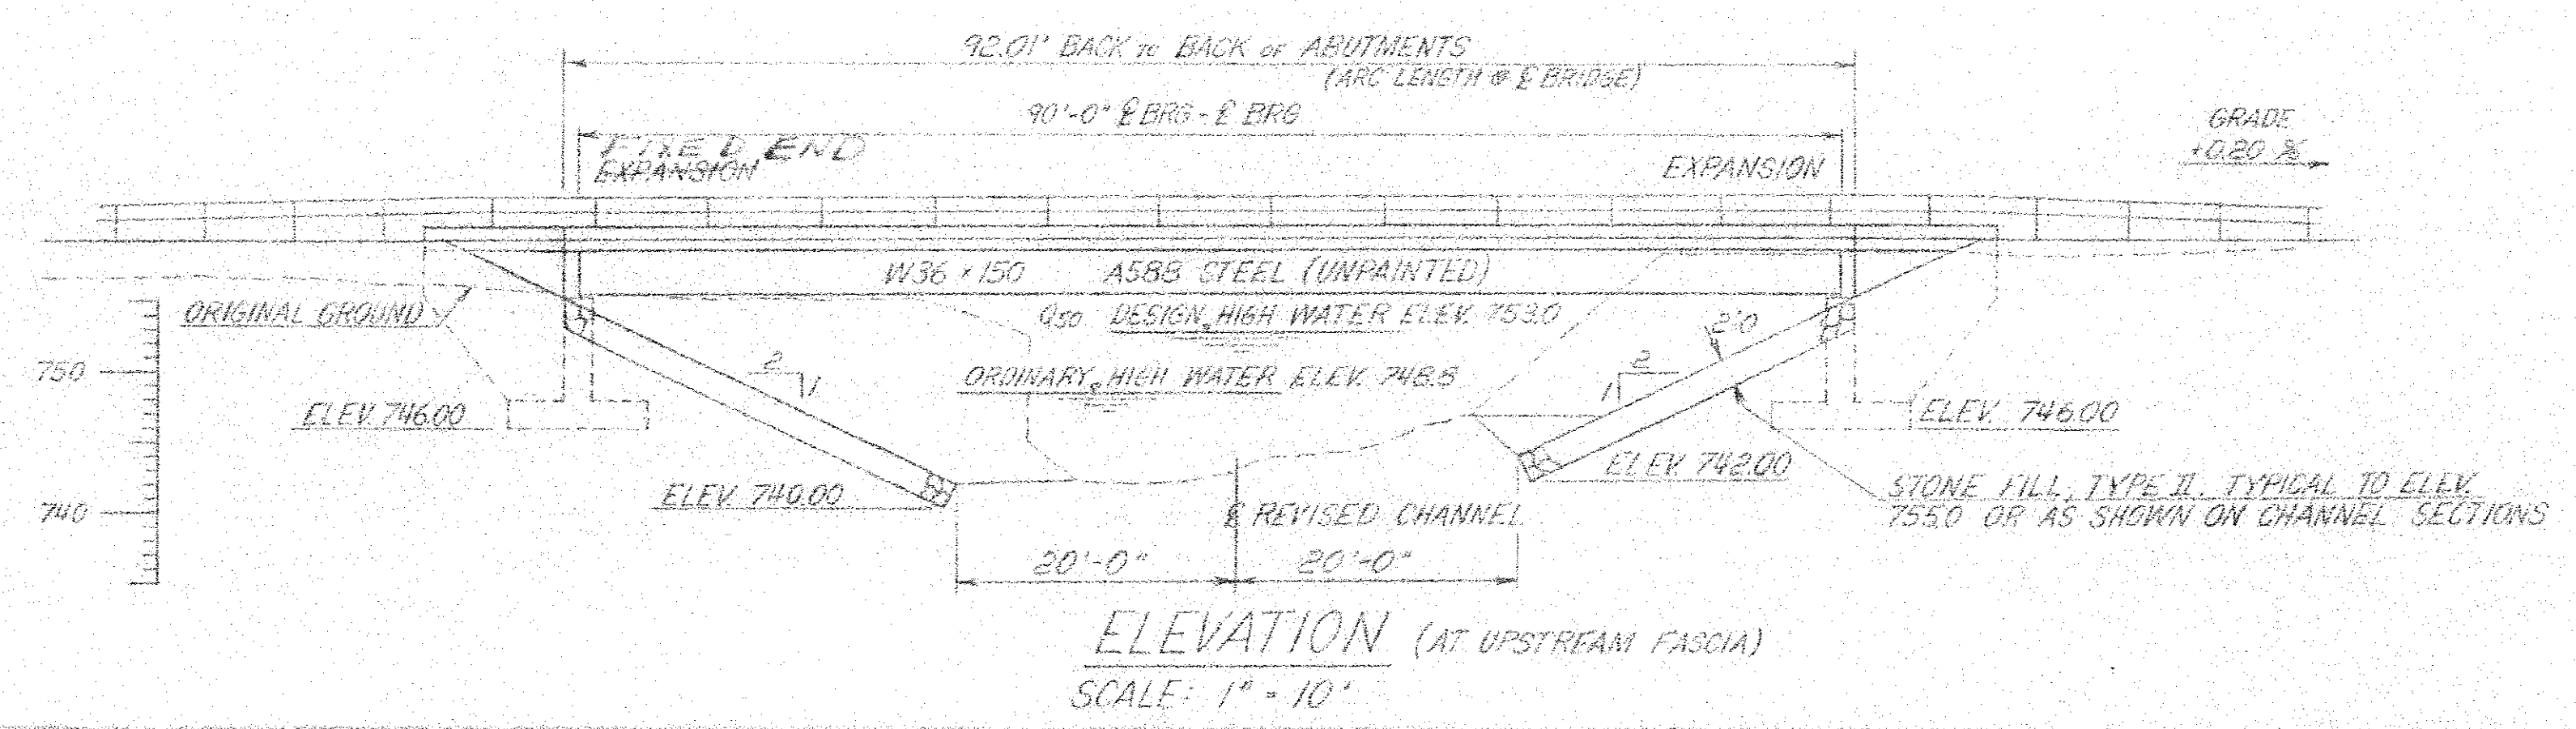

ELEVATION (AT UPSTREAM FASCIA)
 SCALE: 1" = 10'

STATEWIDE - N.E. REGION
BHF MEMB(19)
SHEET 77 OF 80
BRIDGE No. 12
FOR REFERENCE ONLY

STATE OF VERMONT DEPARTMENT OF HIGHWAYS			
PROJECT No.	WHEELOCK	Sheet No.	12
SECTION No.	VERMONT ROUTE 122	Long Sta.	50+66
		Short Sta.	52+58
VERMONT ROUTE 122 OVER MILLER RUN			
PLAN AND ELEVATION			
Designed by	E. ENGLEHARDT	Drawn by	E. ENGLEHARDT
Checked by	JAC 2/16	Builder/Inspector	
E. Beta	12/73	J. A. RICHARDSON	2/74
PROJECT	WHEELOCK	PROJECT No.	RS 0259(2)
Sheet No.	BR 101	Sheet	12
			48