



VIEW B - B
SCALE: 1/4" = 1'-0"
FOR LOCATION OF VIEW B-B
SEE SHEET III OF 121.

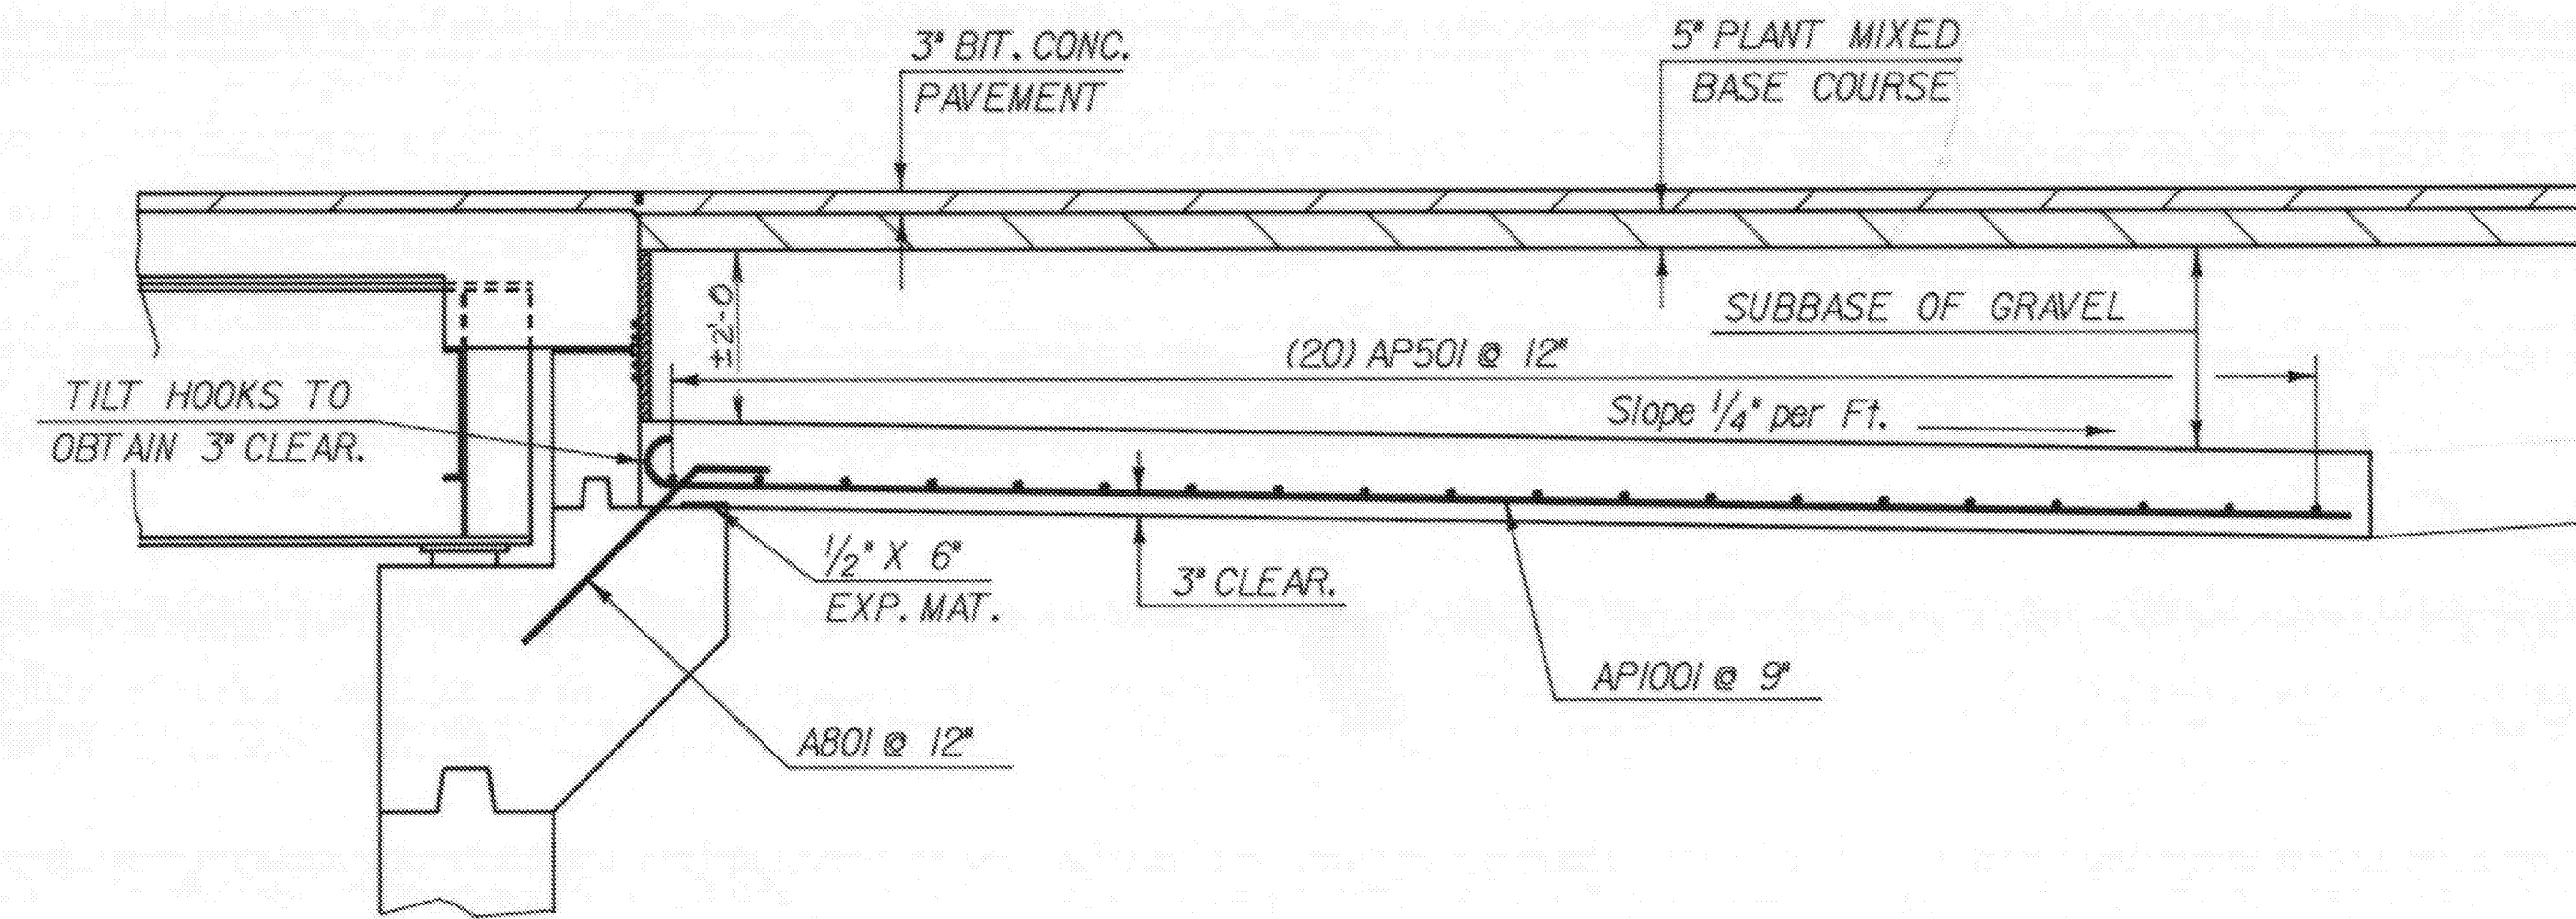

SECTION A - A
SCALE: 1/2" = 1'-0"

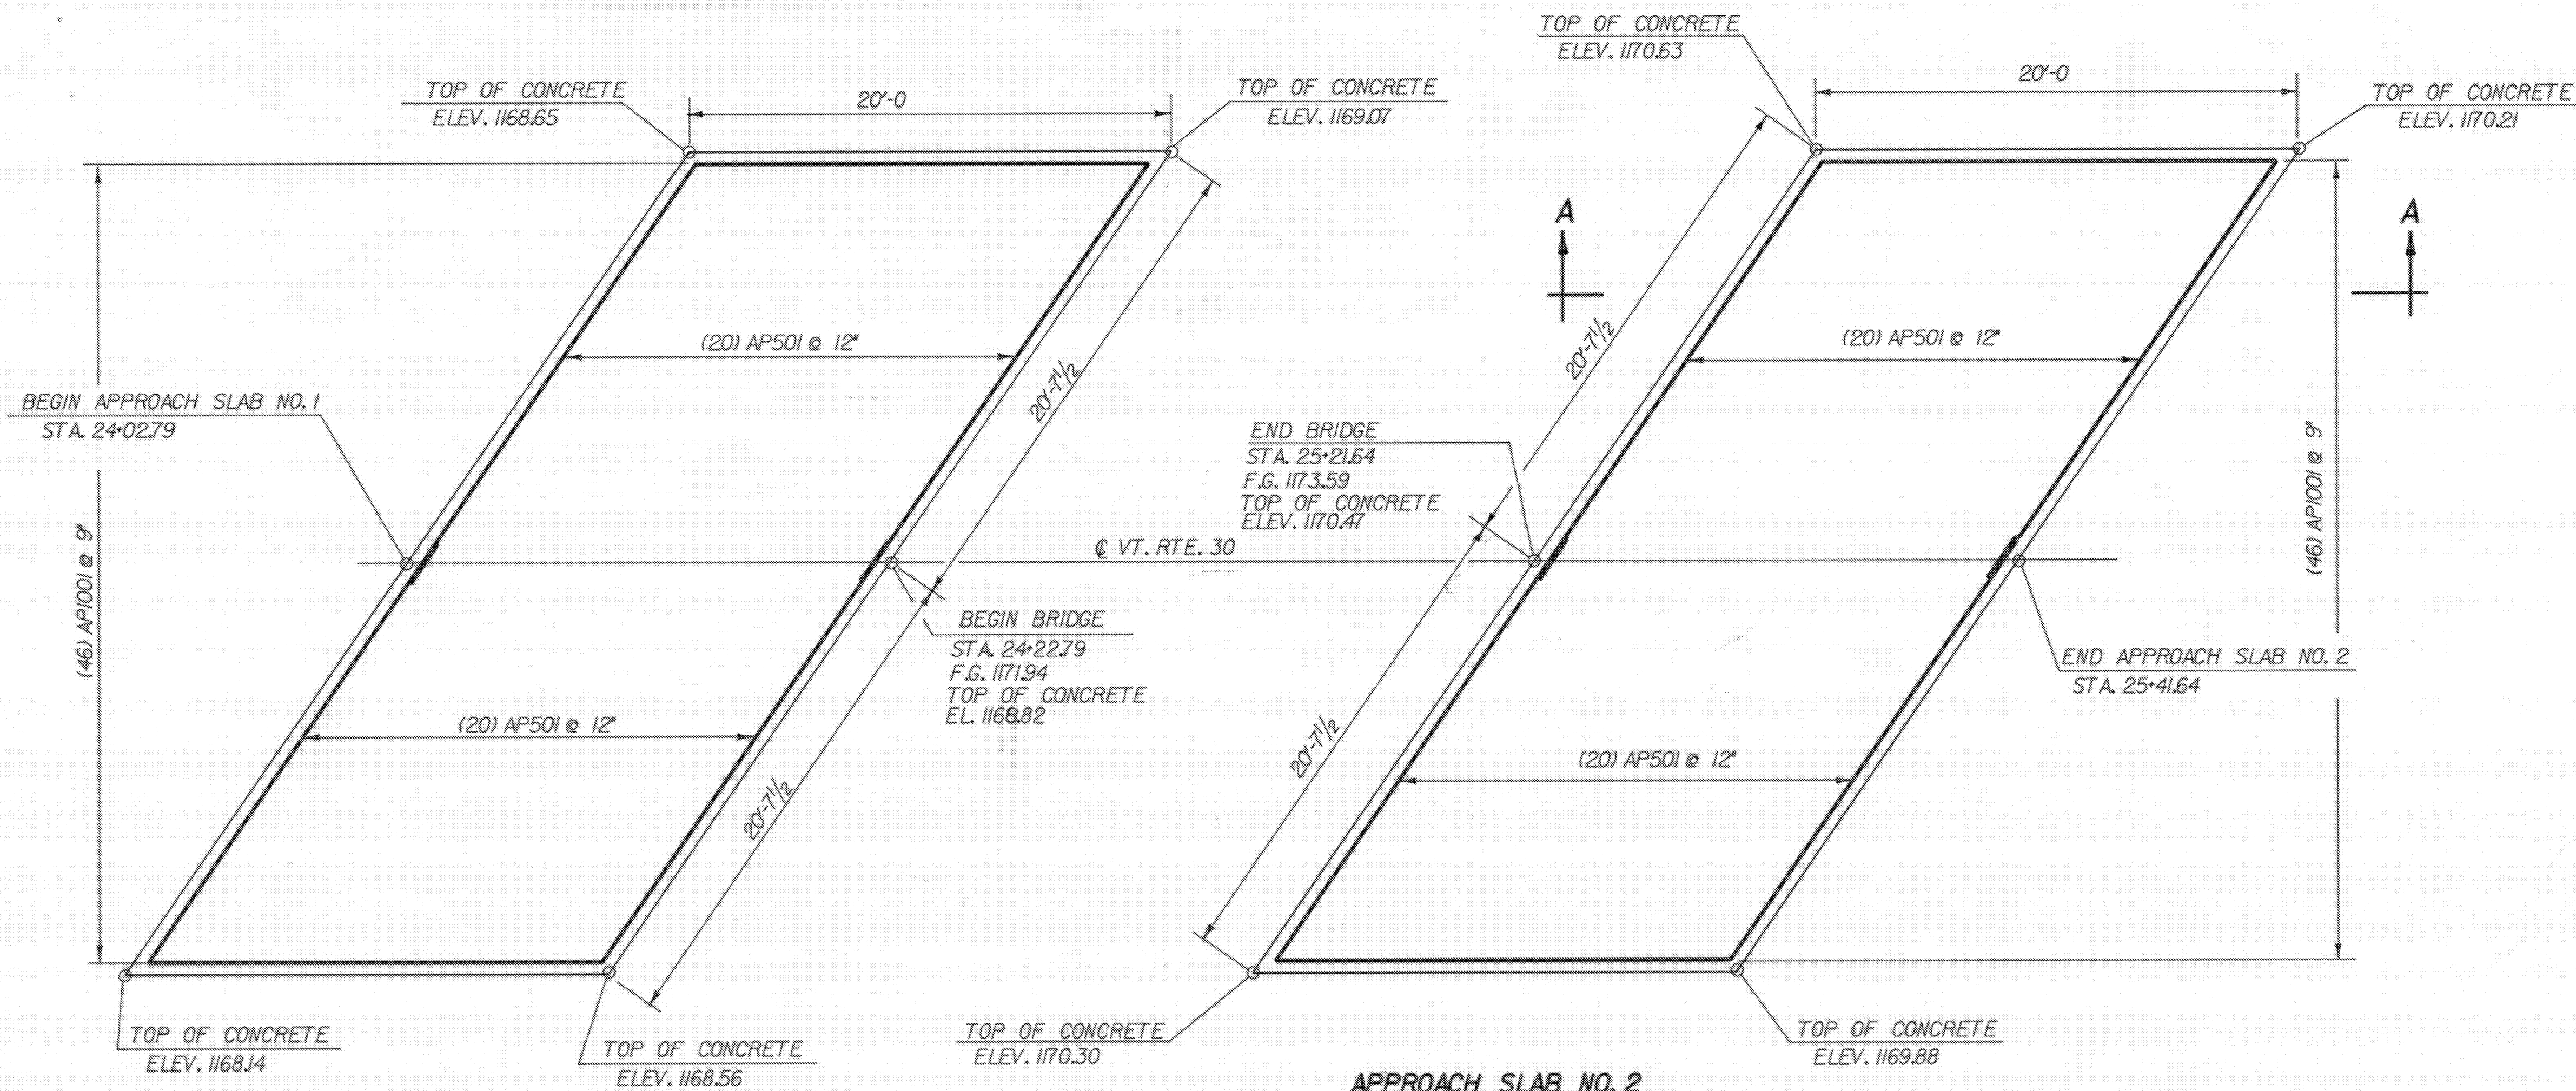

APPROACH SLAB PLAN
SCALE: 1/4" = 1'-0"

STATEWIDE - SOUTHWEST REGION
BHF MEMB(20)
SHEET 35 OF 47
BRIDGE 40
FOR REFERENCE ONLY

STATE OF VERMONT AGENCY OF TRANSPORTATION	
Town Of JAMAICA	Bridge No. 40
Highway No. VT. RTE. 30	Log Sta. 24+22.22
VT. RTE. 30 OVER WINHALL RIVER	
APPROACH SLAB DETAILS	
Designed By M. EVANS-MONGEON	Drawn By G. SCHELLEY
Checked By M. CERUTTI	Date 9/85
	Bridge Design Supervisor R. L. Oatley Date 9-85
PROJECT JAMAICA	PROJECT NO. BRF 015-1161S
I.C.C. Info. 05A1130.33J78F210APP	
Bridge Sheet No. BR108	Sheet 24 of 78