


CURTAIN WALL DETAILS  
Scale: 1/2" = 1'-0"

NOTE

1. FOR GRANITE CURB JOINT DETAILS SEE SCB-D6-73 AND SCB-D4-70

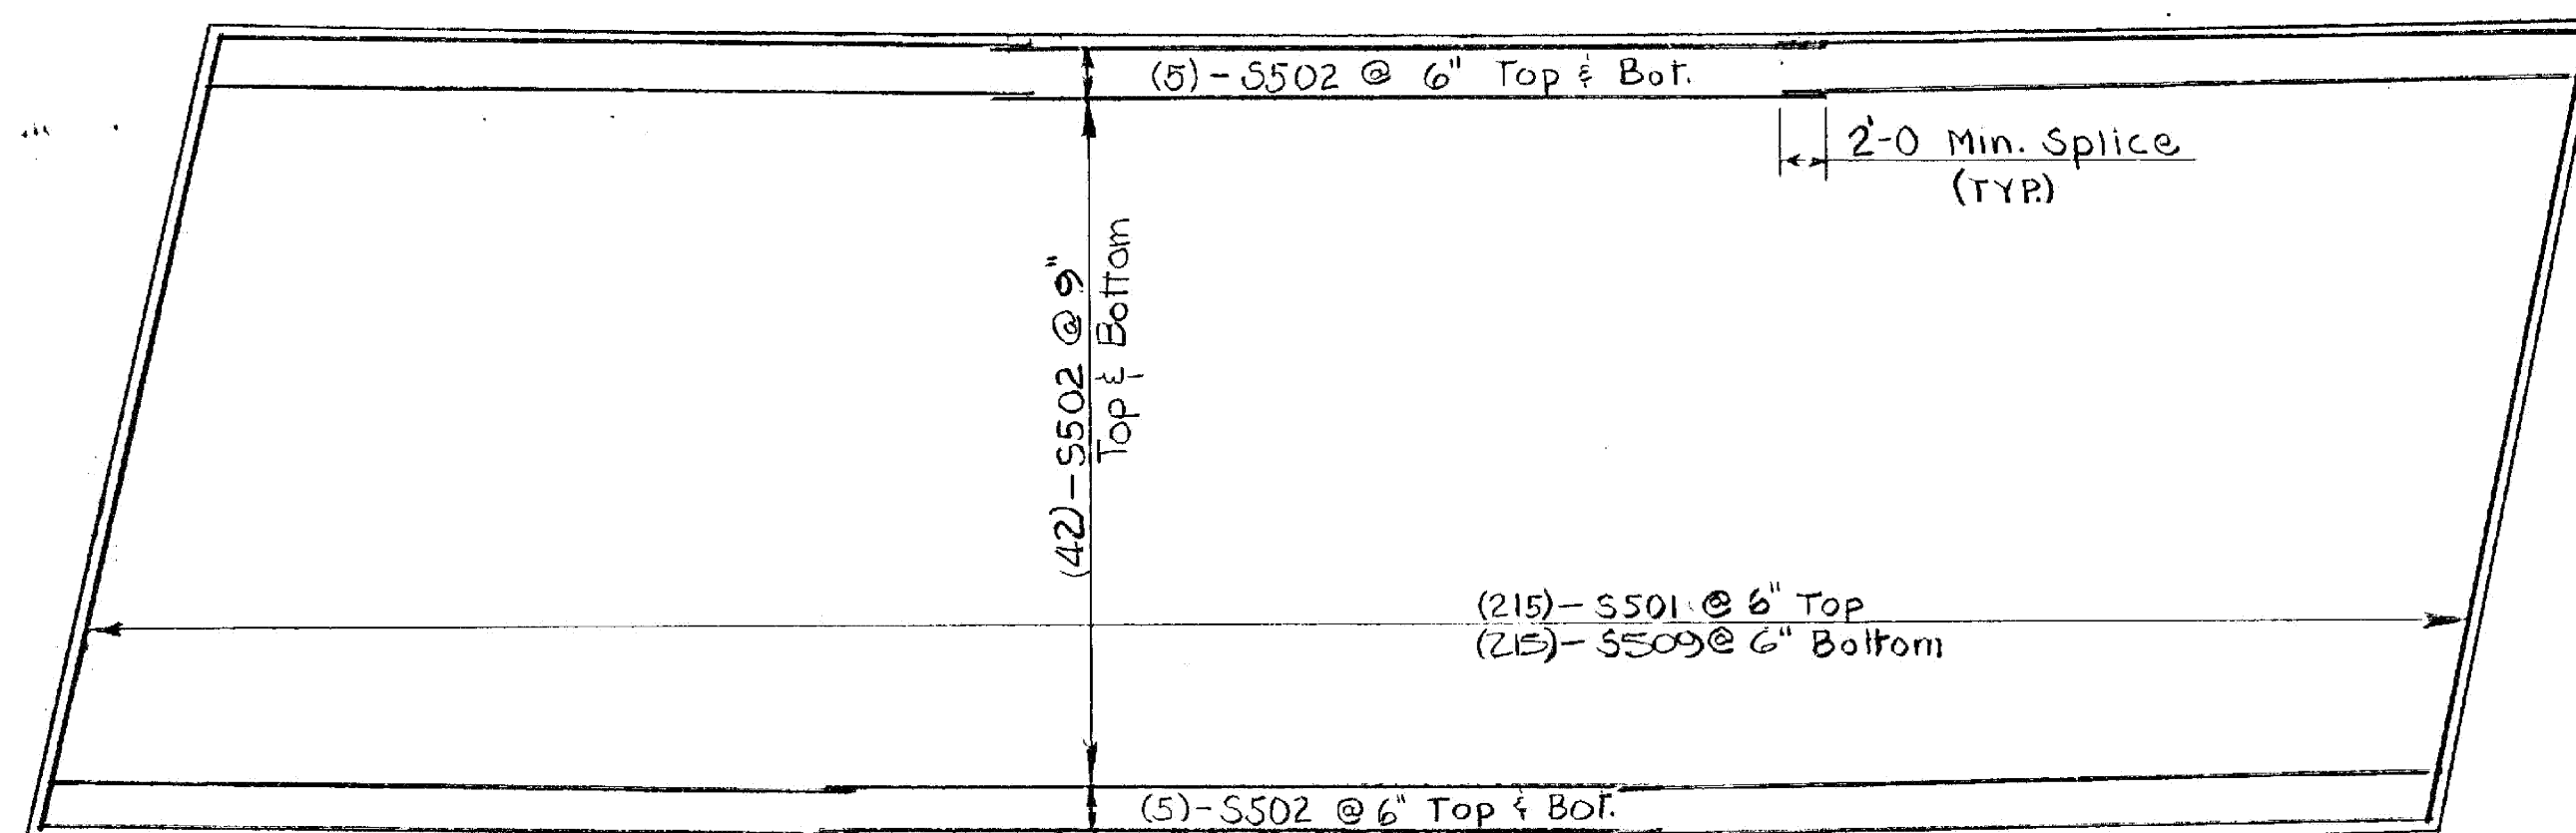

DECK REINFORCEMENT PLAN  
Scale: 1/8" = 1'-0"

STATEWIDE - SOUTHWEST REGION  
BHF MEMB(20)  
SHEET 42 OF 47  
BRIDGE D21  
FOR REFERENCE ONLY

<b>STATE OF VERMONT</b>	
<b>AGENCY OF TRANSPORTATION</b>	
TOWN OF SUNDERLAND	Bridge No. 23
HIGHWAY NO. ART. U.S. RT. 7	Log Sta.
T.H.#3 OVER ART. U.S. RT. 7 SOUTHBOUND	Surr. Sta.
SUPERSTRUCTURE DETAILS	
Designed by C. BENDA	Drawn by G. SCHELLEY
Checked by C. BENDA date 4/80	Bridge Design Supervisor R.L. O'Neil date 9-80
PROJECT SUNDERLAND-MANCHESTER	PROJECT NO. FO19-1(9) Cont.#1
Bridge Sheet No. BR2305	Sheet 187 of 429