



**CURVE DATA**  
 Δ - 30° 50' 30" RT  
 D - 4° 00'  
 R - 1432.40'  
 T - 395.11'  
 L - 771.04'  
 E - 53.49'  
 BNK - 0.047 FT/FT

**LEGEND**  
 △ - Edge Of Cut  
 ○ - Edge Of Fill  
 ML - Main Line  
 F.G. - Finished Grade

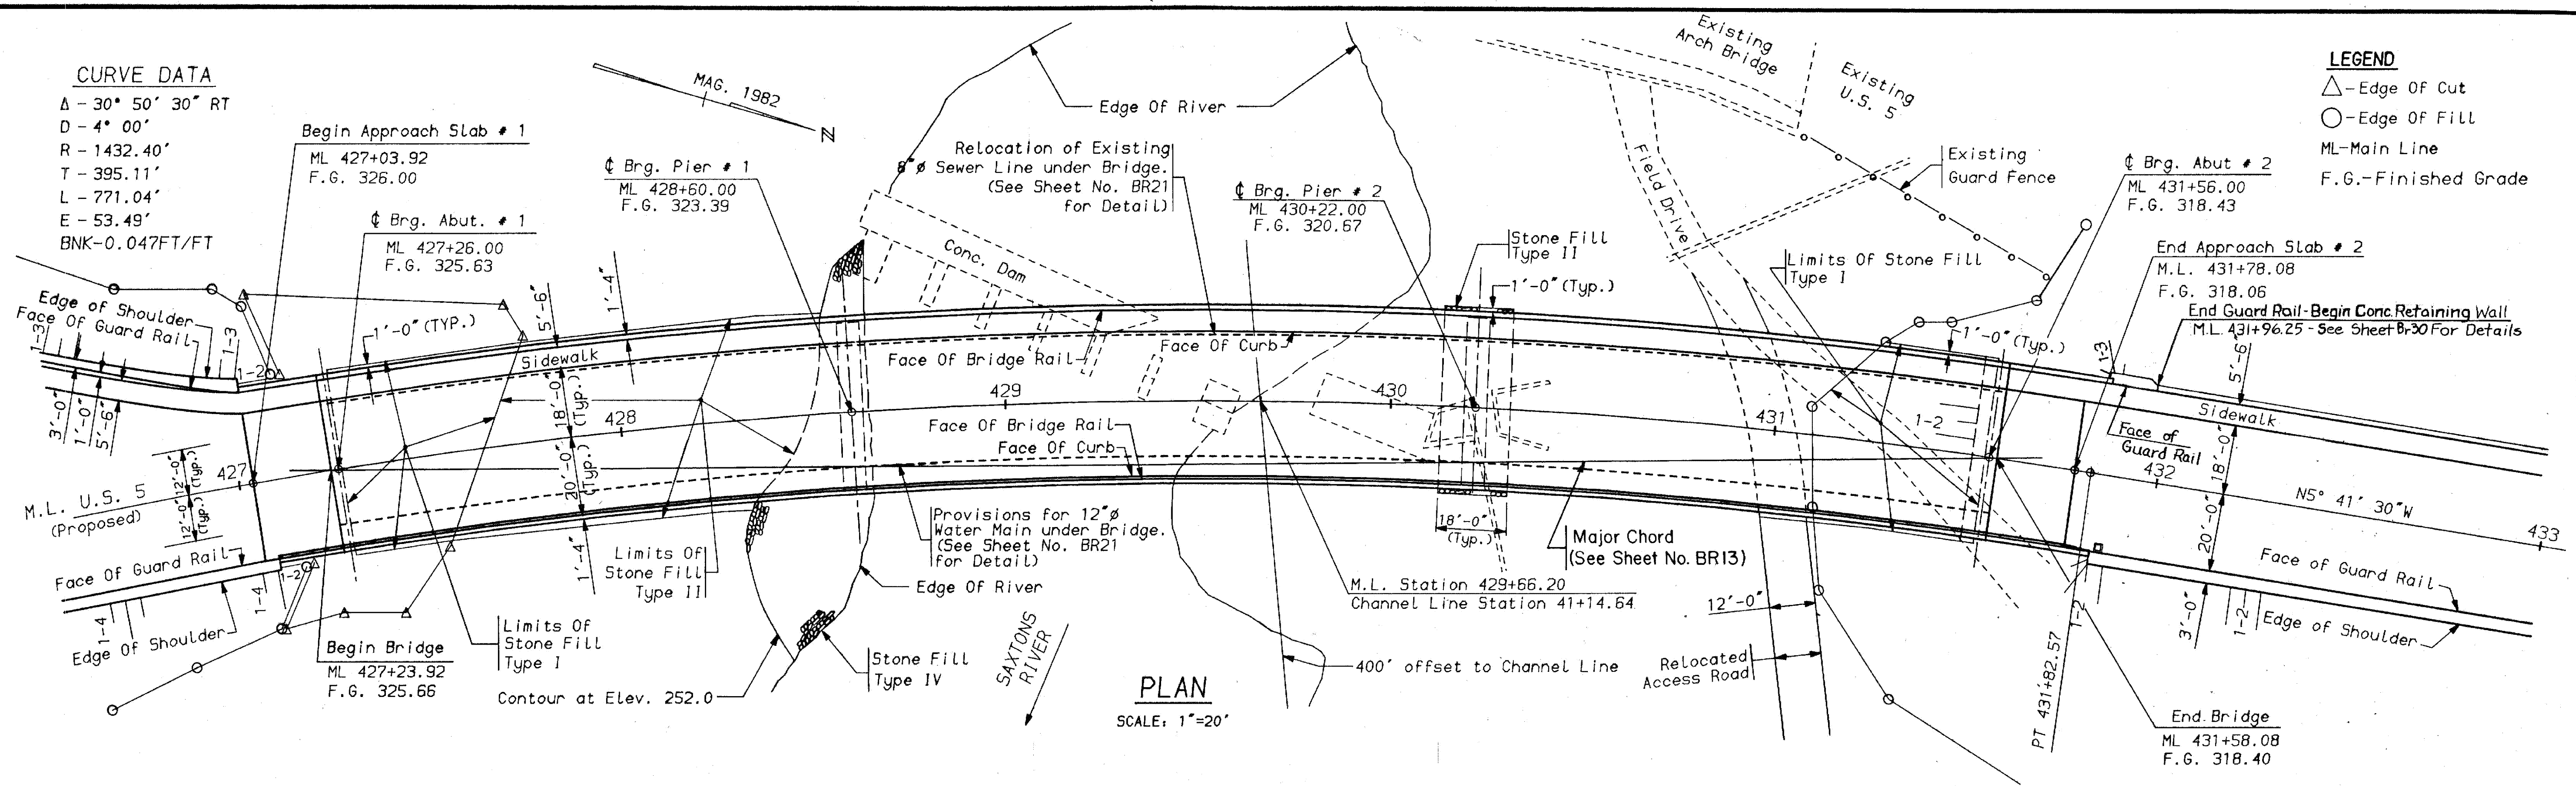

**PLAN**  
 SCALE: 1"=20'

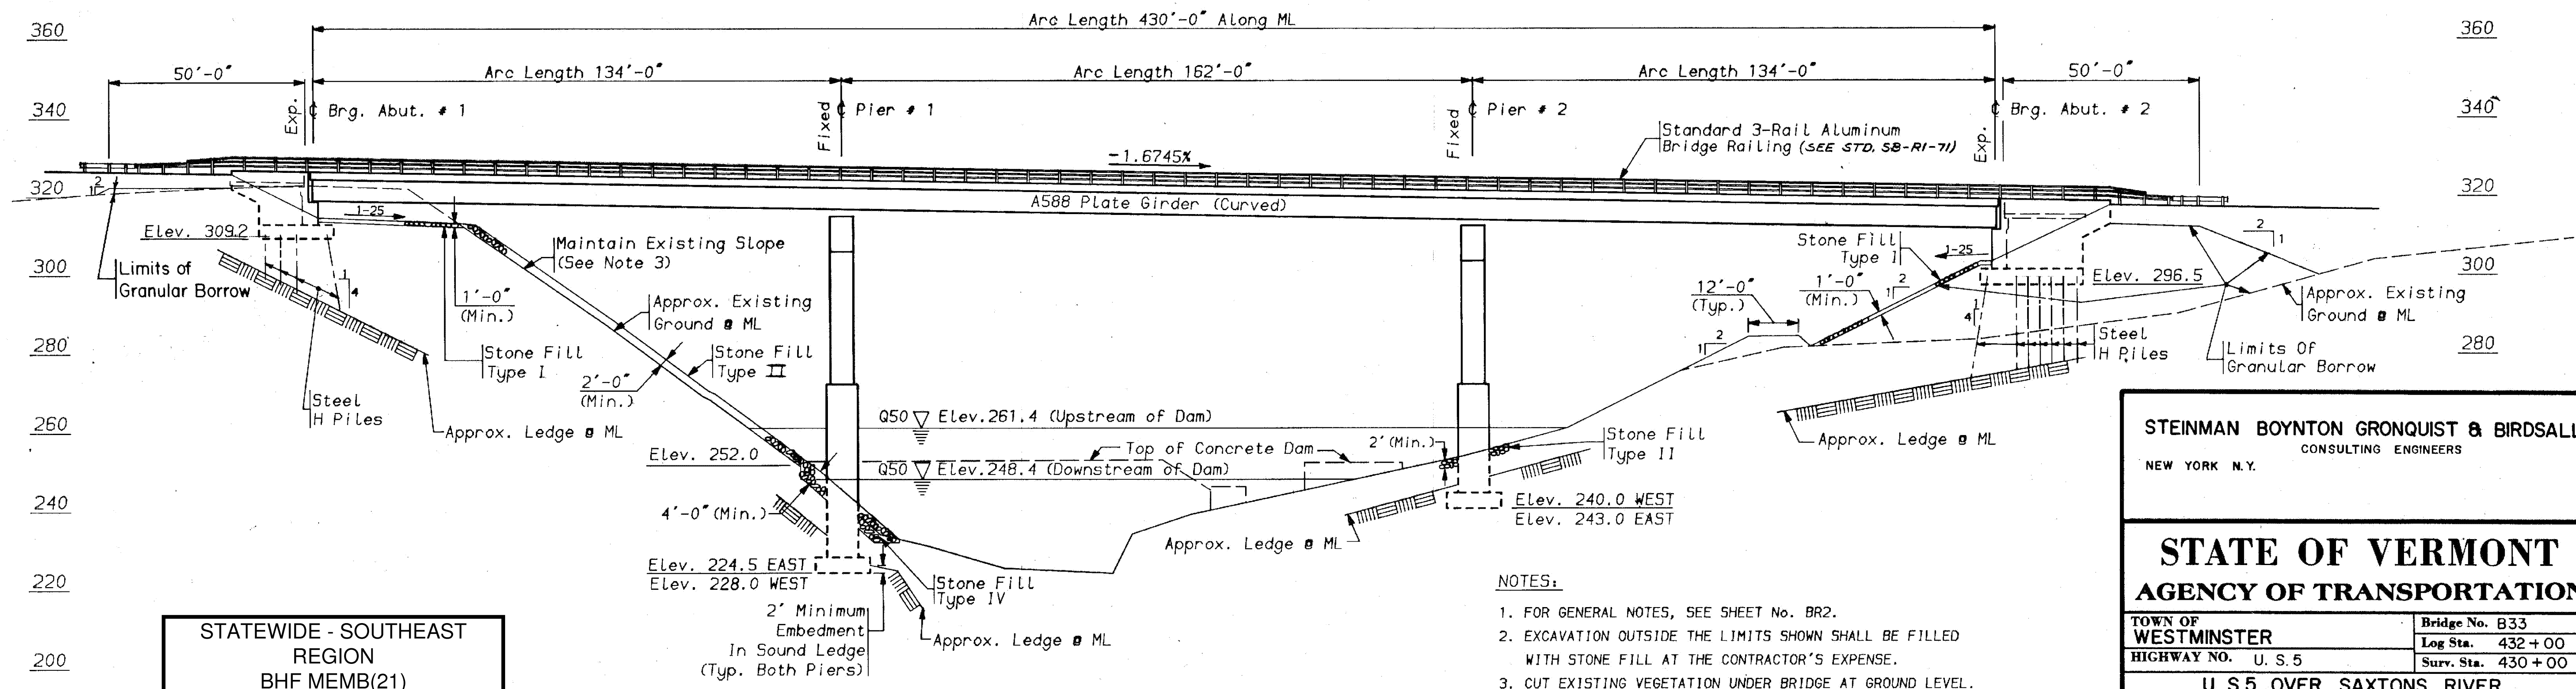

**EAST ELEVATION**  
 SCALE: 1"=20'

- NOTES:**
- FOR GENERAL NOTES, SEE SHEET No. BR2.
  - EXCAVATION OUTSIDE THE LIMITS SHOWN SHALL BE FILLED WITH STONE FILL AT THE CONTRACTOR'S EXPENSE.
  - CUT EXISTING VEGETATION UNDER BRIDGE AT GROUND LEVEL. LEAVE ROOT SYSTEMS INTACT. SEE SPECIAL PROVISIONS.
  - FOR LOCATIONS OF SCUPPERS AND LIGHT POSTS ON BRIDGE, SEE SHEET No. BR25.

STATEWIDE - SOUTHEAST REGION  
 BHF MEMB(21)  
 SHEET 22 OF 34  
 BRIDGE 33  
 FOR REFERENCE ONLY

**STEINMAN BOYNTON GRONQUIST & BIRDSALL**  
 CONSULTING ENGINEERS  
 NEW YORK N.Y.

**STATE OF VERMONT**  
**AGENCY OF TRANSPORTATION**

TOWN OF WESTMINSTER	Bridge No. B33
HIGHWAY NO. U. S. 5	Log Sta. 432+00
	Surv. Sta. 430+00
<b>U. S.5 OVER SAXTONS RIVER</b>	
<b>GENERAL PLAN AND ELEVATION</b>	
Designed by R. CHASE	Drawn by E. REIZE
Checked by J. HANKE	Bridge Design Supervisor T. A. FISHER
date 9/84	date 10/84
PROJECT WESTMINSTER-ROCKINGHAM	PROJECT NO. BRS 0113 (15)
Bridge Sheet No. BR 8	Sheet 85 of 262