

STATE OF VERMONT AGENCY OF TRANSPORTATION




PROPOSED IMPROVEMENT TOWNS OF WELLS, POULTNEY, CASTLETON AND HUBBARDTON COUNTY OF RUTLAND VT ROUTE 30

BEGINNING AT THE PAWLET-WELLS TOWN LINE ON
VT ROUTE 30 AT MILE MARKER 0.000 AND EXTENDING NORTHERLY ALONG VT ROUTE 30 FOR A DISTANCE OF
26.387 MILES TO THE HUBBARDTON-SUDBURY TOWN LINE AT MILE MARKER 5J6.

LENGTH OF ROADWAY = 26.387 MILES
LENGTH OF PROJECT = 26.387 MILES


WORK TO BE PERFORMED UNDER THIS PROJECT INCLUDES THE REMOVAL OF EXISTING SIGNS AND SIGN POSTS
AND THE INSTALLATION OF NEW SIGNS AND SIGN POSTS AND INCIDENTAL ITEMS.

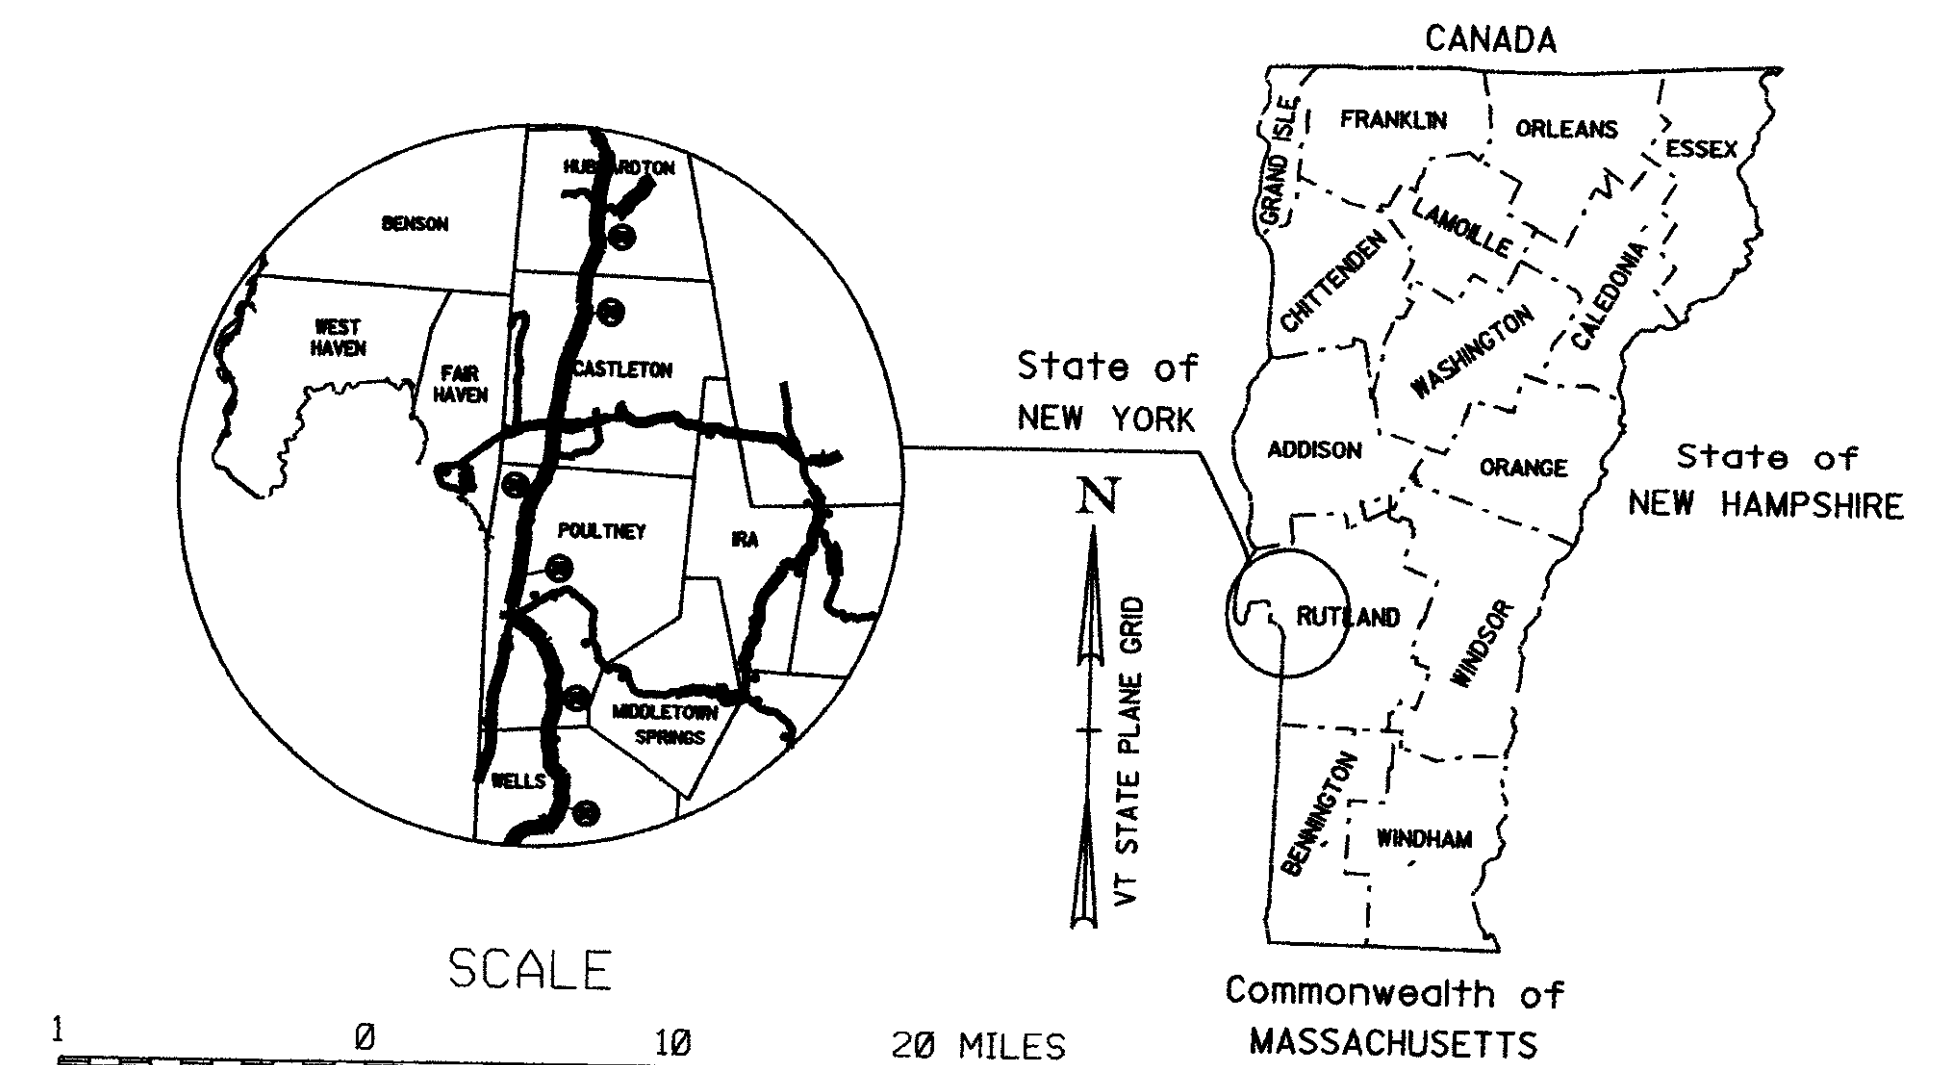

INDEX OF SHEETS	
1	TITLE SHEET
2	QUANTITY SHEET
3	GENERAL NOTES
4-30	LAYOUT SHEETS
31	SIGN DETAILS
32-73	TRAFFIC SIGN SUMMARY SHEETS
74-75	TRAFFIC CONTROL SHEETS

STANDARDS		
E-120	STANDARD SIGN PLACEMENT - EXPRESSWAY & FREEWAY	08/08/95
E-121	STANDARD SIGN PLACEMENT - CONVENTIONAL ROAD	08/08/95
E-123	GUIDE SIGN PLACEMENT - MISCELLANEOUS DETAILS	03/16/04
E-124	TOWN LINE SIGNS	08/08/95
E-127	ROUTE MARKINGS AT RURAL INTERSECTIONS	08/08/95
E-128A	DETAILING VILLAGE SIGNS (A-M)	08/08/95
E-128B	DETAILING VILLAGE SIGNS (N-W)	08/08/95
E-136B	STATE ROUTE MARKER SIGN DETAILS	08/08/95
E-136C	STATE NUMBERED TOWN HIGHWAY SIGN DETAILS	08/08/95
E-138	MILEMARKER DETAILS - STATE & TOWN HIGHWAYS	05/30/03
E-140	REGULATORY SIGN DETAILS	08/30/96
E-141	REGULATORY SIGN DETAILS	09/20/95
E-142	REGULATORY SIGN DETAILS	09/20/95
E-143	REGULATORY SIGN DETAILS	06/15/04
E-144	REGULATORY SIGN DETAILS	03/29/99
E-150	WARNING SIGN DETAILS	05/01/04
E-151	WARNING SIGN DETAILS	05/01/04
E-152	WARNING SIGN DETAILS	05/01/04
E-153	WARNING SIGN DETAILS	05/01/04
E-154	WARNING SIGN DETAILS	05/01/04
E-155	WARNING SIGN DETAILS	05/01/04
E-164	SQUARE STEEL SIGN POSTS	05/20/99

RECORD PLANS	
CONTRACTOR	F R LAFAYETTE, INC - ESSEX JUNCTION, VT
RESIDENT ENGINEER	JUDY GILMORE
CONSTRUCTION BEGAN	NOVEMBER 11, 2008
CONSTRUCTION COMPLETE	JANUARY 9, 2009
RECORD PLANS BY	JUDY GILMORE & C PIERCE
I HEREBY CERTIFY THAT ALL THE CONSTRUCTION REQUIRED BY THIS SET OF DRAWINGS HAS BEEN ACCOMPLISHED AS INDICATED HEREIN	
BY	<i>Judy Gilmore</i> RESIDENT ENGINEER
DATE	22 JUNE 2010
NOTE: Any further information concerning final quantities, amounts or other details relative to this project may be found at Central Files in the electronic archives	

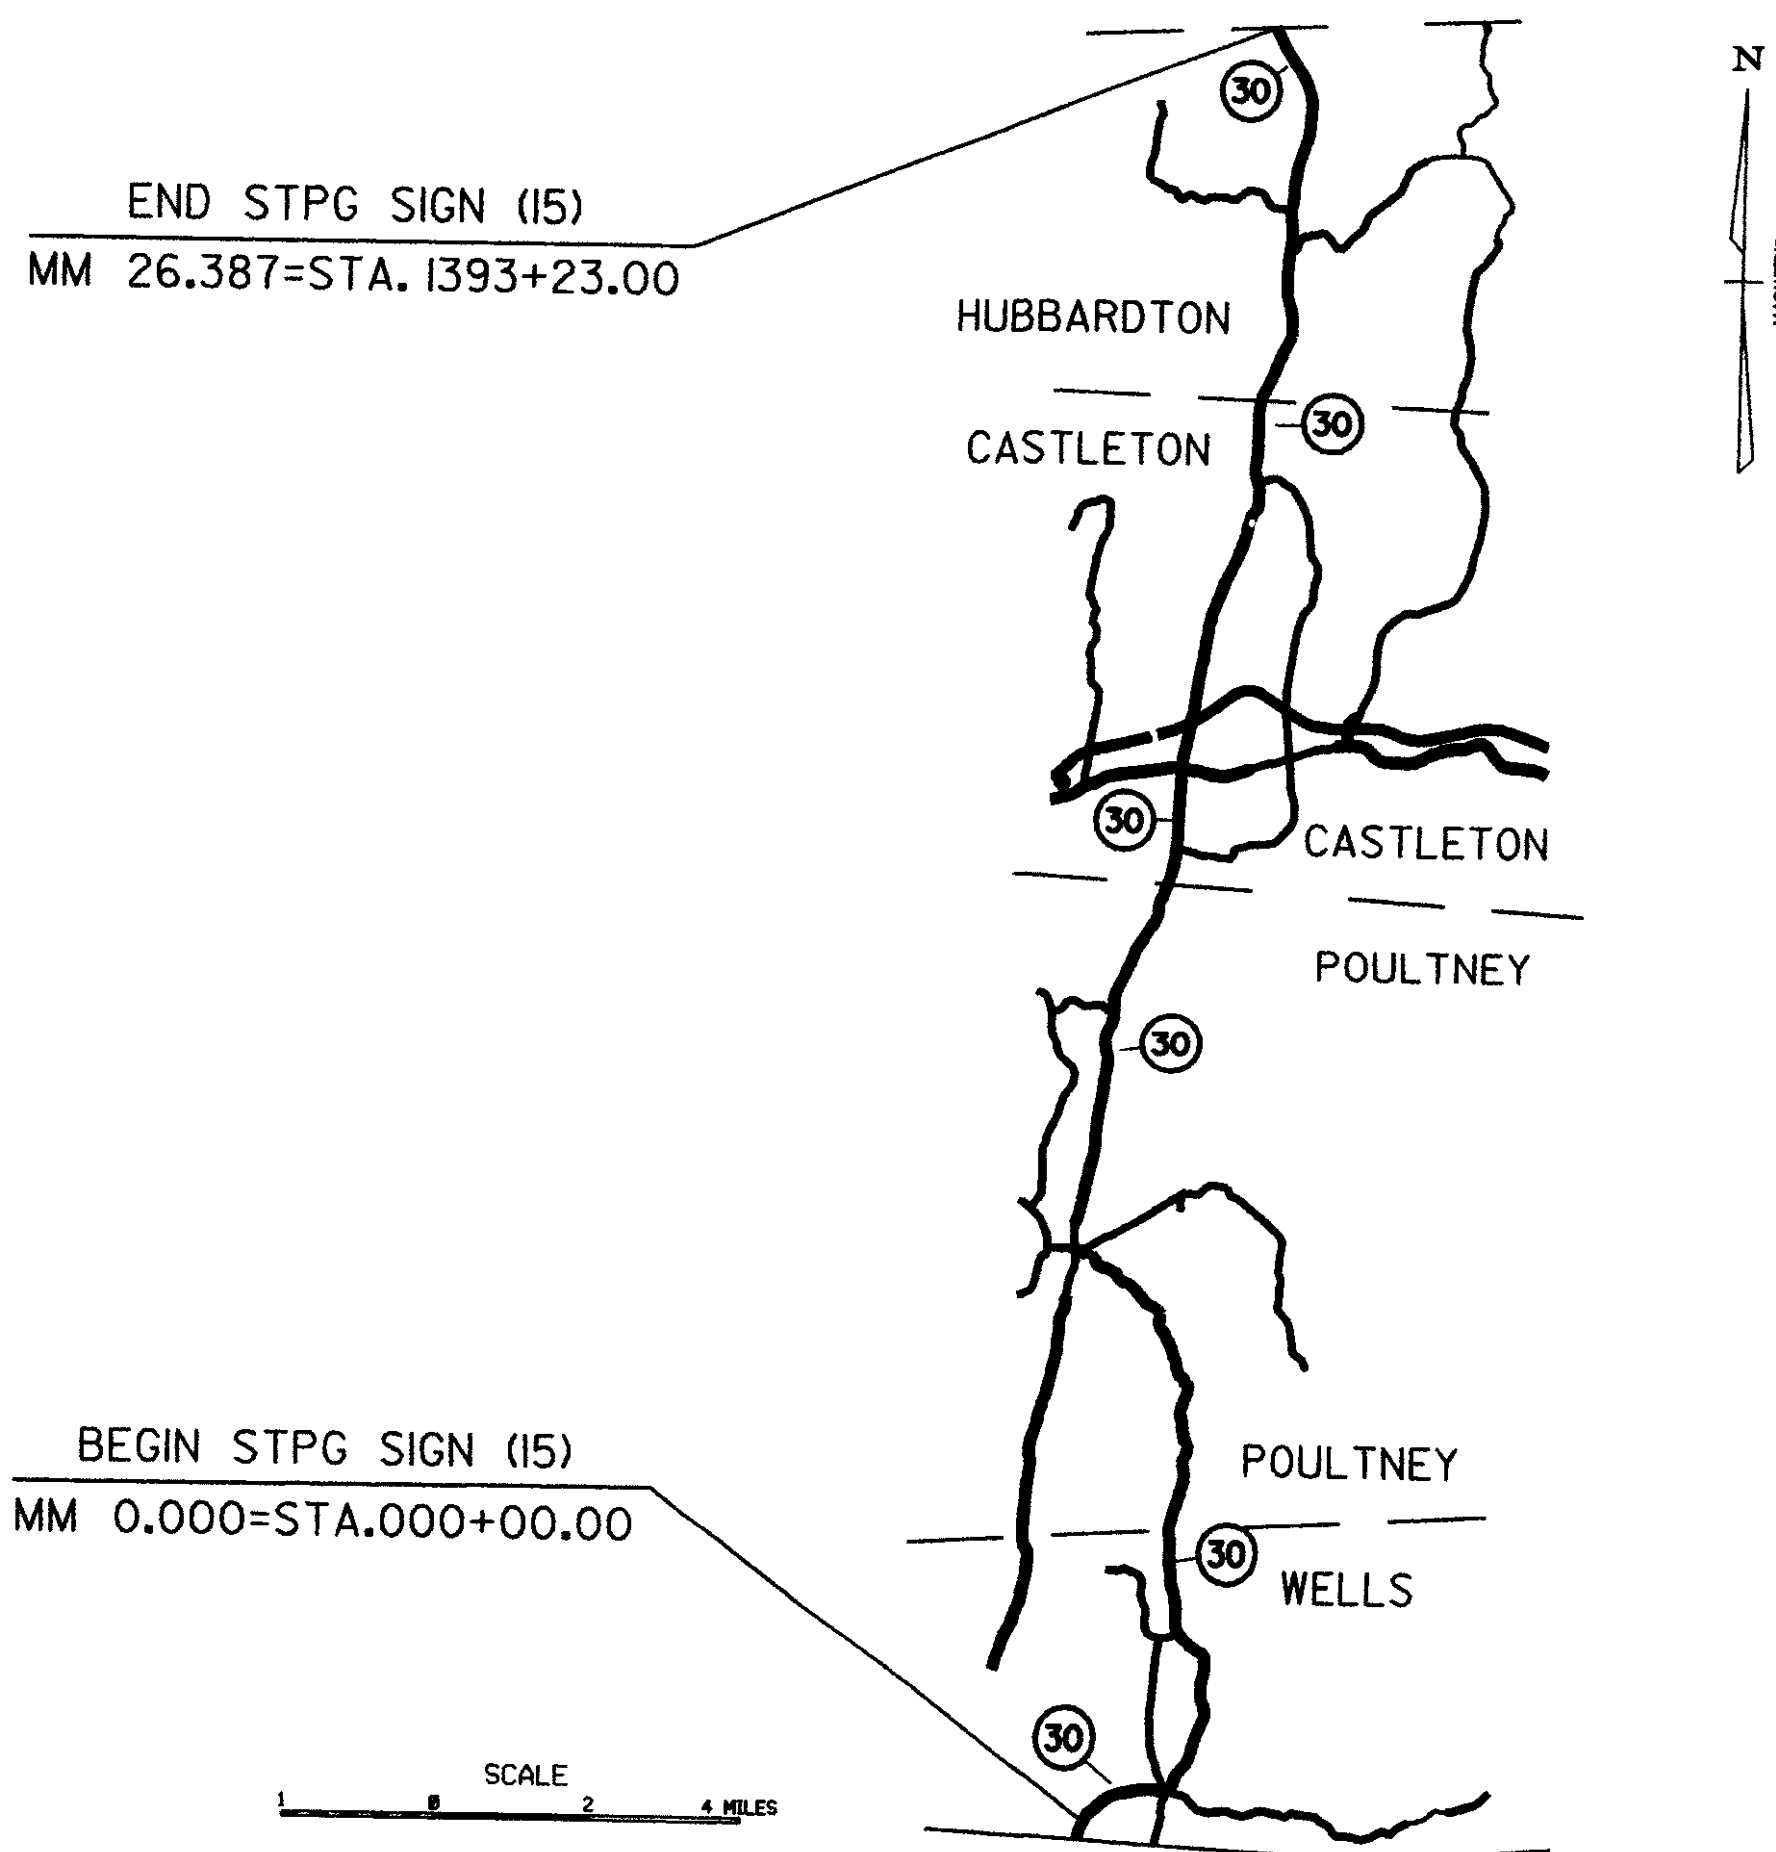

CONVENTIONAL SYMBOLS	
COUNTY LINE	
TOWN LINE	
LIMITS OF ACCESS	
POINT OF ACCESS	
FENCE LINE	
STONE WALL	
TRAVELED WAY	
GUARD RAIL	
RAILROAD	
SURVEY LINE	
CULVERT	
POWER POLE	
TELEPHONE POLE	
TREES	
CONTROL OF ACCESS	
PROPERTY LINE	
R.O.W. TAKING LINE	
SLOPE RIGHTS	
TOP OF CUT	
TOE OF SLOPE	

SURVEYED BY :	
SURVEYED DATE :	
DATUM	
VERTICAL	
HORIZONTAL	

THESE PLANS ARE SUBJECT TO SUCH ENGINEERING CHANGES AS MAY BE REQUIRED BY THE FEDERAL HIGHWAY ADMINISTRATION OR THE DIRECTOR OF PROGRAM DEVELOPMENT.

CONSTRUCTION IS TO BE CARRIED ON IN ACCORDANCE WITH THESE PLANS AND THE STANDARD SPECIFICATIONS FOR CONSTRUCTION DATED 2006, AS APPROVED BY THE FEDERAL HIGHWAY ADMINISTRATION ON JUNE 15, 2006 FOR USE ON THIS PROJECT, INCLUDING ALL SUBSEQUENT REVISIONS AND SUCH REVISED SPECIFICATIONS AND SPECIAL PROVISIONS AS ARE INCORPORATED IN THESE PLANS.

UNLESS OTHERWISE NOTED, ALL DRAWINGS AND DETAILS OF THE PROJECT PLANS ARE NOT TO SCALE.	
DIRECTOR OF PROGRAM DEVELOPMENT	
APPROVED <i>[Signature]</i>	DATE 6-17-08
PROJECT MANAGER :	
PROJECT NAME :	WELLS-HUBBARDTON
PROJECT NUMBER :	STPG SIGN (I5)
SHEET 1 OF 75 SHEETS	