


ACTUAL SALVAGED POSTS
28 1
0 0

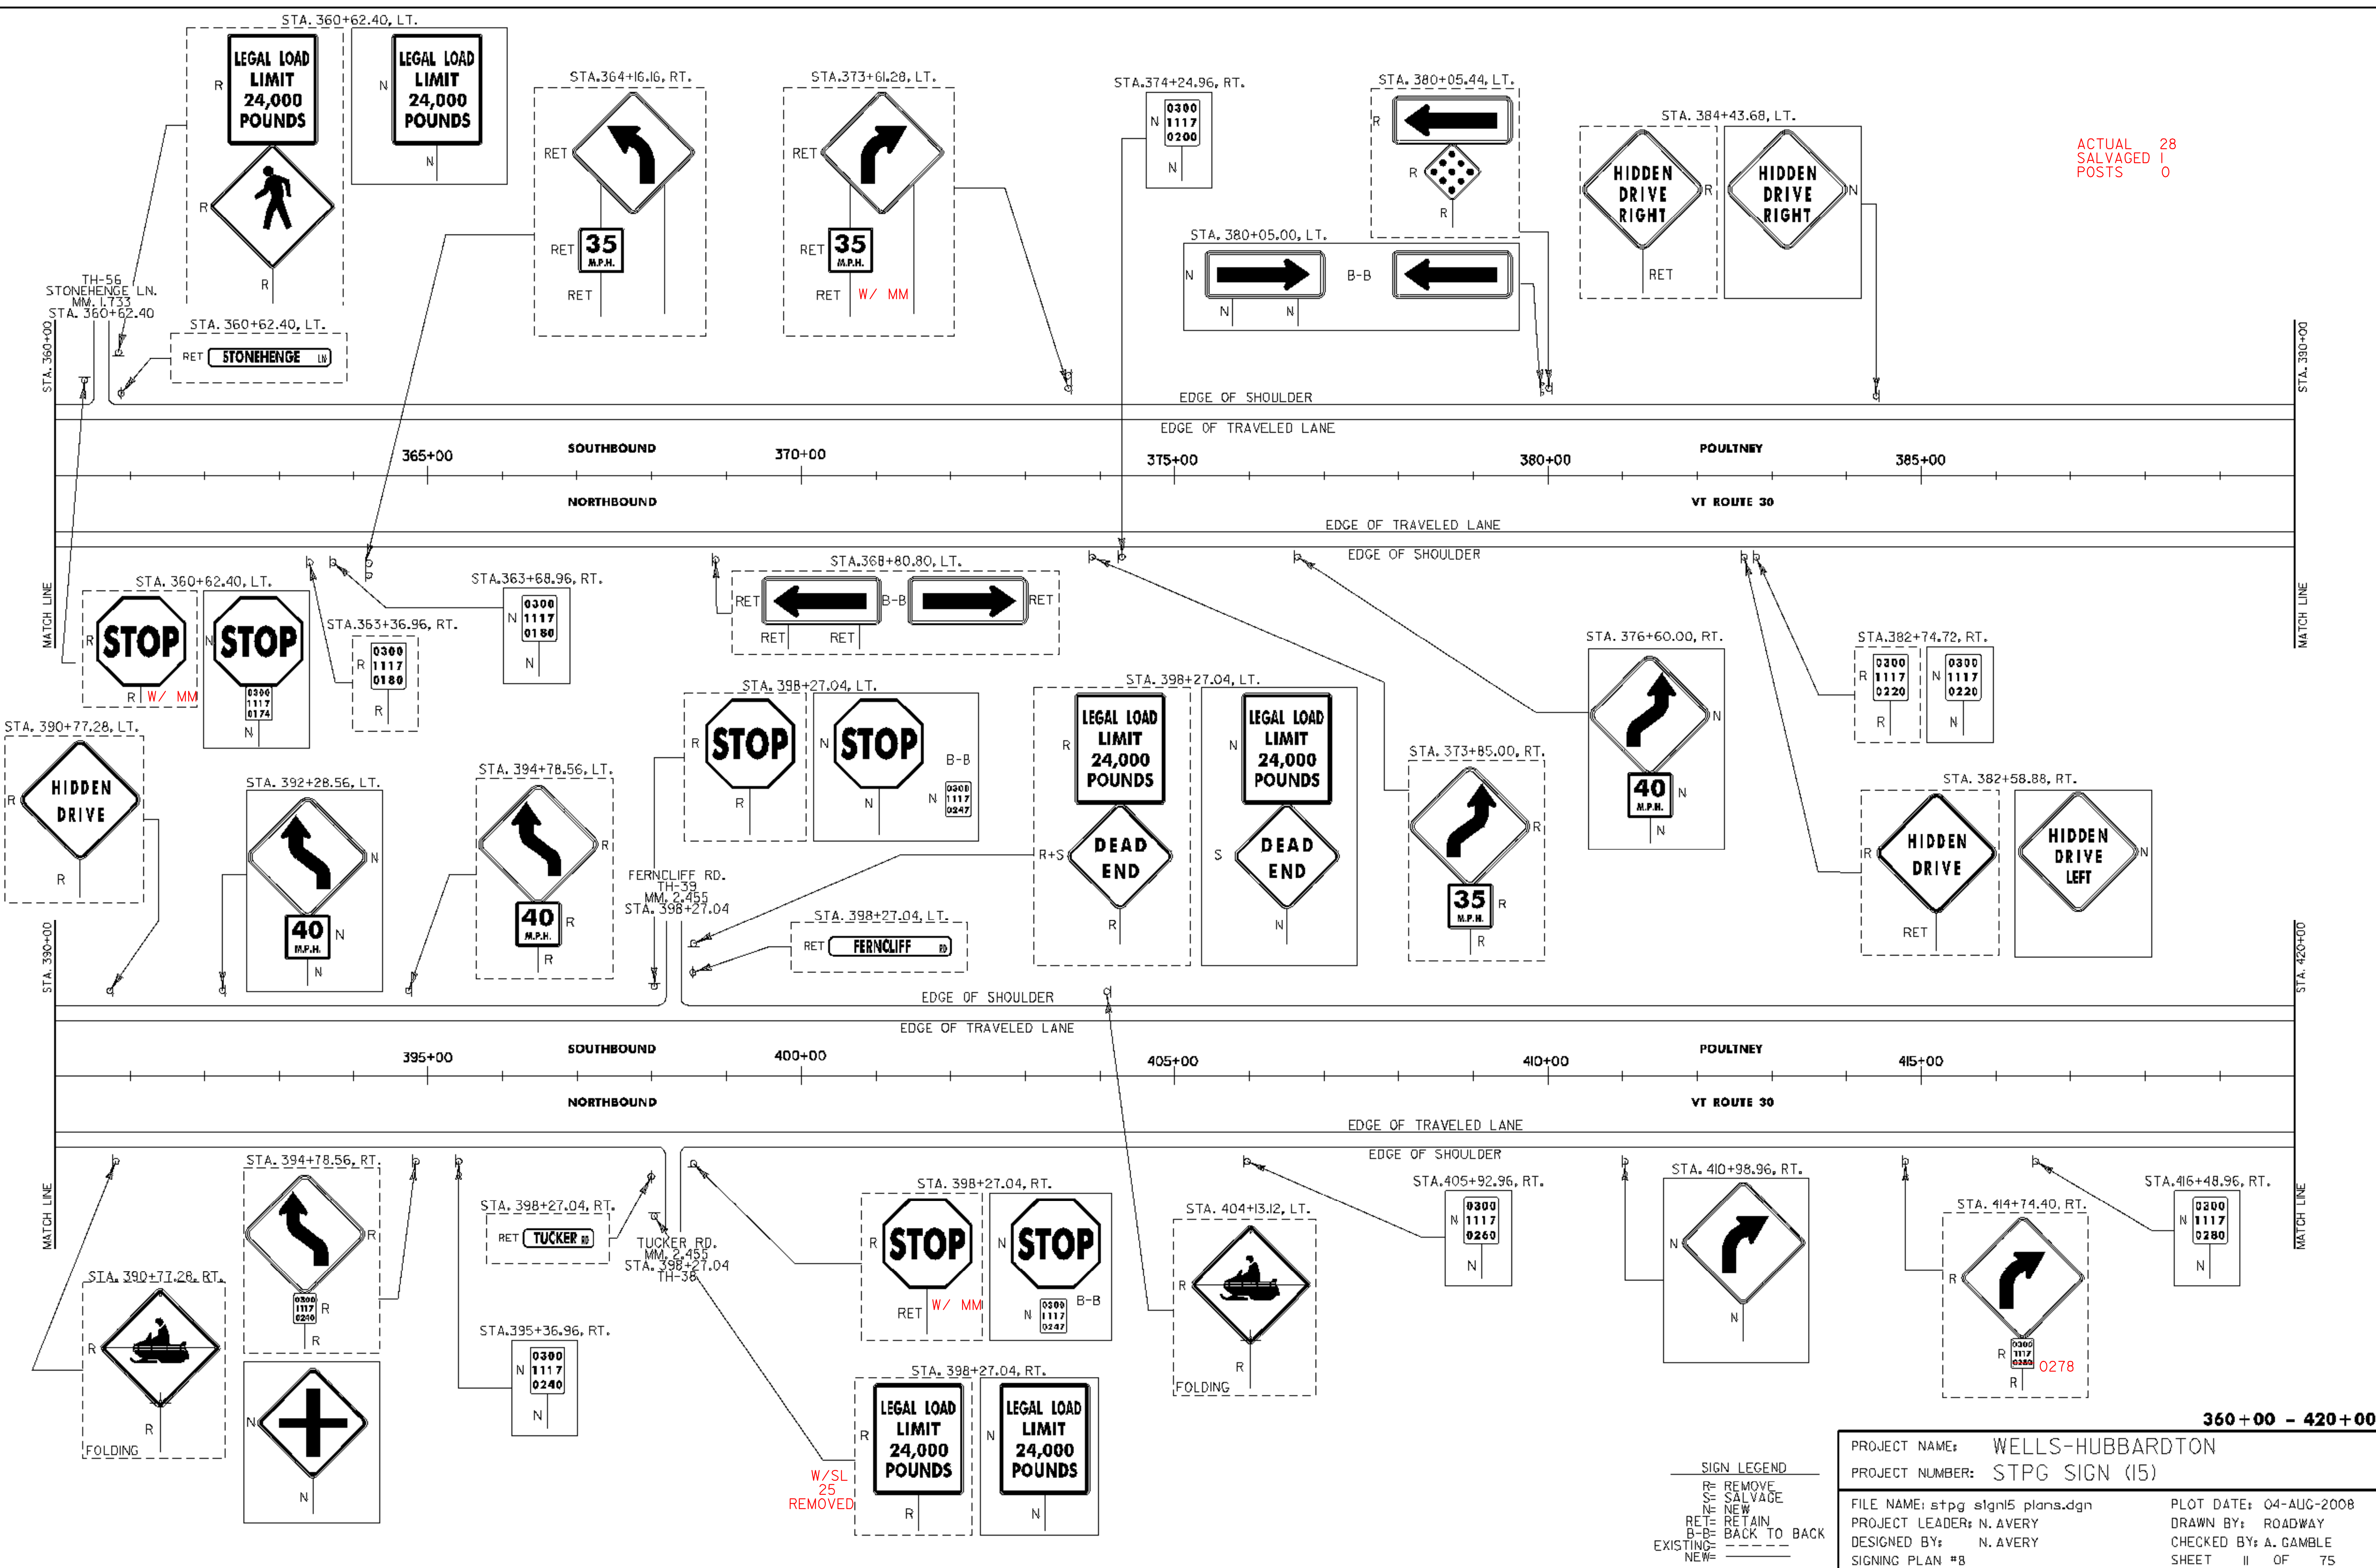

SIGN LEGEND
 R= REMOVE
 S= SALVAGE
 N= NEW
 RET= RETAIN
 B-B= BACK TO BACK
 EXISTING= - - - -
 NEW= _____

360+00 - 420+00

PROJECT NAME: WELLS-HUBBARDTON
 PROJECT NUMBER: STPG SIGN (15)

FILE NAME: stpg sign5 plans.dgn
 PROJECT LEADER: N. AVERY
 DESIGNED BY: N. AVERY
 SIGNING PLAN #8

PLOT DATE: 04-AUG-2008
 DRAWN BY: ROADWAY
 CHECKED BY: A. GAMBLE
 SHEET II OF 75

W/SL
25
REMOVED