


ACTUAL SALVAGED POSTS 23
0

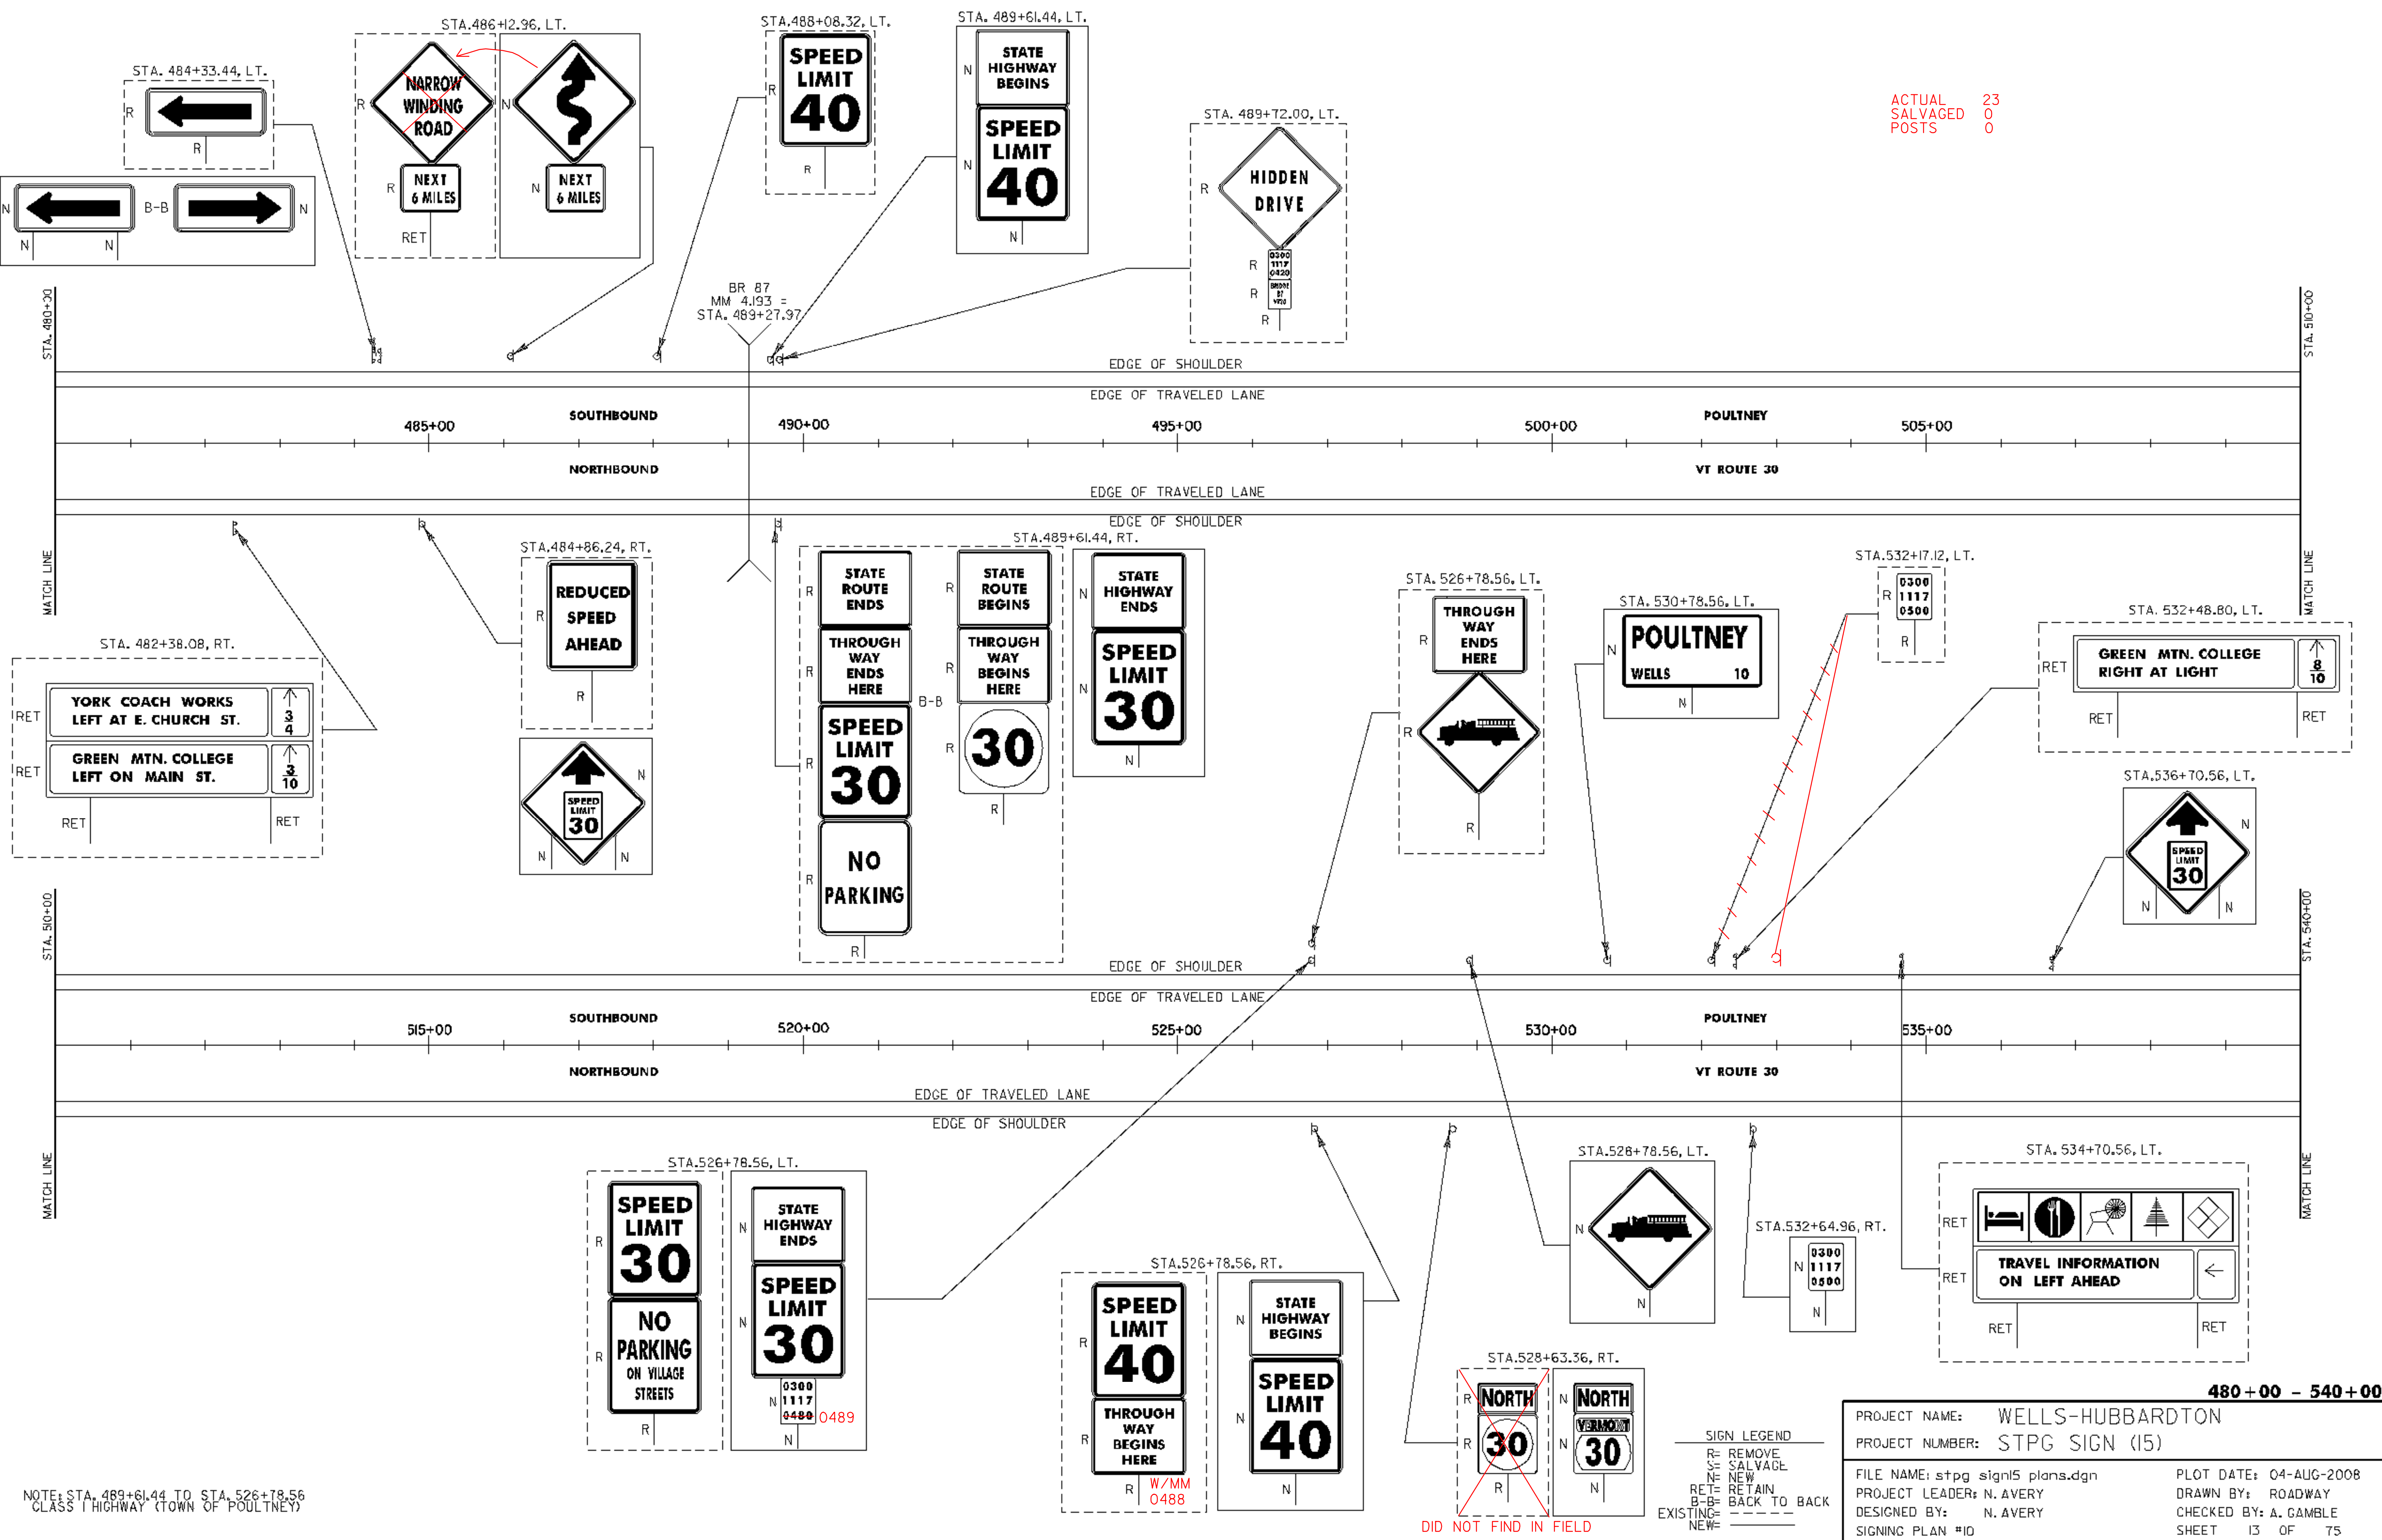

NOTE: STA. 489+61.44 TO STA. 526+78.56 CLASS I HIGHWAY (TOWN OF POULTNEY)

- SIGN LEGEND**
- R- REMOVE
 - S- SALVAGE
 - N- NEW
 - RET- RETAIN
 - B-B- BACK TO BACK
 - EXISTING- DASHED LINE
 - NEW- SOLID LINE

480+00 - 540+00

PROJECT NAME: WELLS-HUBBARDTON
PROJECT NUMBER: STPG SIGN (15)

FILE NAME: stpg sign15 plans.dgn
PROJECT LEADER: N. AVERY
DESIGNED BY: N. AVERY
SIGNING PLAN #10

PLOT DATE: 04-AUG-2008
DRAWN BY: ROADWAY
CHECKED BY: A. GAMBLE
SHEET 13 OF 75

