


ACTUAL SALVAGED POSTS 10
1

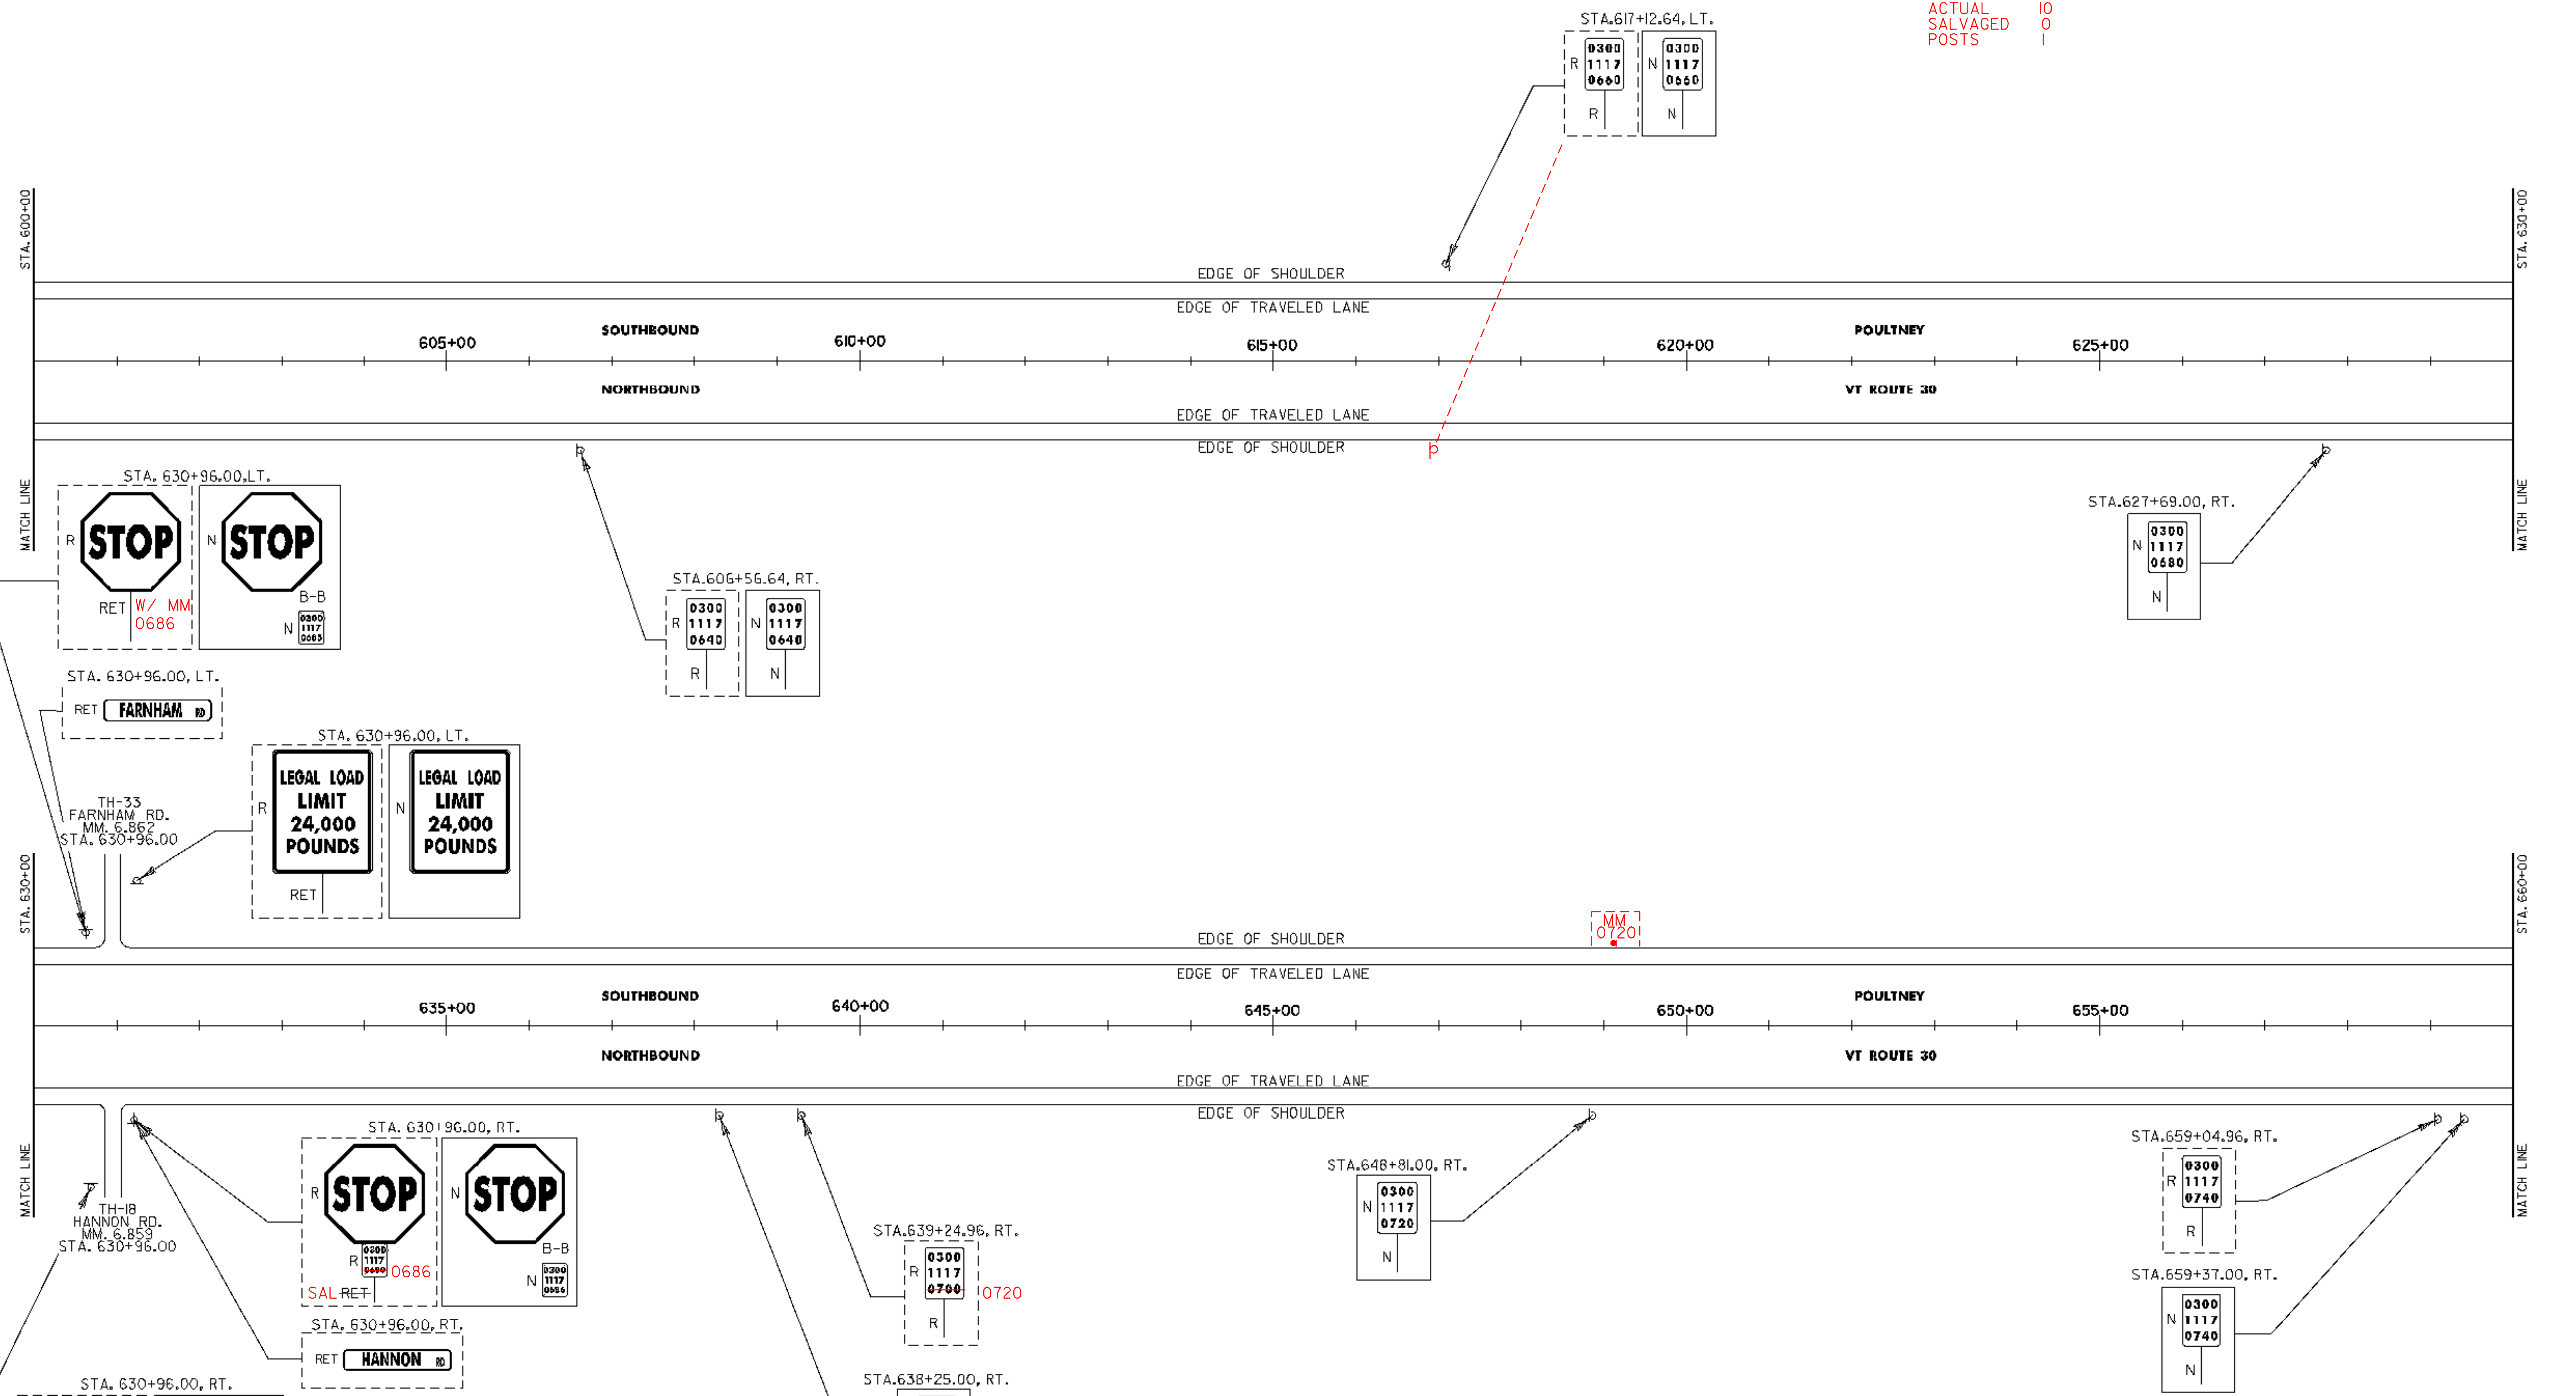

600+00 - 660+00

- SIGN LEGEND**
- R= REMOVE
 - S= SALVAGE
 - N= NEW
 - RFT= RFTAIN
 - B-B= BACK TO BACK
 - EXISTING= - - - - -
 - NEW= _____

| | |
|----------------------------------|------------------------|
| PROJECT NAME: | WELLS-HUBBARDTON |
| PROJECT NUMBER: | STPG SIGN (15) |
| FILE NAME: stpg sign15 plans.dgn | PLOT DATE: 04-AUG-2008 |
| PROJECT LEADER: N. AVERY | DRAWN BY: ROADWAY |
| DESIGNED BY: N. AVERY | CHECKED BY: A. GAMBLE |
| SIGNING PLAN #12 | SHEET 15 OF 75 |