


ACTUAL SALVAGED POSTS 25
10

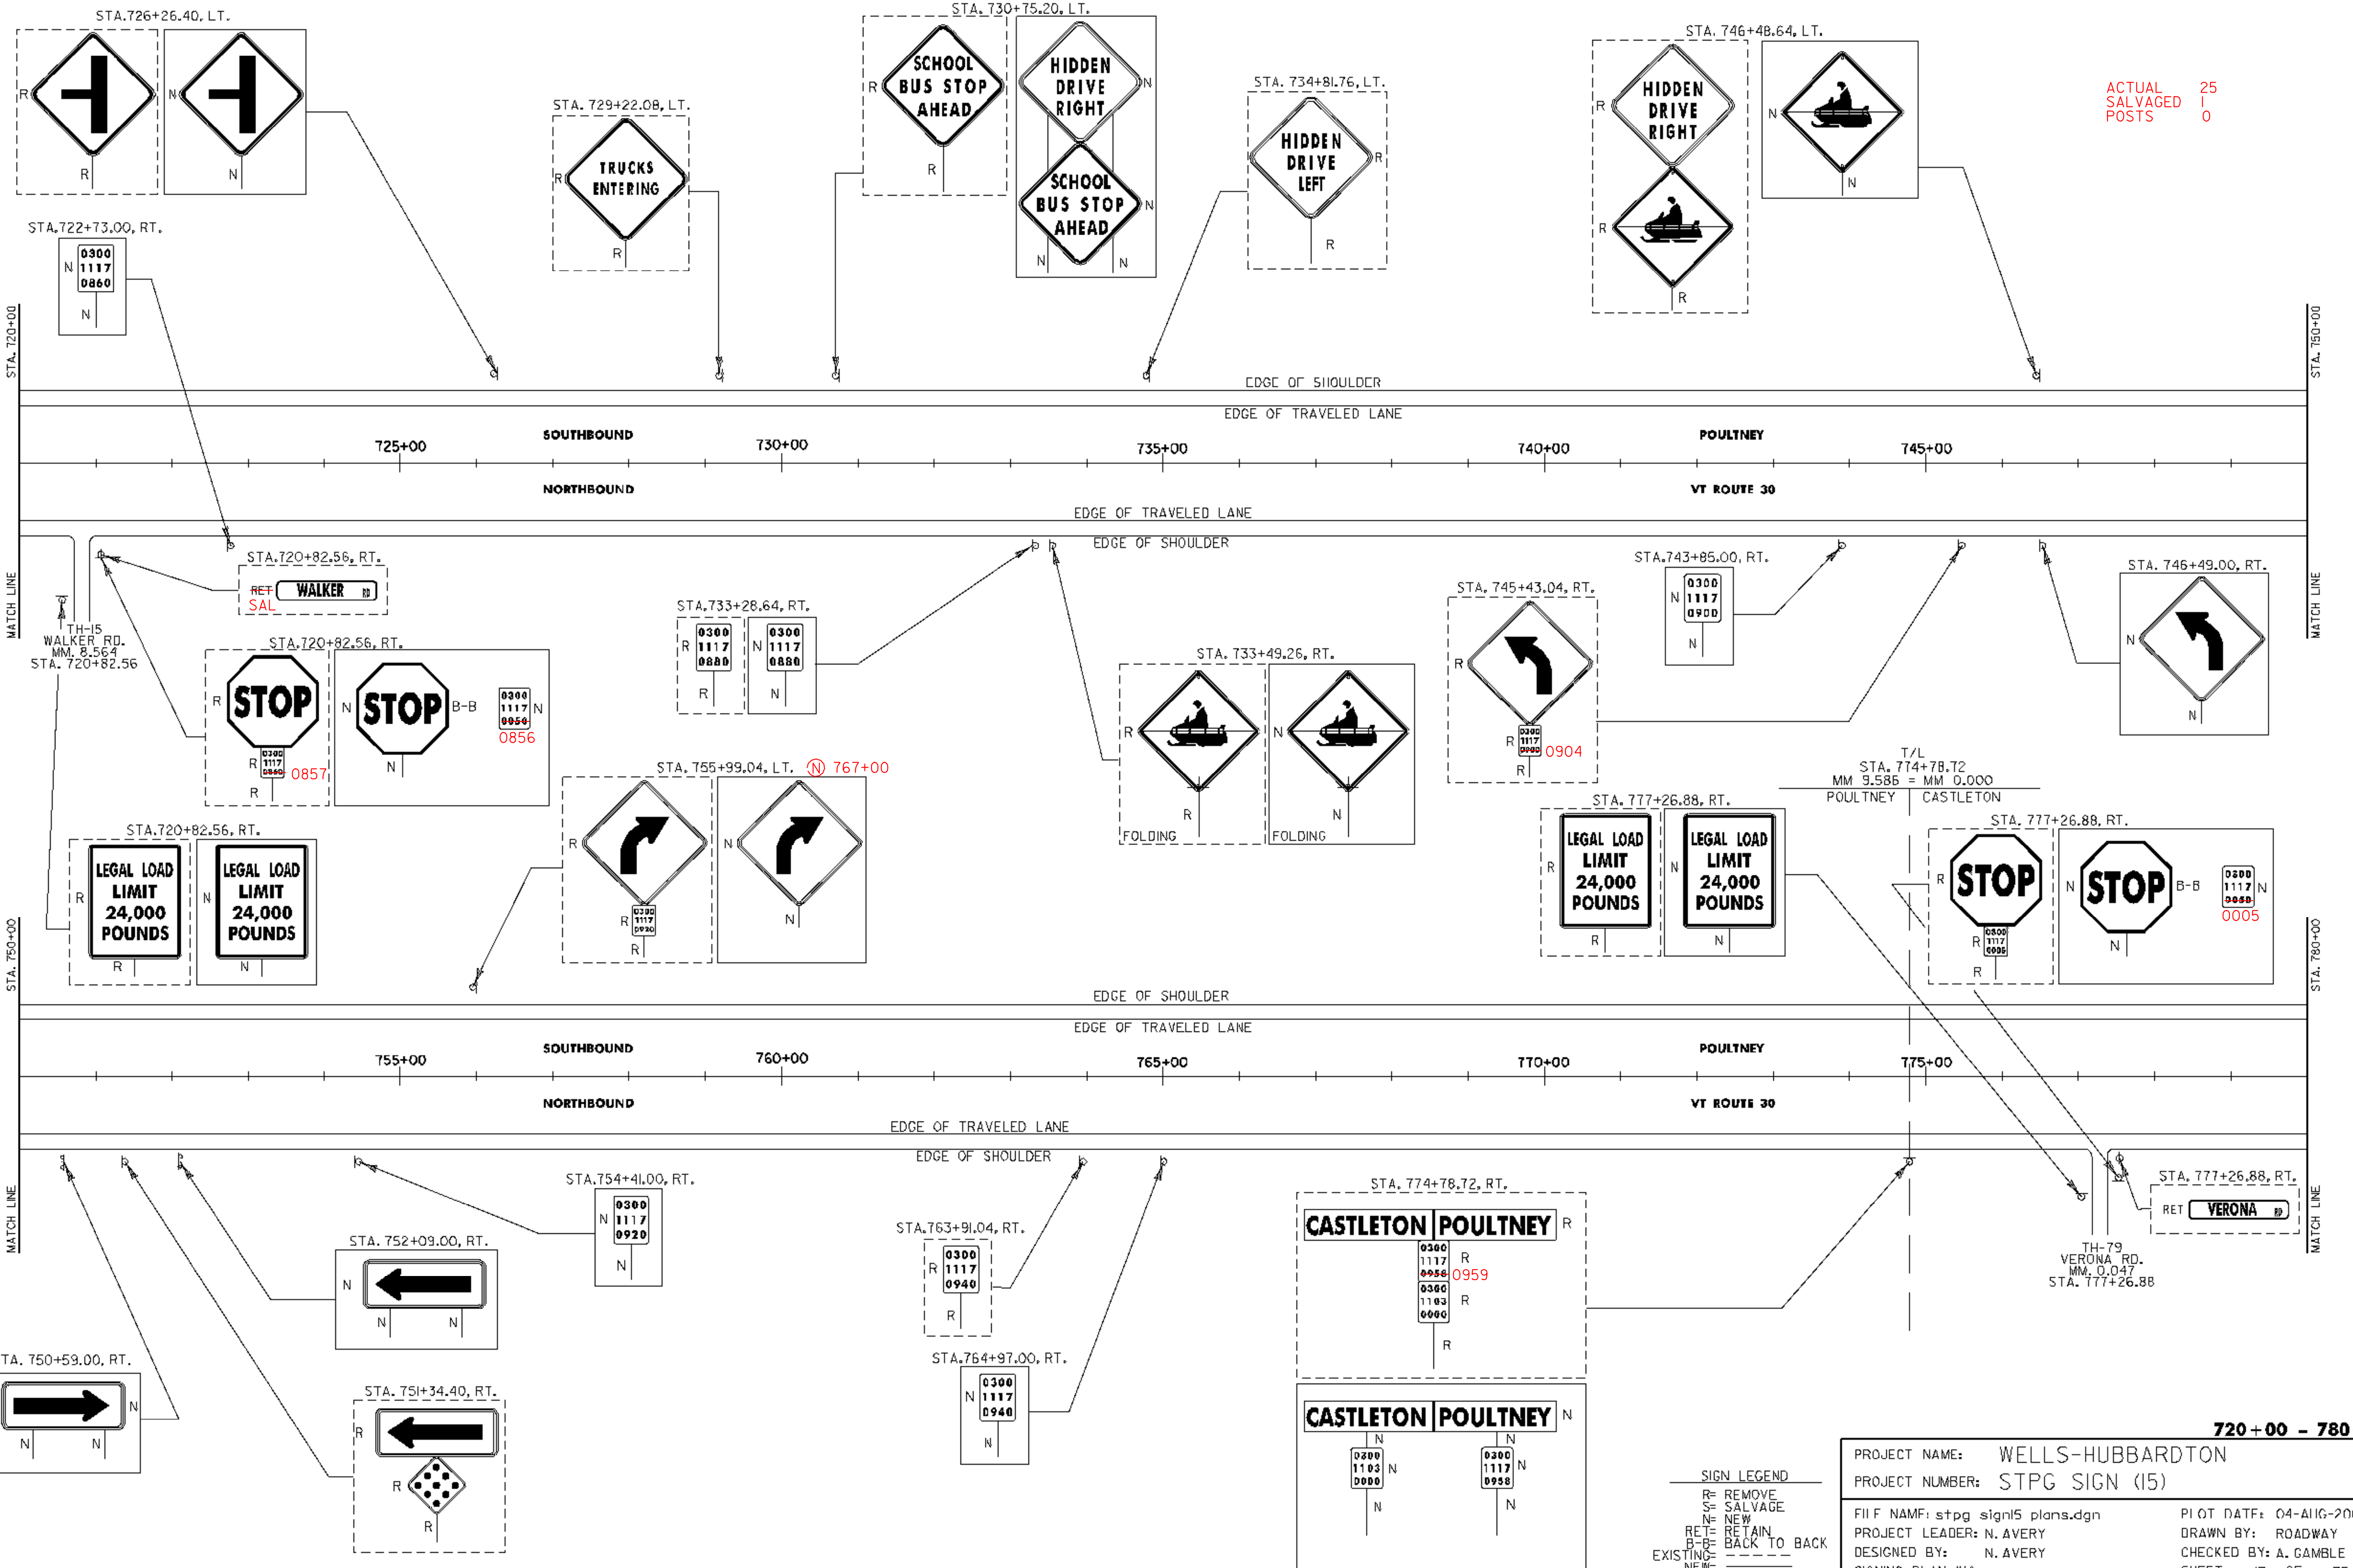

720+00 - 780+00

PROJECT NAME: WELLS-HUBBARDTON
 PROJECT NUMBER: STPG SIGN (15)
 FILE NAME: stpg sign15 plans.dgn
 PROJECT LEADER: N. AVERY
 DESIGNED BY: N. AVERY
 SIGNING PLAN #14
 PLOT DATE: 04-AUG-2008
 DRAWN BY: ROADWAY
 CHECKED BY: A. GAMBLE
 SHEET 17 OF 75

SIGN LEGEND
 R= REMOVE
 S= SALVAGE
 N= NEW
 RET= RETAIN
 B-B= BACK TO BACK
 EXISTING= ---
 NEW= ---