





ACTUAL SALVAGED POSTS
19 0 0

STA. 780+00


















MATCH LINE

STA. 810+00

MATCH LINE

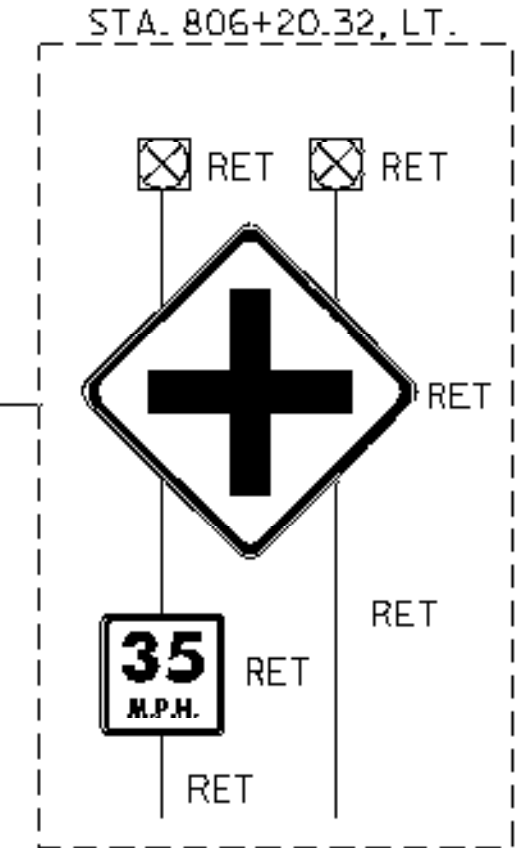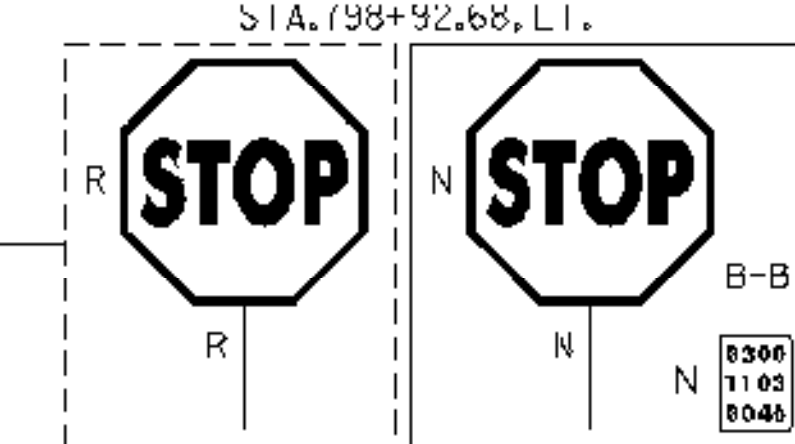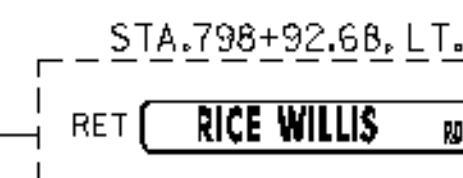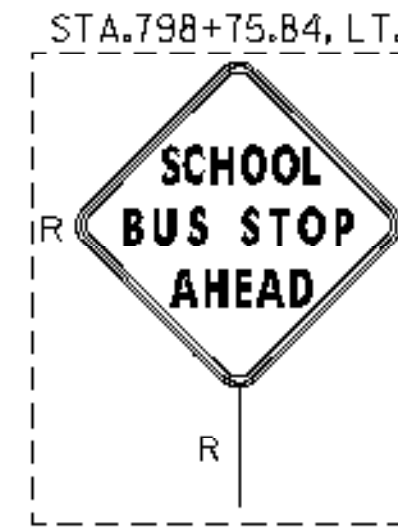

STA. 810+00

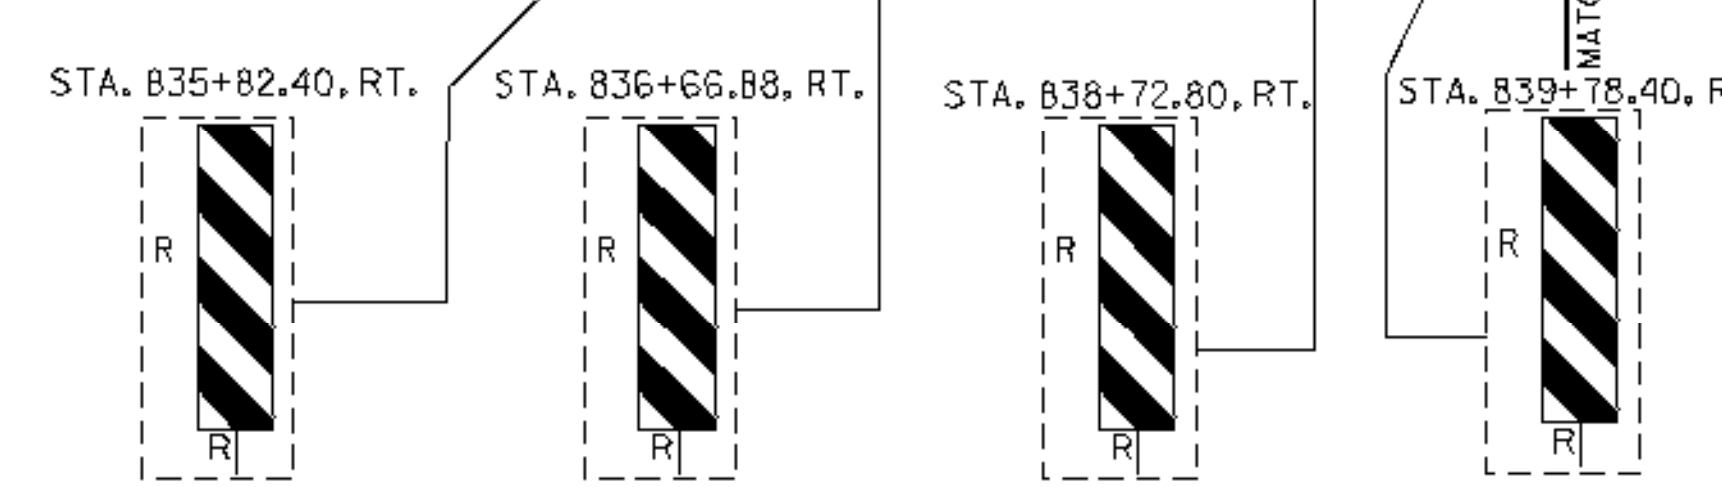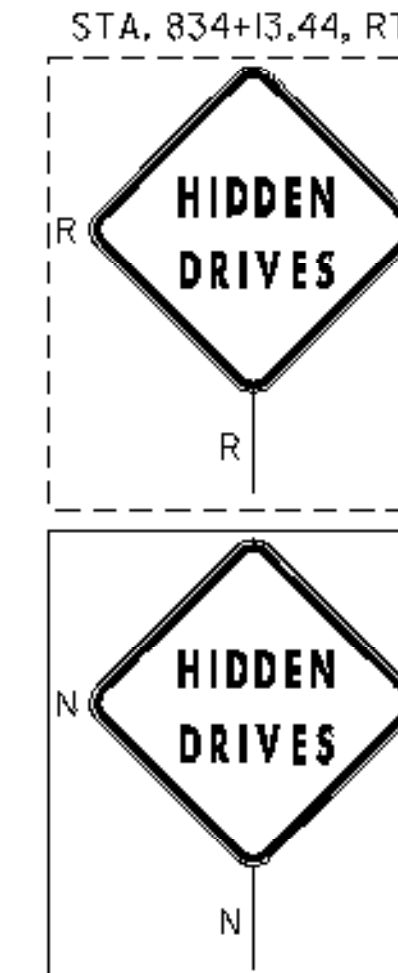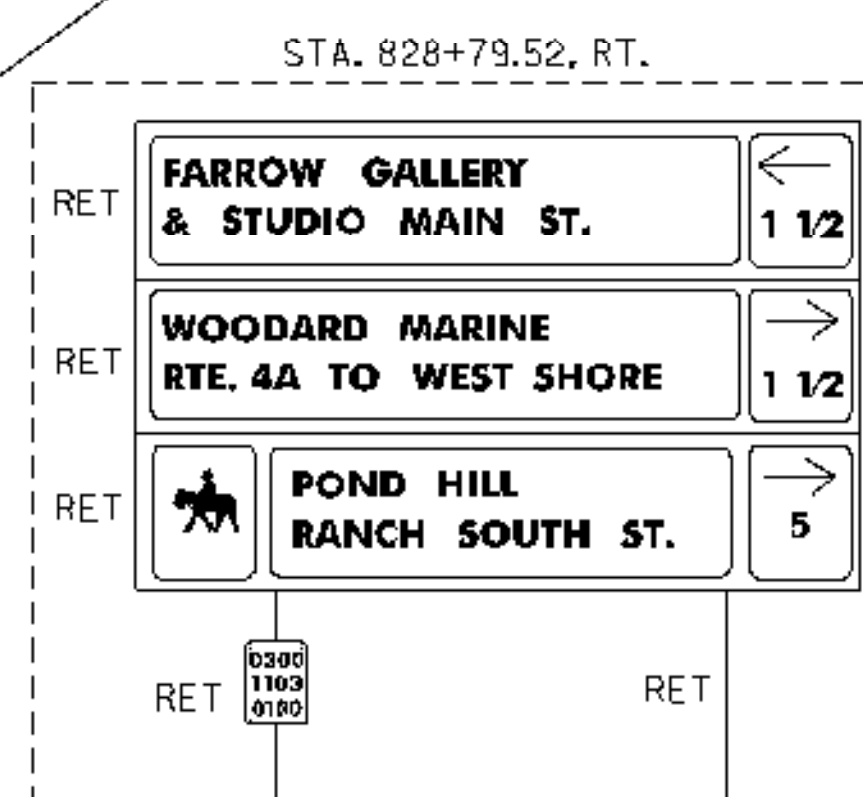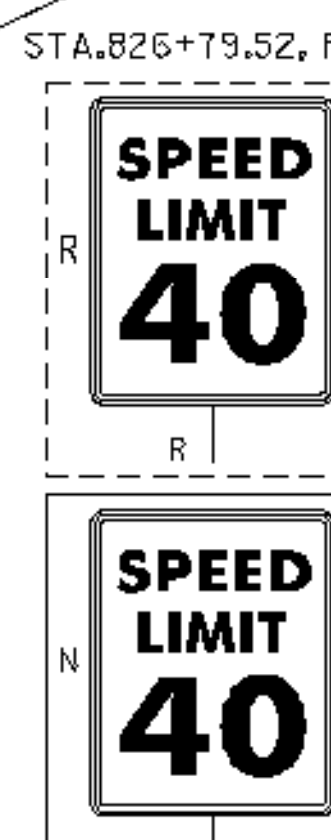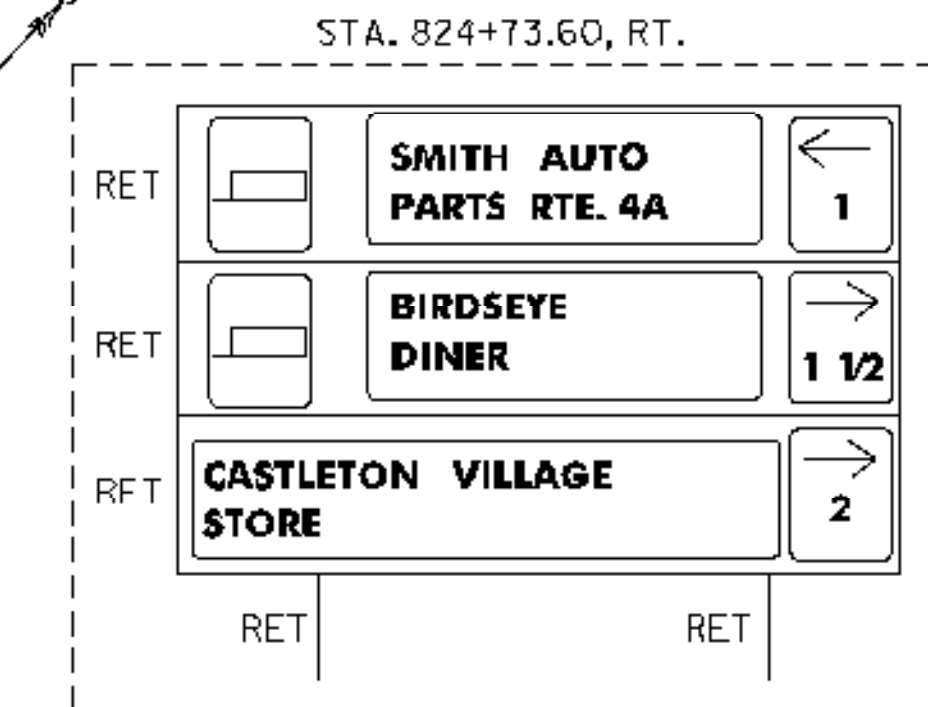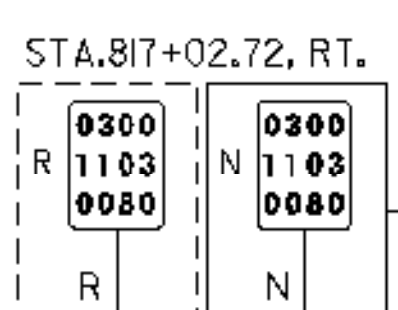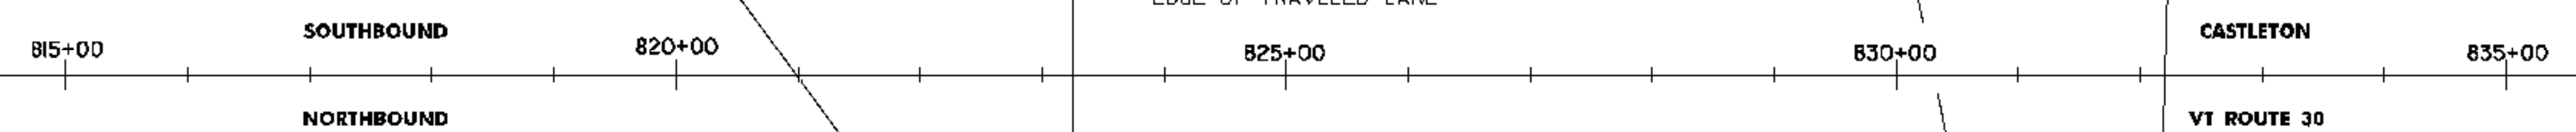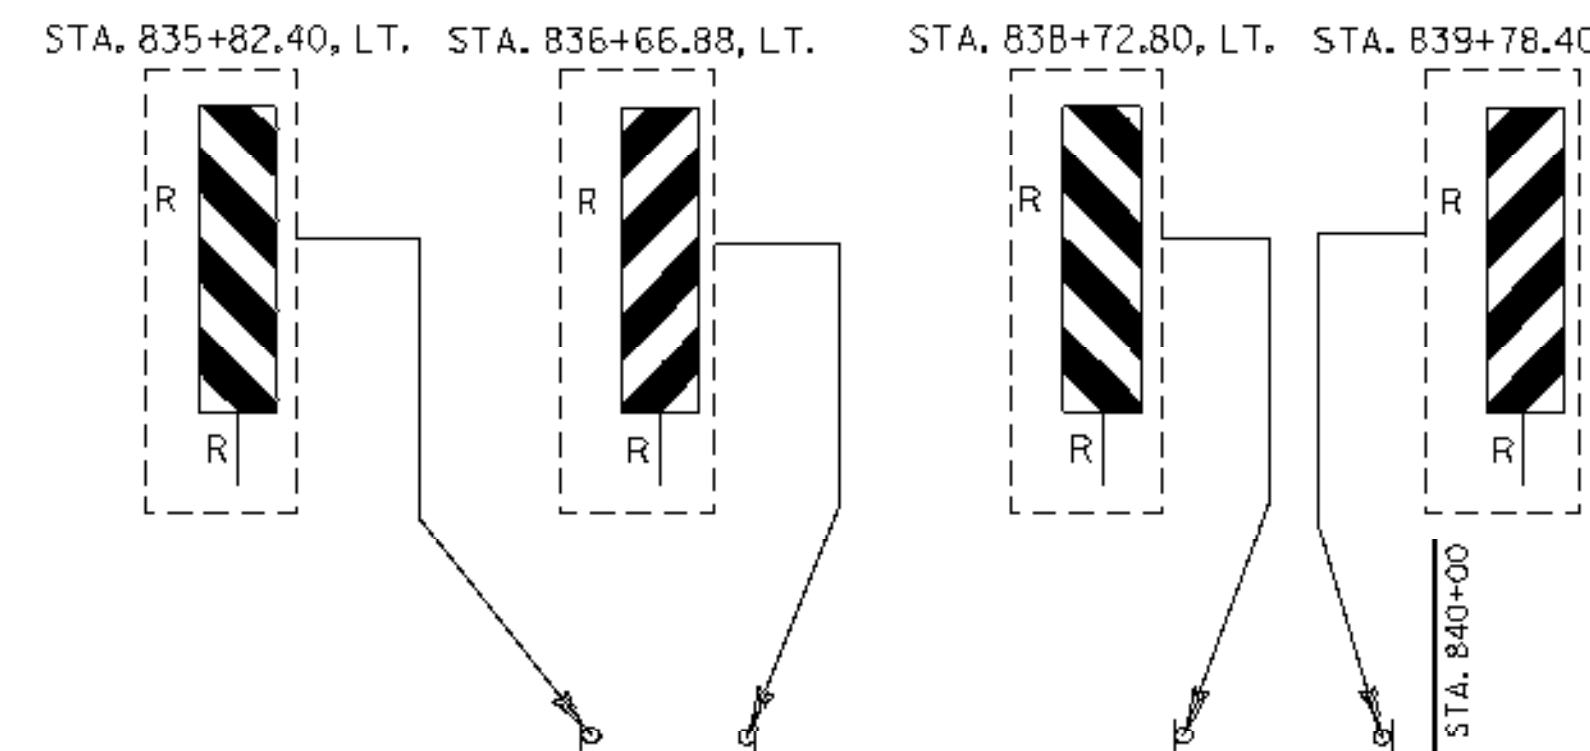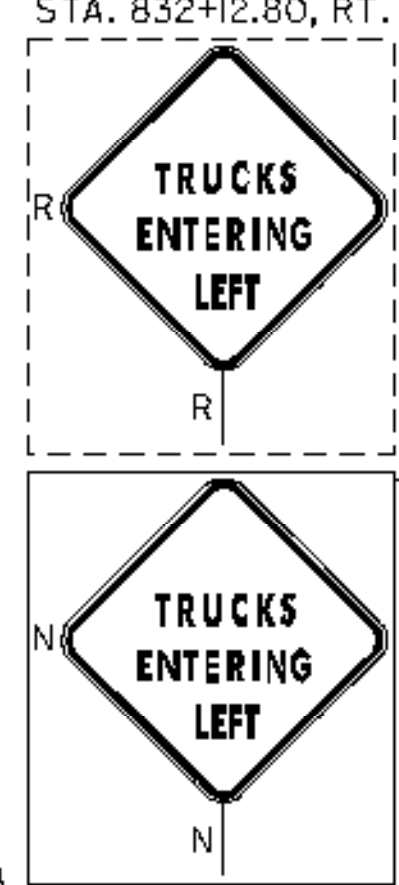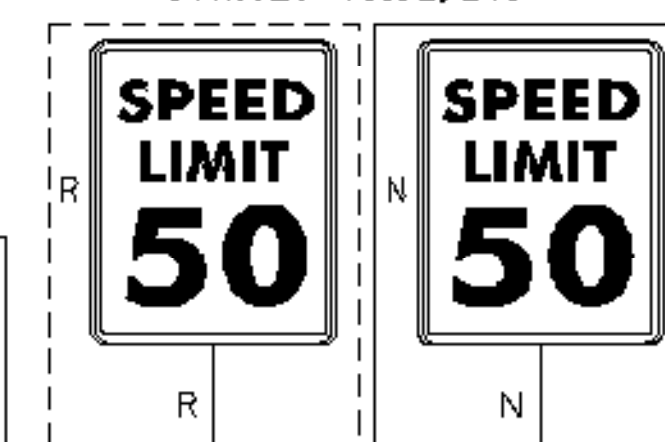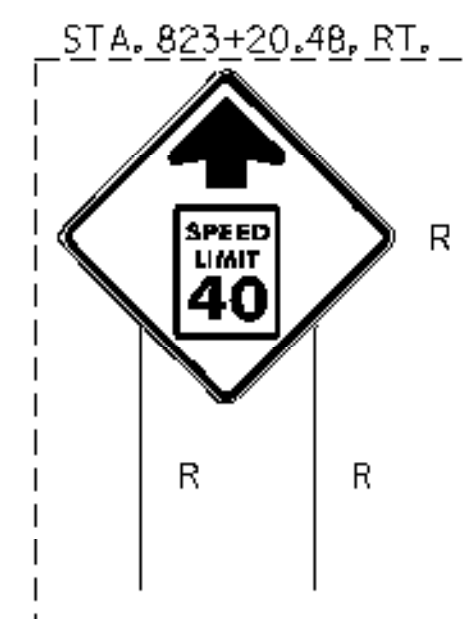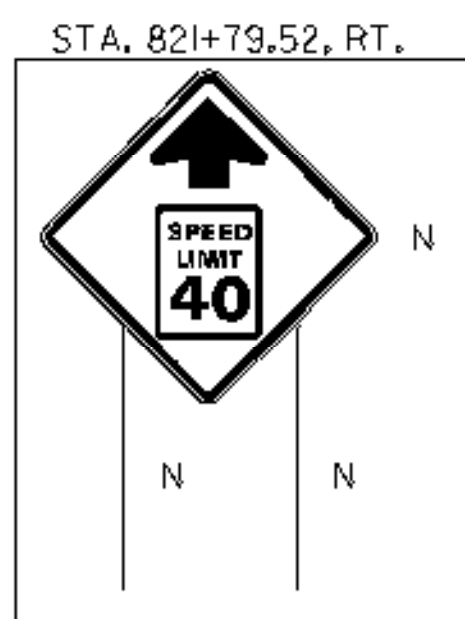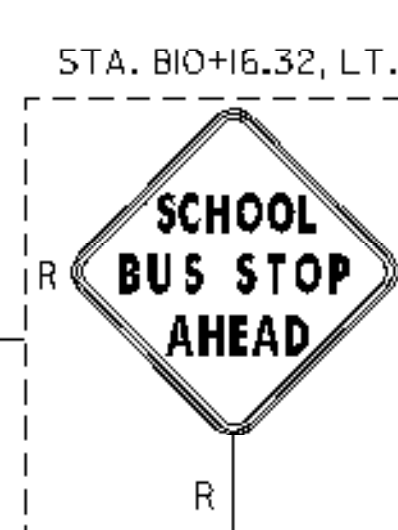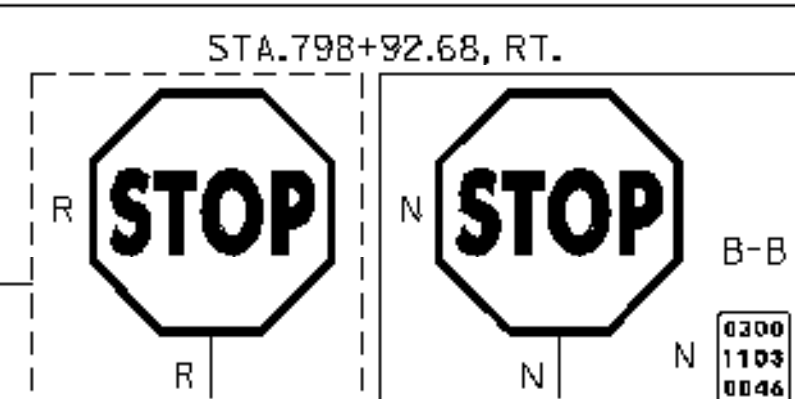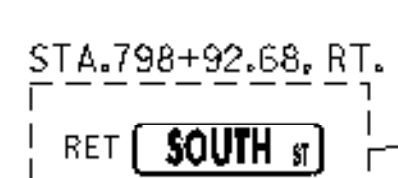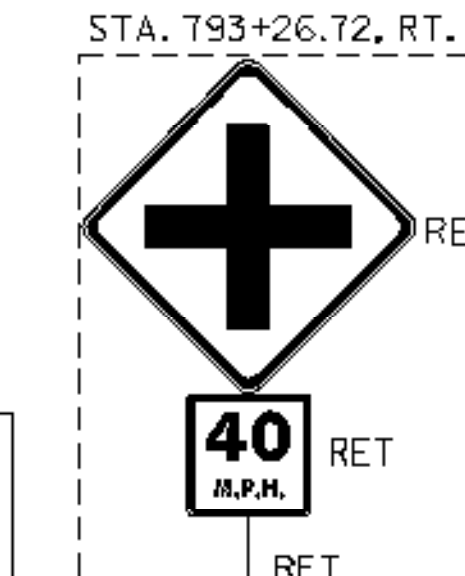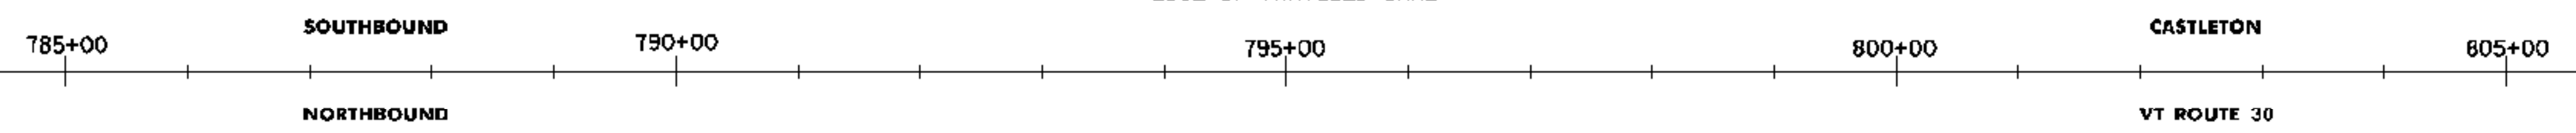

780+00 - 840+00

SIGN LEGEND
R= REMOVE
S= SALVAGE
N= NEW
RET= RETAIN
B-B= BACK TO BACK
EXISTING= ---
NEW= - - -

PROJECT NAME: WELLS-HUBBARDTON
PROJECT NUMBER: STPG SIGN (15)
FILE NAME: stpg sign15 plans.dgn
PROJECT LEADER: N. AVERY
DESIGNED BY: N. AVERY
SIGNING PLAN #15
PLOT DATE: 04-AUG-2008
DRAWN BY: ROADWAY
CHECKED BY: A. GAMBLE
SHEET 18 OF 75