


ACTUAL SALVAGED POSTS 600

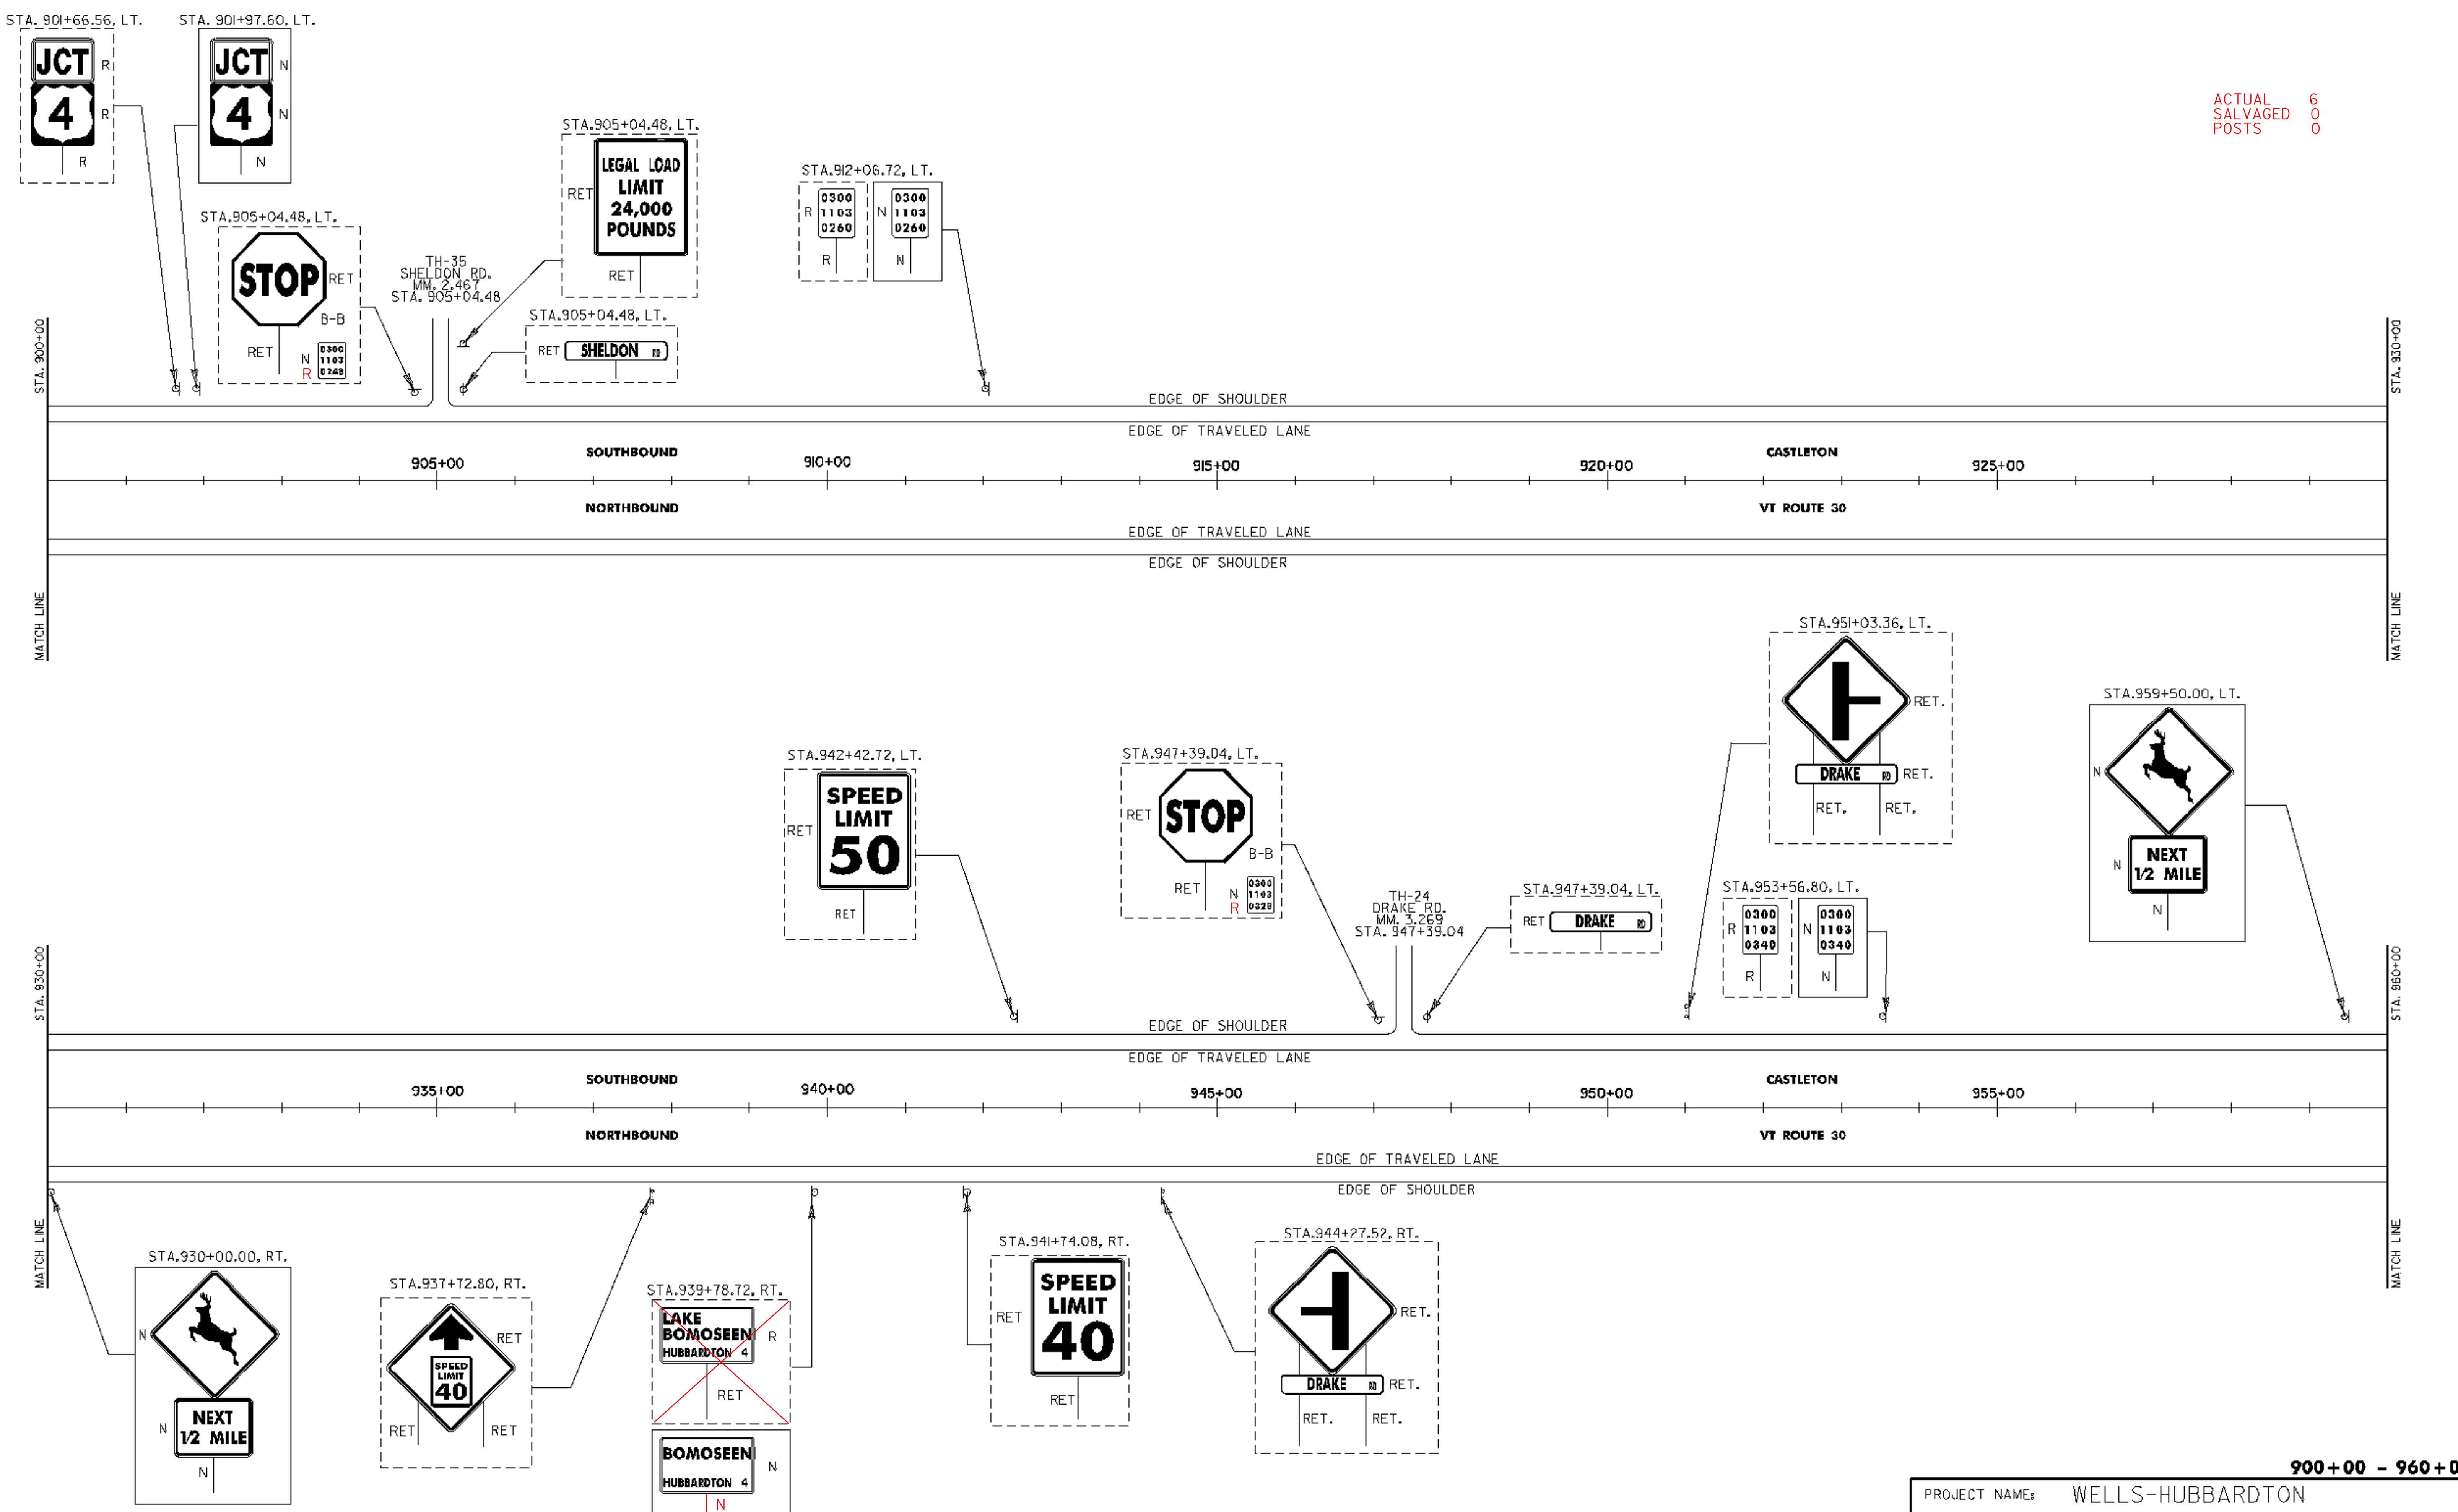

- SIGN LEGEND**
- R= REMOVE
 - S= SALVAGE
 - N= NEW
 - RET= RETAIN
 - B-B= BACK TO BACK
 - EXISTING= - - - - -
 - NEW= _____

900+00 - 960+00

PROJECT NAME: WELLS-HUBBARDTON
 PROJECT NUMBER: STPG SIGN (15)

FILE NAME: stpg sign5 plans.dgn
 PROJECT LEADER: N. AVERY
 DESIGNED BY: N. AVERY
 SIGNING PLAN #19

PLOT DATE: 04-AUG-2008
 DRAWN BY: ROADWAY
 CHECKED BY: A. GAMBLE
 SHEET 22 OF 75