

ACTUAL II
SALVAGED 0
POSTS 0

STA. 960+00

STA. 990+00

MATCH LINE


MATCH LINE

STA. 990+00

STA. 1020+00

MATCH LINE

MATCH LINE

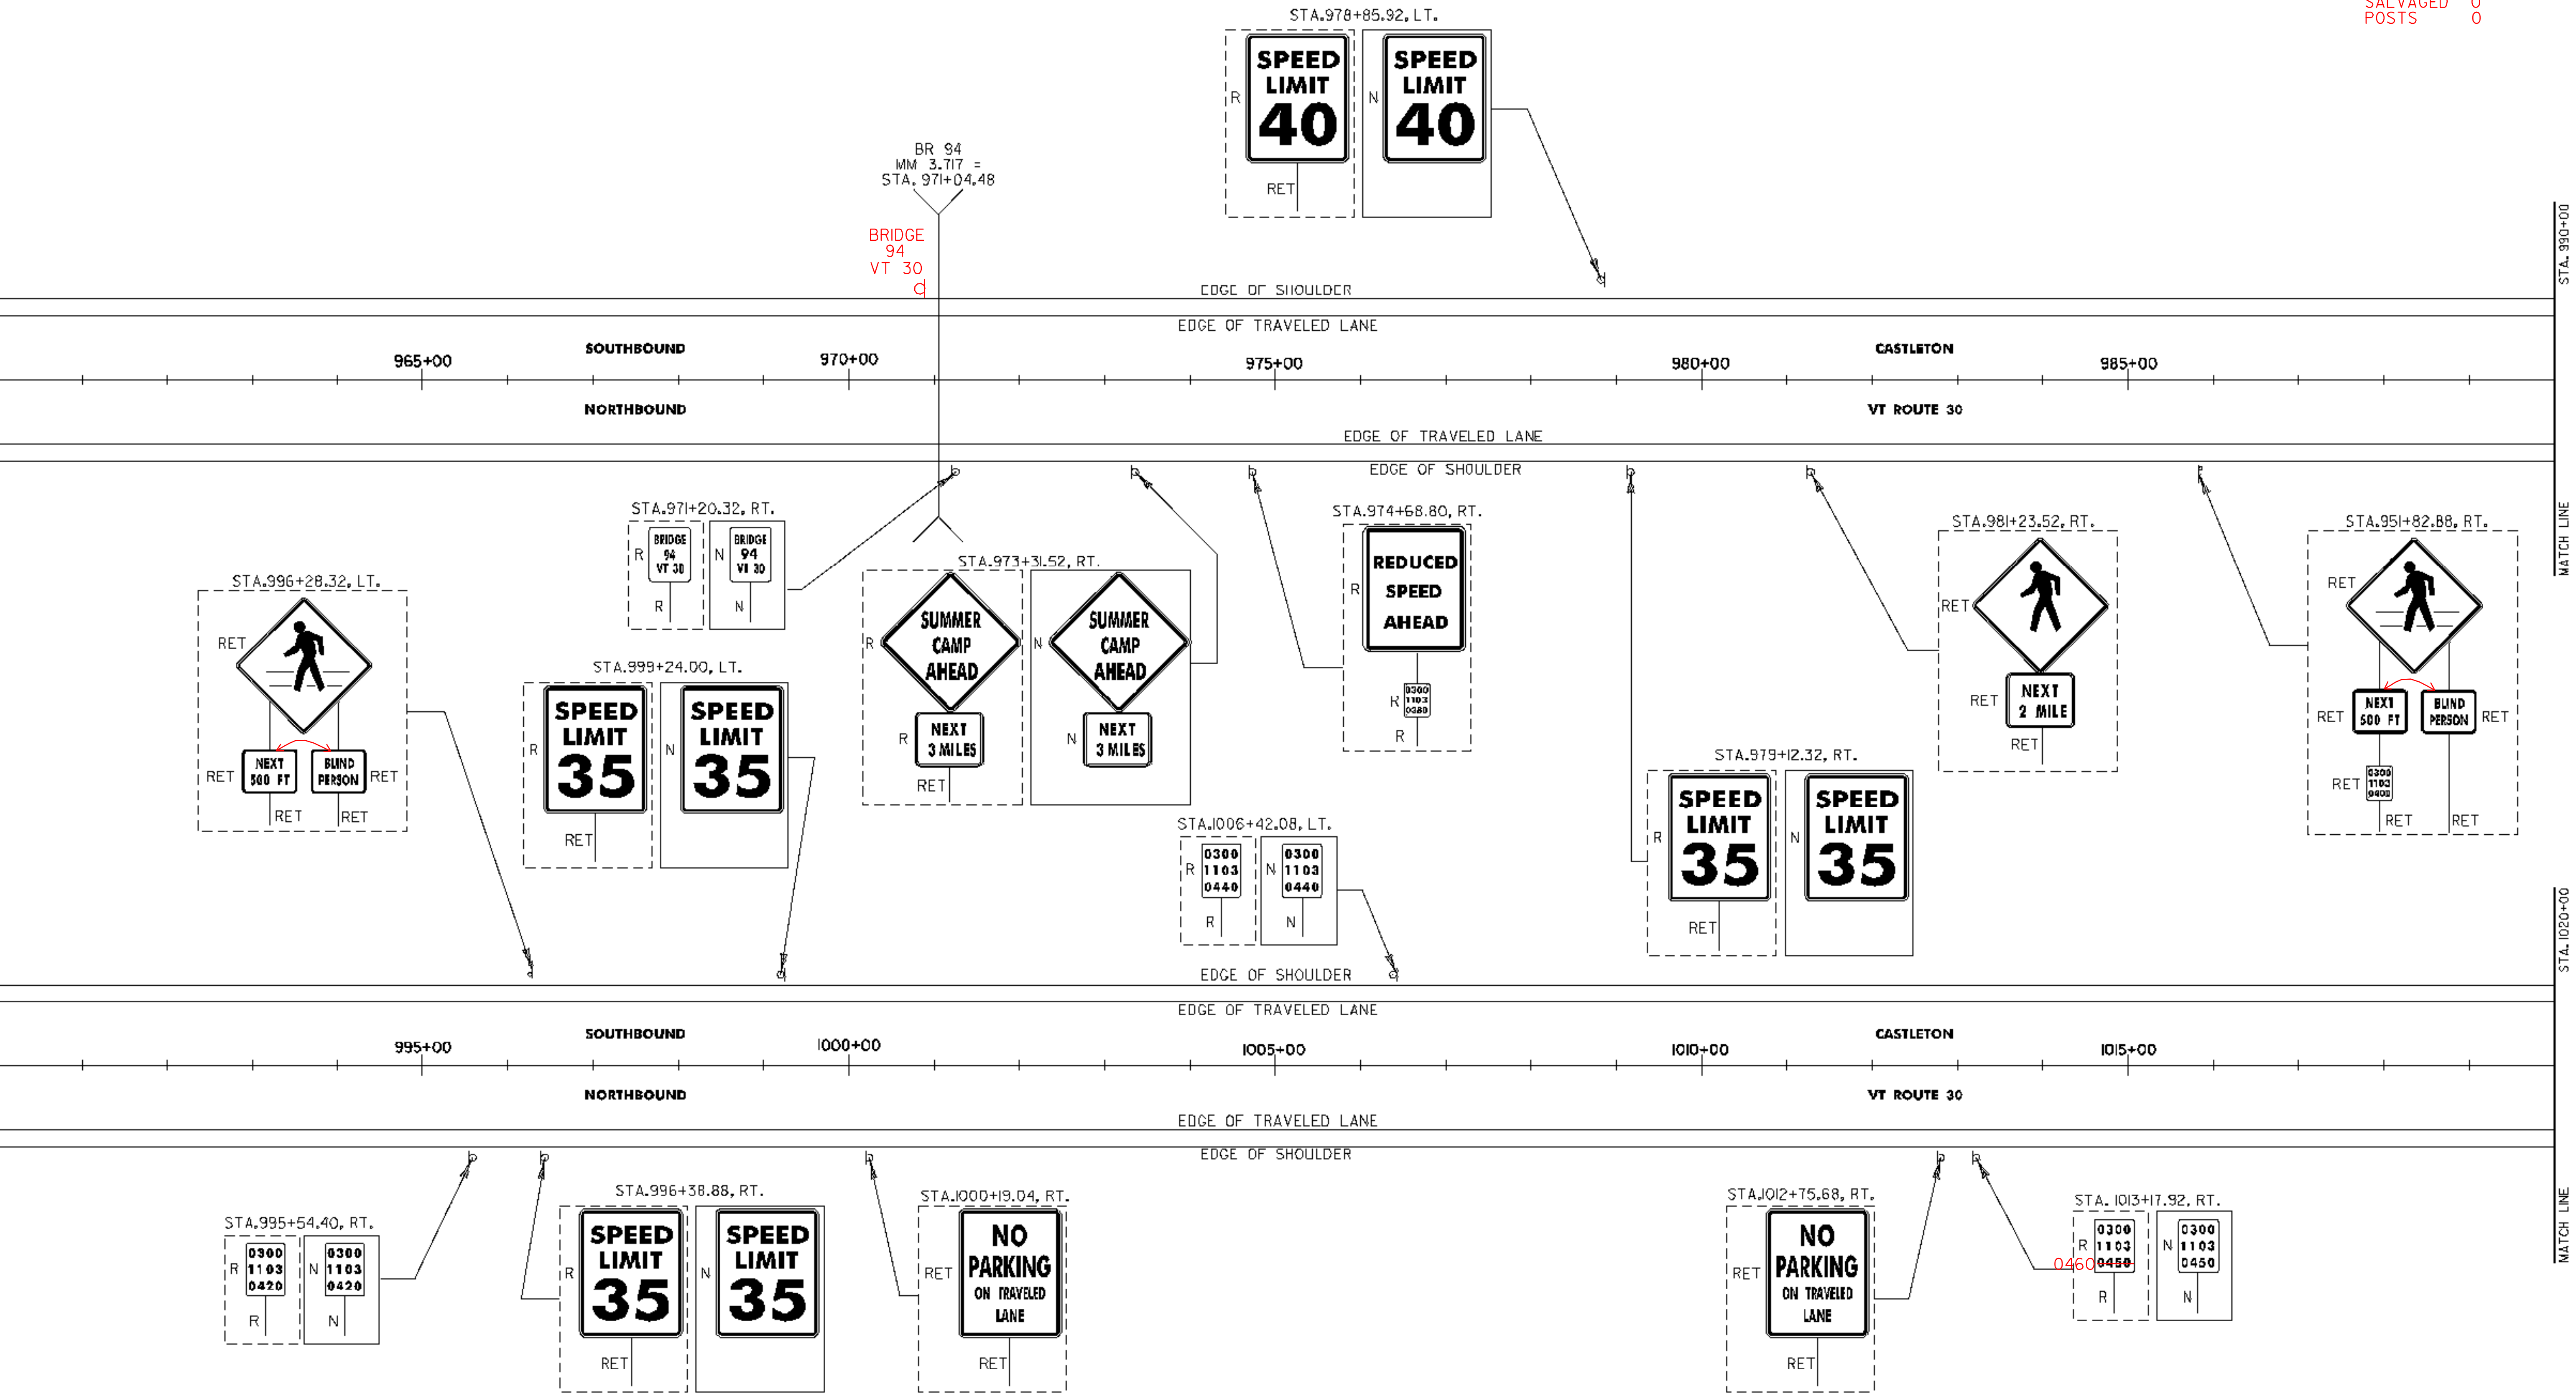

960+00 - 1020+00

SIGN LEGEND
R= REMOVE
S= SALVAGE
N= NEW
RET= RETAIN
B-B= BACK TO BACK
EXISTING= - - - -
NEW= _____

PROJECT NAME: WELLS-HUBBARDTON
PROJECT NUMBER: STPG SIGN (15)
FILE NAME: stpg sign5 plans.dgn
PROJECT LEADER: N. AVERY
DESIGNED BY: N. AVERY
SIGNING PLAN #20
PLOT DATE: 04-AUG-2008
DRAWN BY: ROADWAY
CHECKED BY: A. GAMBLE
SHEET 23 OF 75