
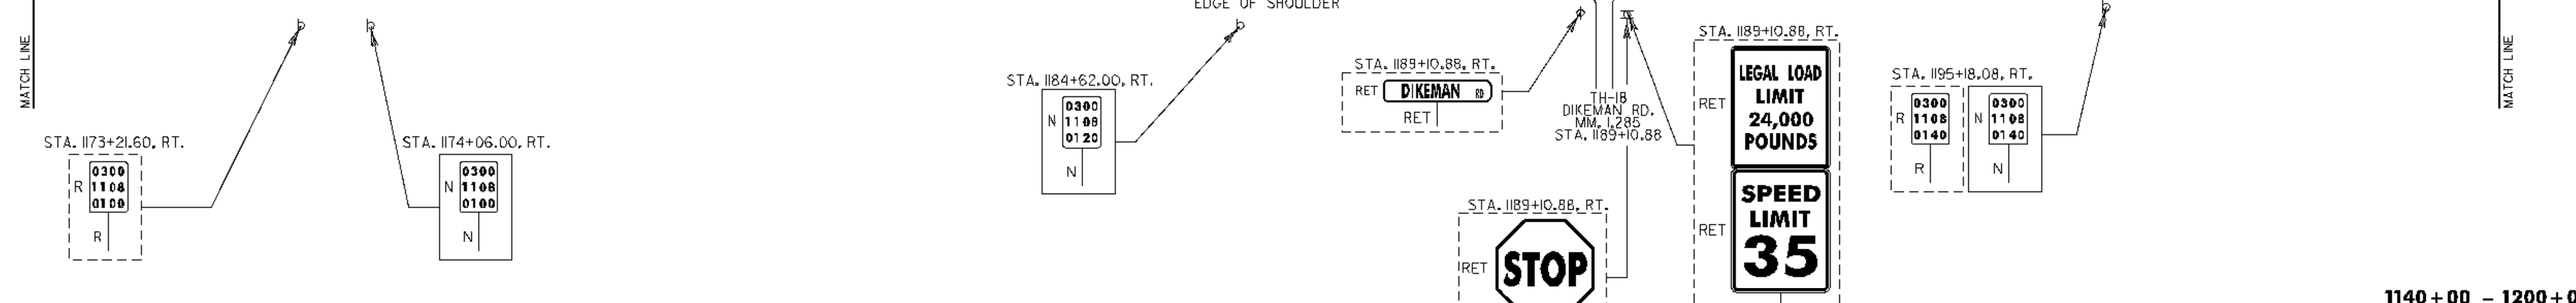
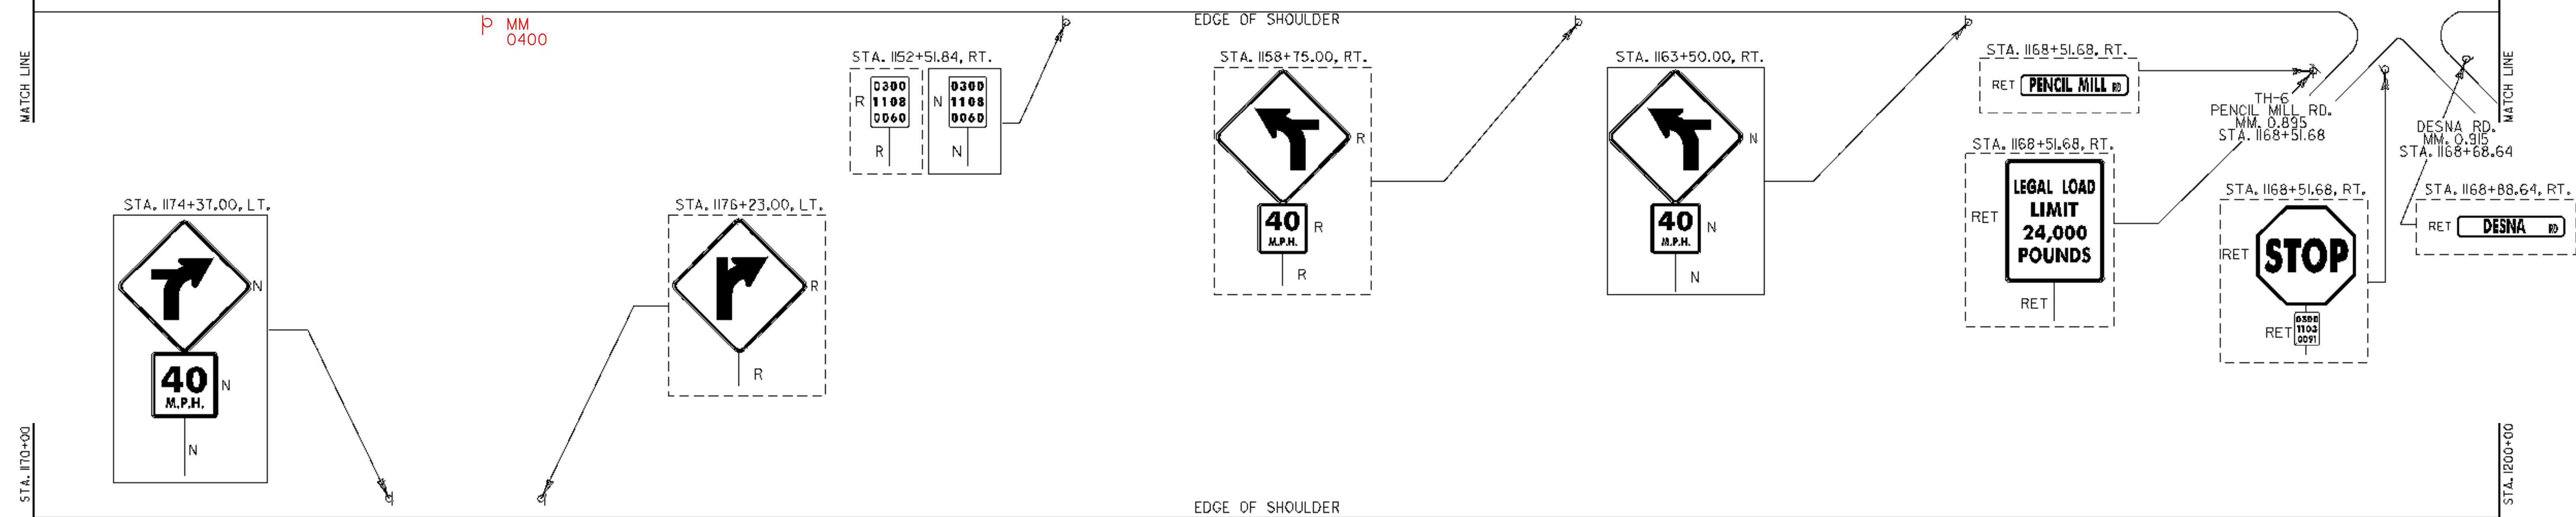
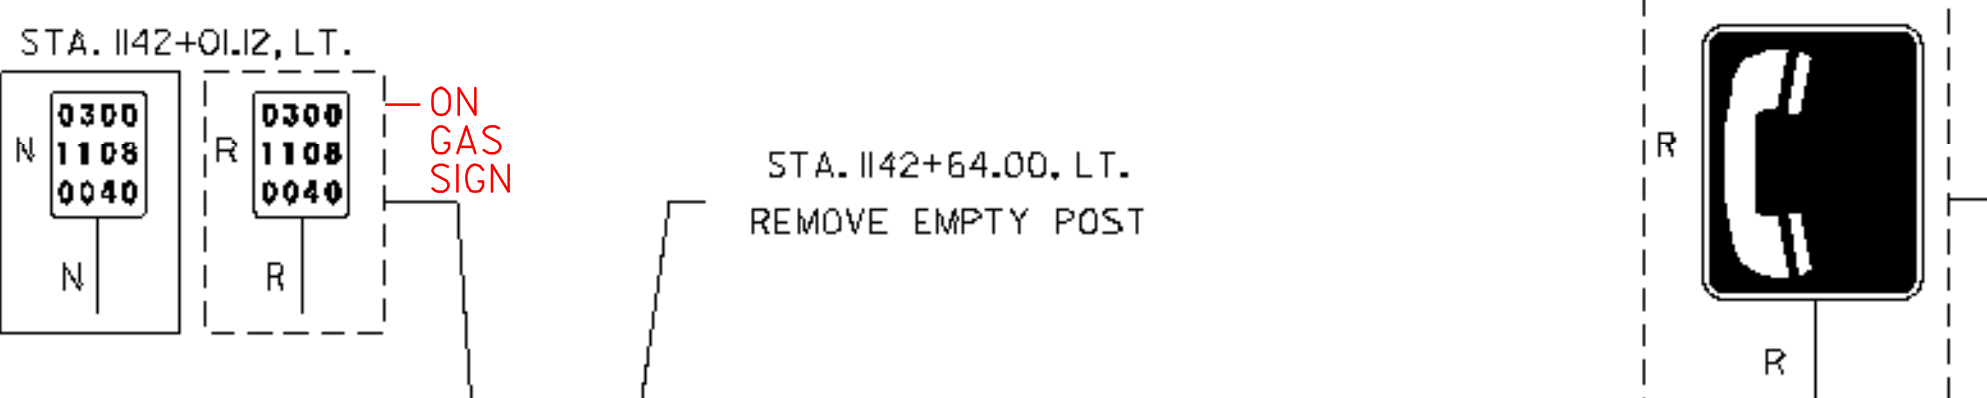


ACTUAL SALVAGED POSTS 900

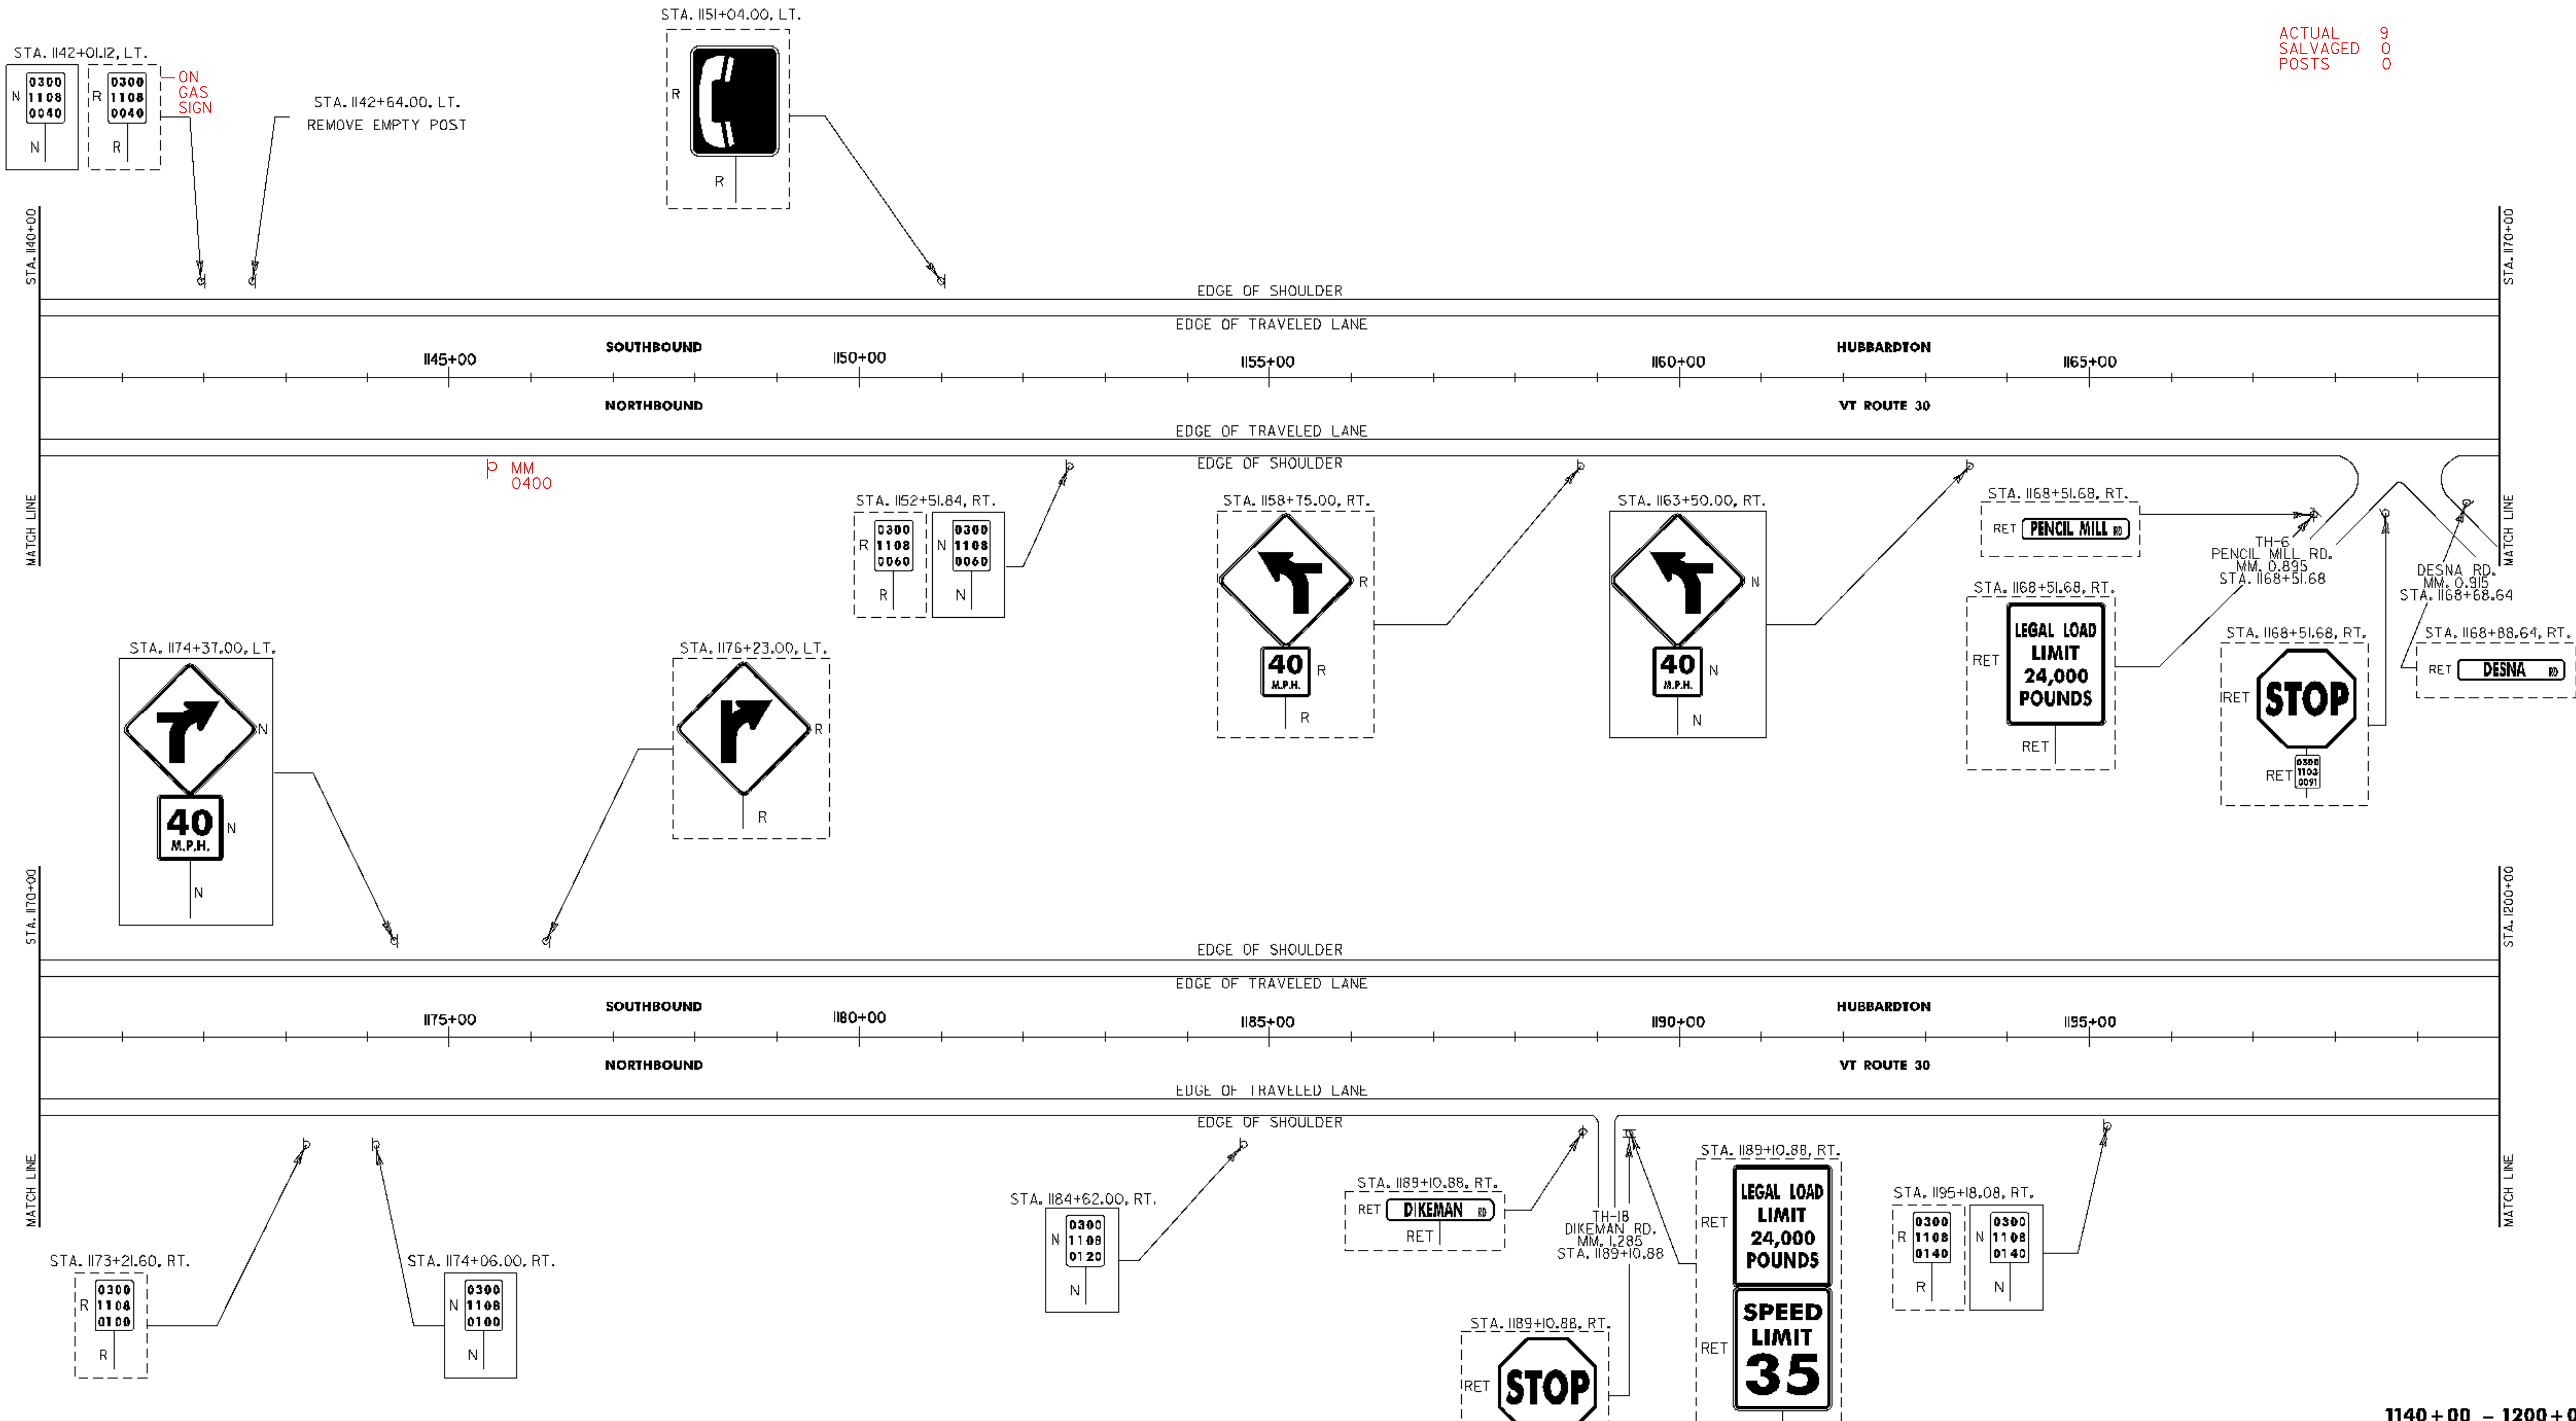

SIGN LEGEND
 R= REMOVE
 S= SALVAGE
 N= NEW
 RET= RETAIN
 B-B= BACK TO BACK
 EXISTING= - - - - -
 NEW= _____

1140 + 00 - 1200 + 00

PROJECT NAME: WELLS-HUBBARDTON
 PROJECT NUMBER: STPG SIGN (15)

FILE NAME: stpg sign5 plans.dgn PLOT DATE: 04-AUG-2008
 PROJECT LEADER: N. AVERY DRAWN BY: ROADWAY
 DESIGNED BY: N. AVERY CHECKED BY: A. GAMBLE
 SIGNING PLAN #23 SHEET 26 OF 75