


ACTUAL SALVAGED POSTS 800

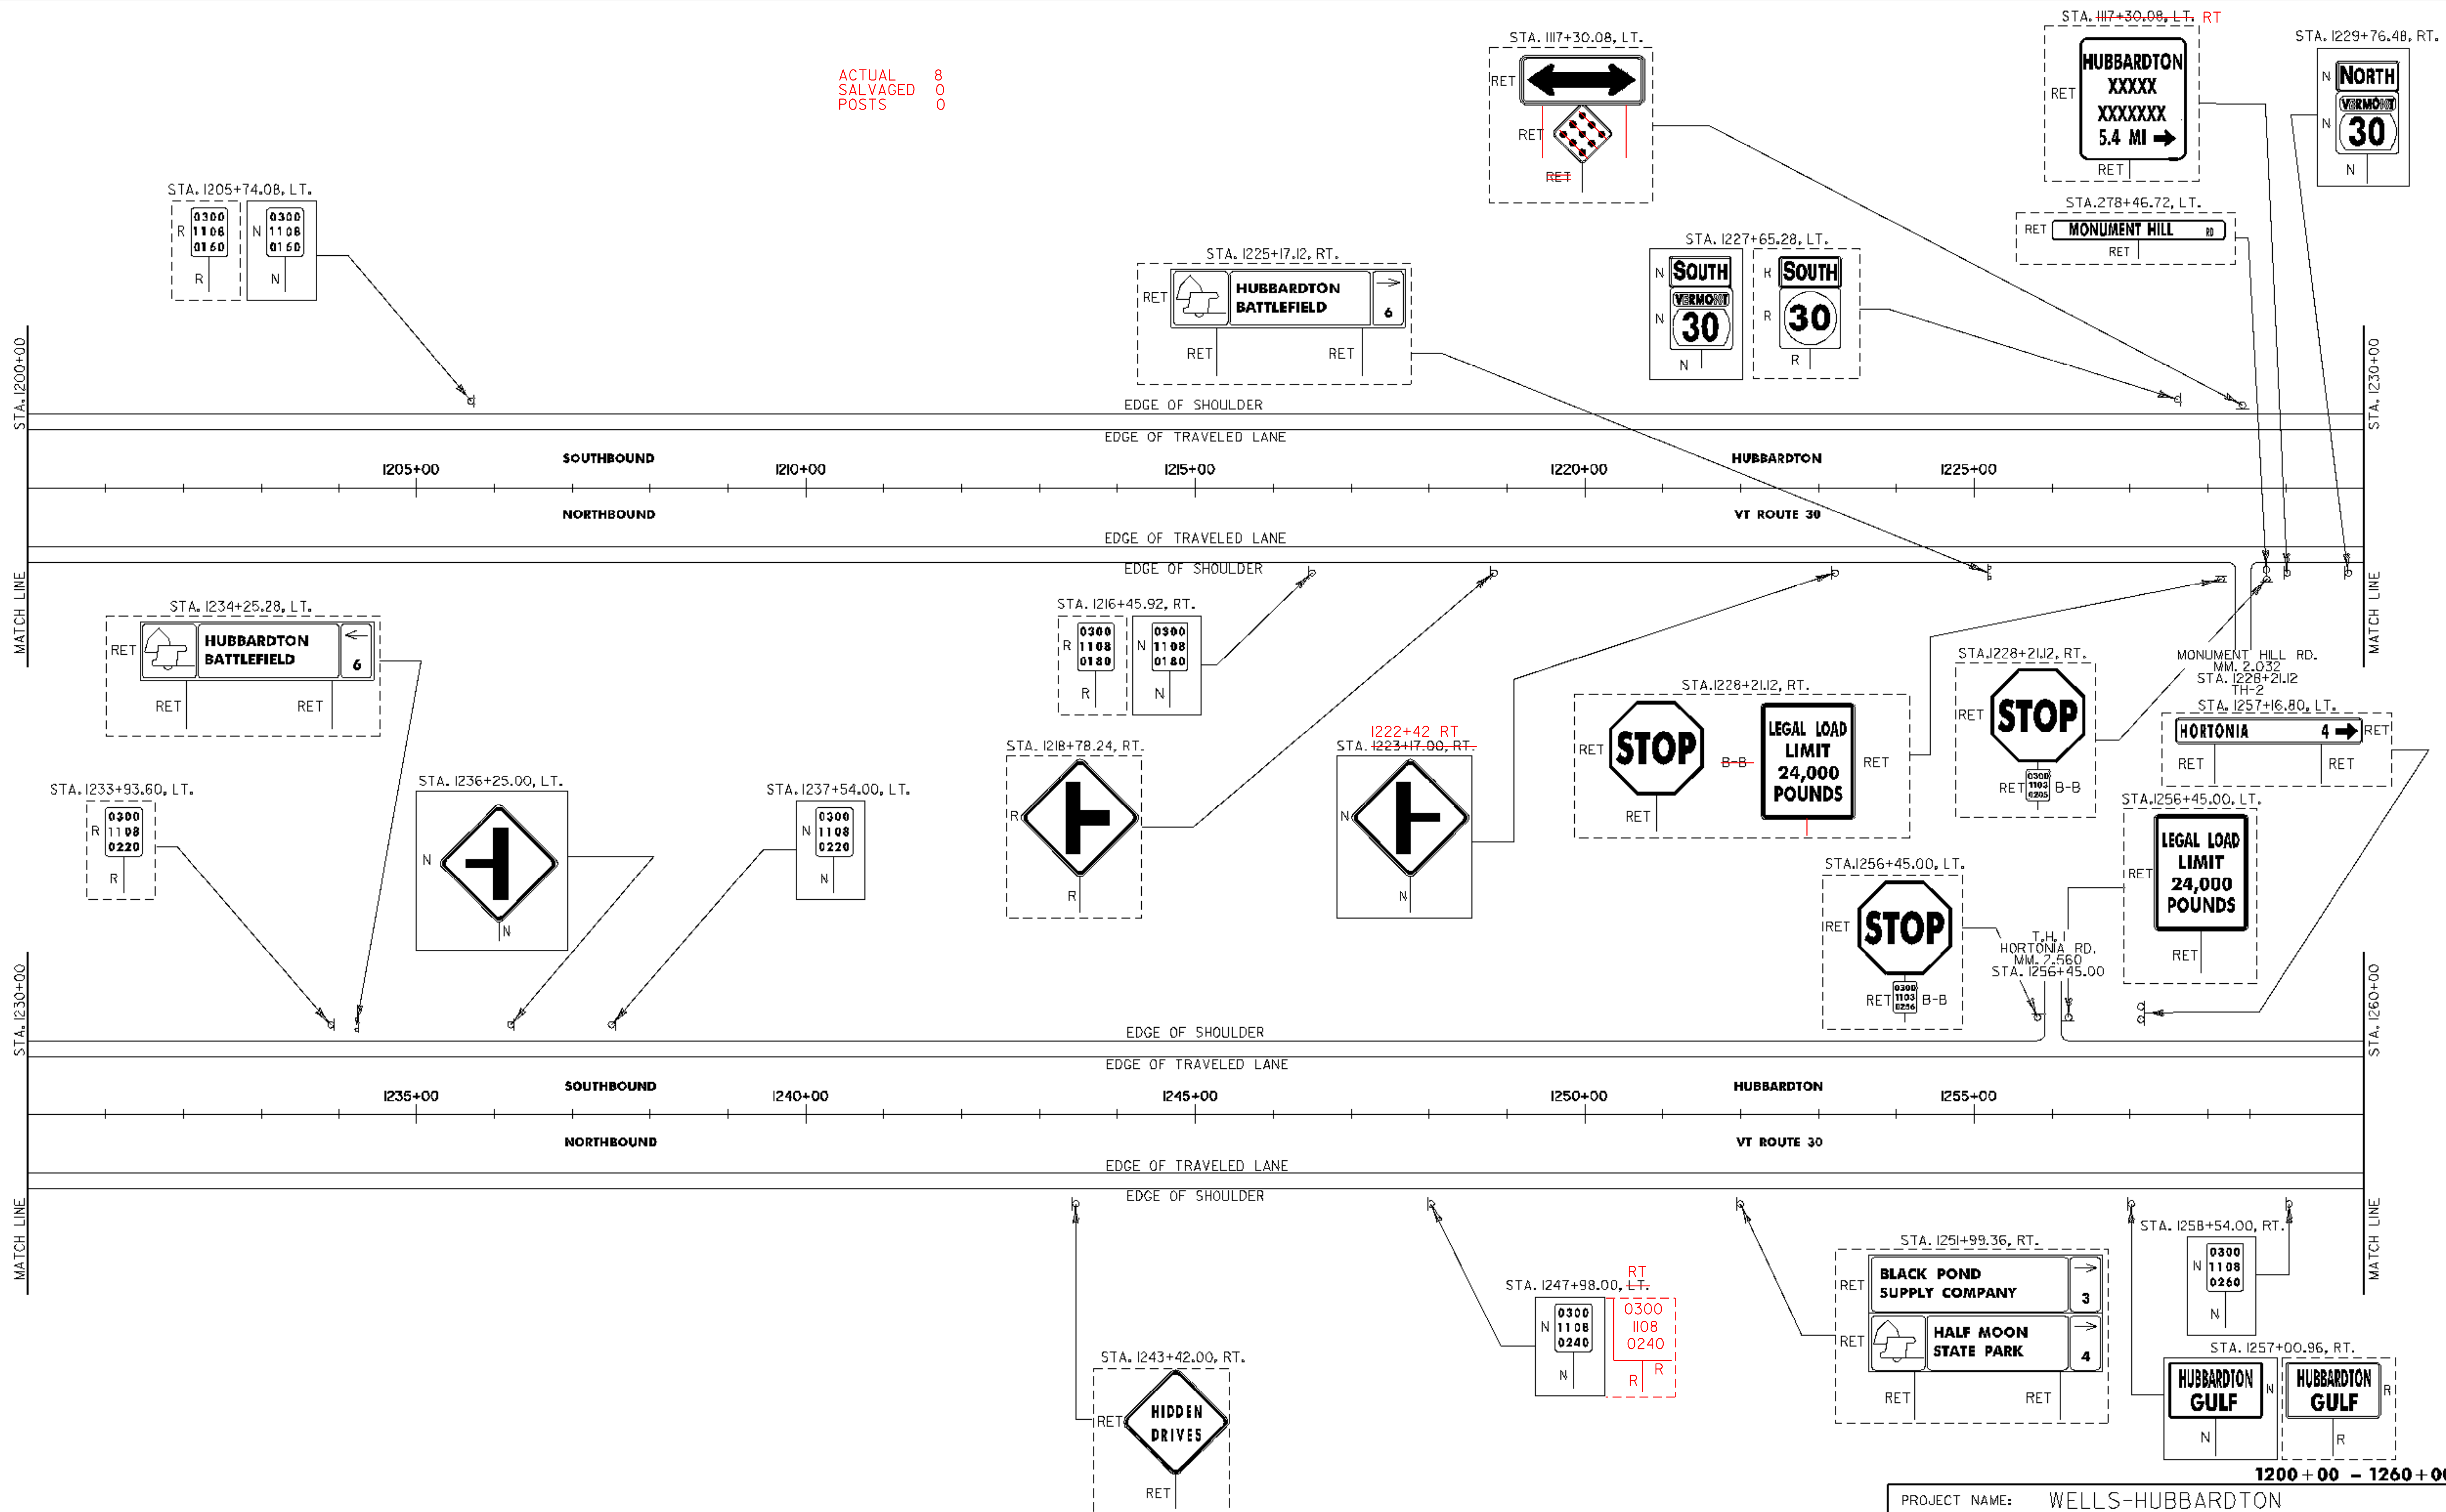

SIGN LEGEND

- R= REMOVE
- S= SALVAGE
- N= NEW
- RET= RETAIN
- B-B= BACK TO BACK
- EXISTING=
- NEW=

PROJECT NAME:	WELLS-HUBBARDTON
PROJECT NUMBER:	STPG SIGN (15)
FILE NAME:	stpg sign15 plans.dgn
PROJECT LEADER:	N. AVERY
DESIGNED BY:	N. AVERY
SIGNING PLAN #	24
PLOT DATE:	04-AUG-2008
DRAWN BY:	ROADWAY
CHECKED BY:	A. GAMBLE
SHEET	27 OF 75

1200+00 - 1260+00