


ACTUAL SALVAGED POSTS 400

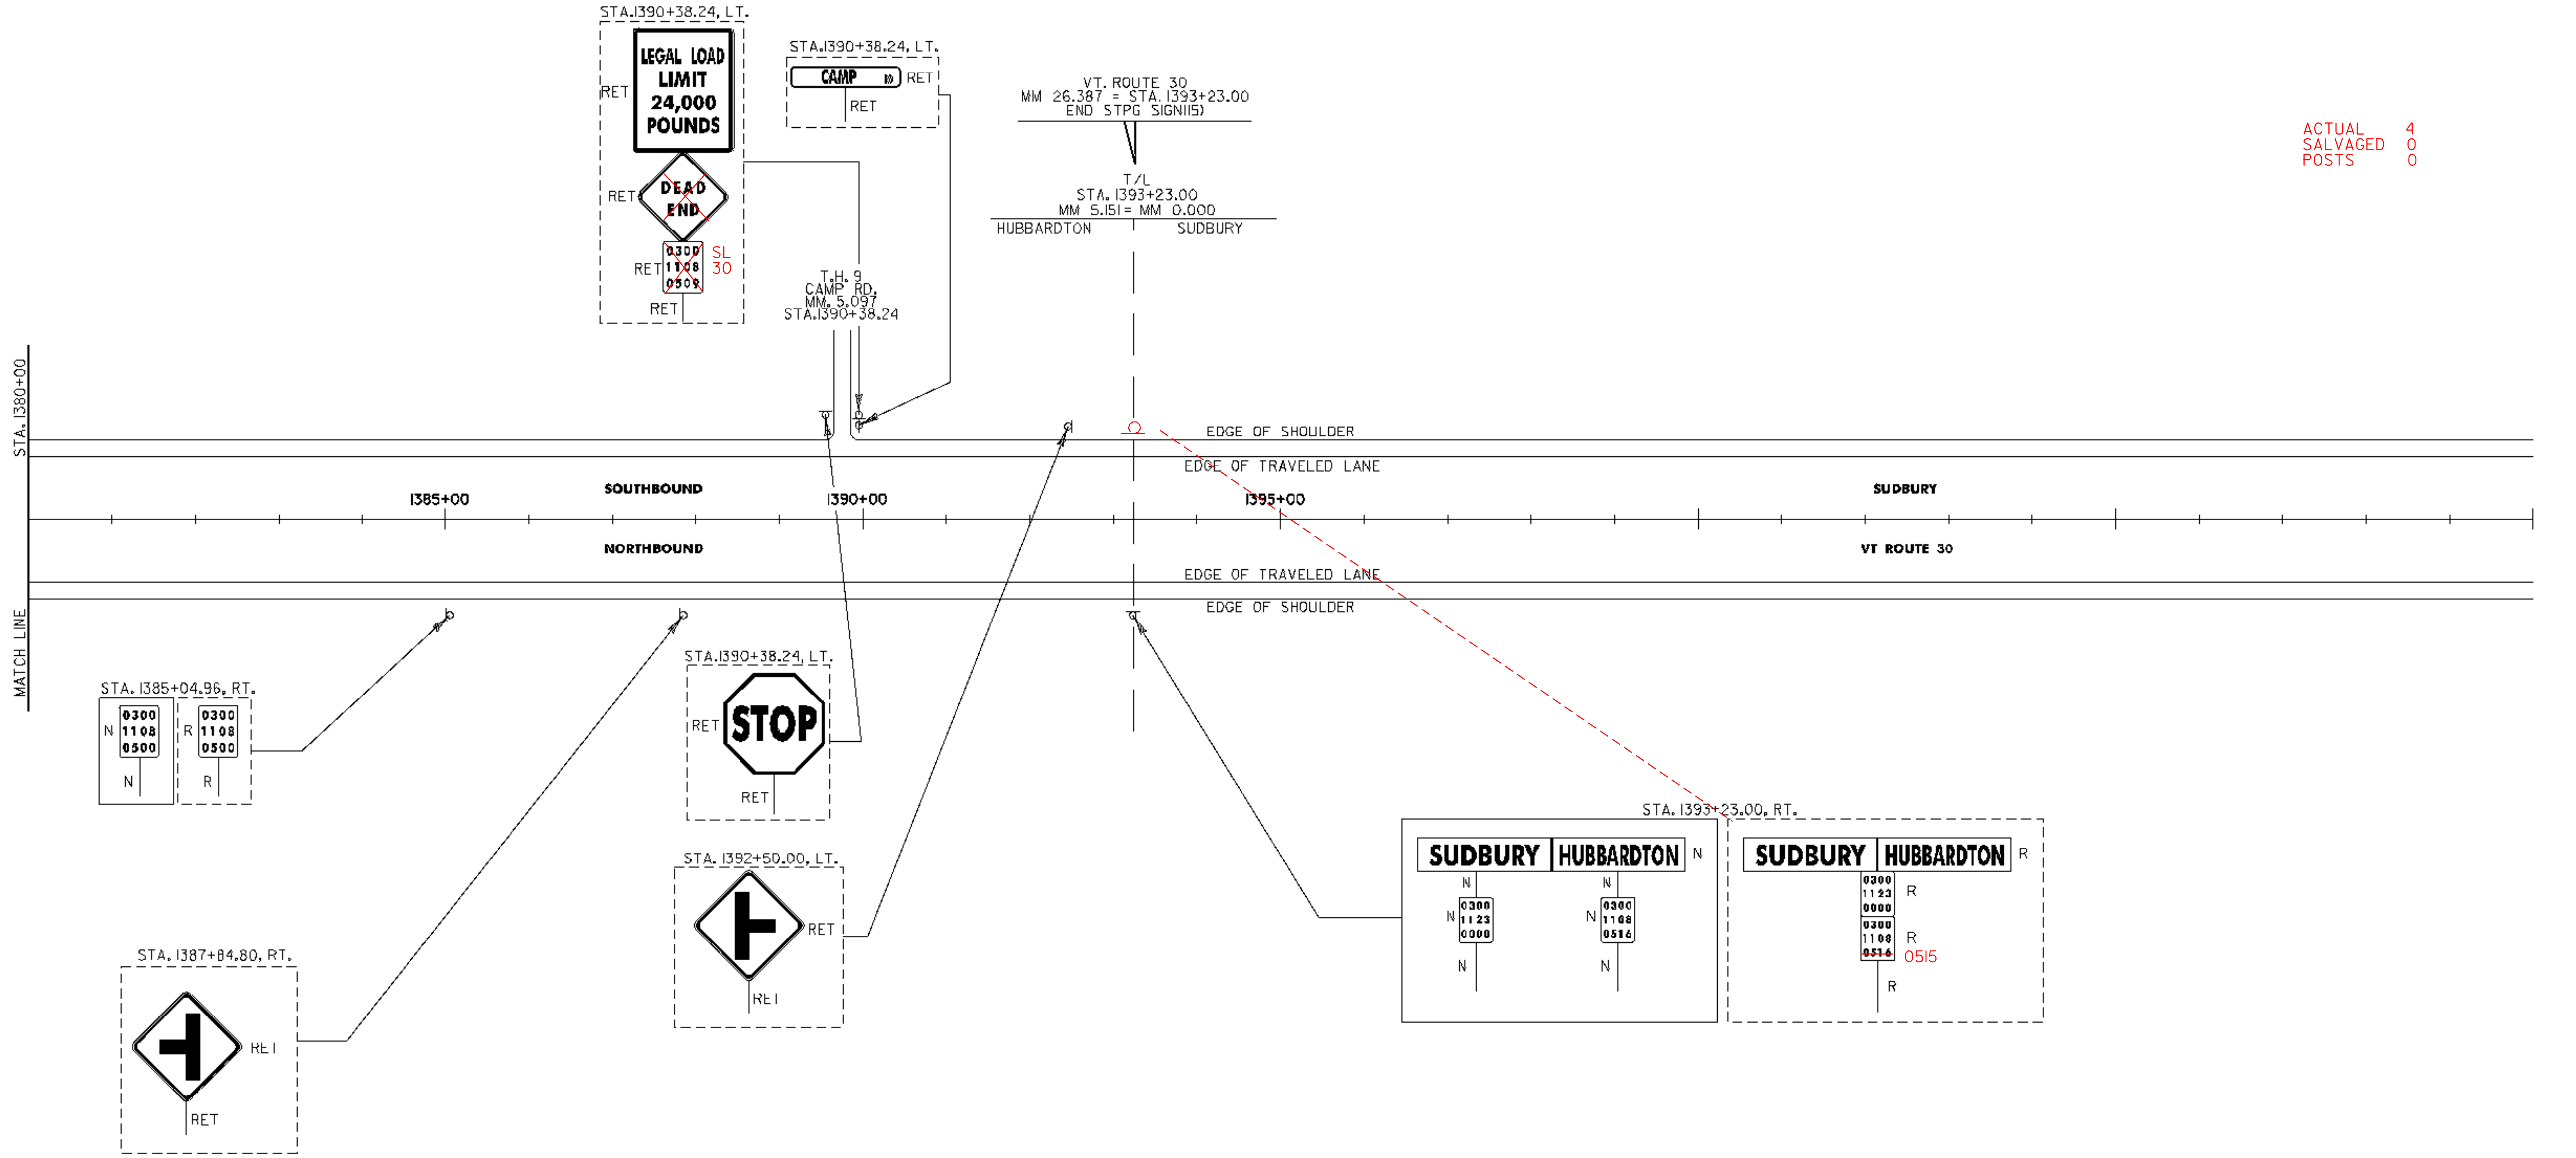

1380+00 - 1390+54

SIGN LEGEND
 R= REMOVE
 S= SALVAGE
 N= NEW
 RET= RETAIN
 B-B= BACK TO BACK
 EXISTING= - - - -
 NEW= _____

PROJECT NAME: WELLS-HUBBARDTON
 PROJECT NUMBER: STPG SIGN (15)
 FILE NAME: stpg sign15 plans.dgn
 PROJECT LEADER: N. AVERY
 DESIGNED BY: N. AVERY
 SIGNING PLAN #27
 PLOT DATE: 04-AUG-2008
 DRAWN BY: ROADWAY
 CHECKED BY: A. GAMBLE
 SHEET 30 OF 75