


INDEX OF SHEETS
(SEE SHEET 2)

STATE OF VERMONT AGENCY OF TRANSPORTATION



PROPOSED IMPROVEMENT TOWN OF CHESTER COUNTY OF WINDSOR VT 103 - PRINCIPAL ARTERIAL

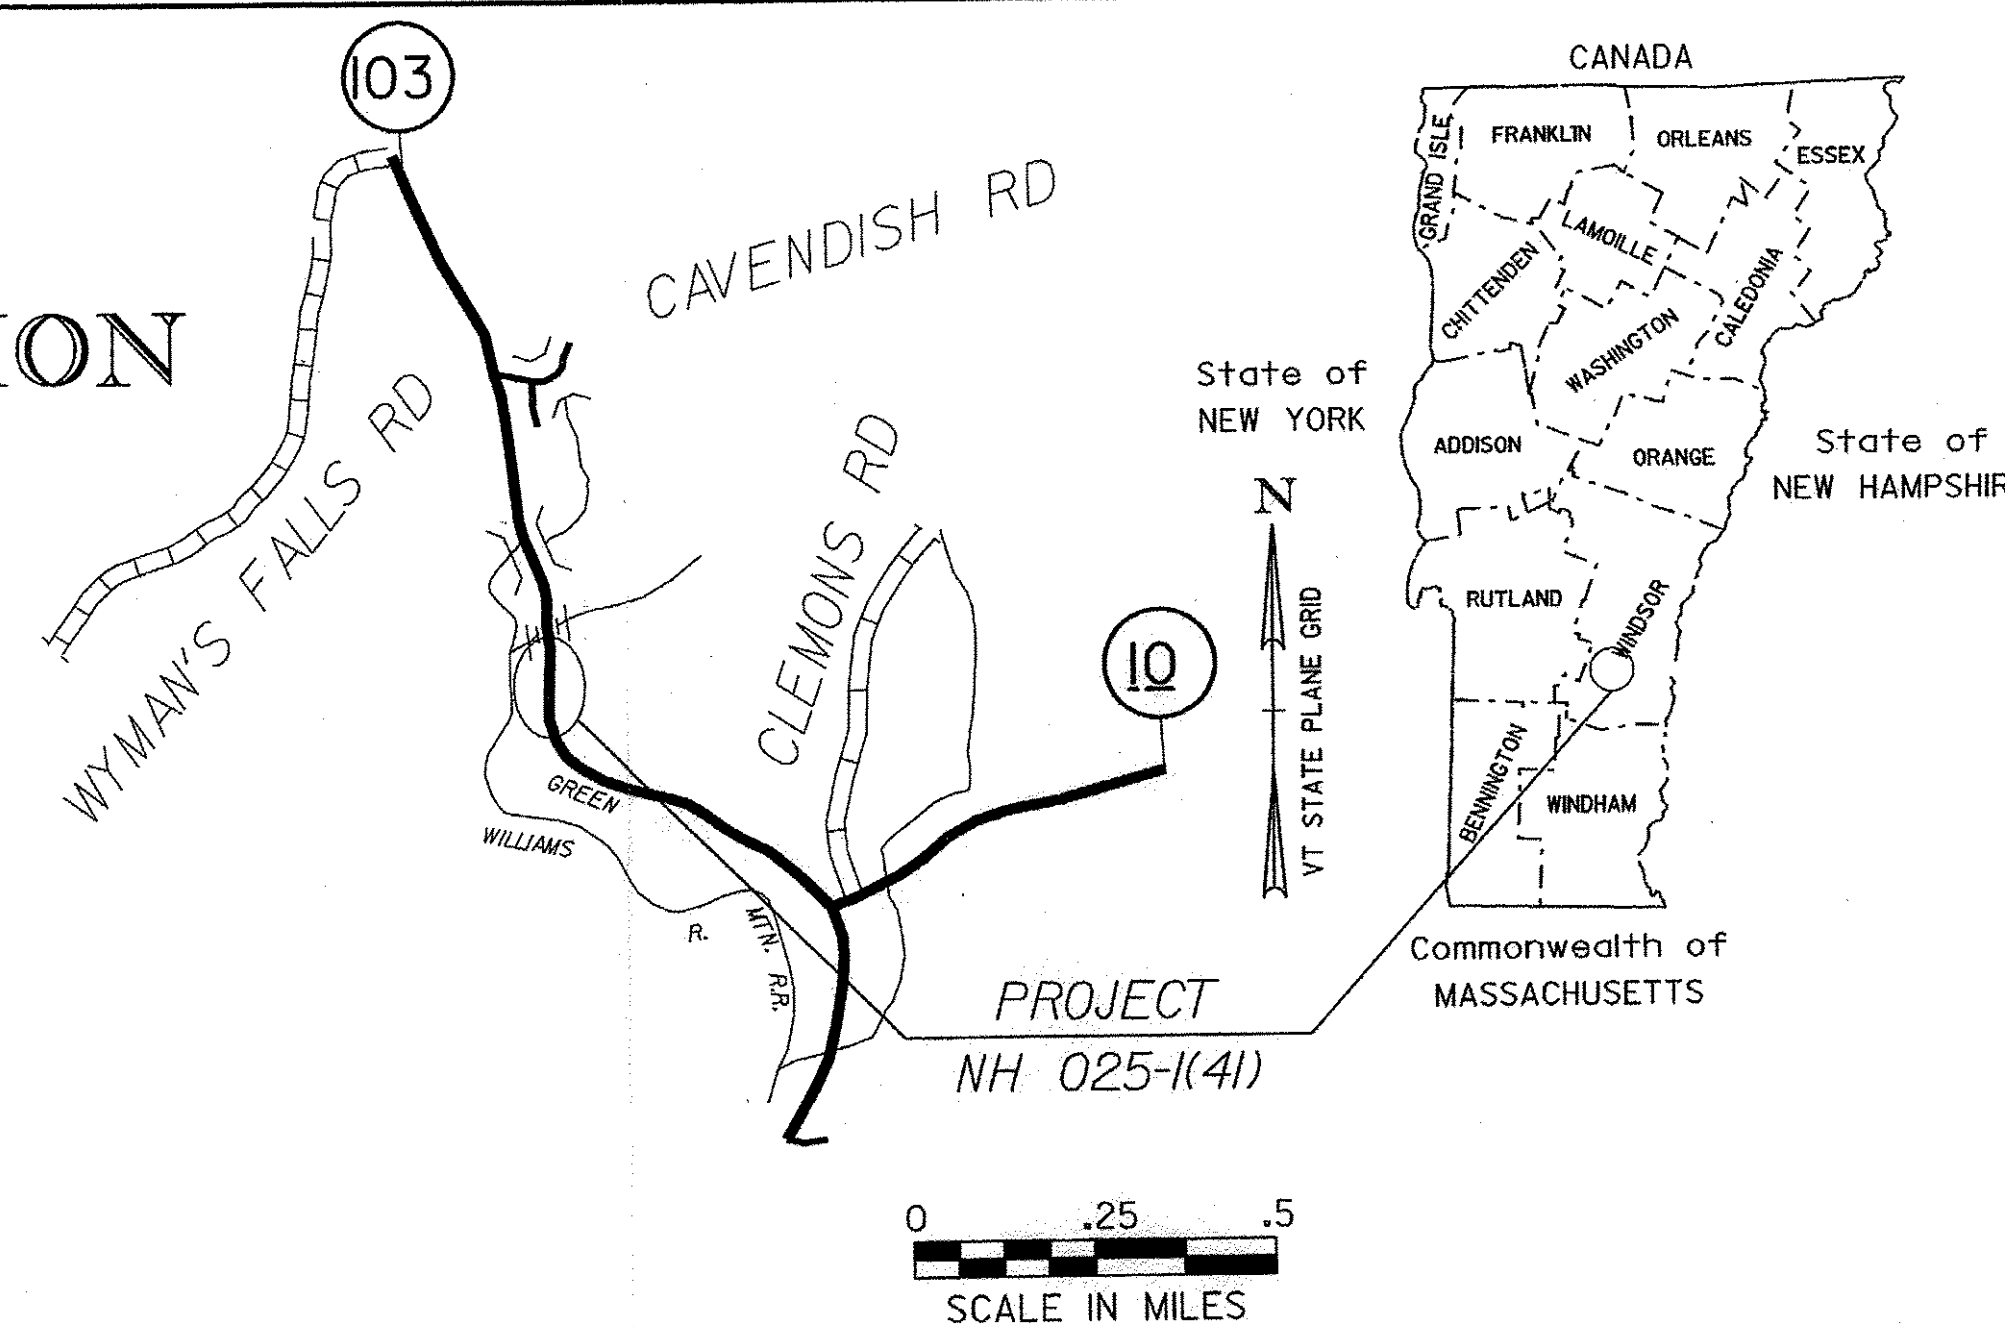

RECORD PLANS	
CONTRACTOR:	MORRILL CONSTRUCTION INC.- NORTH HAVERHILL, NH
RESIDENT ENGINEER:	DAN BREER
CONSTRUCTION BEGAN:	MARCH 25, 2010
CONSTRUCTION COMPLETE:	AUGUST 10, 2010
RECORD PLANS BY:	DAN BREER & NICK GARBACIK
I HEREBY CERTIFY THAT ALL THE CONSTRUCTION REQUIRED BY THIS SET OF DRAWINGS HAS BEEN ACCOMPLISHED AS INDICATED HEREIN.	
BY:	<i>D. Breer</i> RESIDENT ENGINEER
DATE:	7/1/13
NOTE: Any further information concerning final quantities, amounts or other details relative to this project may be found at Central Files in the electronic archives.	

PROJECT LOCATION: BEGINNING AT MM 8.114 AND EXTENDING NORTHERLY 0.246 MILES TO MM 8.360


PROJECT DESCRIPTION: WORK TO BE PERFORMED UNDER THIS PROJECT INCLUDES SCALING, ROCK DOWELING, TRIM BLASTING, ROCK DRAINS, TRAFFIC CONTROL AND OTHER RELATED ITEMS.

LENGTH OF ROADWAY: 1,300 FT 0.246 MILES

LENGTH OF PROJECT: 1,300 FT 0.246 MILES

STATION 13+00
END PROJECT
NH 025-(41)

VT 103
TO
CAVENDISH

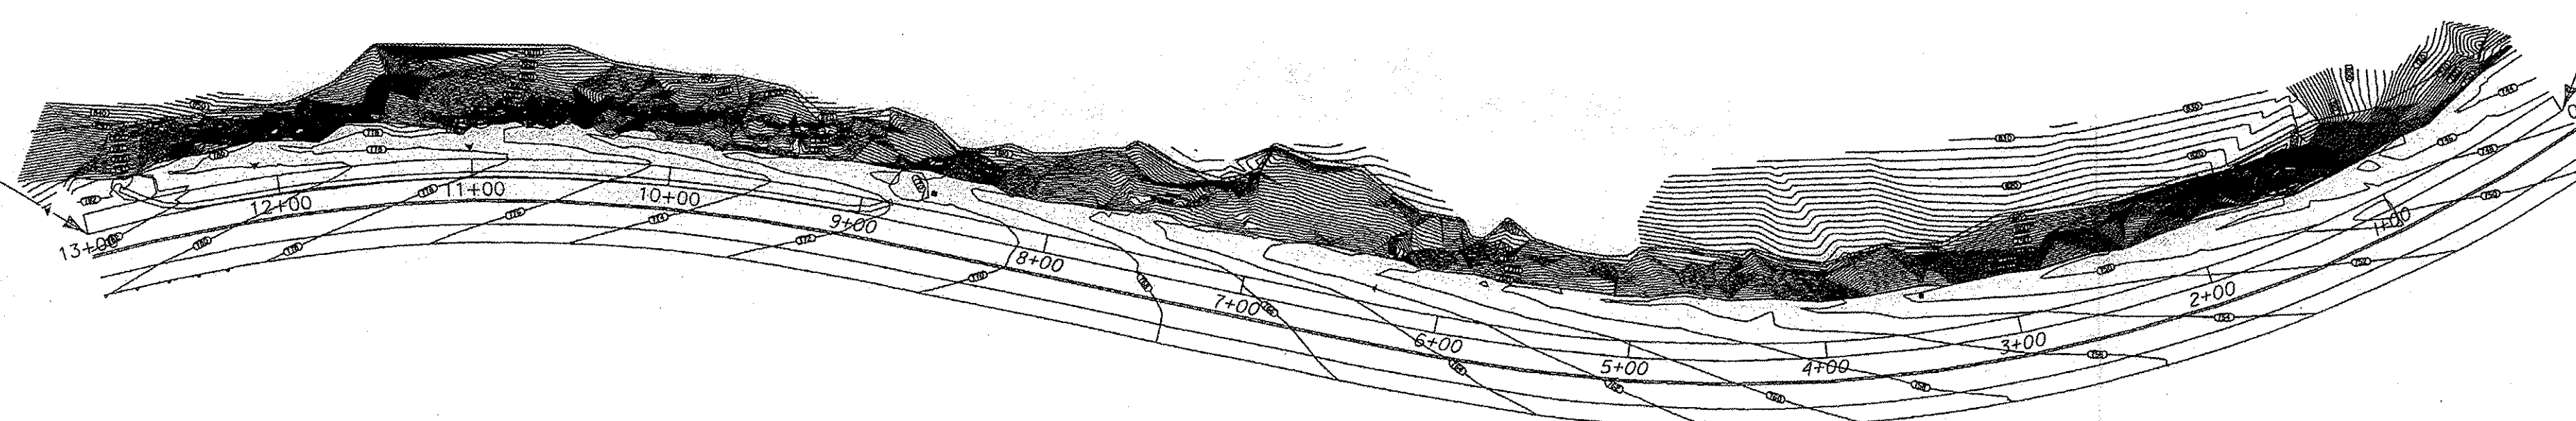

STATION 0+00
BEGIN PROJECT
NH 025-(41)

VT 103
TO ROCKINGHAM

CONVENTIONAL SYMBOLS

COUNTY LINE	
TOWN LINE	
LIMITS OF ACCESS	
POINT OF ACCESS	
FENCE LINE	
STONE WALL	
TRAVELED WAY	
GUARD RAIL	
RAILROAD	
SURVEY LINE	
CULVERT	
POWER POLE	
TELEPHONE POLE	
TREES	
CONTROL OF ACCESS	
PROPERTY LINE	
R.O.W. TAKING LINE	
SLOPE RIGHTS	
TOP OF CUT	
TOE OF SLOPE	

SURVEYED BY : CLD
SURVEYED DATE : 8-2008

DATUM
VERTICAL NAVD88
HORIZONTAL NAD83/92



0 100 200
SCALE IN FEET

THESE PLANS ARE SUBJECT TO SUCH ENGINEERING CHANGES AS MAY BE REQUIRED BY THE FEDERAL HIGHWAY ADMINISTRATION OR THE DIRECTOR OF PROGRAM DEVELOPMENT.

CONSTRUCTION IS TO BE CARRIED ON IN ACCORDANCE WITH THESE PLANS AND THE STANDARD SPECIFICATIONS FOR CONSTRUCTION DATED 2006, AS APPROVED BY THE FEDERAL HIGHWAY ADMINISTRATION ON JUNE 15, 2006 FOR USE ON THIS PROJECT, INCLUDING ALL SUBSEQUENT REVISIONS AND SUCH REVISED SPECIFICATIONS AND SPECIAL PROVISIONS AS ARE INCORPORATED IN THESE PLANS.

DIRECTOR OF PROGRAM DEVELOPMENT
APPROVED *Richard Phelan* DATE 11/13/09

PROJECT MANAGER : KEN ROBBIE

PROJECT NAME : CHESTER
PROJECT NUMBER : NH 025-1 (41)

SHEET 1 OF 16 SHEETS