



STA. 4+50




STA. 3+50

1 = 20'
2 = 15'
3 = 10'




STA. 2+50

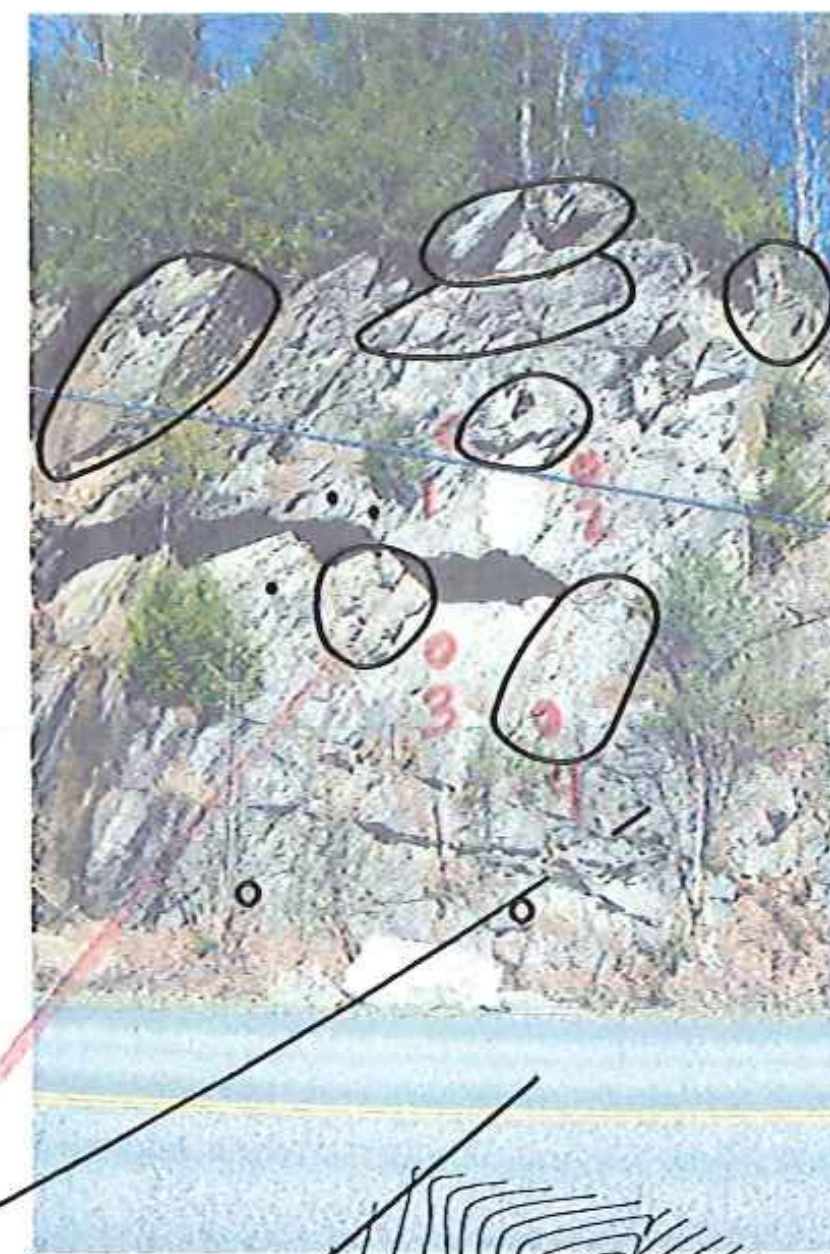

1 = 15'
2 = 15'
3 = 10'
4 = 10'

STA. 1+50

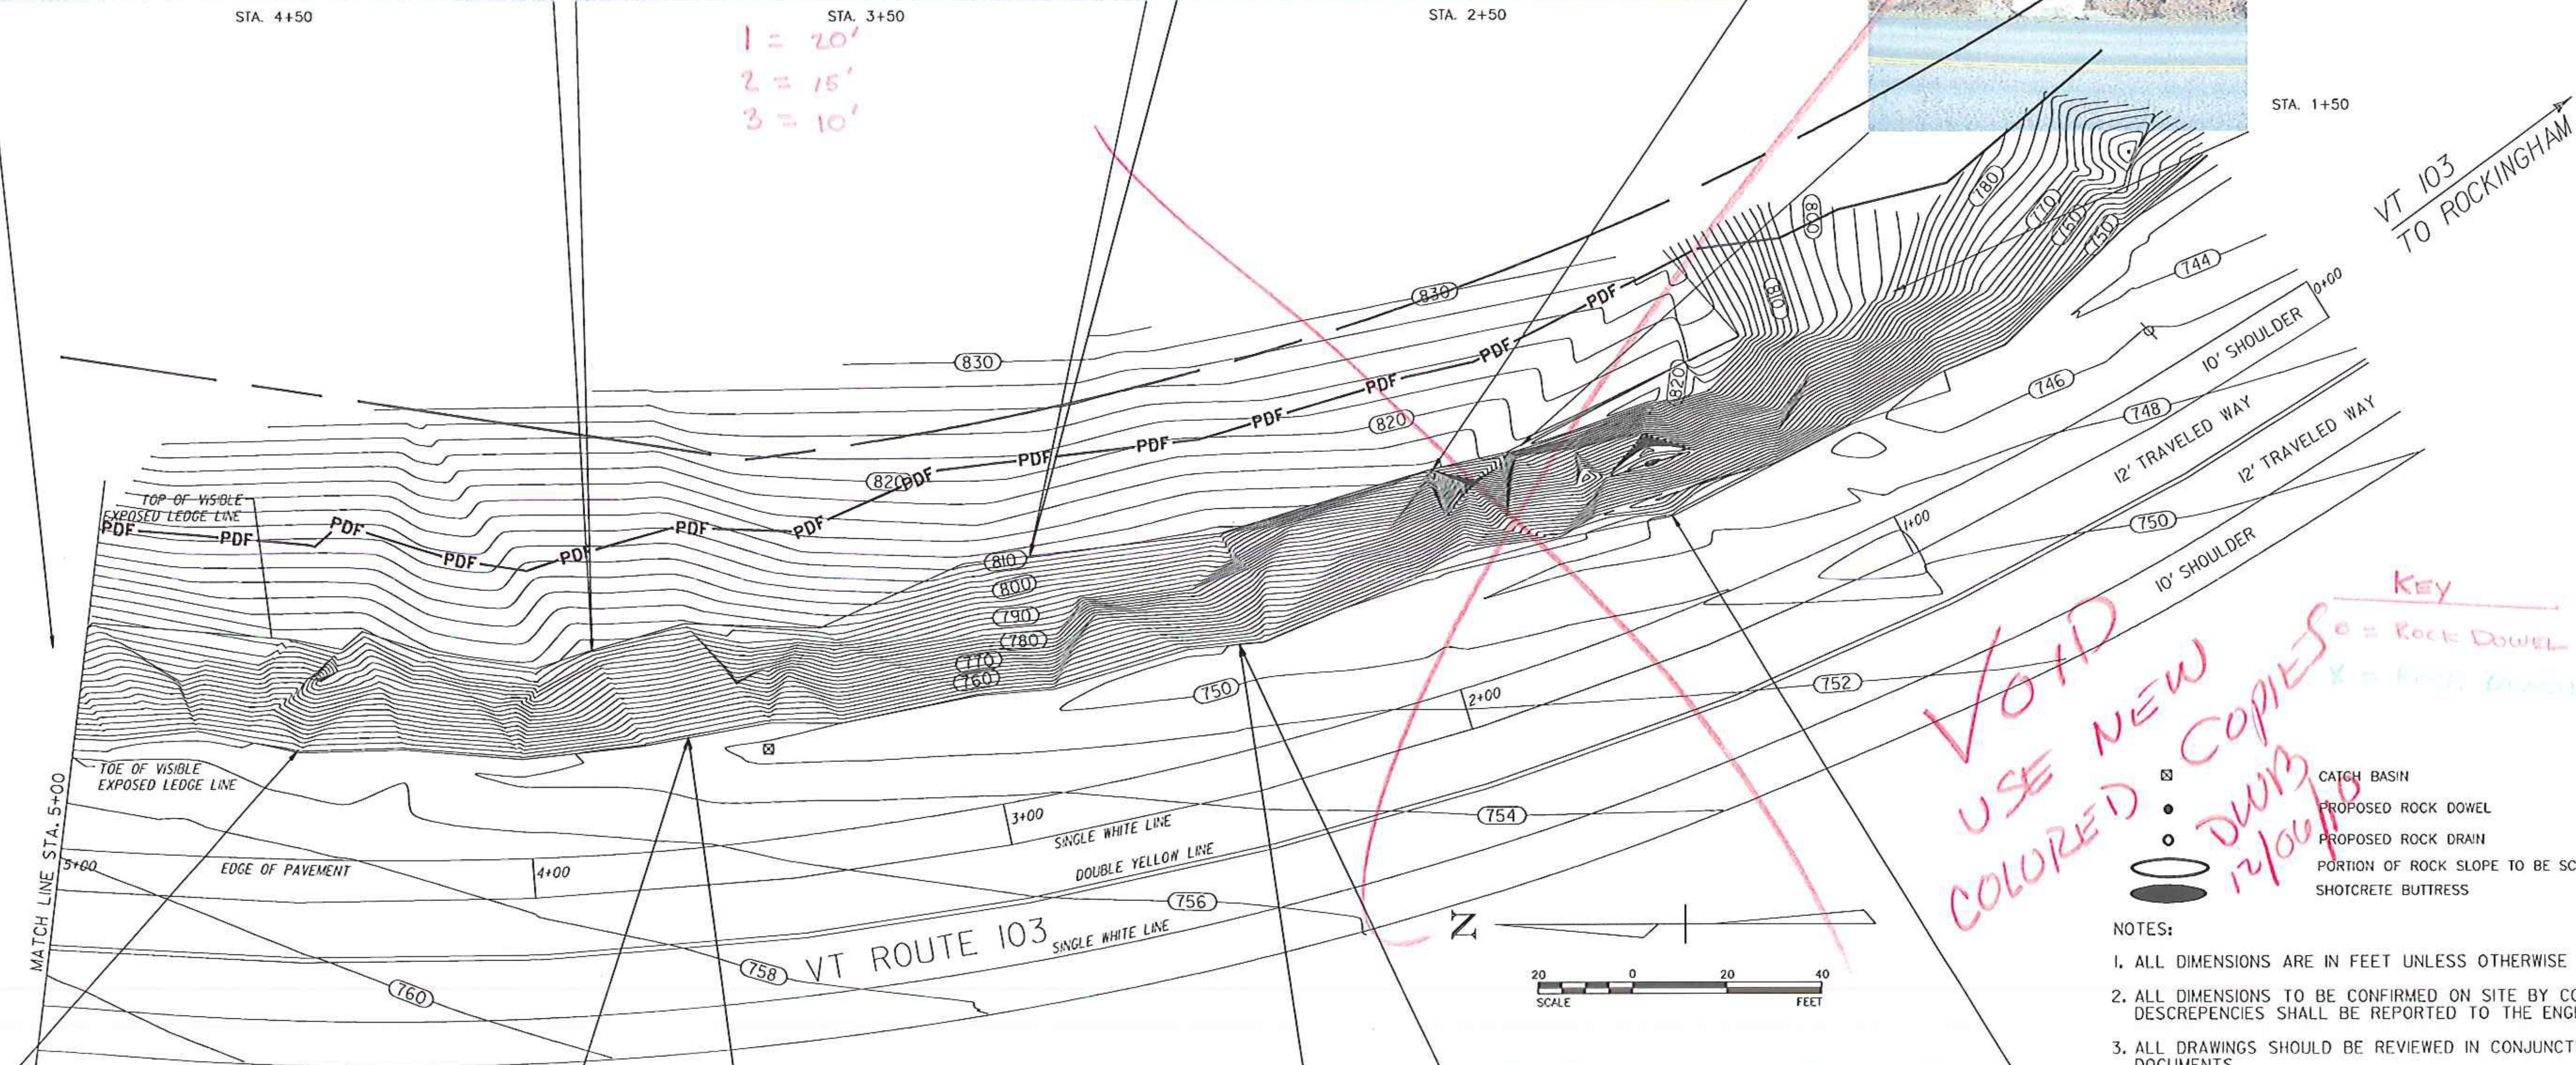


VT 103
TO ROCKINGHAM

VOID
USE NEW COLORED COPIES
12/10/09

Key
o = Rock Dowel
PDF = Prop. Drain
CB = Catch Basin

- NOTES:
- ALL DIMENSIONS ARE IN FEET UNLESS OTHERWISE NOTED.
 - ALL DIMENSIONS TO BE CONFIRMED ON SITE BY CONTRACTOR. ALL DISCREPANCIES SHALL BE REPORTED TO THE ENGINEER IMMEDIATELY.
 - ALL DRAWINGS SHOULD BE REVIEWED IN CONJUNCTION WITH CONTRACT DOCUMENTS.
 - ALL WORK TO BE PERFORMED IN ACCORDANCE WITH CONTRACT DOCUMENTS.
 - CONTRACTOR SHALL IDENTIFY ALL UNDERGROUND UTILITIES, USING DIGSAFE, PRIOR TO DRILLING OR OTHER SUBSURFACE ACTIVITIES.
 - FINAL LOCATIONS OF ROCK DOWELS SHALL BE DETERMINED BY THE VTRANS GEOLOGIST AFTER SCALING.
 - DURING INSTALLATION, VTRANS GEOLOGIST MAY IDENTIFY ADDITIONAL STABILIZATION LOCATIONS NOT ON THIS DRAWING.
 - DIGITAL PHOTOGRAPHS TAKEN APRIL 16, 2008

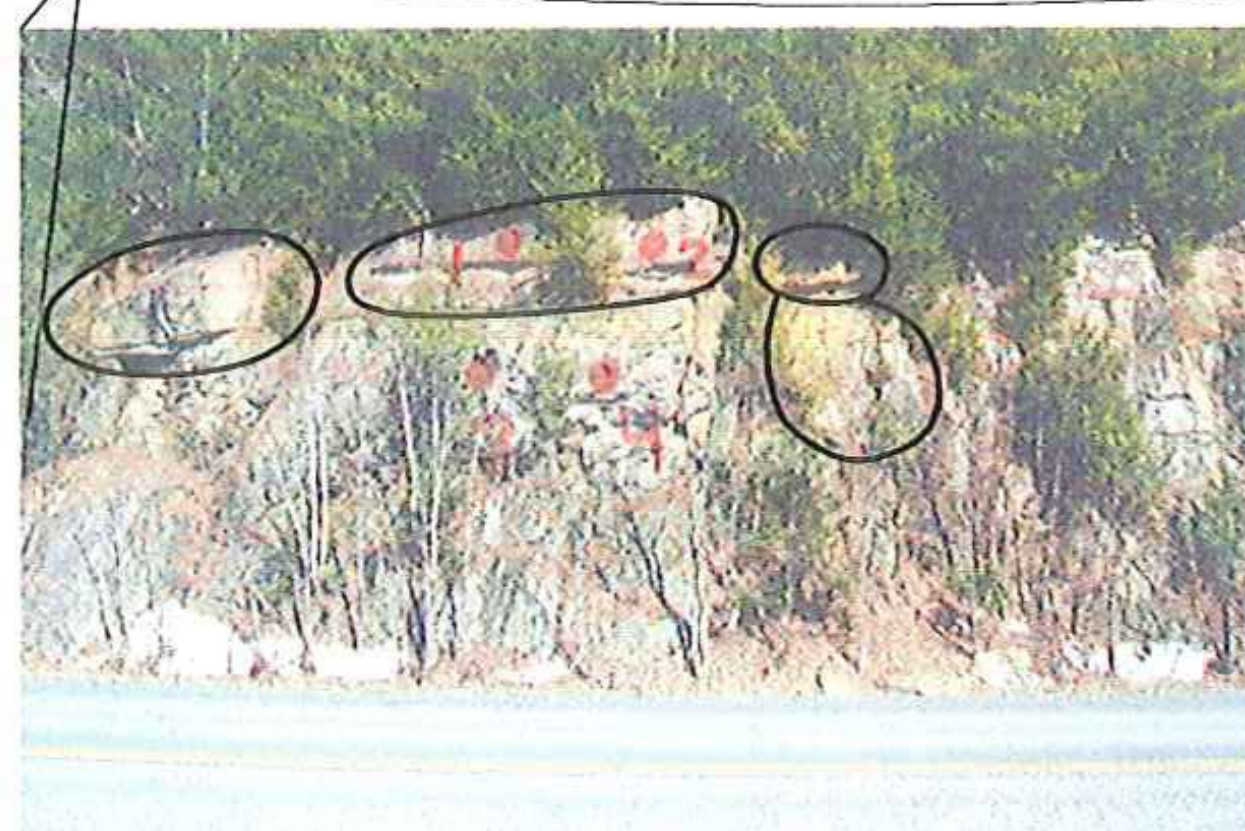


STA. 4+00



STA. 3+00

1 = 15'
2 = 15'
3 = 15'
4 = 15'

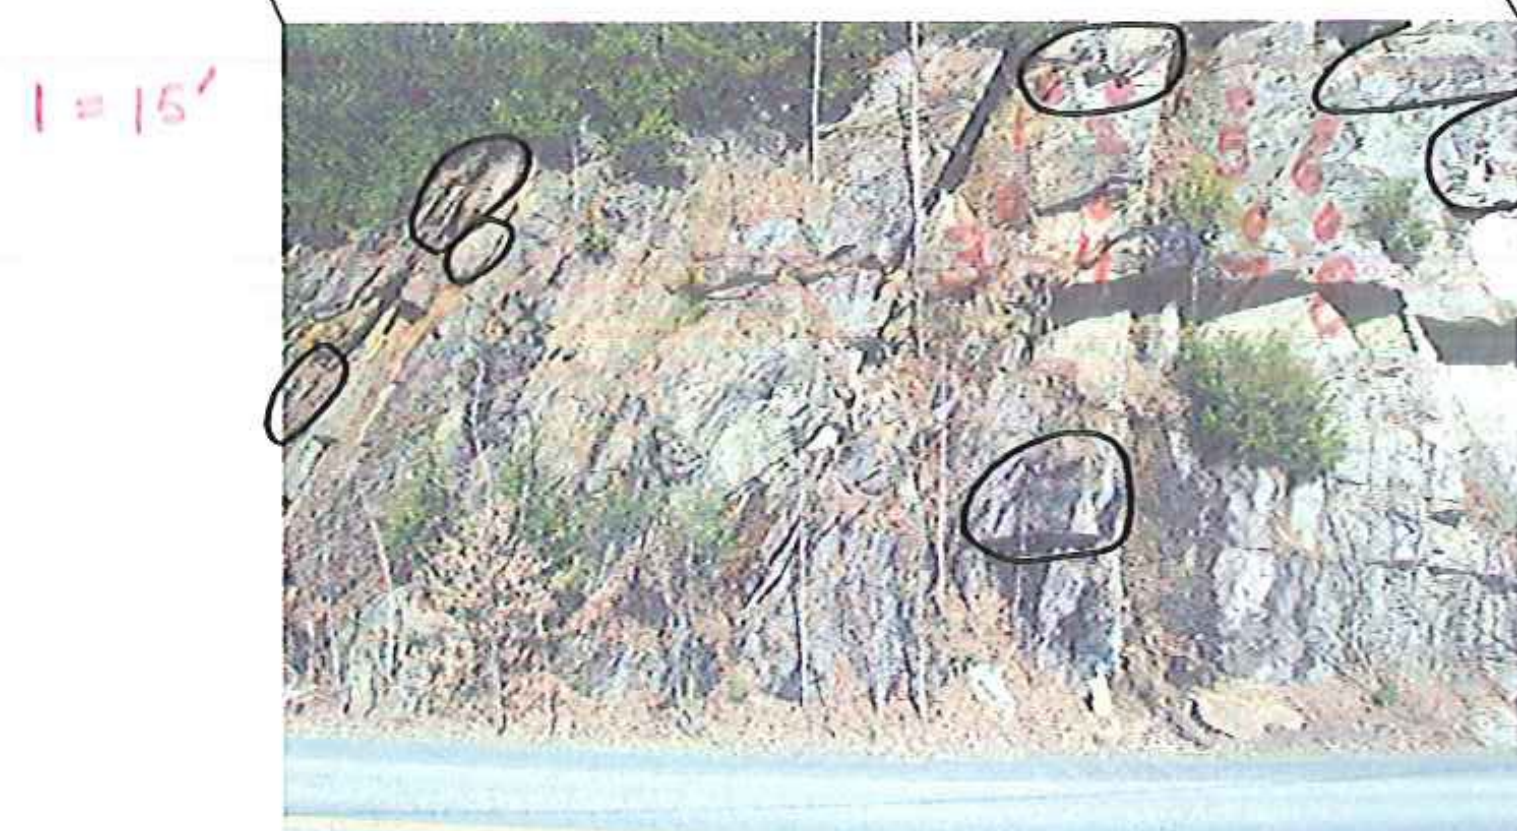

STA. 2+00

1 = 15'

1 = 20'
2 = 20'
3 = 20'
4 = 20'
5 = 20'
6 = 20'
7 = 20'
8 = 20'

PROJECT NAME:	CHESTER	PLOT DATE:	23-NOV-2009
PROJECT NUMBER:	NH 025-(41)	DRAWN BY:	P. PELOQUIN
FILE NAME:	d08b036nu1.dgn	CHECKED BY:	S. MENARD
PROJECT LEADER:	K. ROBIE	LAYOUT SHEET 1	SHEET 8 OF 16
DESIGNED BY:	P. PELOQUIN		