


TEMPORARY EROSION MATTING
 STA. 0+00 RT TO STA. 6+00 RT (CREST OF LEDGE)
 STA. 0+00 RT TO STA. 6+00 RT (DITCH)


PROJECT DEMARCATION FENCE
 STA. 0+00 RT TO STA. 6+00 RT

TEMPORARY STONE CHECK DAM, TYPE I
 STA. 3+50 RT TO STA. 6+00 RT (33 CHECK DAMS)

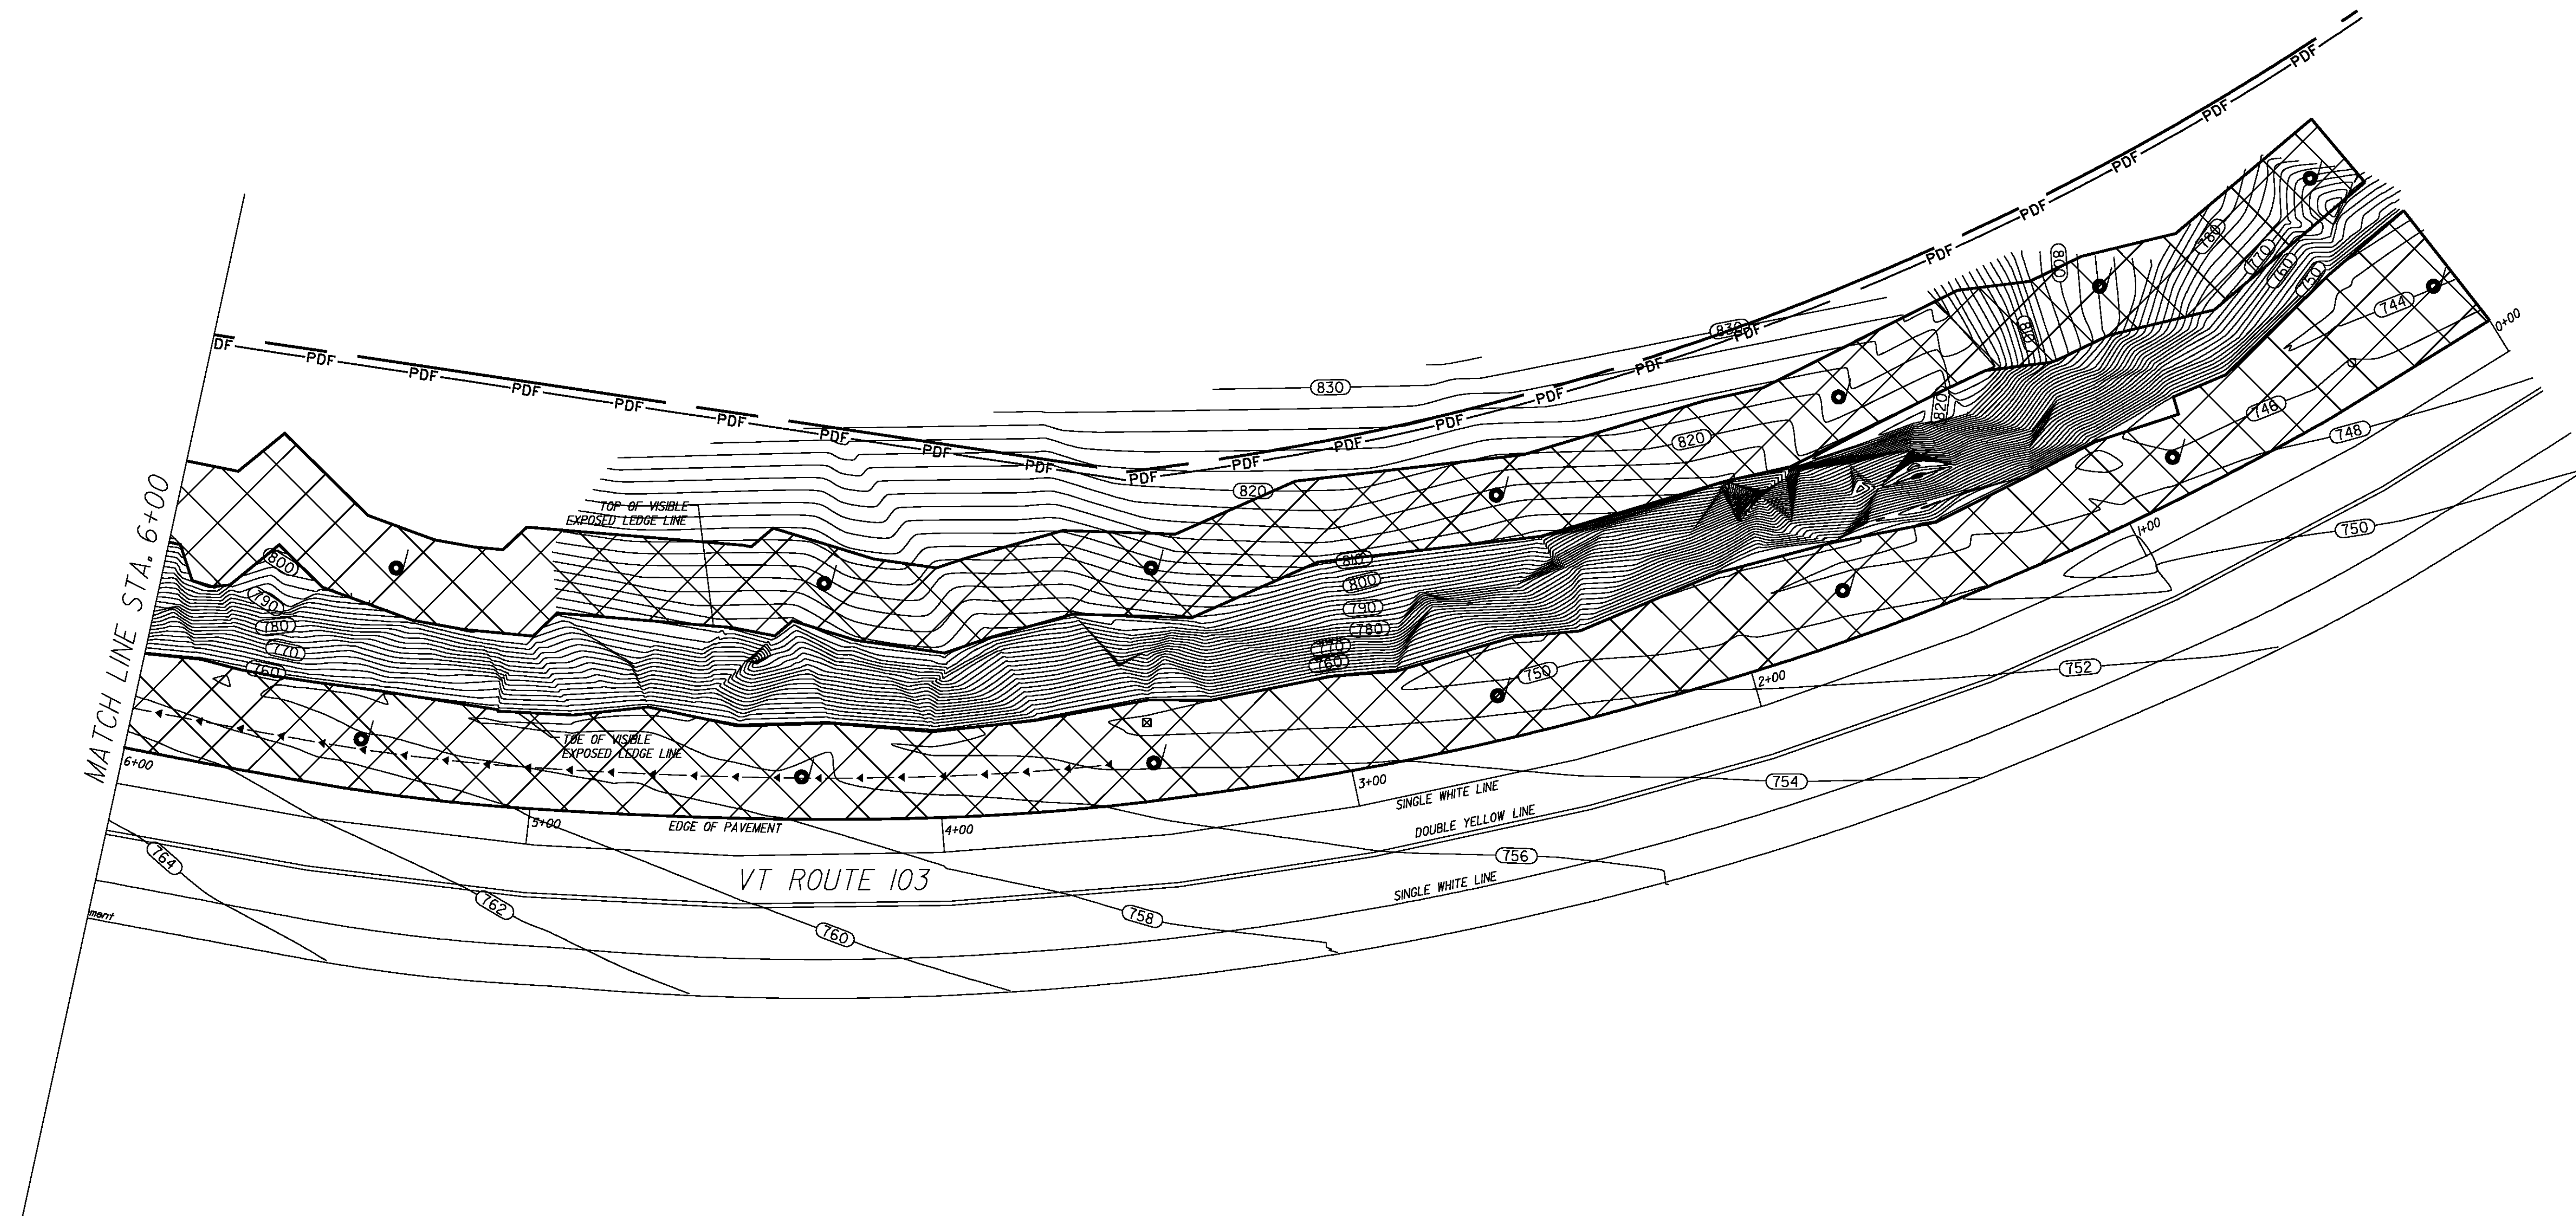

LEGEND

- ▶▶▶▶▶ CHECK DAMS
- EROSION MATTING/LIMITS OF DISTURBANCE
- PROJECT DEMARCATION FENCE
- INLET PROTECTION

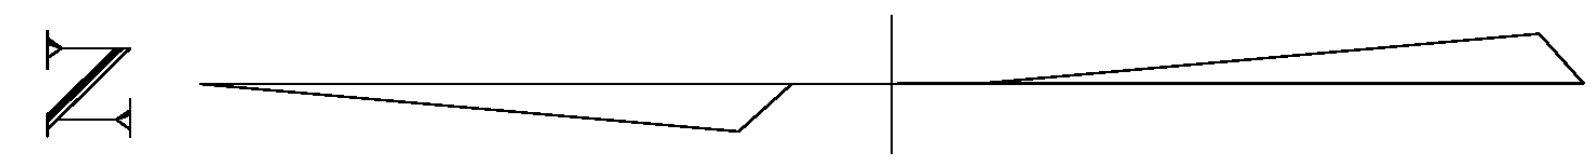

PROJECT NAME:	CHESTER	PLOT DATE:	23-NOV-2009
PROJECT NUMBER:	NH 025-I(41)	DRAWN BY:	P. PELOQUIN
FILE NAME:	d08b036bdr.dgn	CHECKED BY:	S. MENARD
PROJECT LEADER:	K. ROBIE	EPSC LAYOUT SHEET 2	SHEET 12 OF 16
DESIGNED BY:	P. PELOQUIN		