


SEE SHEET 2 FOR INDEX AND LIST OF STANDARDS

# STATE OF VERMONT AGENCY OF TRANSPORTATION



## PROPOSED IMPROVEMENT BRIDGE PROJECT

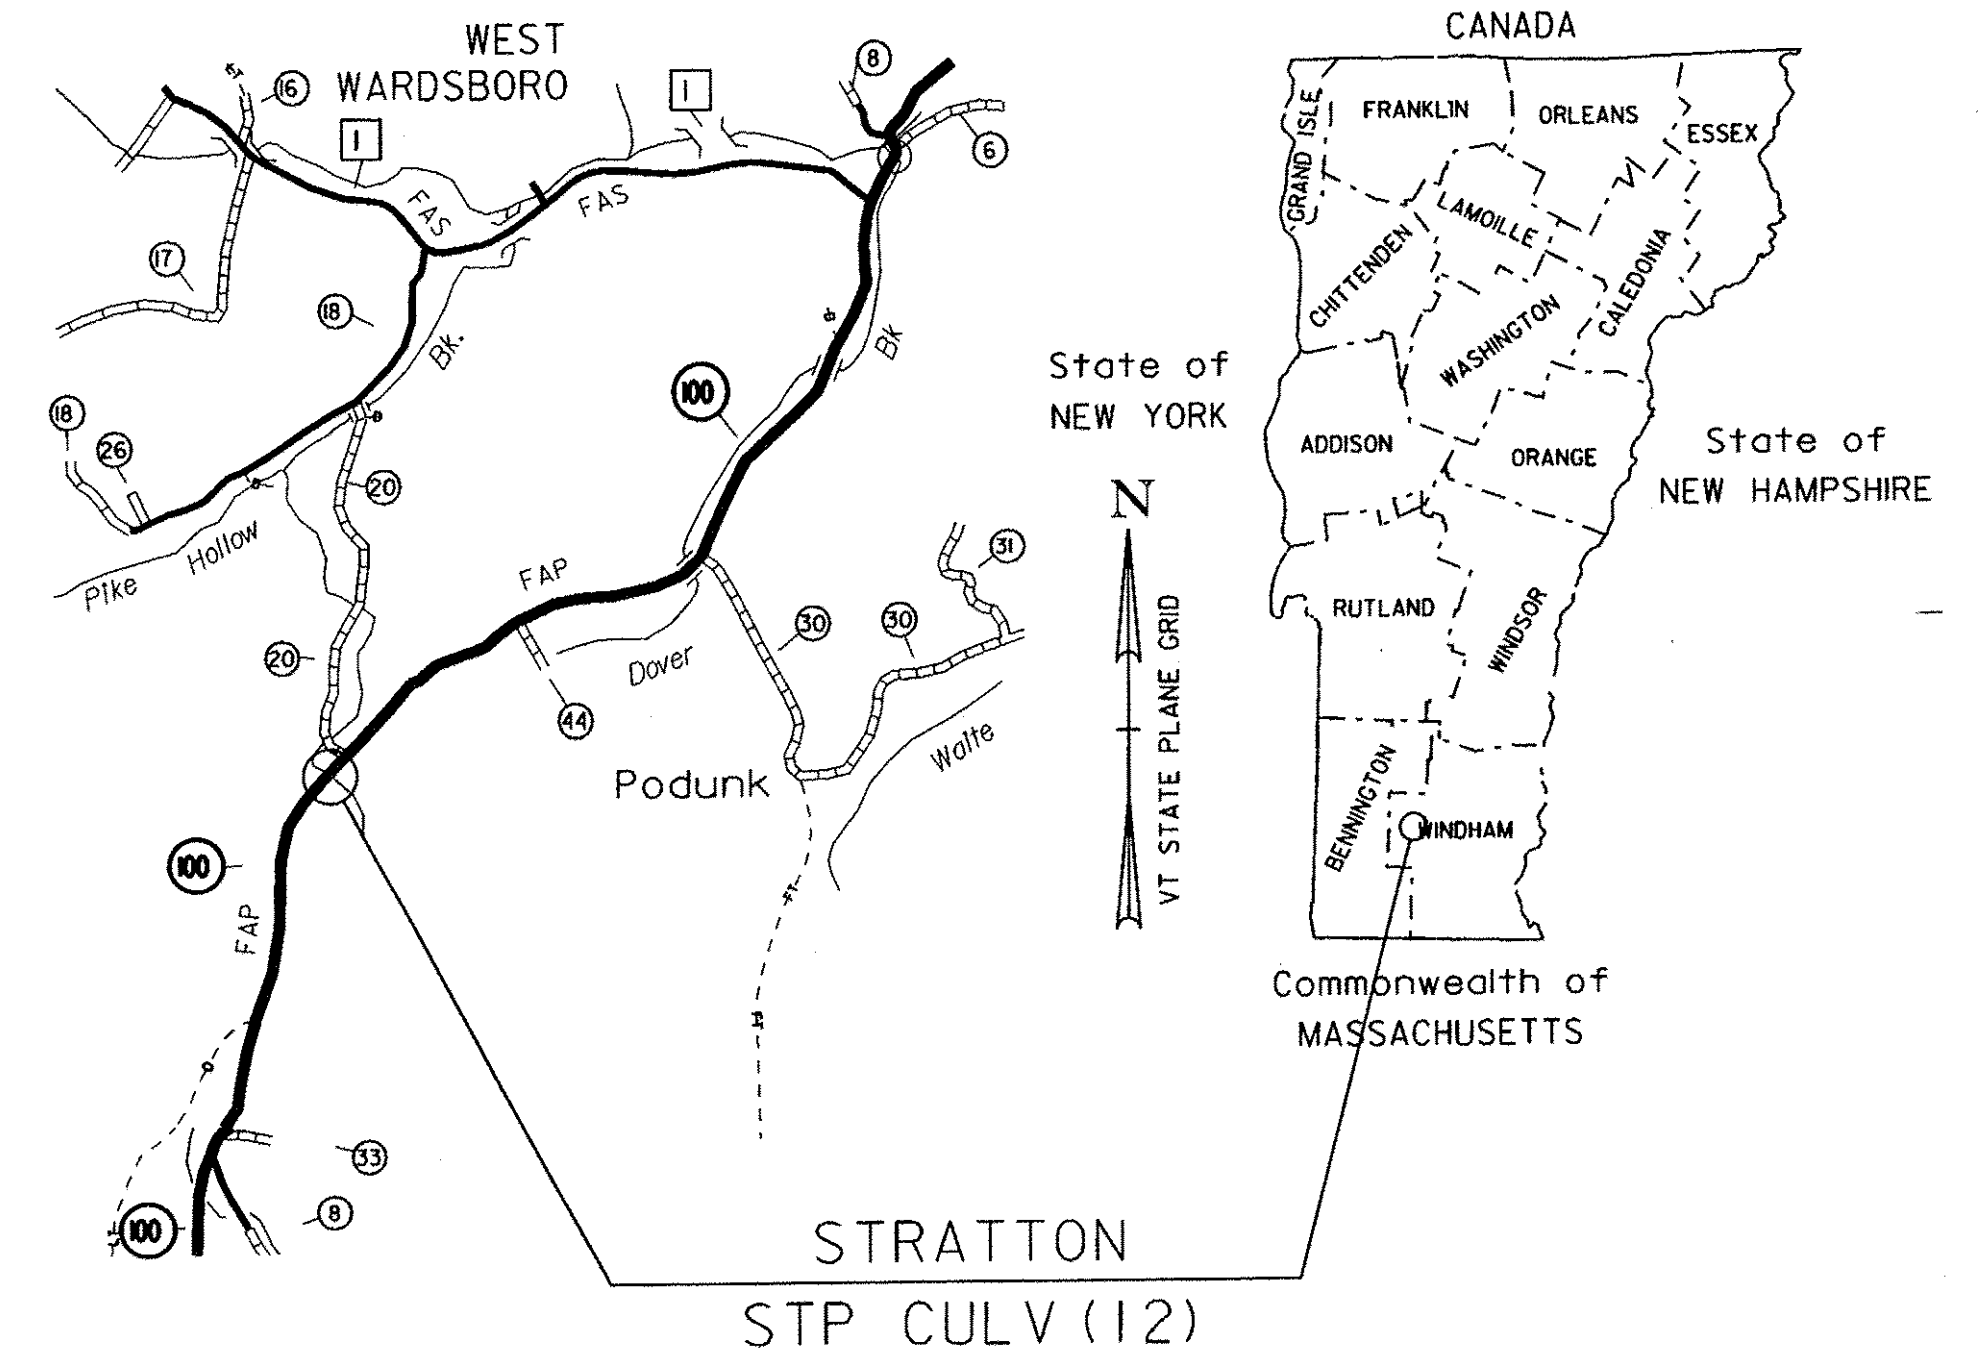

RECORD PLANS	
CONTRACTOR:	ALPINE CONSTRUCTION, LLC- SCHUYLERVILLE, NY
RESIDENT ENGINEER:	MARK HAUGHWOUT
CONSTRUCTION BEGAN:	SEPTEMBER 1, 2010
CONSTRUCTION COMPLETE:	JULY 19, 2011
RECORD PLANS BY:	MARK HAUGHWOUT & C. PIERCE
I HEREBY CERTIFY THAT ALL THE CONSTRUCTION REQUIRED BY THIS SET OF DRAWINGS HAS BEEN ACCOMPLISHED AS INDICATED HEREIN.	
BY	<i>Mark W. Haughwout</i> RESIDENT ENGINEER
DATE	April 10, 2012
NOTE: Any further information concerning final quantities, amounts or other details relative to this project may be found at Central Files in the electronic archives.	


TOWN OF STRATTON  
COUNTY OF WINDHAM

ROUTE NO: VT 100, RURAL MINOR ARTERIAL BRIDGE NO: 64

PROJECT LOCATION : 11.5 MILES NORTH OF JUNCTION WITH VT ROUTE 9, MM 1.03

PROJECT DESCRIPTION: THE PROJECT SHALL CONSIST OF LINING THE EXISTING CULVERT,  
AND REPLACING THE EXISTING INLET HEADWALL.

LENGTH OF STRUCTURE: N/A  
LENGTH OF PROJECT: 100.00'

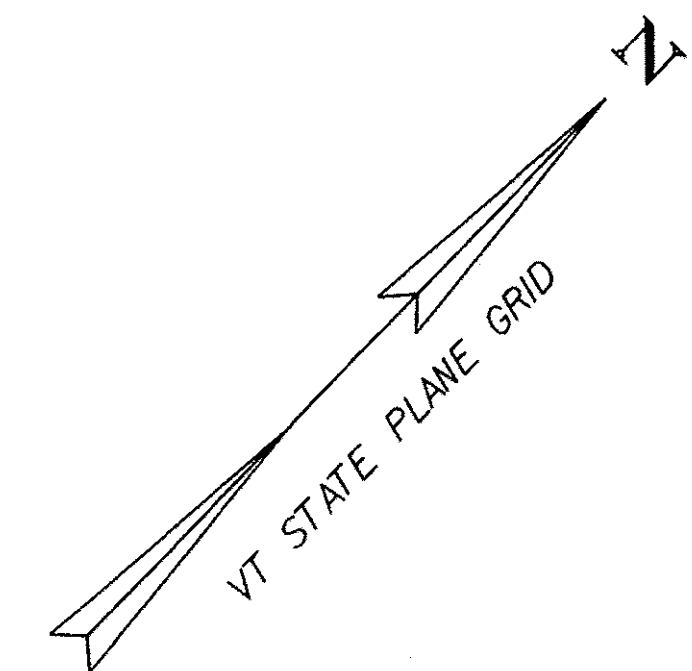


QUALITY ASSURANCE PROGRAM: LEVEL 2

CONVENTIONAL SYMBOLS	
COUNTY LINE	
TOWN LINE	
LIMITS OF ACCESS	
POINT OF ACCESS	
FENCE LINE	
STONE WALL	
TRAVELED WAY	
GUARD RAIL	
RAILROAD	
SURVEY LINE	
CULVERT	
POWER POLE	
TELEPHONE POLE	
TREES	
CONTROL OF ACCESS	
PROPERTY LINE	
R.O.W. TAKING LINE	
SLOPE RIGHTS	
TOP OF CUT	
TOE OF SLOPE	

SURVEYED BY : R. GILMAN  
SURVEYED DATE : 07-21-2008

DATUM  
VERTICAL NAVD88  
HORIZONTAL NAD 83 (2007)

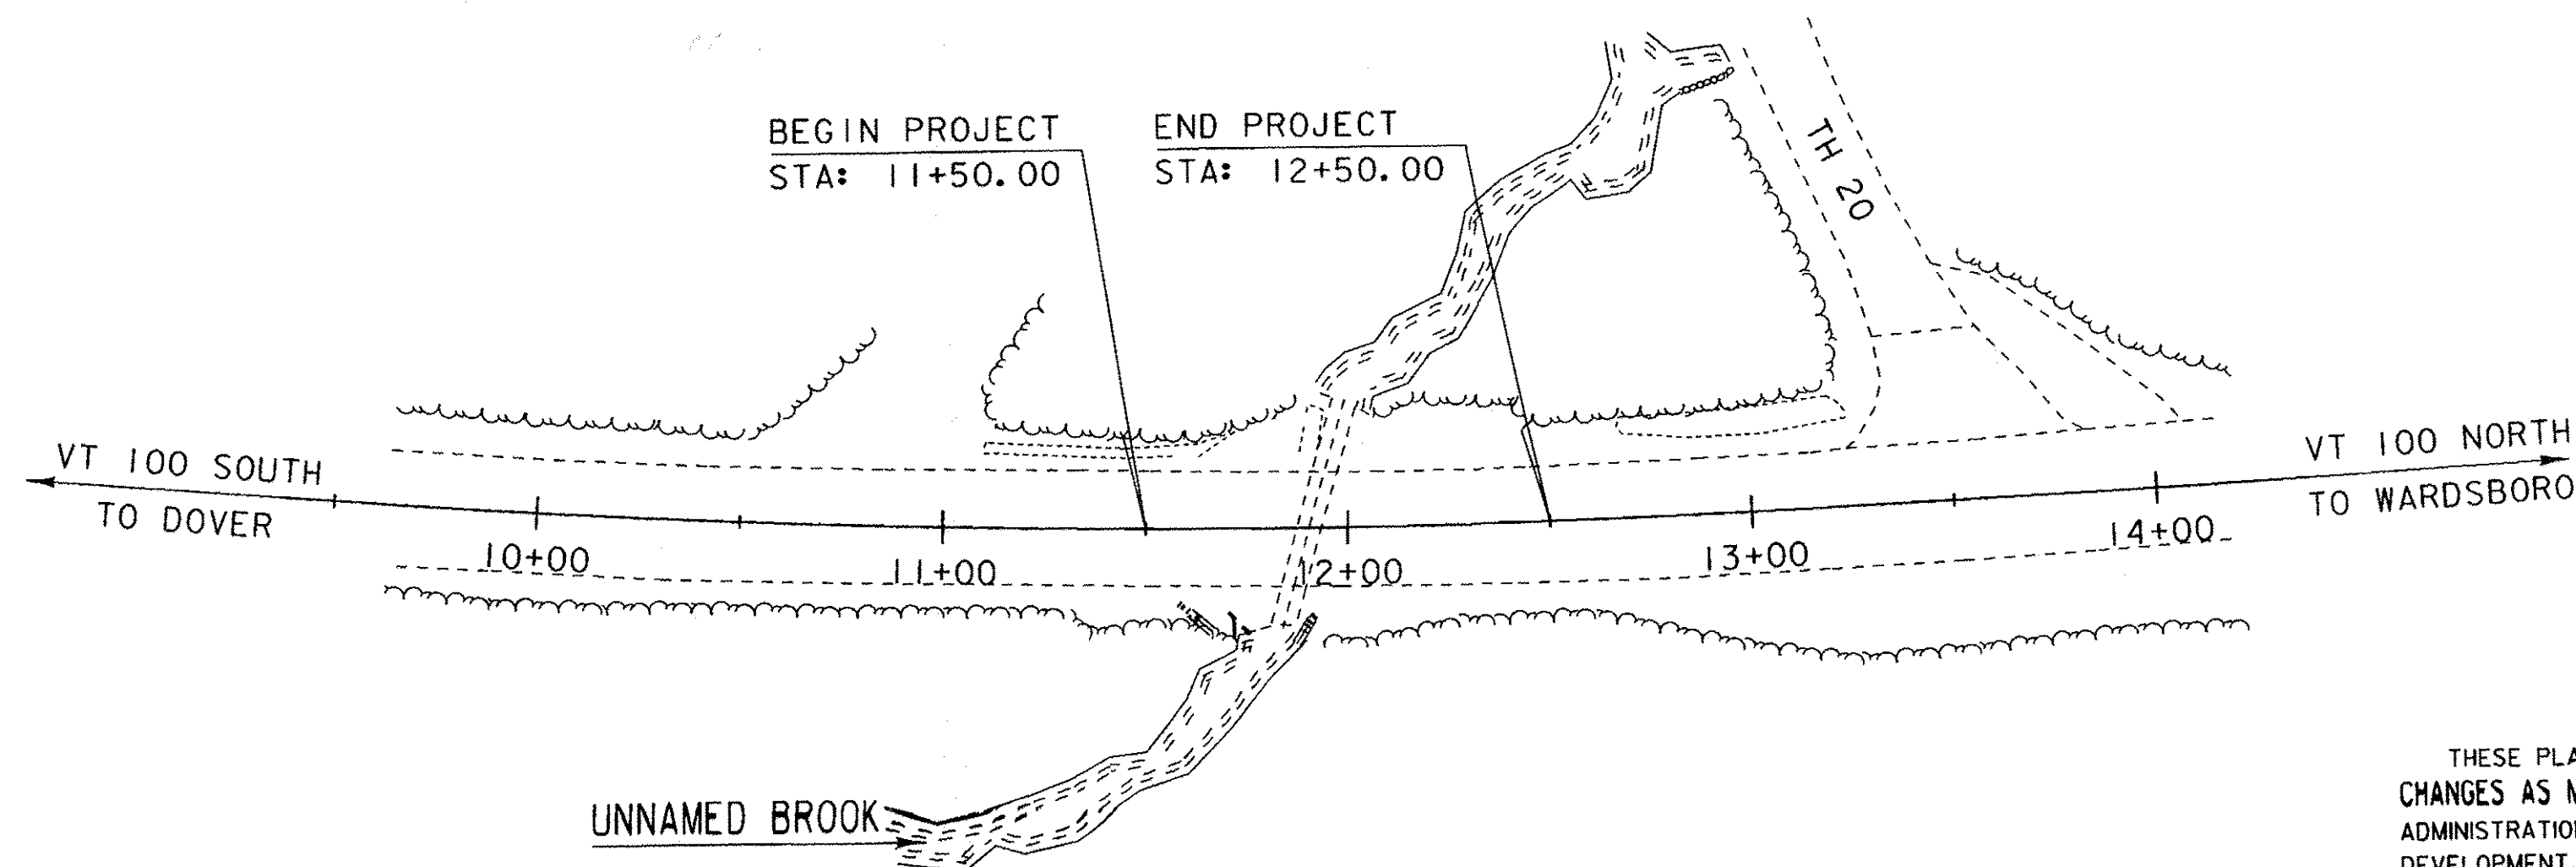

SCALE 1" = 40'-0"  
40 0 40

THESE PLANS ARE SUBJECT TO SUCH ENGINEERING CHANGES AS MAY BE REQUIRED BY THE FEDERAL HIGHWAY ADMINISTRATION OR THE DIRECTOR OF PROGRAM DEVELOPMENT.

CONSTRUCTION IS TO BE CARRIED ON IN ACCORDANCE WITH THESE PLANS AND THE STANDARD SPECIFICATIONS FOR CONSTRUCTION DATED 2006, AS APPROVED BY THE FEDERAL HIGHWAY ADMINISTRATION ON JUNE 15, 2006 FOR USE ON THIS PROJECT, INCLUDING ALL SUBSEQUENT REVISIONS AND SUCH REVISED SPECIFICATIONS AND SPECIAL PROVISIONS AS ARE INCORPORATED IN THESE PLANS.

DIRECTOR OF PROGRAM DEVELOPMENT	APPROVED <i>Richard Johnson</i> DATE 6-1-10
PROJECT MANAGER : C.P. WILLIAMS	
PROJECT NAME : STRATTON	
PROJECT NUMBER : STP CULV (12)	
SHEET 1 OF 15 SHEETS	

PLOTTED 01-JUN-2010