
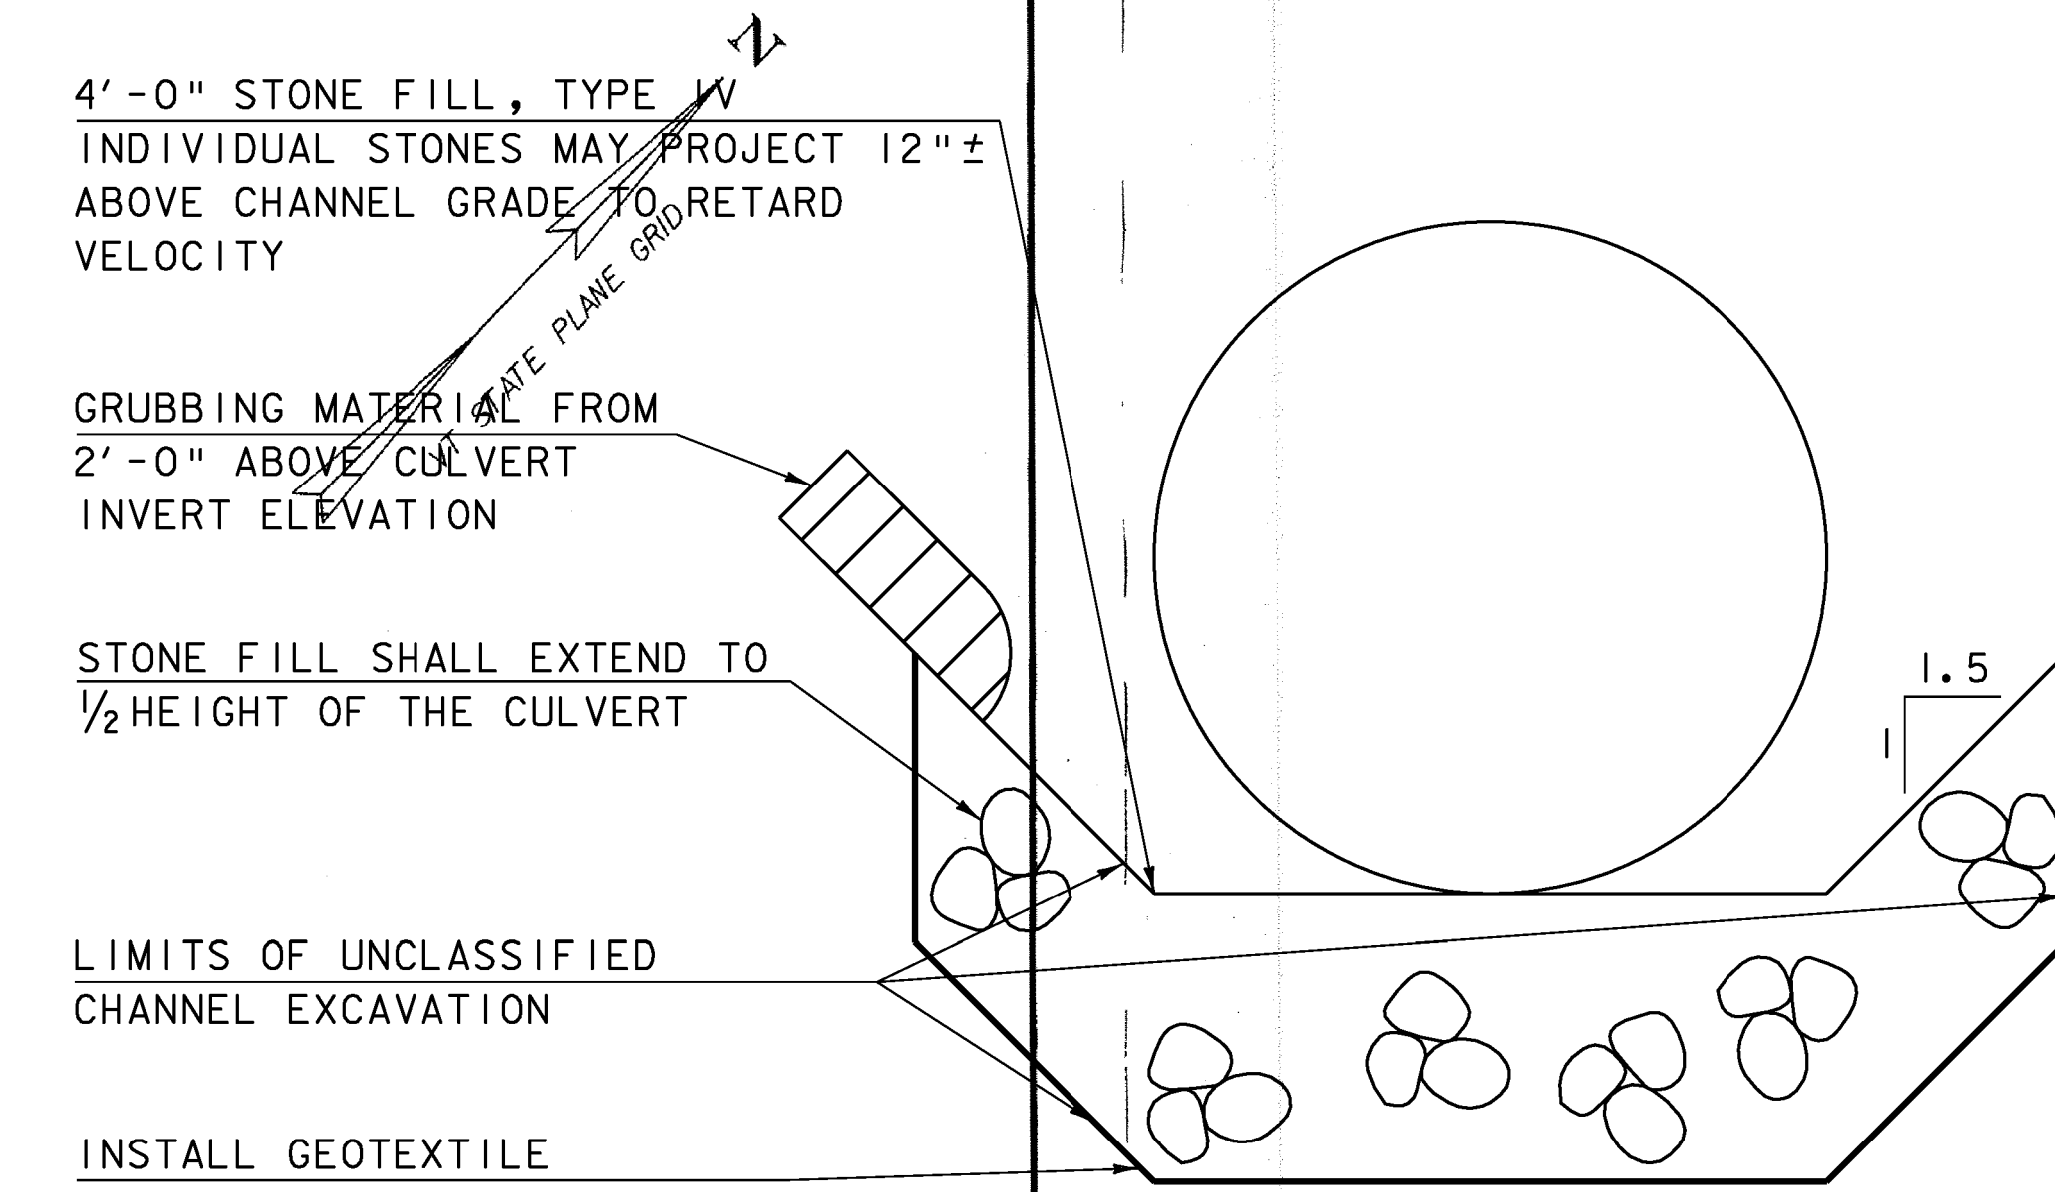


TOWN OF STRATTON
 COUNTY OF WINDHAM
 ROUTE NO: VT 100, RURAL MINOR ARTERIAL BRIDGE NO: 64

PROJECT LOCATION: 11.5 MILES NORTH OF JUNCTION WITH VT ROUTE 9, MM 1.03
 PROJECT DESCRIPTION: THE PROJECT SHALL CONSIST OF LINING THE EXISTING CULVERT,
 AND REPLACING THE EXISTING INLET HEADWALL.
 LENGTH OF STRUCTURE: N/A
 LENGTH OF PROJECT: 100.00'

RECORD PLANS	
CONTRACTOR:	ALPINE CONSTRUCTION, LLC, SCHUYLERVILLE, NY
RESIDENT ENGINEER:	MARK HAUGHWOUT
CONSTRUCTION BEGAN:	SEPTEMBER 1, 2010
CONSTRUCTION COMPLETE:	TYPE I
RECORD PLANS BY:	STONE FILL - THIS WAS EXTENDED UPHILL DUE TO THE PROJECT LOCATION AND STEEP SLOPE. SEE ABOVE DRAWING ALSO.
DATE:	APRIL 17, 2012

CONVENTIONAL SYMBOLS	
COUNTY LINE	--- COUNTY LINE
TOWN LINE	--- TOWN LINE
LIMITS OF ACCESS	--- LIMITS OF ACCESS
POINT OF ACCESS	X POINT OF ACCESS
FENCE LINE	X X FENCE LINE
TRAVELED WAY	--- TRAVELED WAY
GUARD RAIL	--- GUARD RAIL
RAILROAD	--- RAILROAD
SURVEY LINE	--- SURVEY LINE
CULVERT	--- CULVERT
POWER POLE	--- POWER POLE
TELEPHONE POLE	--- TELEPHONE POLE
TREES	--- TREES
CONTROL OF ACCESS	--- CONTROL OF ACCESS
PROPERTY LINE	--- PROPERTY LINE
R.O.W. TAKING LINE	--- R.O.W. TAKING LINE
SLOPE RIGHTS	--- SLOPE RIGHTS
TOP OF CUT	--- TOP OF CUT
TOE OF SLOPE	--- TOE OF SLOPE

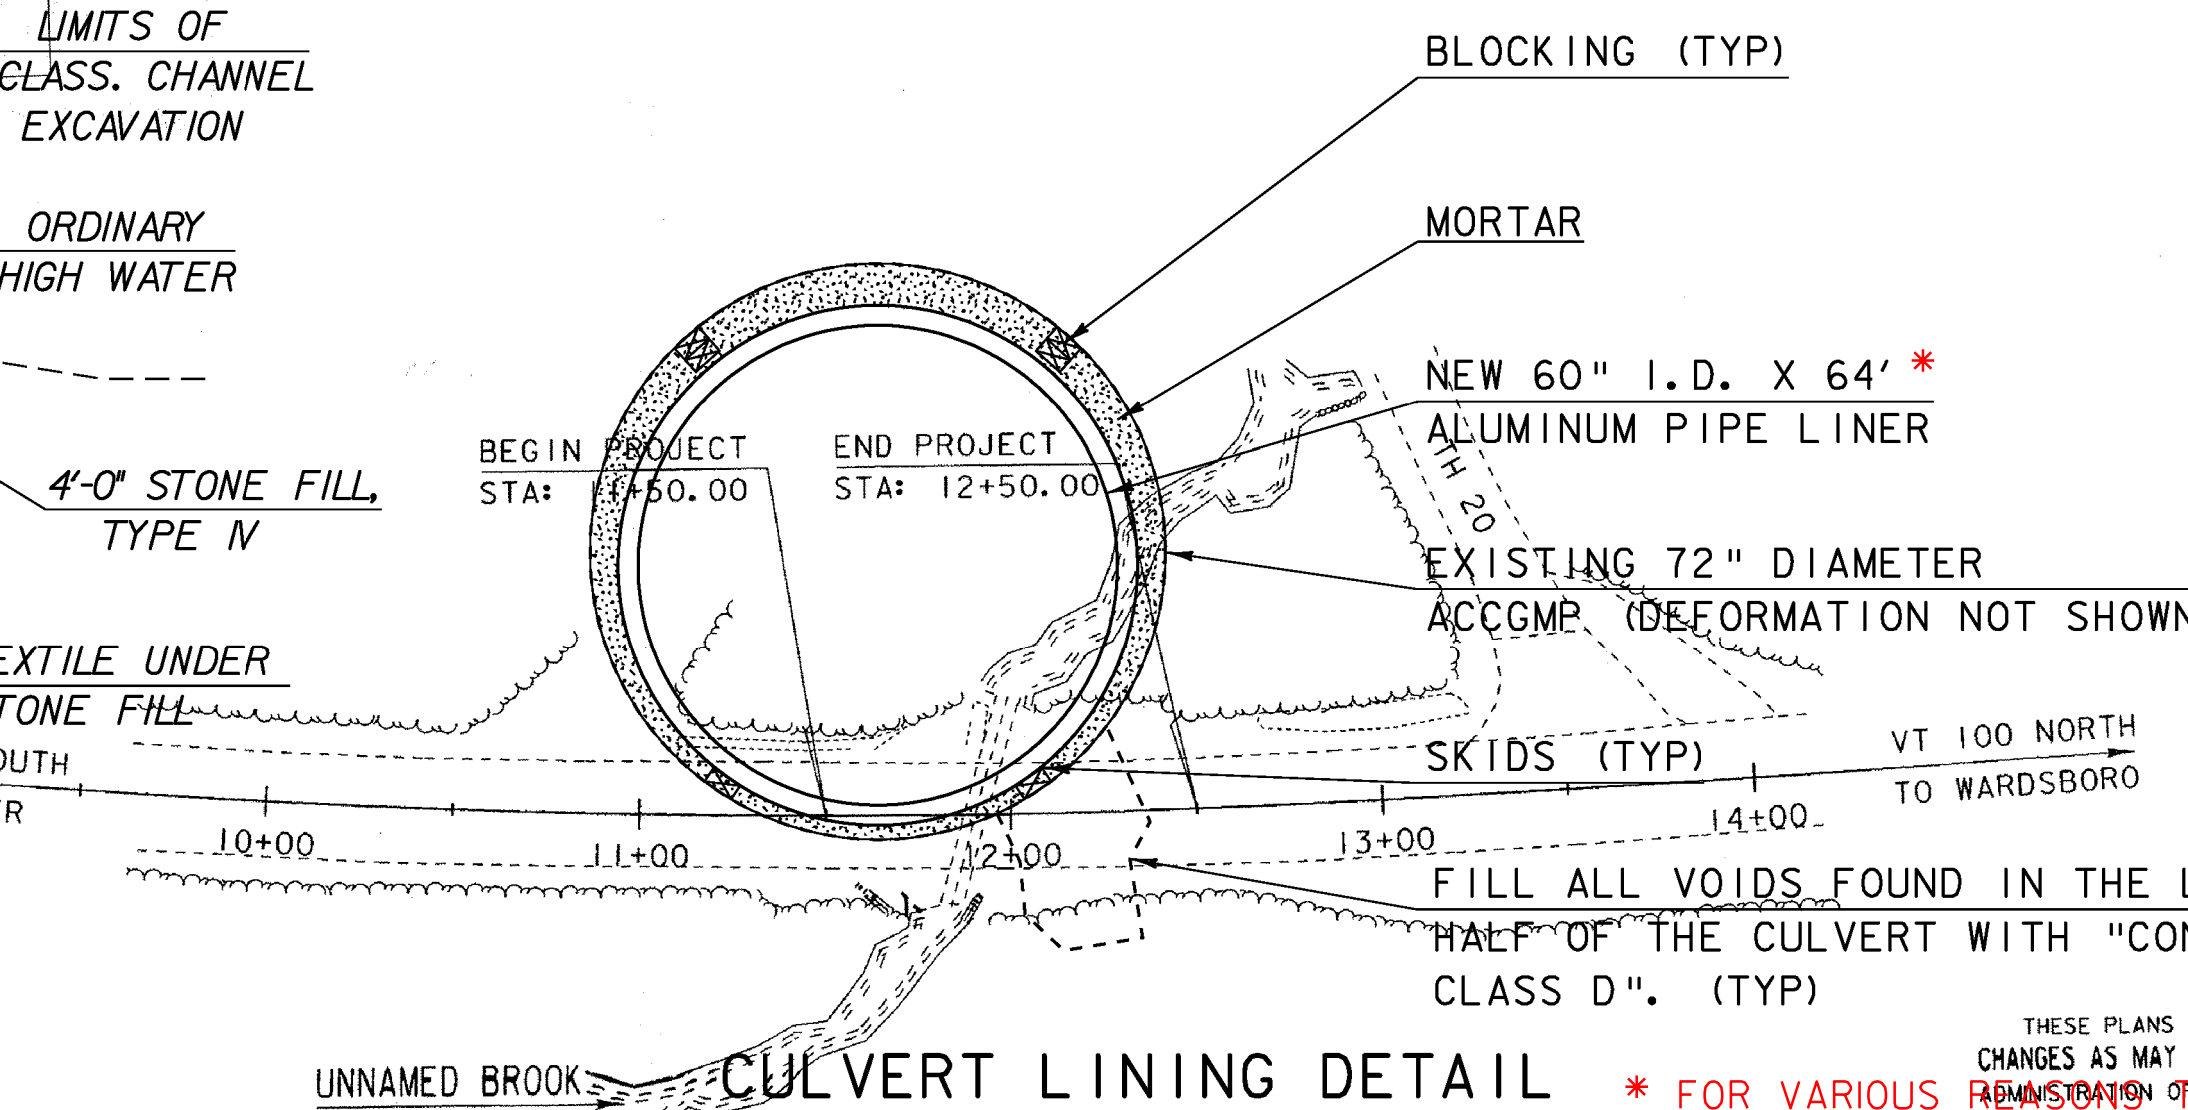

TYPICAL HEADWALL SECTION

(NOT TO SCALE)
 SURVEYED BY: R. GILMAN
 SURVEYED DATE: 07-21-2008
 DATUM
 VERTICAL NAVD88
 HORIZONTAL NAD 83 (2007)

SCALE 1/2" = 1'-0"
 SCALE 1" = 24'-0"

THESE PLANS ARE SUBJECT TO SUCH ENGINEERING CHANGES AS MAY BE REQUIRED BY THE FEDERAL HIGHWAY ADMINISTRATION OR THE DESIGN PROGRAM DEVELOPMENT. CONSTRUCTION IS TO BE CARRIED ON IN ACCORDANCE WITH THESE PLANS AND THE STANDARD SPECIFICATIONS FOR CONSTRUCTION DATED 2006, AS APPROVED BY THE FEDERAL HIGHWAY ADMINISTRATION ON JUNE 15, 2006, FOR USE ON THIS PROJECT, INCLUDING ALL SUBSEQUENT REVISIONS AND SUCH REVISED SPECIFICATIONS AND SPECIAL PROVISIONS AS ARE INCORPORATED IN THESE PLANS.

DIRECTOR OF PROGRAM DEVELOPMENT	PROJECT NAME: STRATTON	PROJECT NUMBER: STP CULV(12)	FILE NAME: s08b058+yp.dgn	PLOT DATE: 01-JUN-2010
PROJECT LEADER: C.P. WILLIAMS	DESIGNED BY: H.I.SALLS	CULVERT PROFILE	PROJECT LEADER: C.P.WILLIAMS	DRAWN BY: D.D.BEARD
PROJECT NUMBER: STP CULV(12)	PROJECT NUMBER: STP CULV(12)		DESIGNED BY: H.I.SALLS	CHECKED BY: H.I. SALLS
SHEET 1 OF 15 SHEETS				SHEET 5 OF 15