



11+00

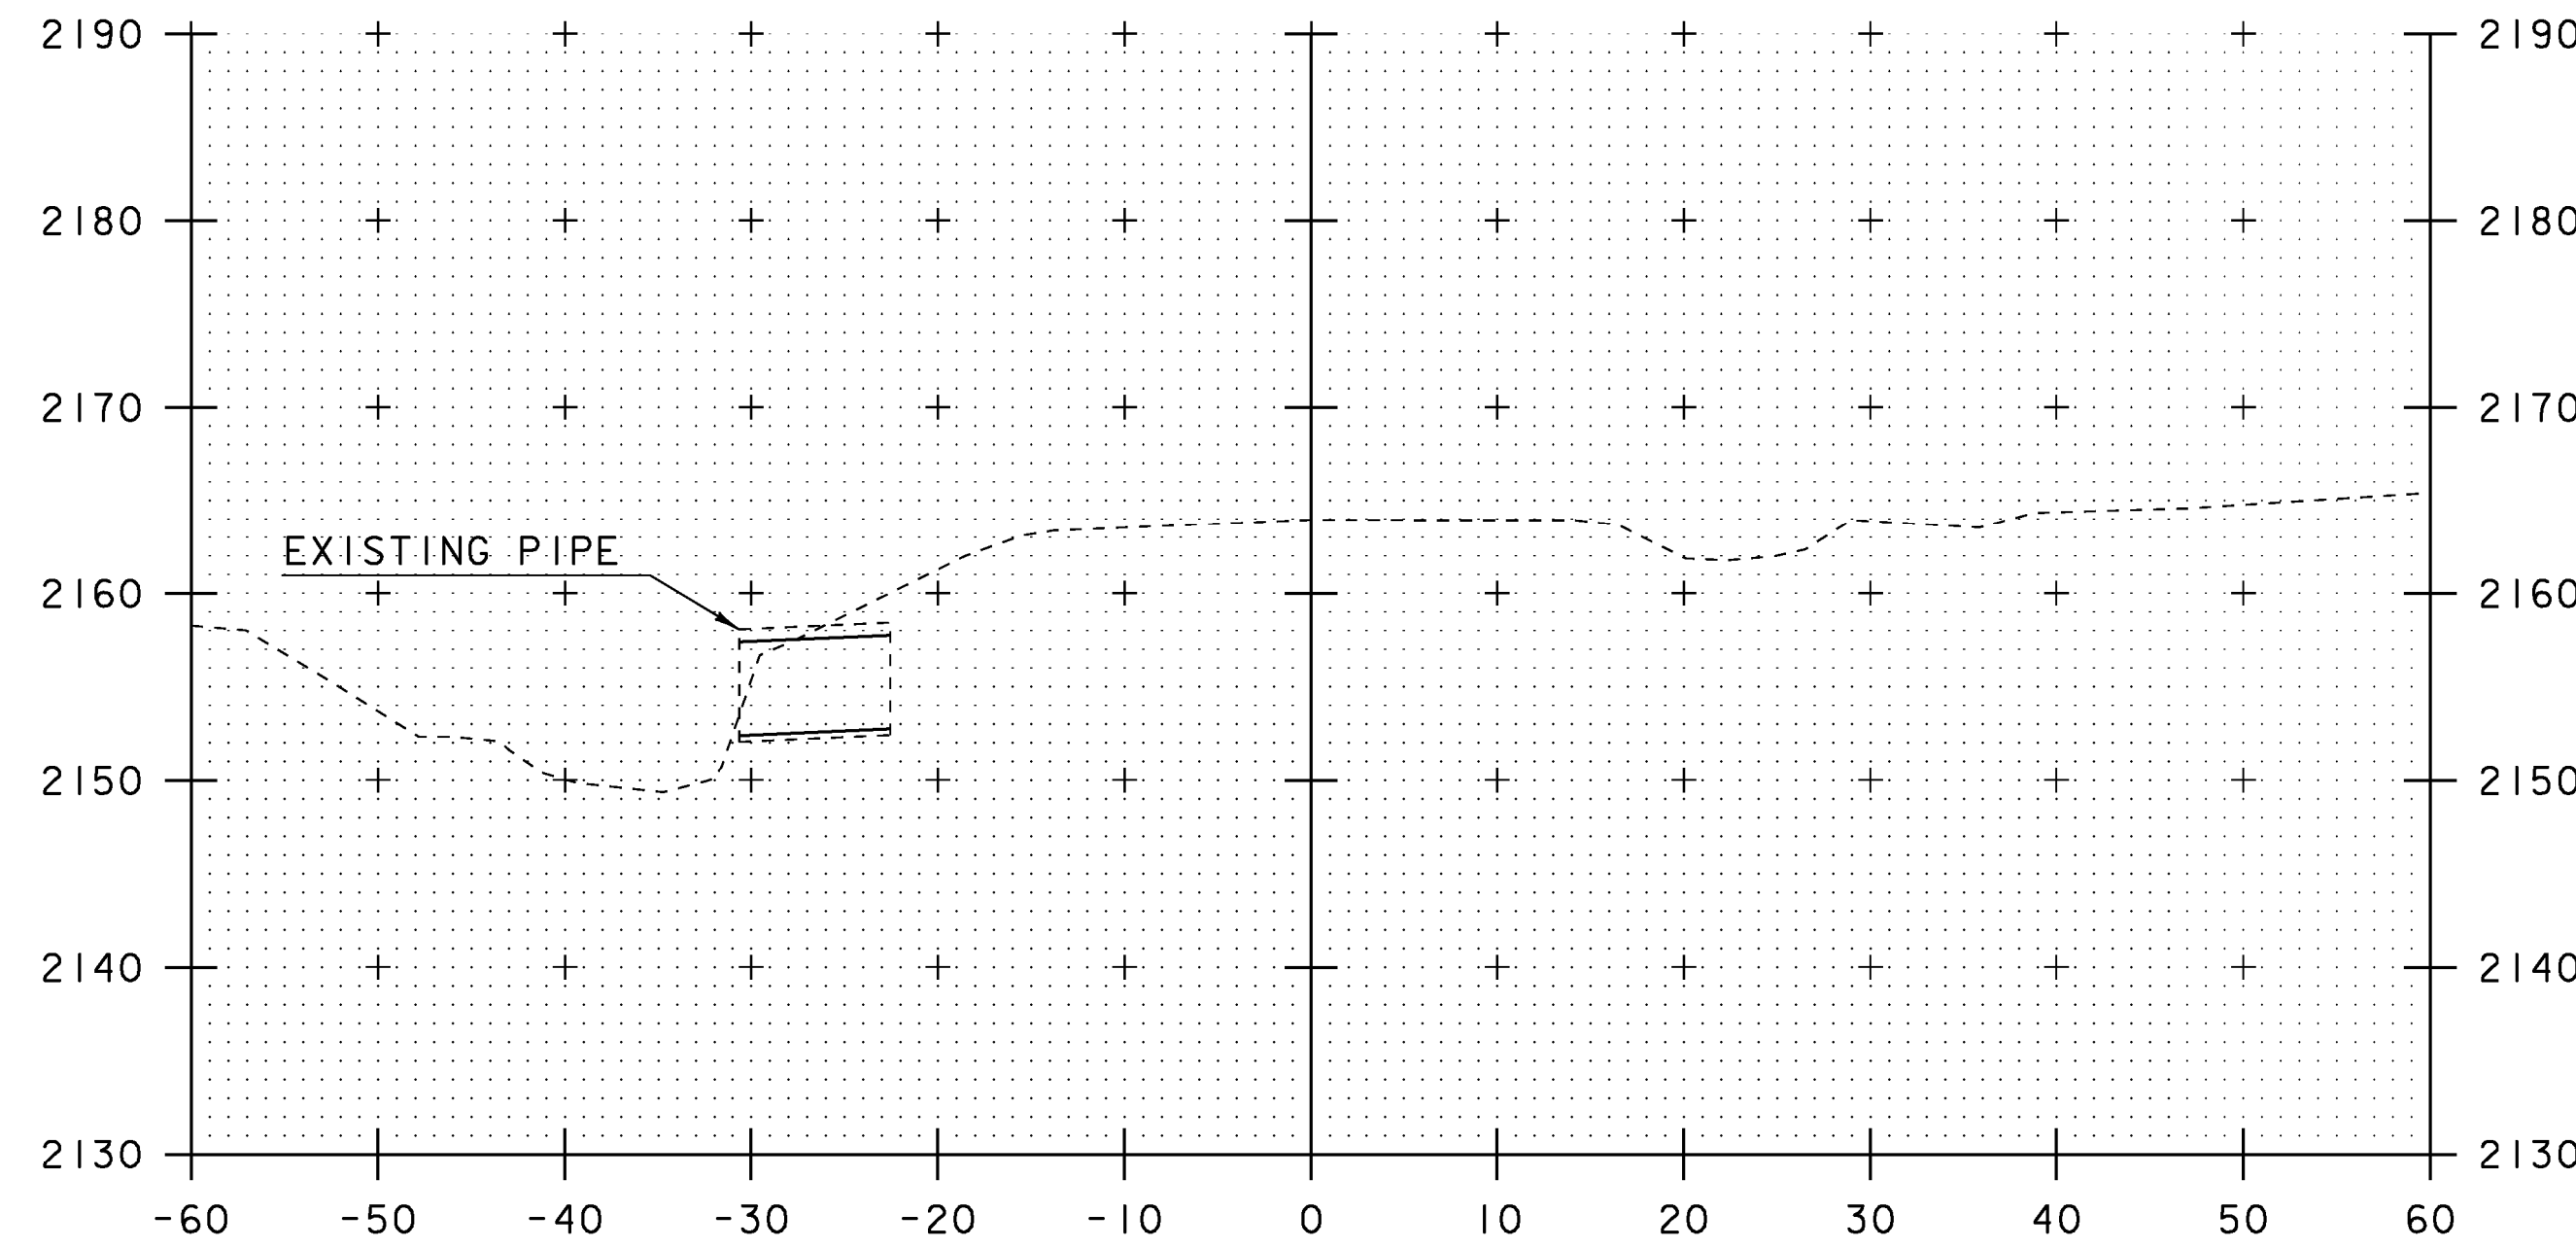


12+00

STA 11+90 SEE NEXT SHEET
STA 11+75 SEE SHEET 14B

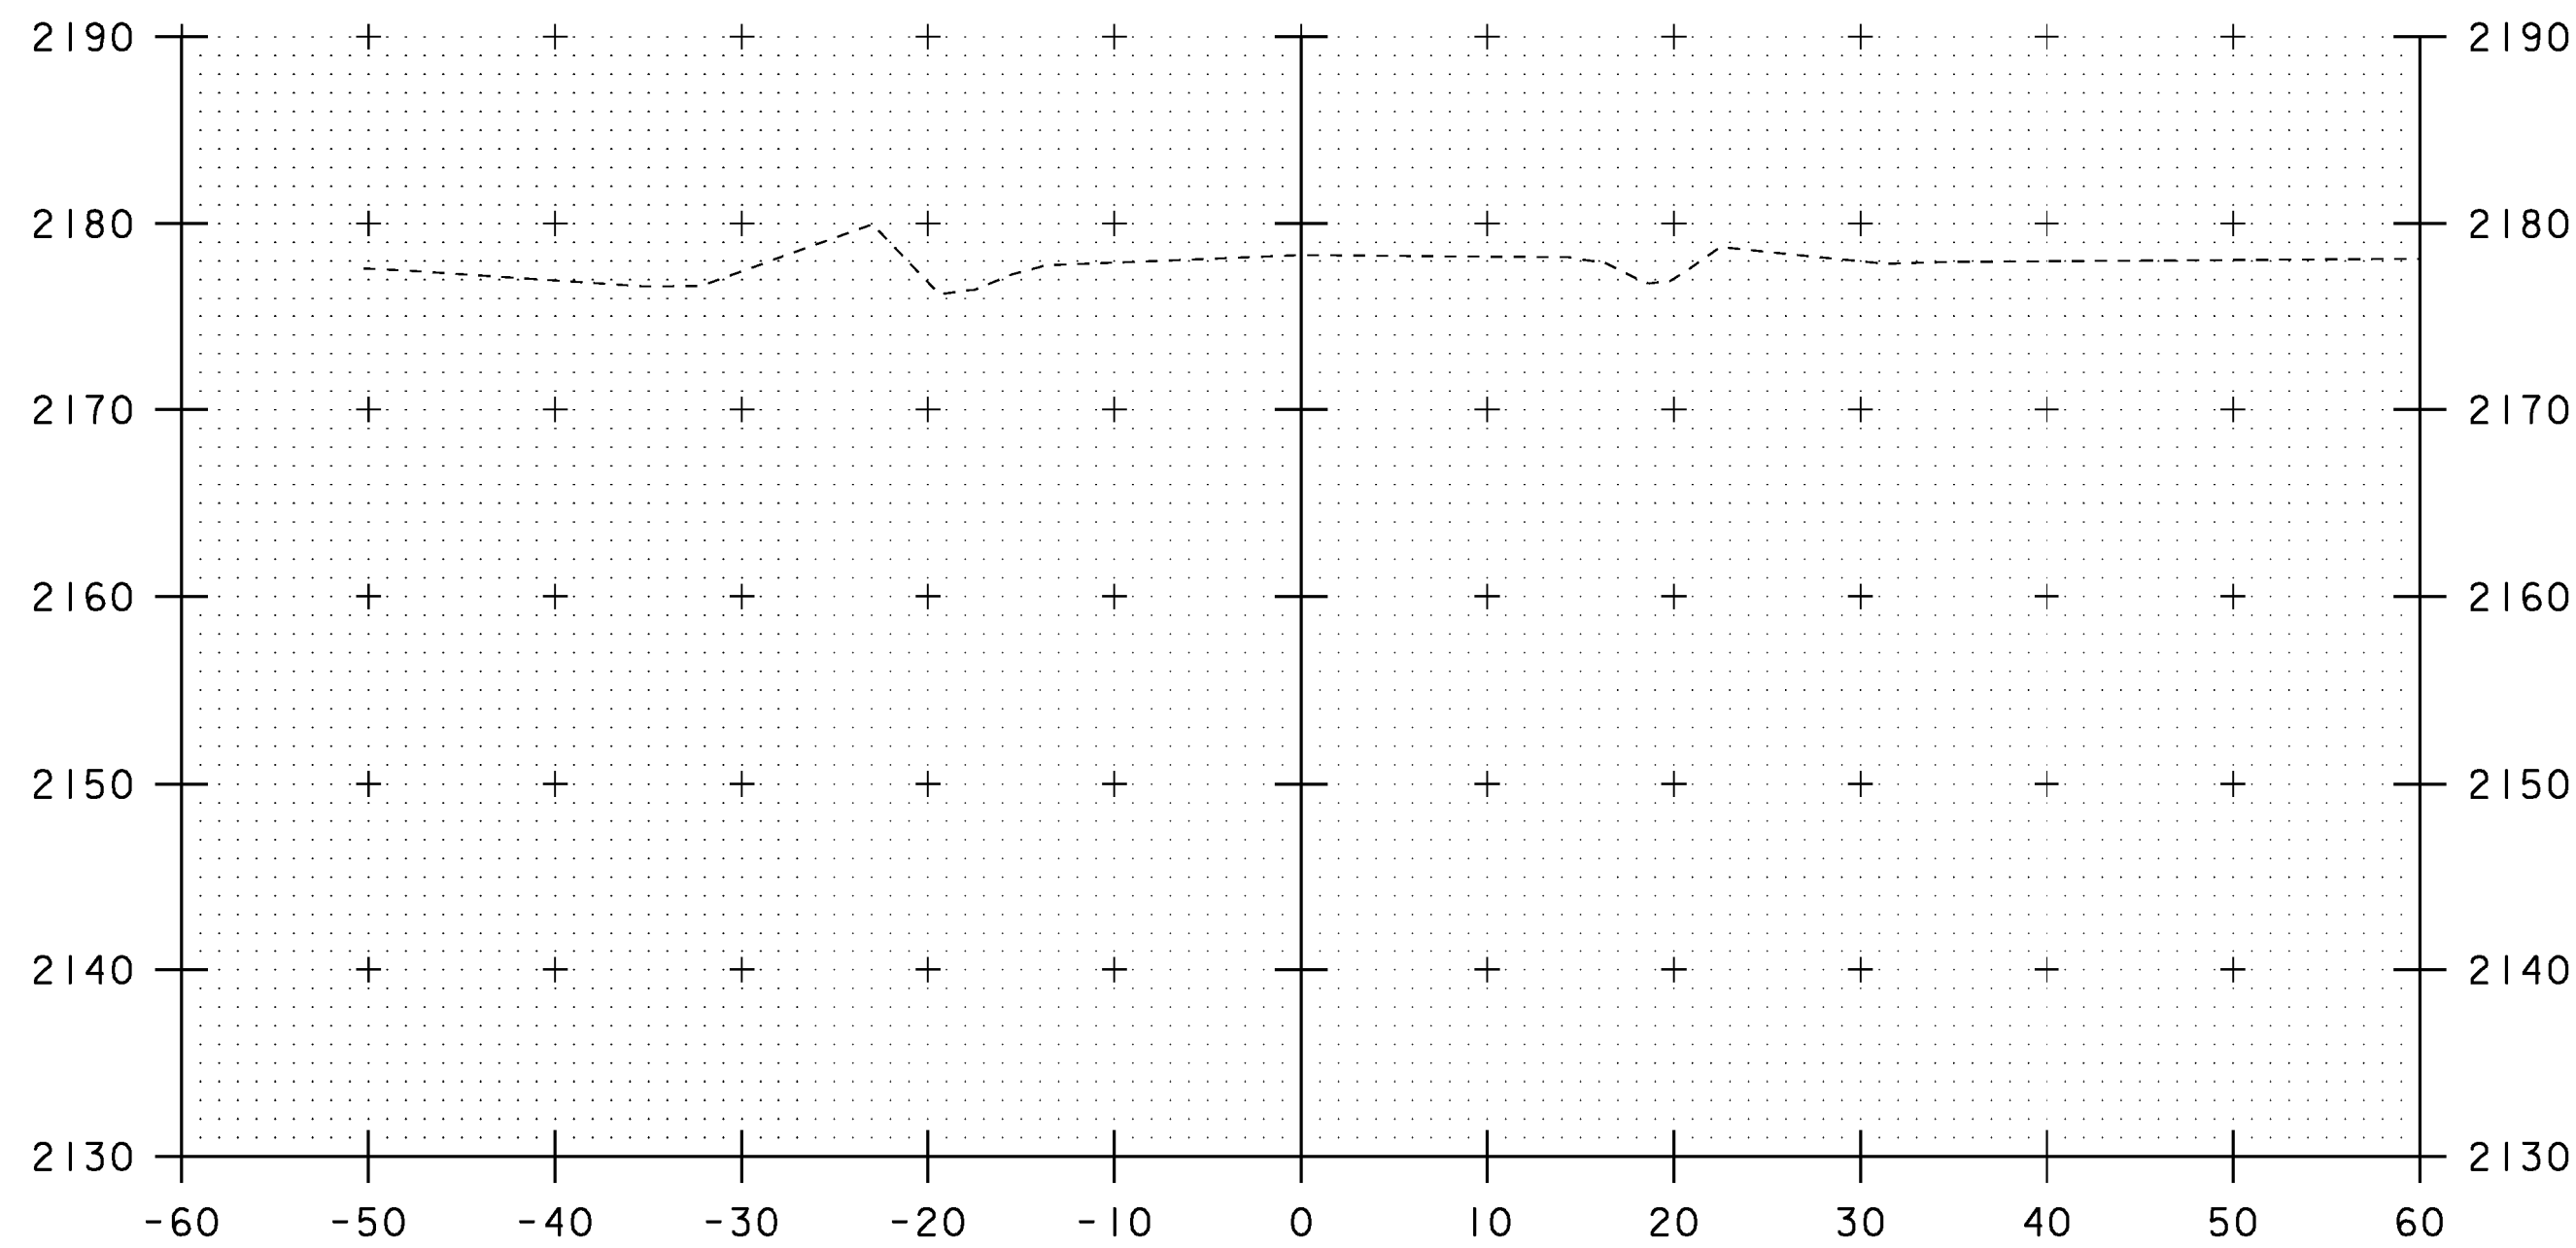

10+50

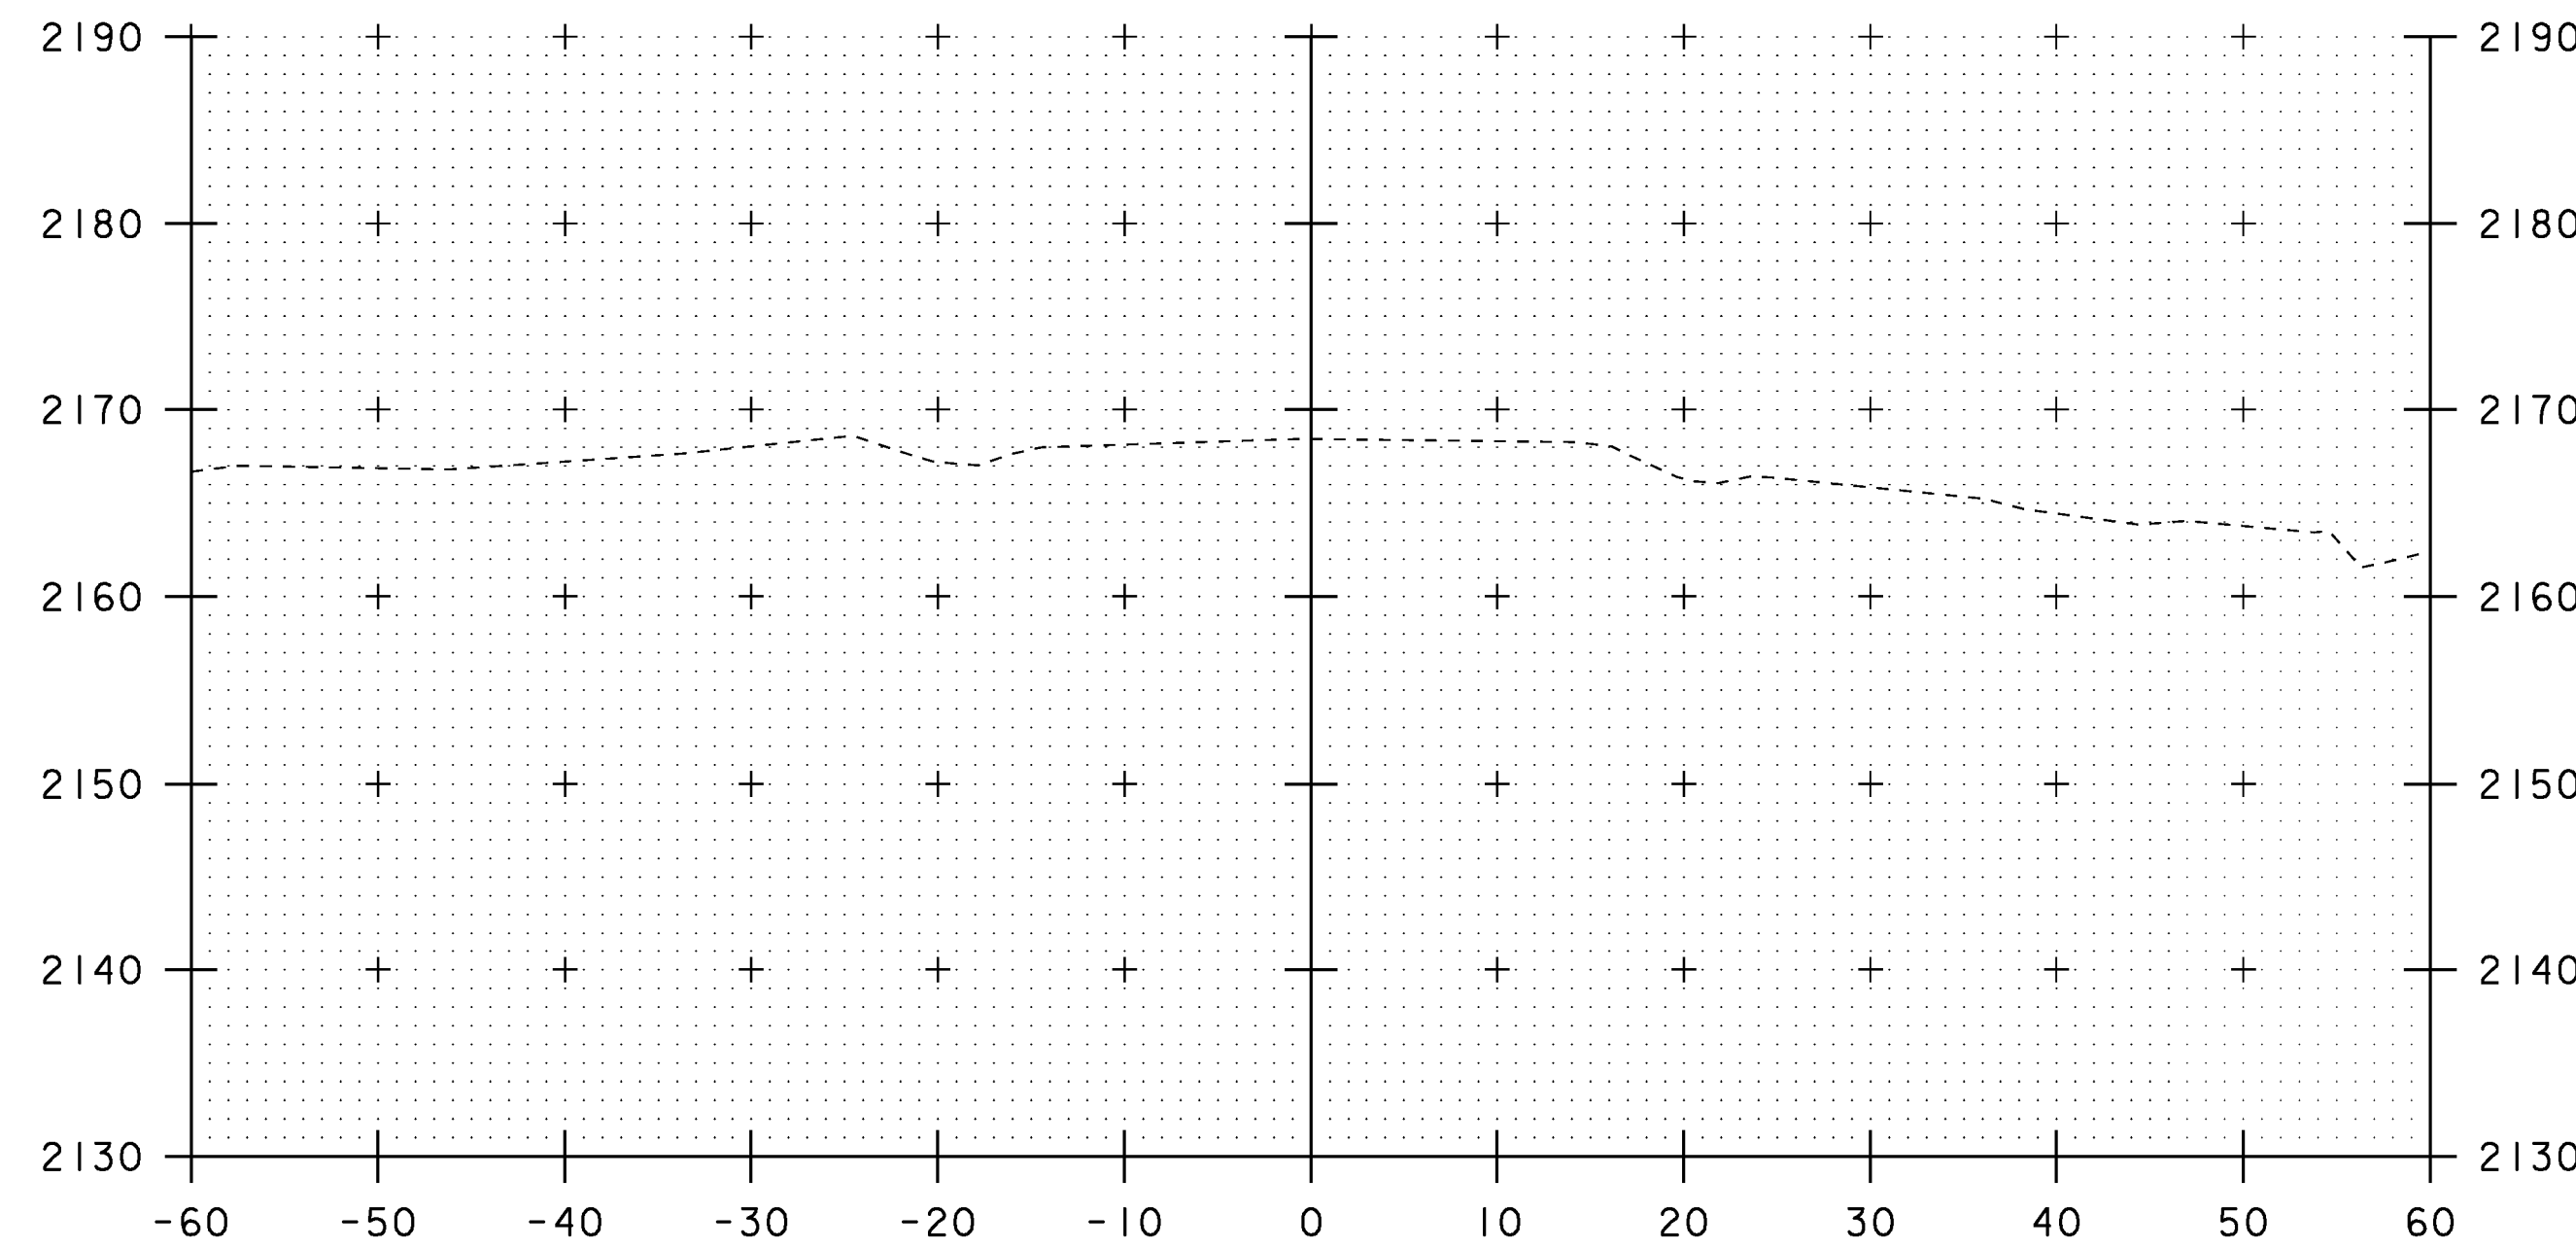

11+50
BEGIN PROJECT

STA. 10+50 TO STA. 12+00

PROJECT NAME:	STRATTON	PLOT DATE:	01-JUN-2010
PROJECT NUMBER:	STP CULV(12)	DRAWN BY:	D.D.BEARD
FILE NAME:	s08b058xsl.dgn	DESIGNED BY:	H.I.SALLS
PROJECT LEADER:	C.P.WILLIAMS	CHECKED BY:	H.I.SALLS
MAINLINE CROSS SECTIONS 1		SHEET 12 OF 15	