




50+25

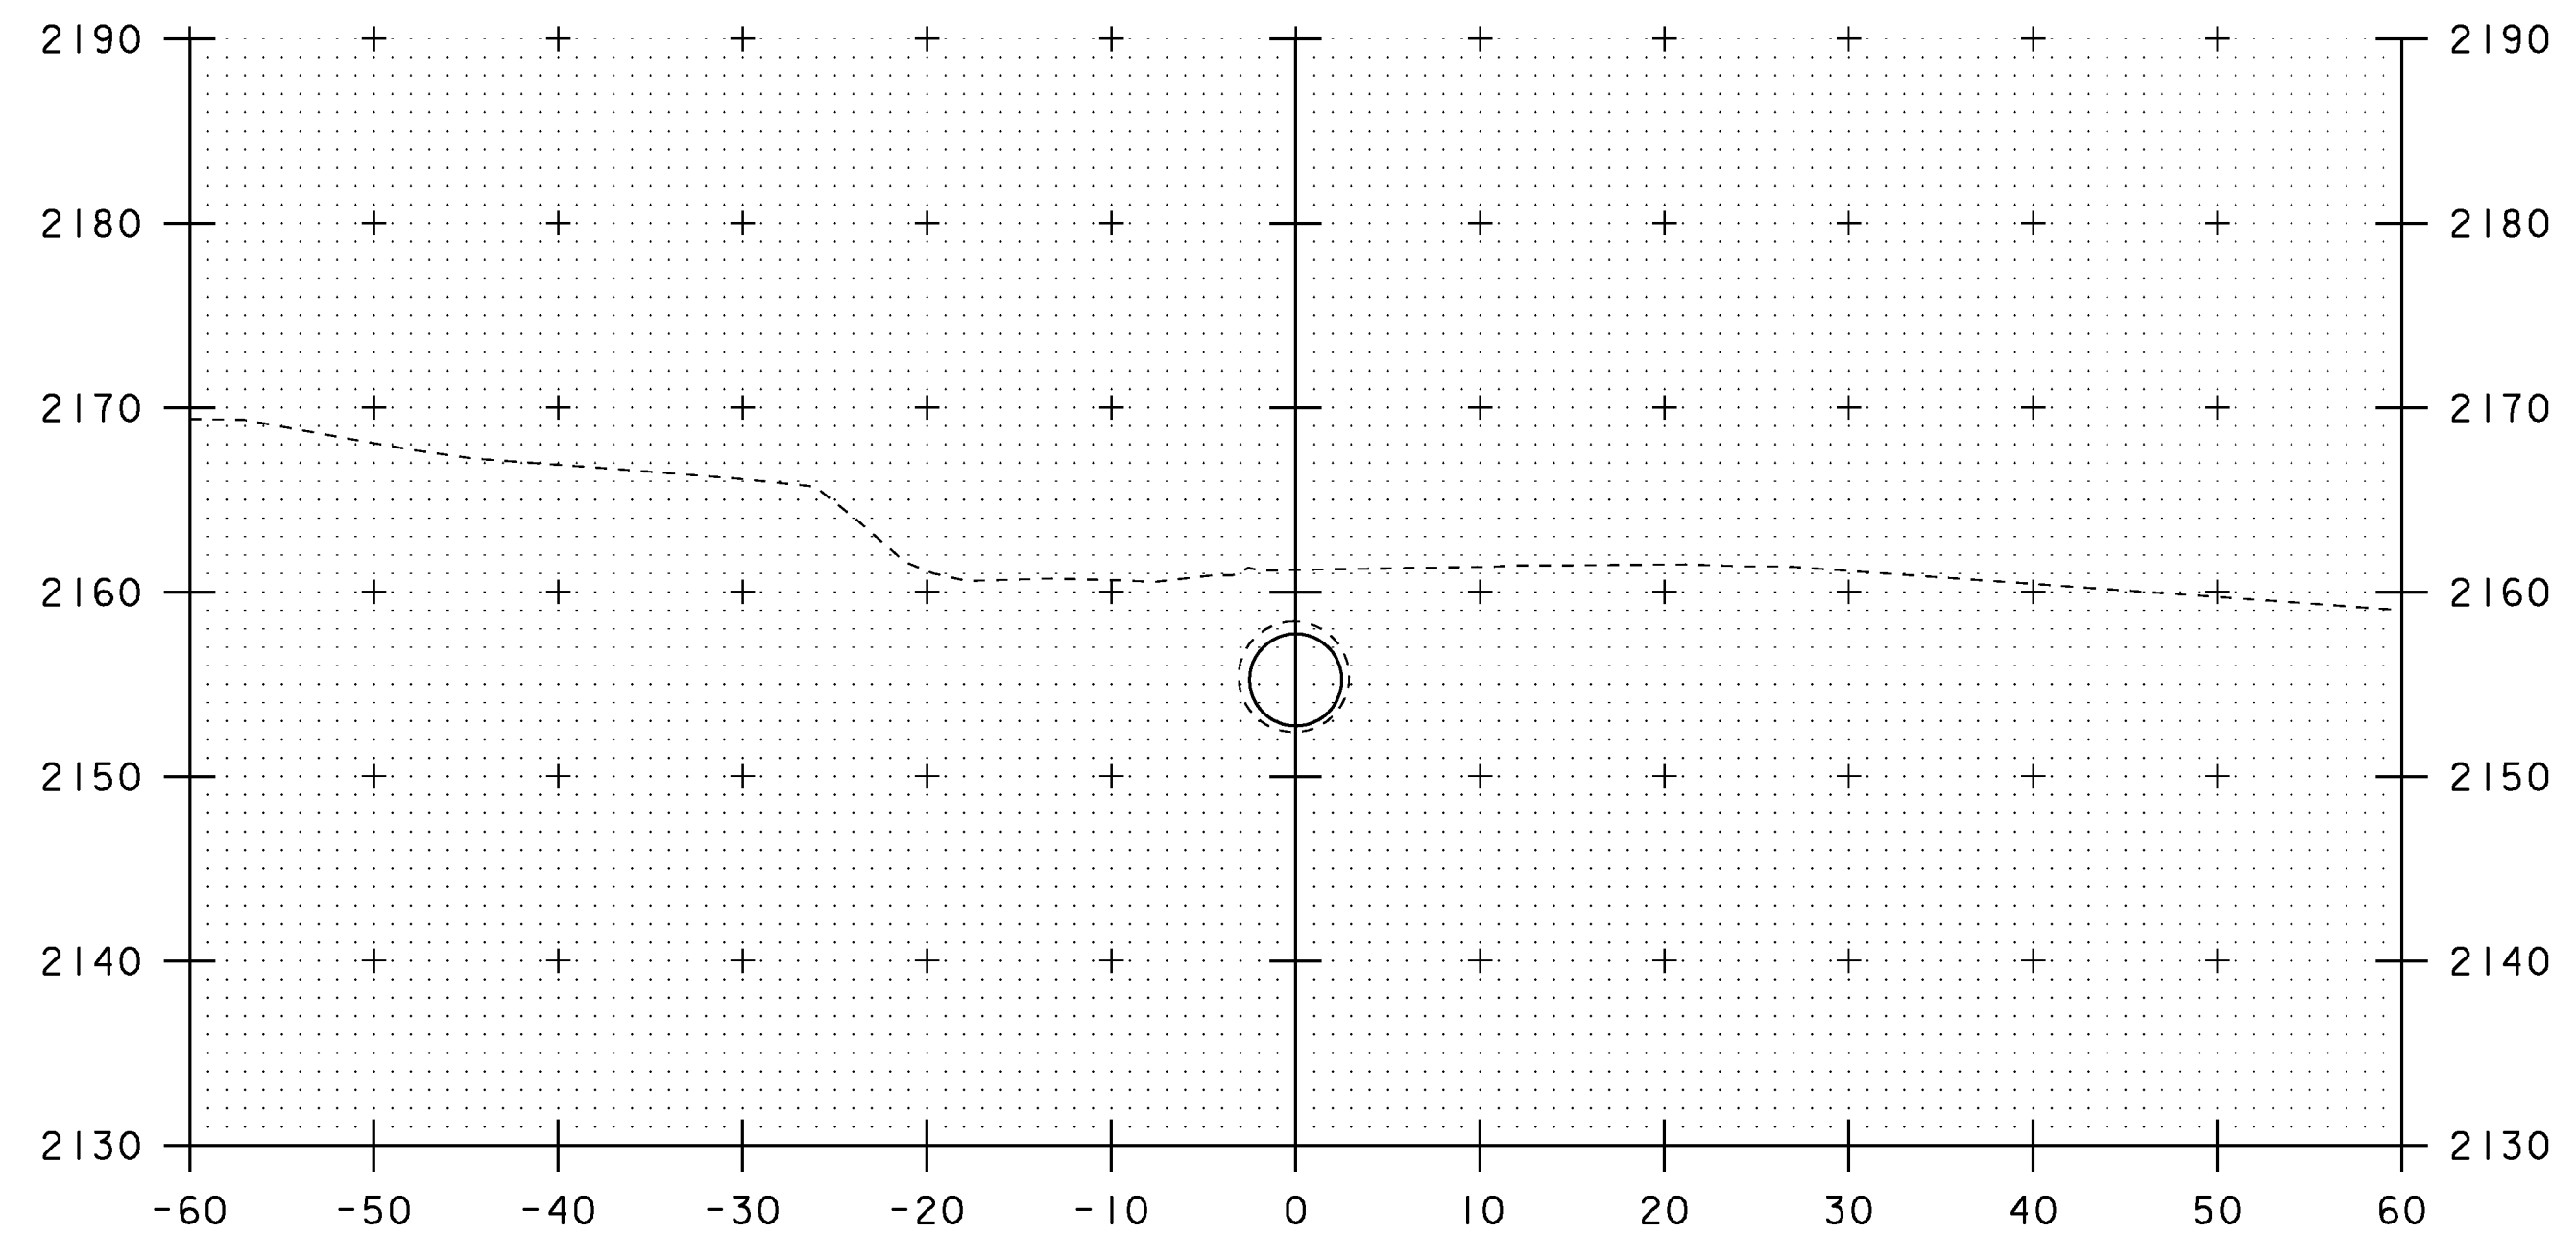

50+75

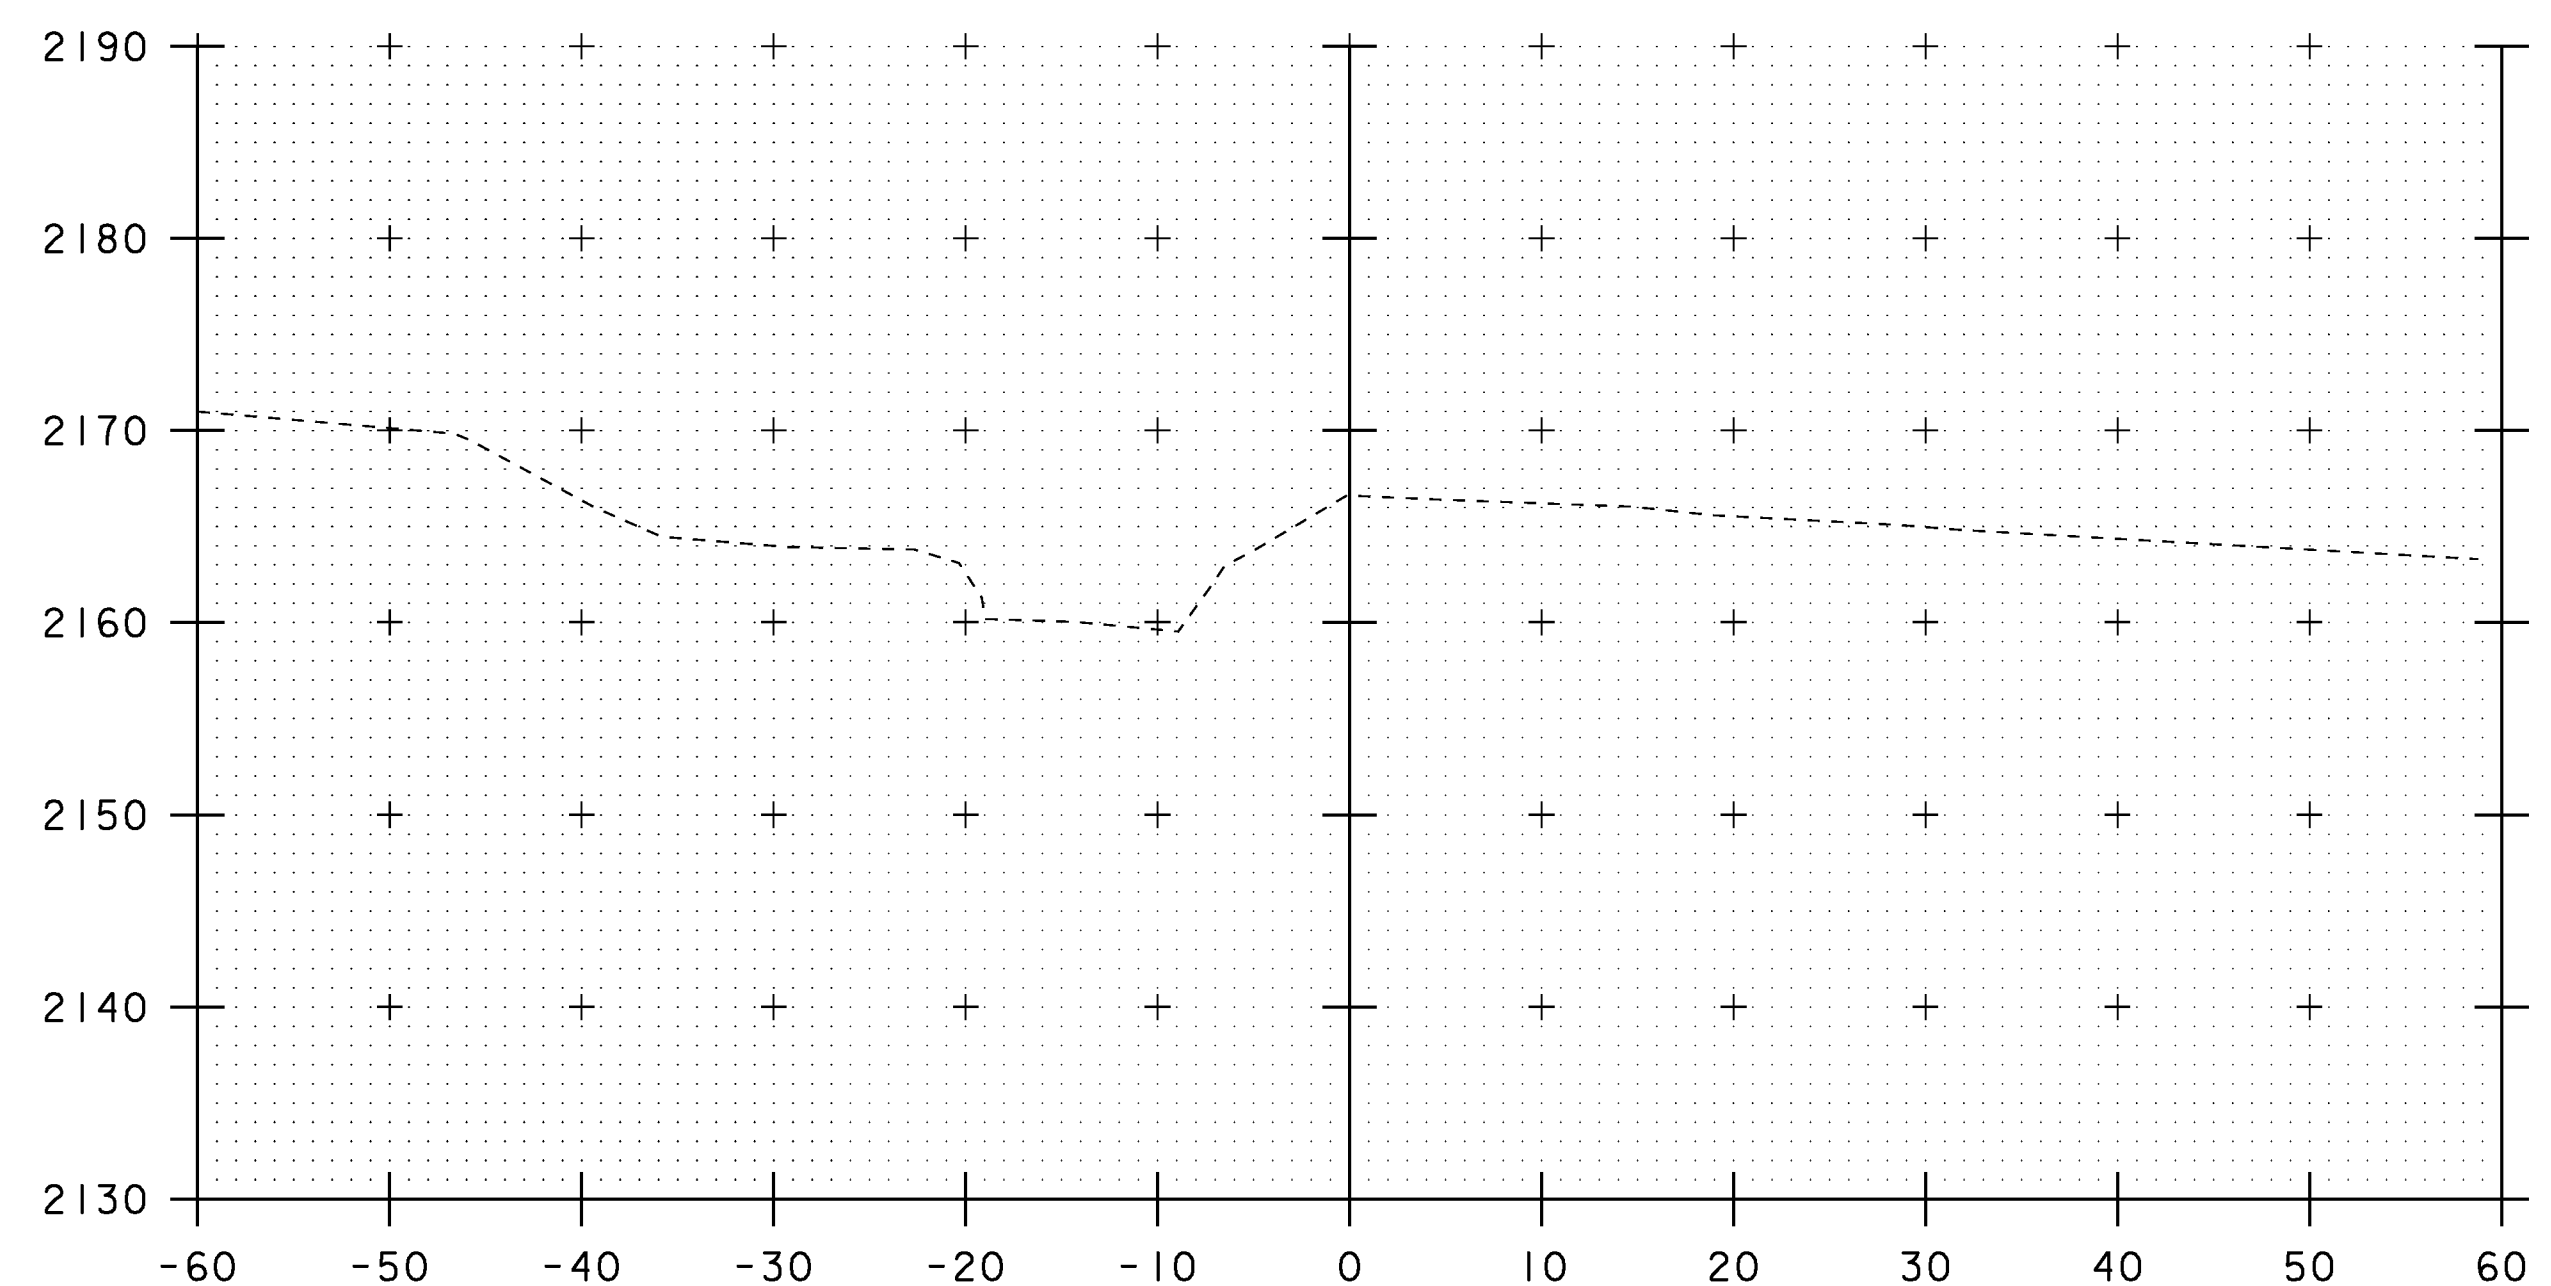

50+00

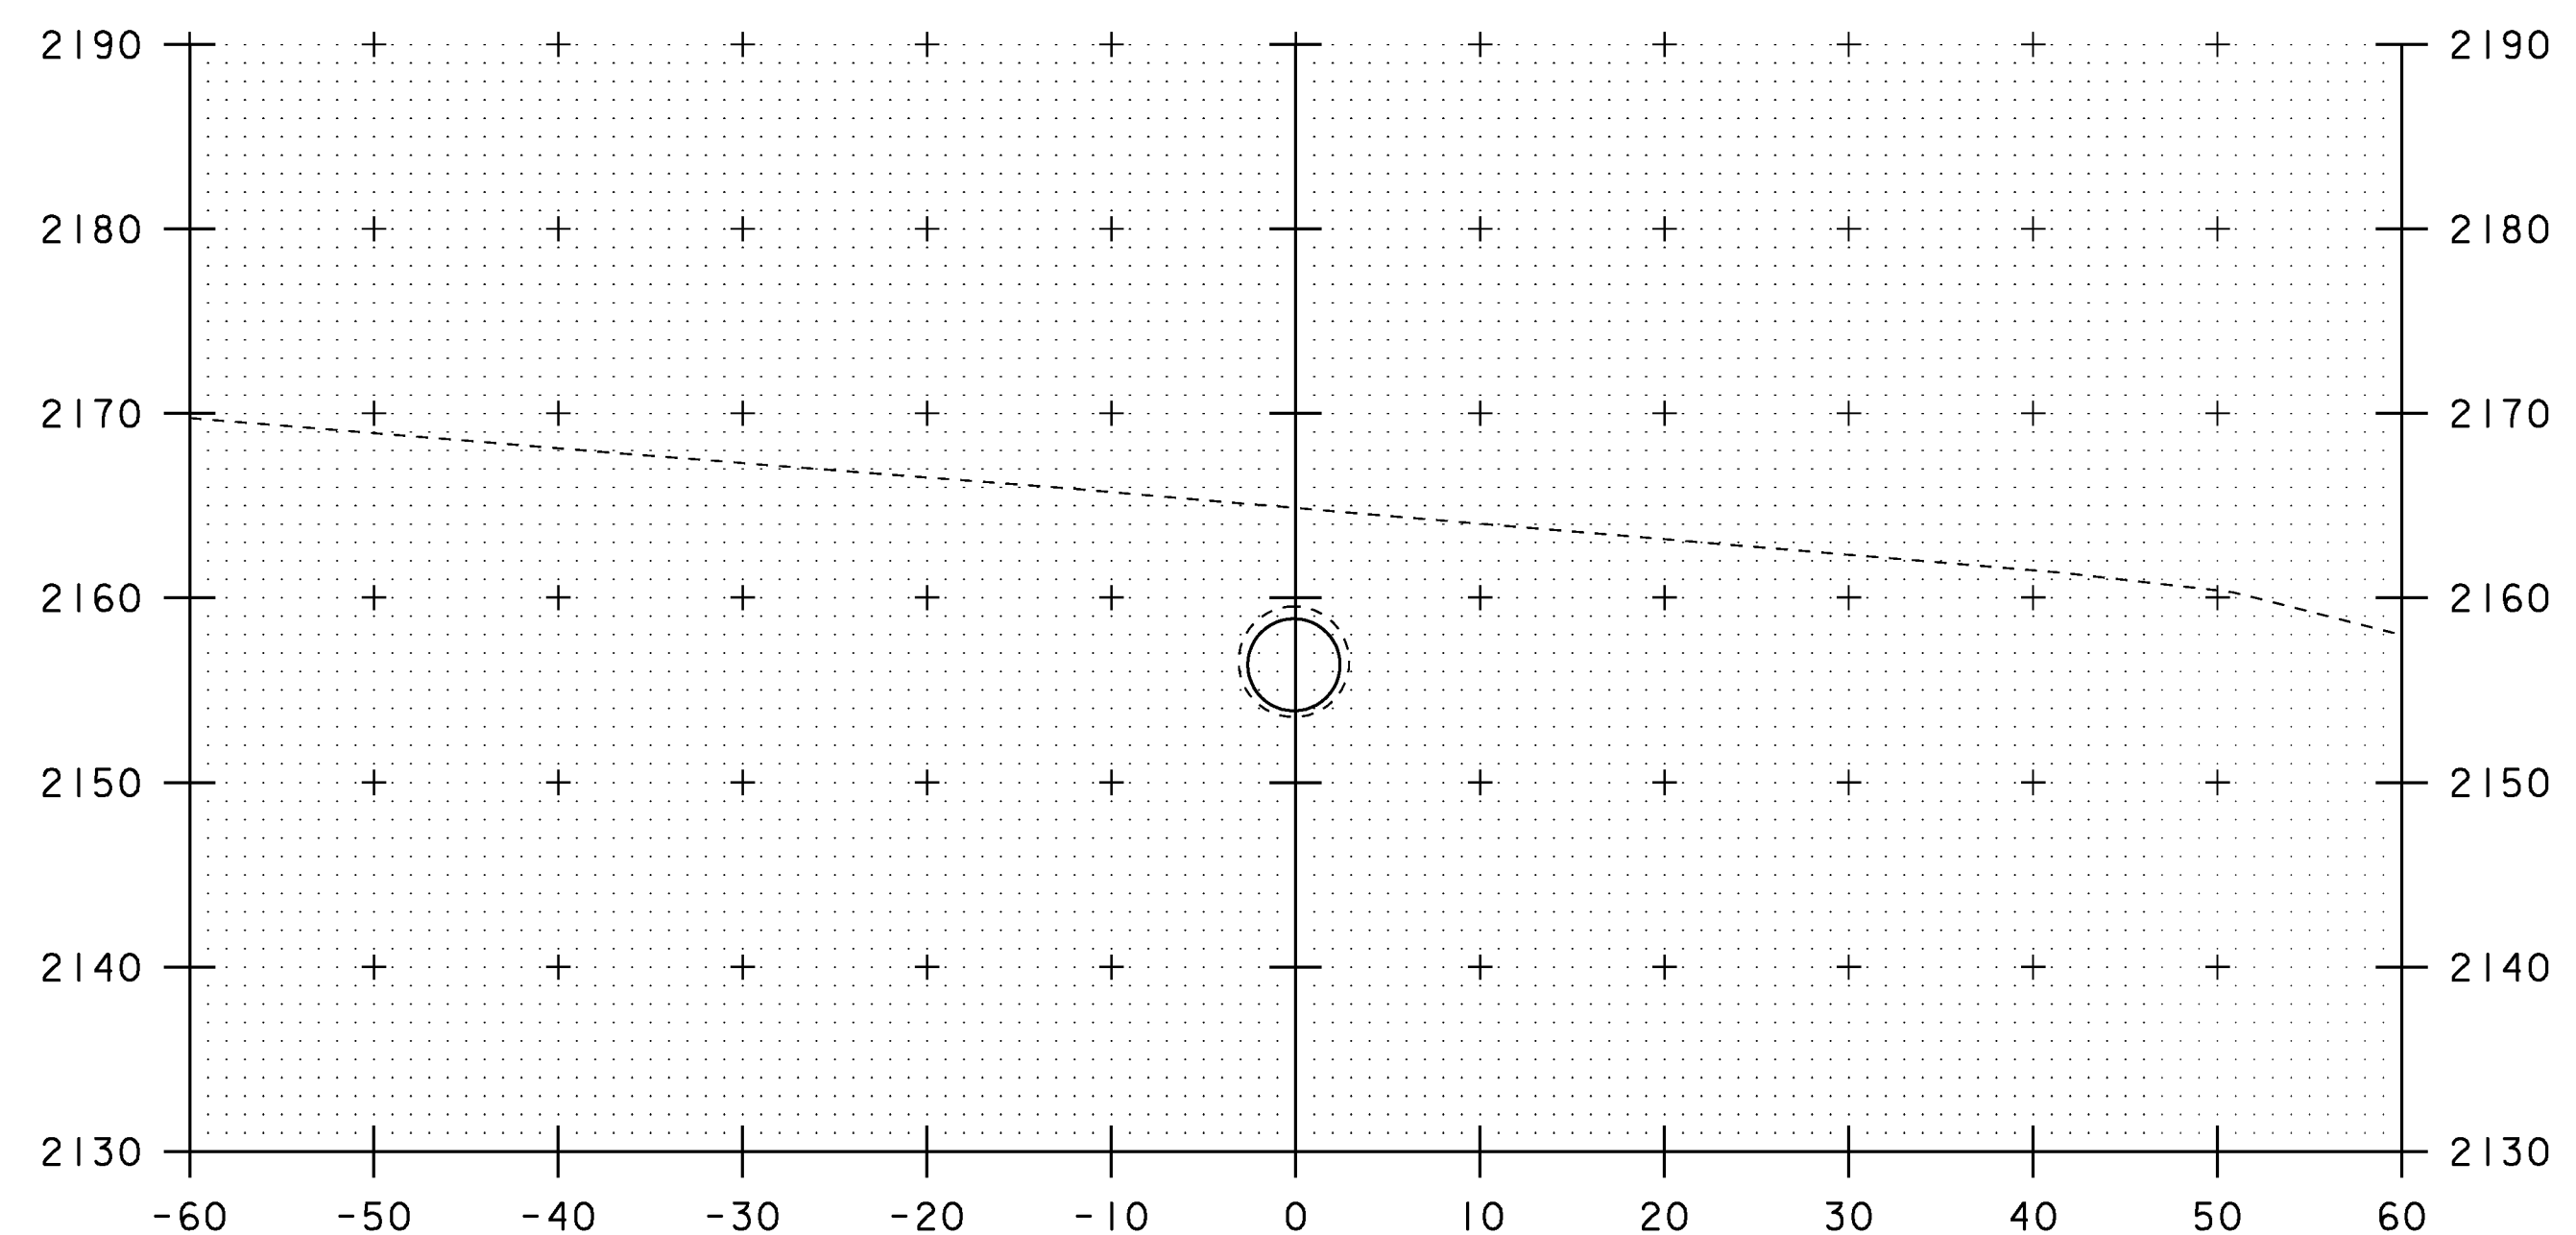

50+50

STA. 50+00 TO STA. 50+75

PROJECT NAME:	STRATTON	PLOT DATE:	01-JUN-2010
PROJECT NUMBER:	STP CULV(12)	DRAWN BY:	D.D.BEARD
FILE NAME:	s08b058xsl.dgn	DESIGNED BY:	H.I.SALLS
PROJECT LEADER:	C.P.WILLIAMS	CHECKED BY:	H.I.SALLS
CHANNEL CROSS SECTIONS 1		SHEET 14	OF 15