


STATE OF VERMONT AGENCY OF TRANSPORTATION



PROPOSED IMPROVEMENT BRIDGE PROJECT TOWN OF ADDISON COUNTY OF ADDISON

VT ROUTE 17 (RURAL MINOR ARTERIAL) - BRIDGE #2

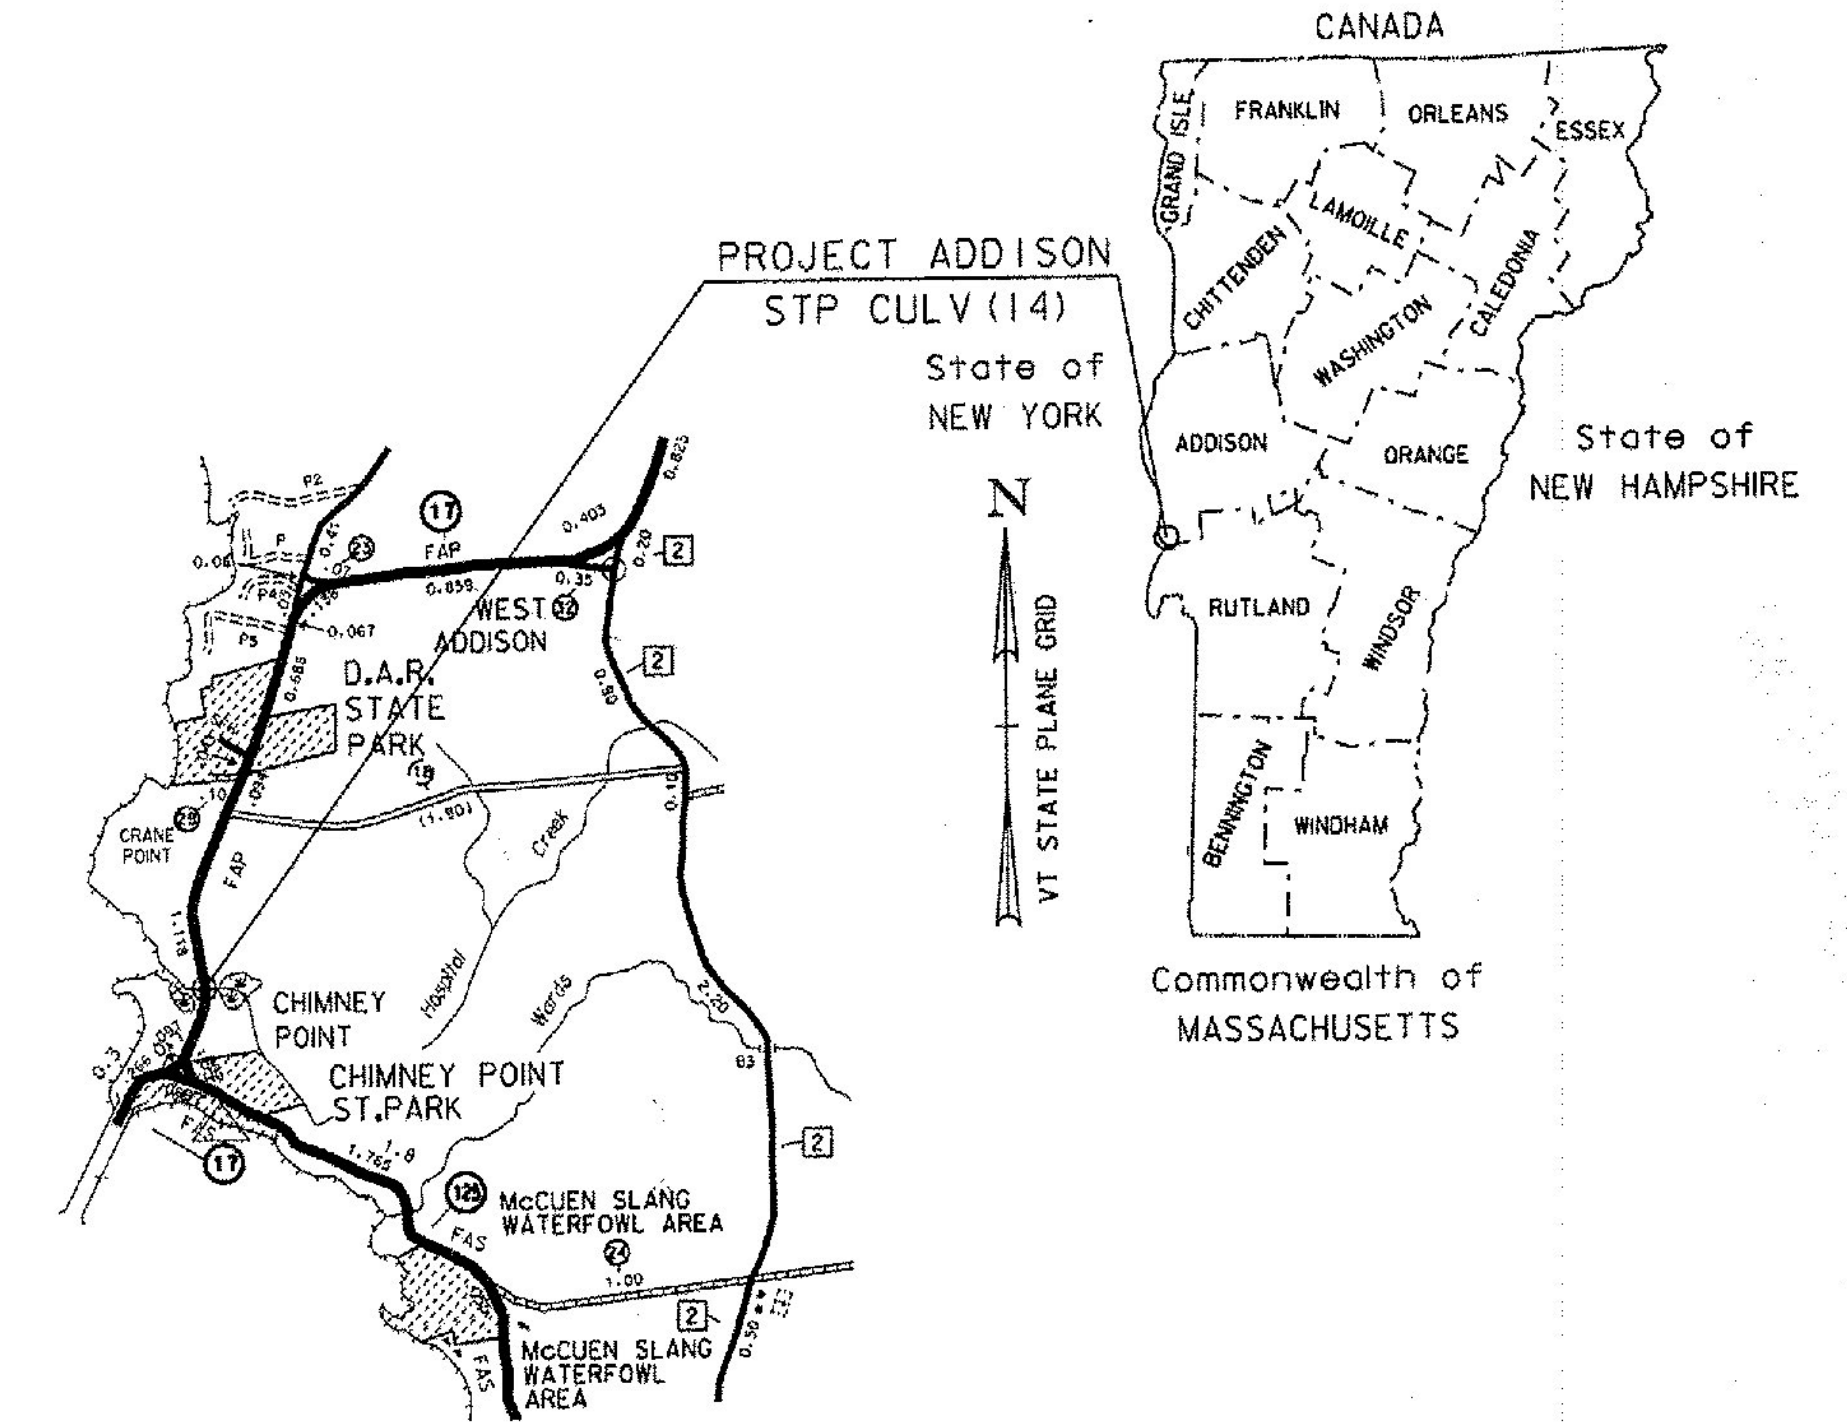


RECORD PLANS	
CONTRACTOR:	S. D. IRELAND CONC. CONST. CORP - BURLINGTON, VT
RESIDENT ENGINEER:	JOE KNIPES
CONSTRUCTION BEGAN:	OCTOBER 9, 2013
CONSTRUCTION COMPLETE:	DECEMBER 6, 2013
RECORD PLANS BY:	JOE KNIPES & AARON JAMES
I HEREBY CERTIFY THAT ALL THE CONSTRUCTION REQUIRED BY THIS SET OF DRAWINGS HAS BEEN ACCOMPLISHED AS INDICATED HEREIN.	
BY:	RESIDENT ENGINEER
DATE: 6-29-16	<i>[Signature]</i>
NOTE: Any further information concerning final quantities, amounts or other details relative to this project may be found at Central Files in the electronic archives.	

PROJECT LOCATION : THE PROJECT IS LOCATED ON VERMONT ROUTE 17, APPROXIMATELY 0.4 MILES NORTH FROM THE INTERSECTION OF VERMONT ROUTE 125.

PROJECT DESCRIPTION : REMOVAL OF THE EXISTING TWIN REINFORCED CONCRETE CULVERTS AND REPLACING THEM WITH A NEW REINFORCED CONCRETE BOX CULVERT.

LENGTH OF BRIDGE : 12.00 FEET
 LENGTH OF ROADWAY : 113.00 FEET
 LENGTH OF PROJECT : 125.00 FEET

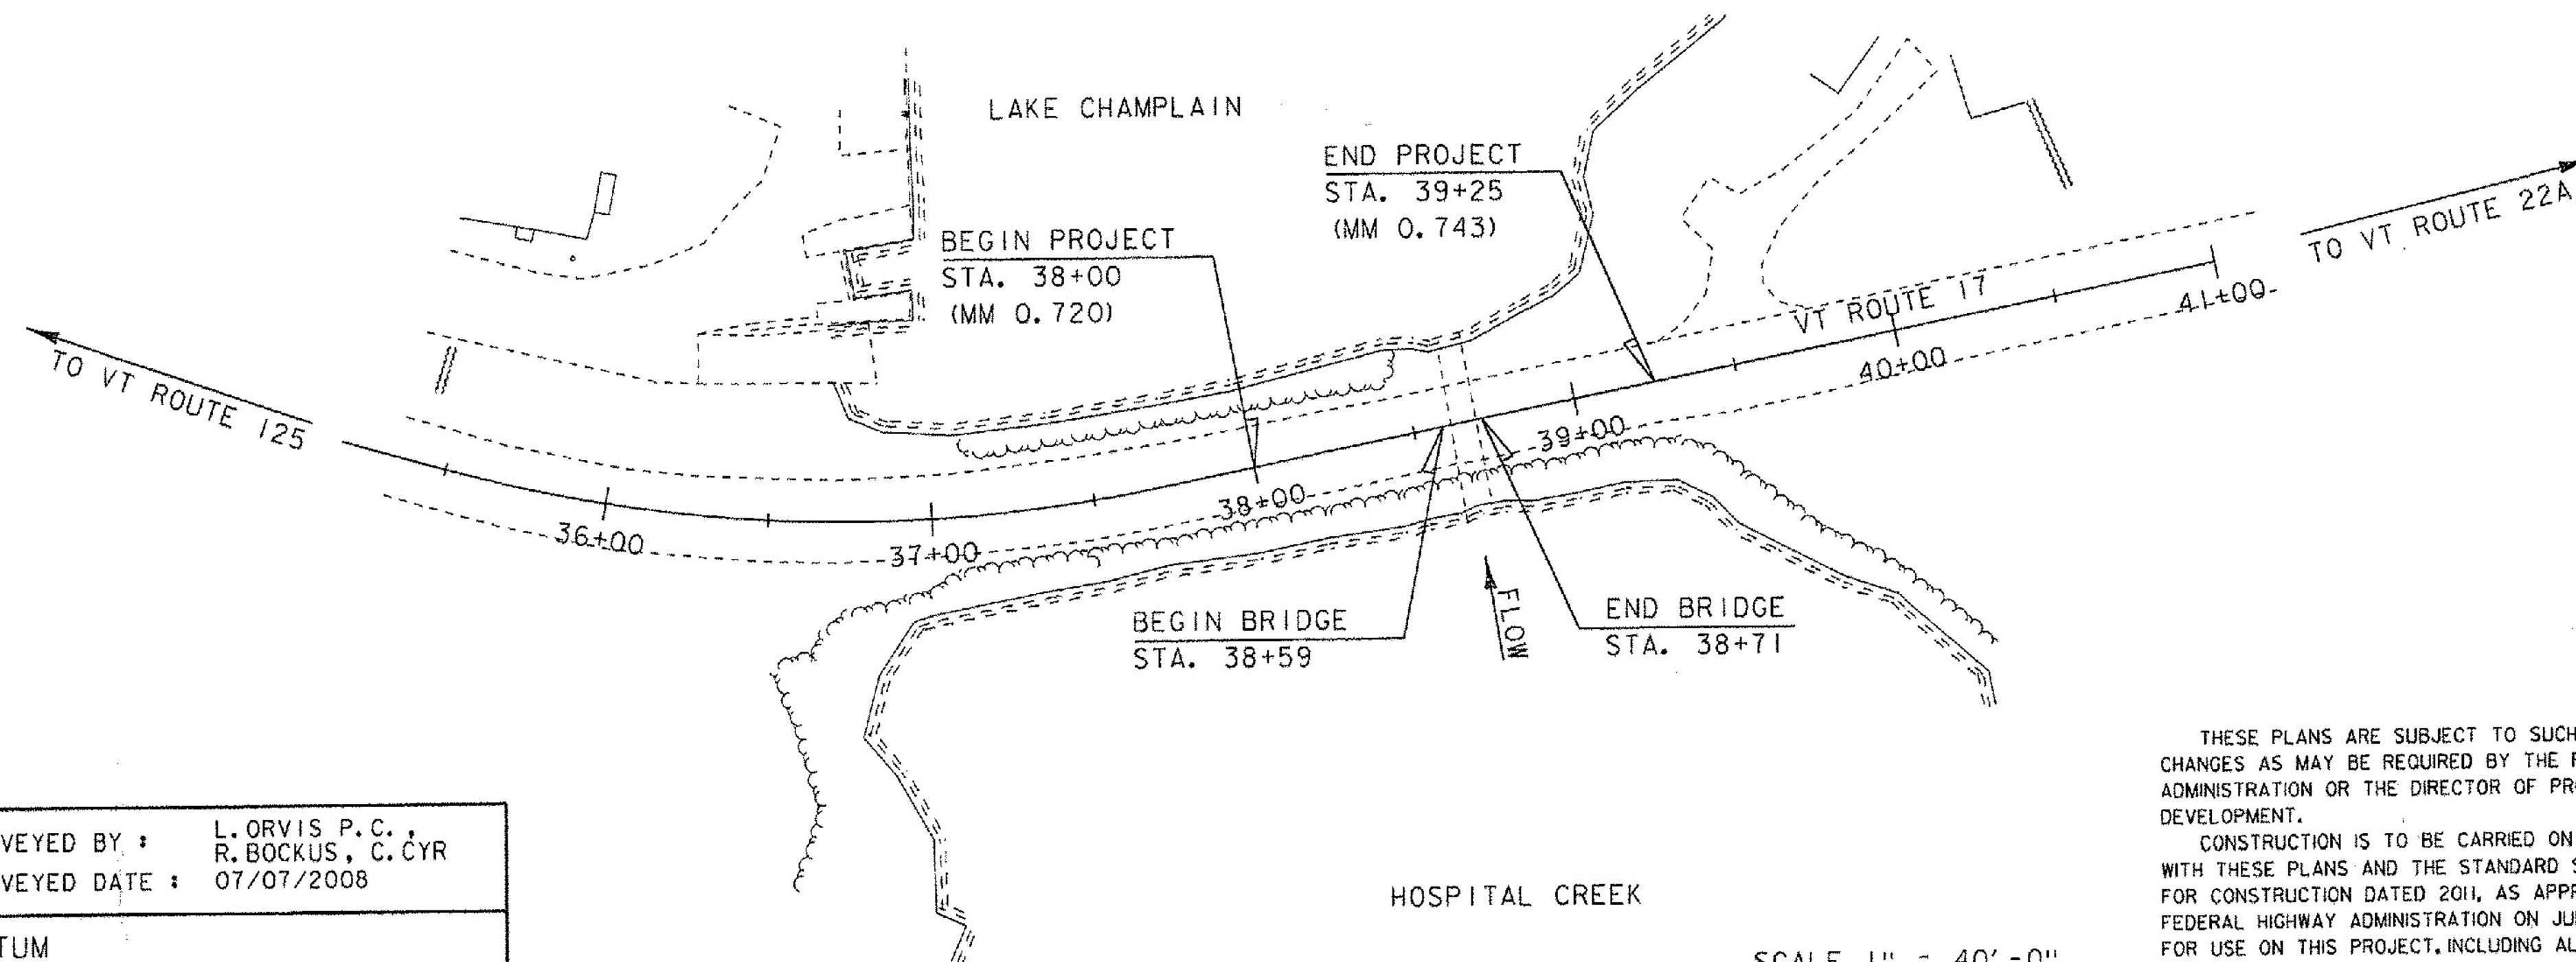

QUALITY ASSURANCE PROGRAM: LEVEL 2

CONVENTIONAL SYMBOLS	
COUNTY LINE	
TOWN LINE	
LIMITS OF ACCESS	
POINT OF ACCESS	
FENCE LINE	
STONE WALL	
TRAVELED WAY	
GUARD RAIL	
RAILROAD	
SURVEY LINE	
CULVERT	
POWER POLE	
TELEPHONE POLE	
TREES	
CONTROL OF ACCESS	
PROPERTY LINE	
R.O.W. TAKING LINE	
SLOPE RIGHTS	
TOP OF CUT	
TOE OF SLOPE	

SURVEYED BY : L. ORVIS P.C., R. BOCKUS, C. CYR
 SURVEYED DATE : 07/07/2008

DATUM
 VERTICAL NAVD 88
 HORIZONTAL NAD 83 (07) CONUS

THESE PLANS ARE SUBJECT TO SUCH ENGINEERING CHANGES AS MAY BE REQUIRED BY THE FEDERAL HIGHWAY ADMINISTRATION OR THE DIRECTOR OF PROGRAM DEVELOPMENT.
 CONSTRUCTION IS TO BE CARRIED ON IN ACCORDANCE WITH THESE PLANS AND THE STANDARD SPECIFICATIONS FOR CONSTRUCTION DATED 2014, AS APPROVED BY THE FEDERAL HIGHWAY ADMINISTRATION ON JULY 20, 2011 FOR USE ON THIS PROJECT, INCLUDING ALL SUBSEQUENT REVISIONS AND SUCH REVISED SPECIFICATIONS AND SPECIAL PROVISIONS AS ARE INCORPORATED IN THESE PLANS.

DIRECTOR OF OPERATIONS
 APPROVED: *[Signature]* DATE 3-11-13
 PROJECT MANAGER: KRISTIN HIGGINS
 PROJECT NAME: ADDISON
 PROJECT NUMBER: STP CULV (14)
 SHEET 1 OF 28 SHEETS

SCALE 1" = 40' - 0"