

COLD PLANING, BITUMINOUS PAVEMENT

STA 37+50 - 38+00  
STA 39+25 - 39+75

4" WHITE LINE  
STA 37+50 - 39+75 LT & RT

4" YELLOW LINE (DOUBLE)  
STA 37+50 - 39+75  
34+85± - 42+45±

CONSTRUCT FIVE FOOT APRON (3 IN)

STA 39+25 - 39+75 LT

TRAFFIC SIGNS, TYPE A


STA 39+00 LT  
STA 38+80 RT

GEOTEXTILE FOR FILTER CURTAIN

STA 38+45 - 38+85 RT

CURVE DATA

DELTA = 27° 11' 00"  
D = 12° 21' 22"  
R = 463.71'  
T = 112.11'  
L = 220.00'  
E = 13.36'

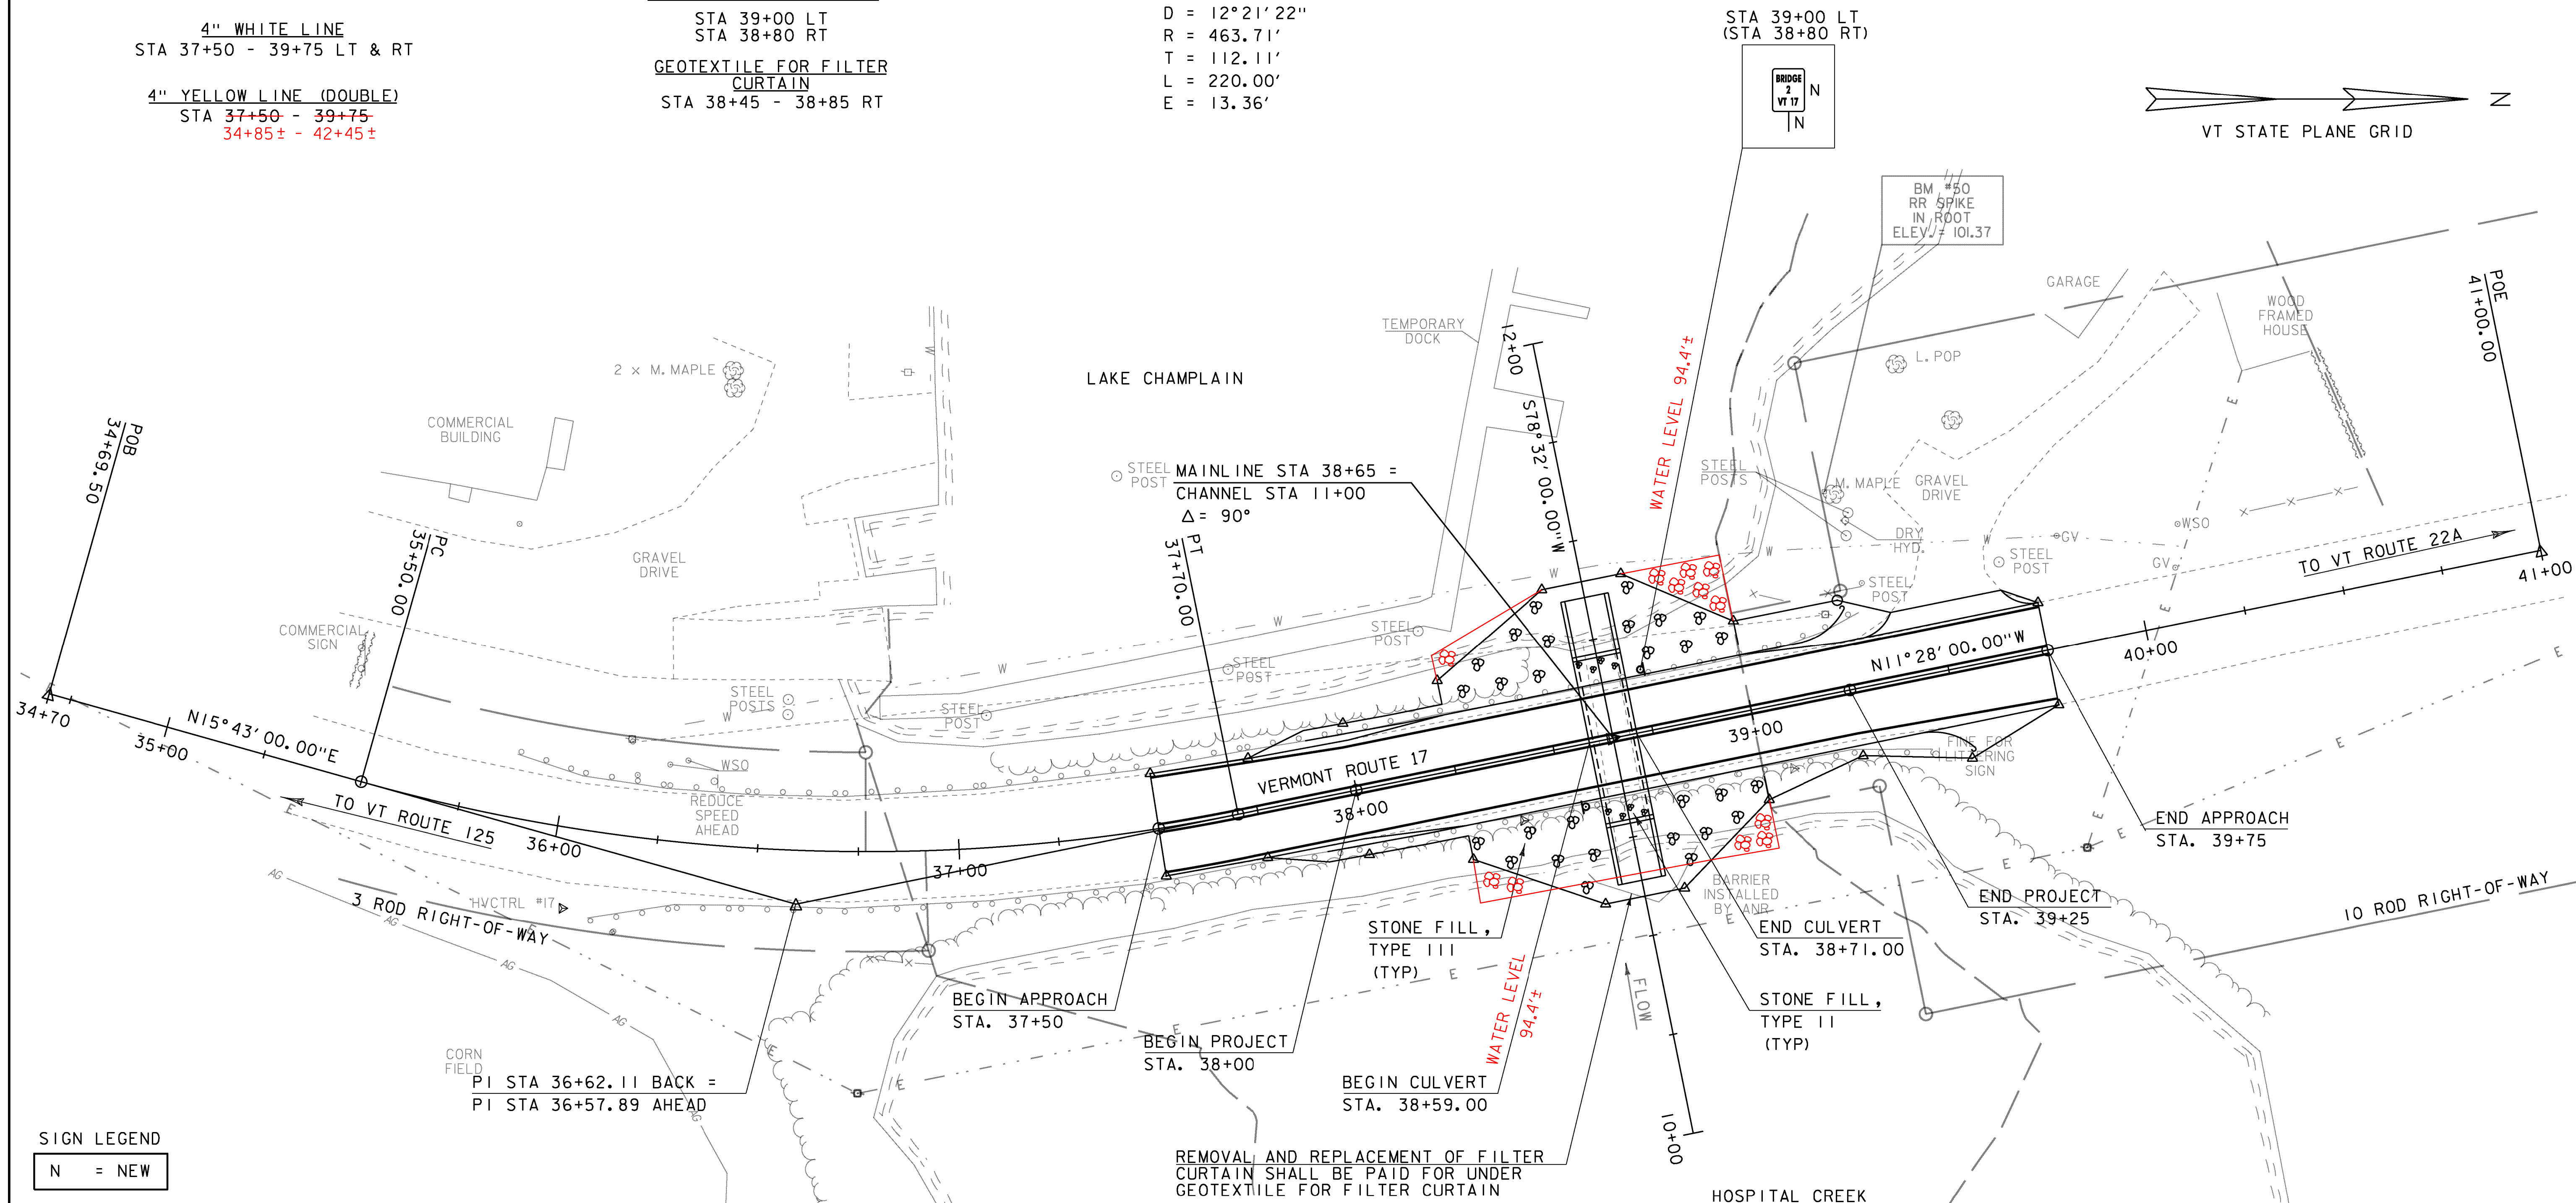

SIGN LEGEND

N = NEW

MILEMARKER, STATION, OR SIGN NUMBER	SIGN LEGEND	SIGN DIMENSIONS		NEW SIGN "A"	EXIST POST RELIANCE	NO. OF POSTS	NEW SIGN POSTS SQUARE STEEL (in)				REMARKS	SIGN DETAIL			
		WIDTH (in)	HEIGHT (in)				1.75	2.0	2.5	ANCHOR		STUB	DETAIL ON SHEET NUMBER	STD. SHEET NUMBER	
															1.88
38+80.00 RT	BRIDGE 2 VT 17	6	8	0.33		1	8				X		VD-701	E-134	
39+00.00 LT	BRIDGE 2 VT 17	6	8	0.33		1	8				X		VD-701	E-134	
							FT	FT	FT	EA					
							16								
FINAL POST LENGTHS ARE TO BE DETERMINED IN THE FIELD. POST SIZES ARE COMPUTED BASED ON INFORMATION FURNISHED ON THE STANDARD SHEETS AND THE VTRANS "SIGN POST DESIGN GUIDELINE."															
<b>TOTALS</b>				SF					FT						
				0.66					16						
												SHS = STANDARD HIGHWAY SIGNS (MUTCD)			

LAYOUT SHEET

SCALE 1" = 20' - 0"

20 0 20

NOTE:  
ADJUST NEW EDGE LINES TO MATCH EXISTING EDGE LINES AT BEGIN/END APPROACH

PROJECT NAME: ADDISON  
PROJECT NUMBER: STP CULV(14)

FILE NAME: s08b062bdr.dgn  
PROJECT LEADER: K. HIGGINS  
DESIGNED BY: J. SALVATORI  
LAYOUT SHEET

PLOT DATE: 09-MAR-2013  
DRAWN BY: J. SALVATORI  
CHECKED BY: W. LAMMER  
SHEET 8 OF 28