


EXISTING WATER LINE TO REMAIN "IN-PLACE" AND RELOCATED ONLY IF LINE IS DISTURBED DURING CONSTRUCTION PER AGREEMENT WITH UTILITY OWNER. ALL COSTS ASSOCIATED TO RELOCATE THE LINE SHALL BE THE SOLE EXPENSE OF THE UTILITY OWNER

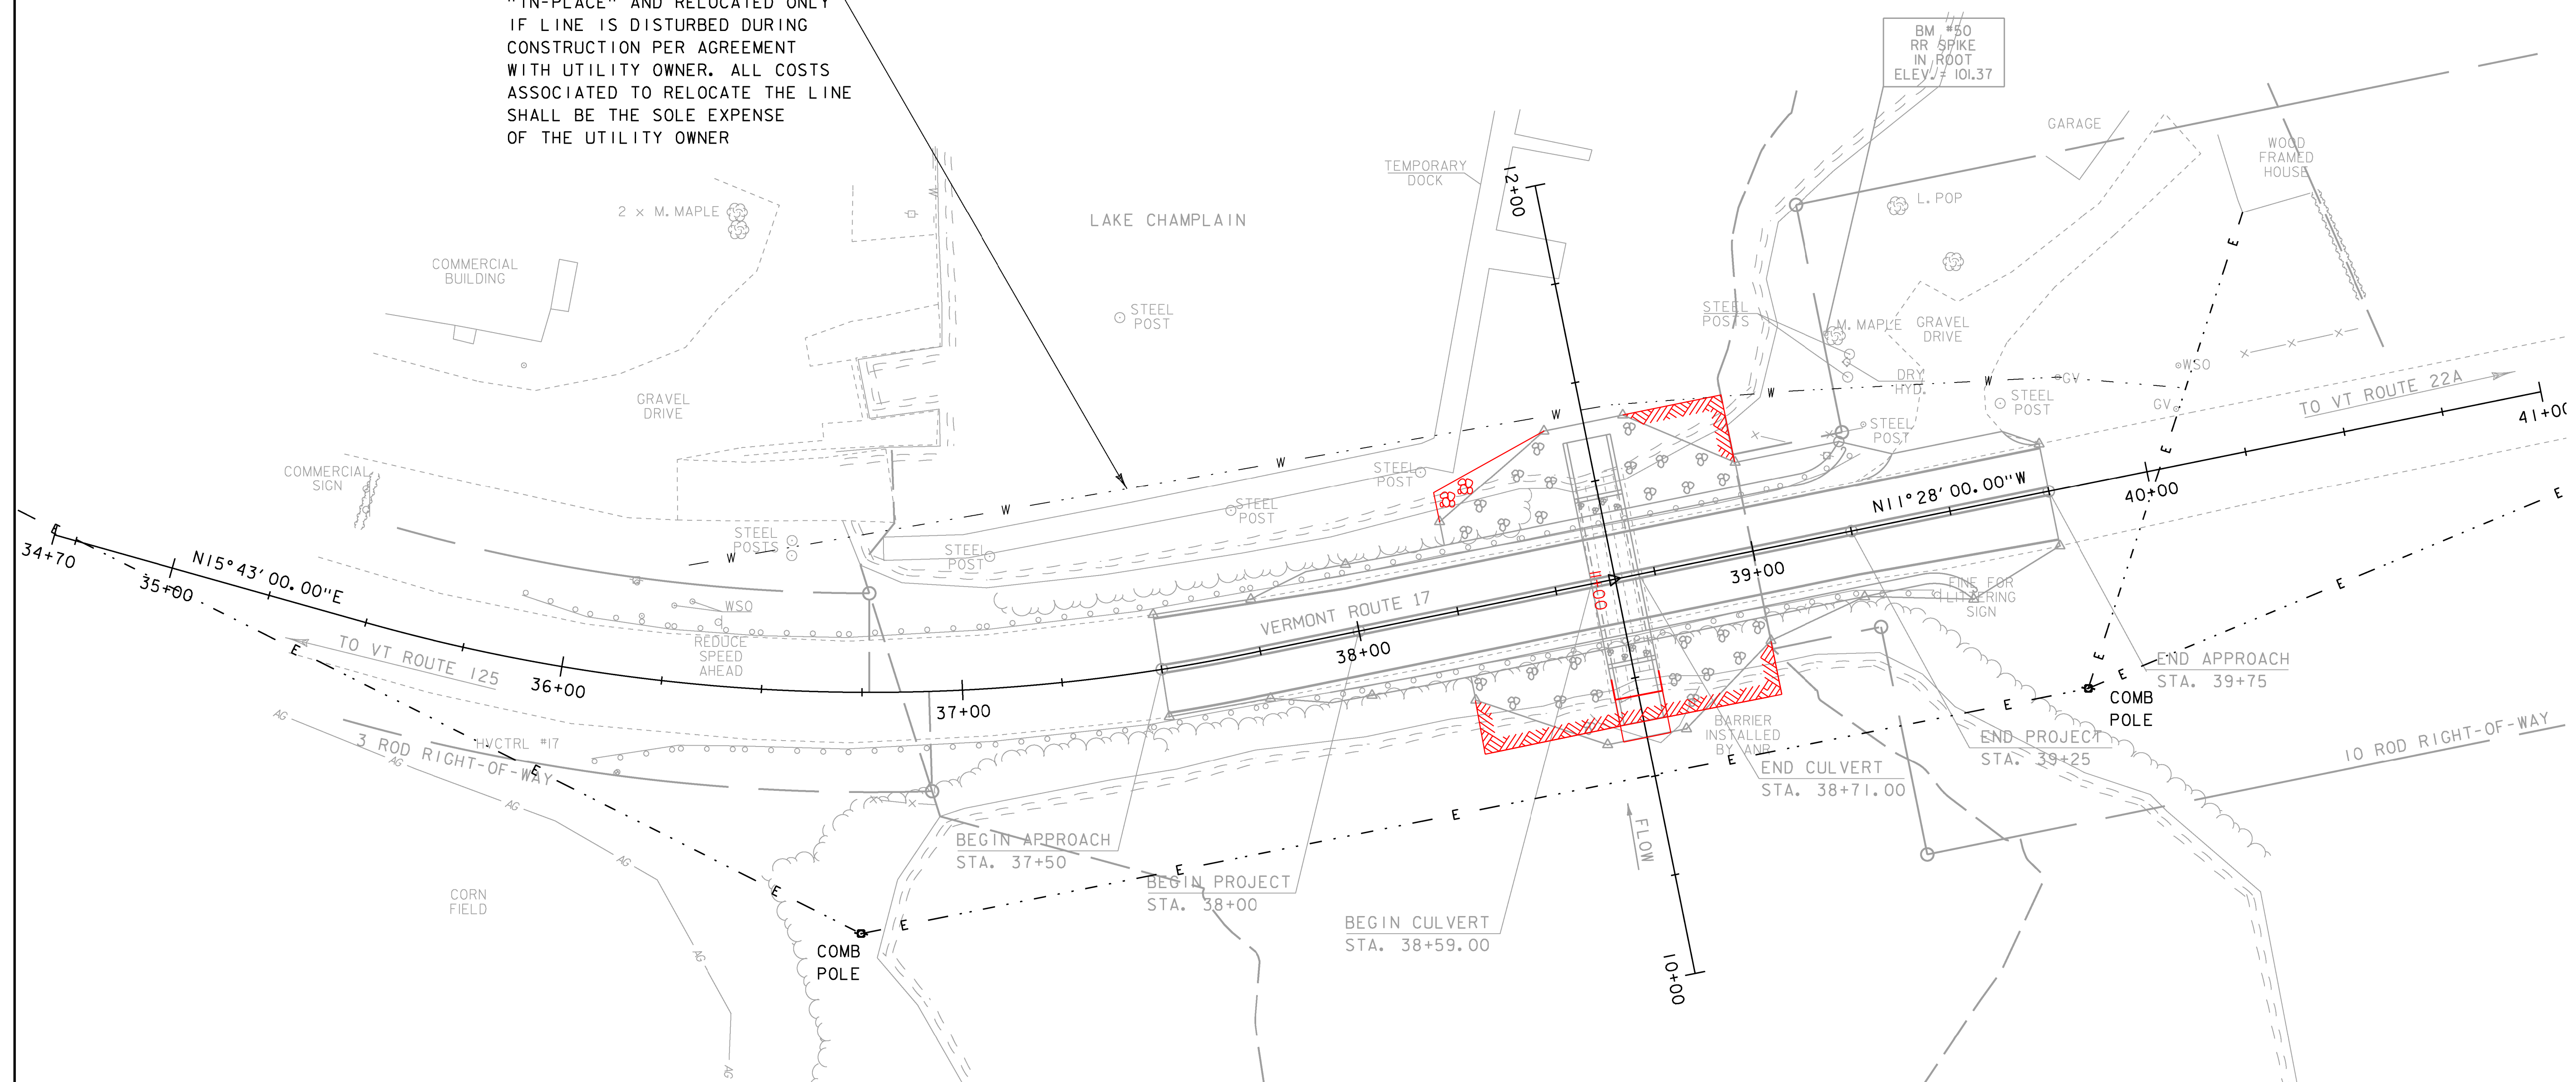

UTILITY LAYOUT SHEET  
SCALE 1" = 20'-0"  
20 0 20

PROJECT NAME: ADDISON	PLOT DATE: 15-MAR-2013
PROJECT NUMBER: STP CULV(14)	DRAWN BY: J. SALVATORI
FILE NAME: s08b062u+11.dgn	CHECKED BY: W. LAMMER
PROJECT LEADER: K. HIGGINS	SHEET 14 OF 28
DESIGNED BY: J. SALVATORI	
UTILITY LAYOUT SHEET	