




37+25

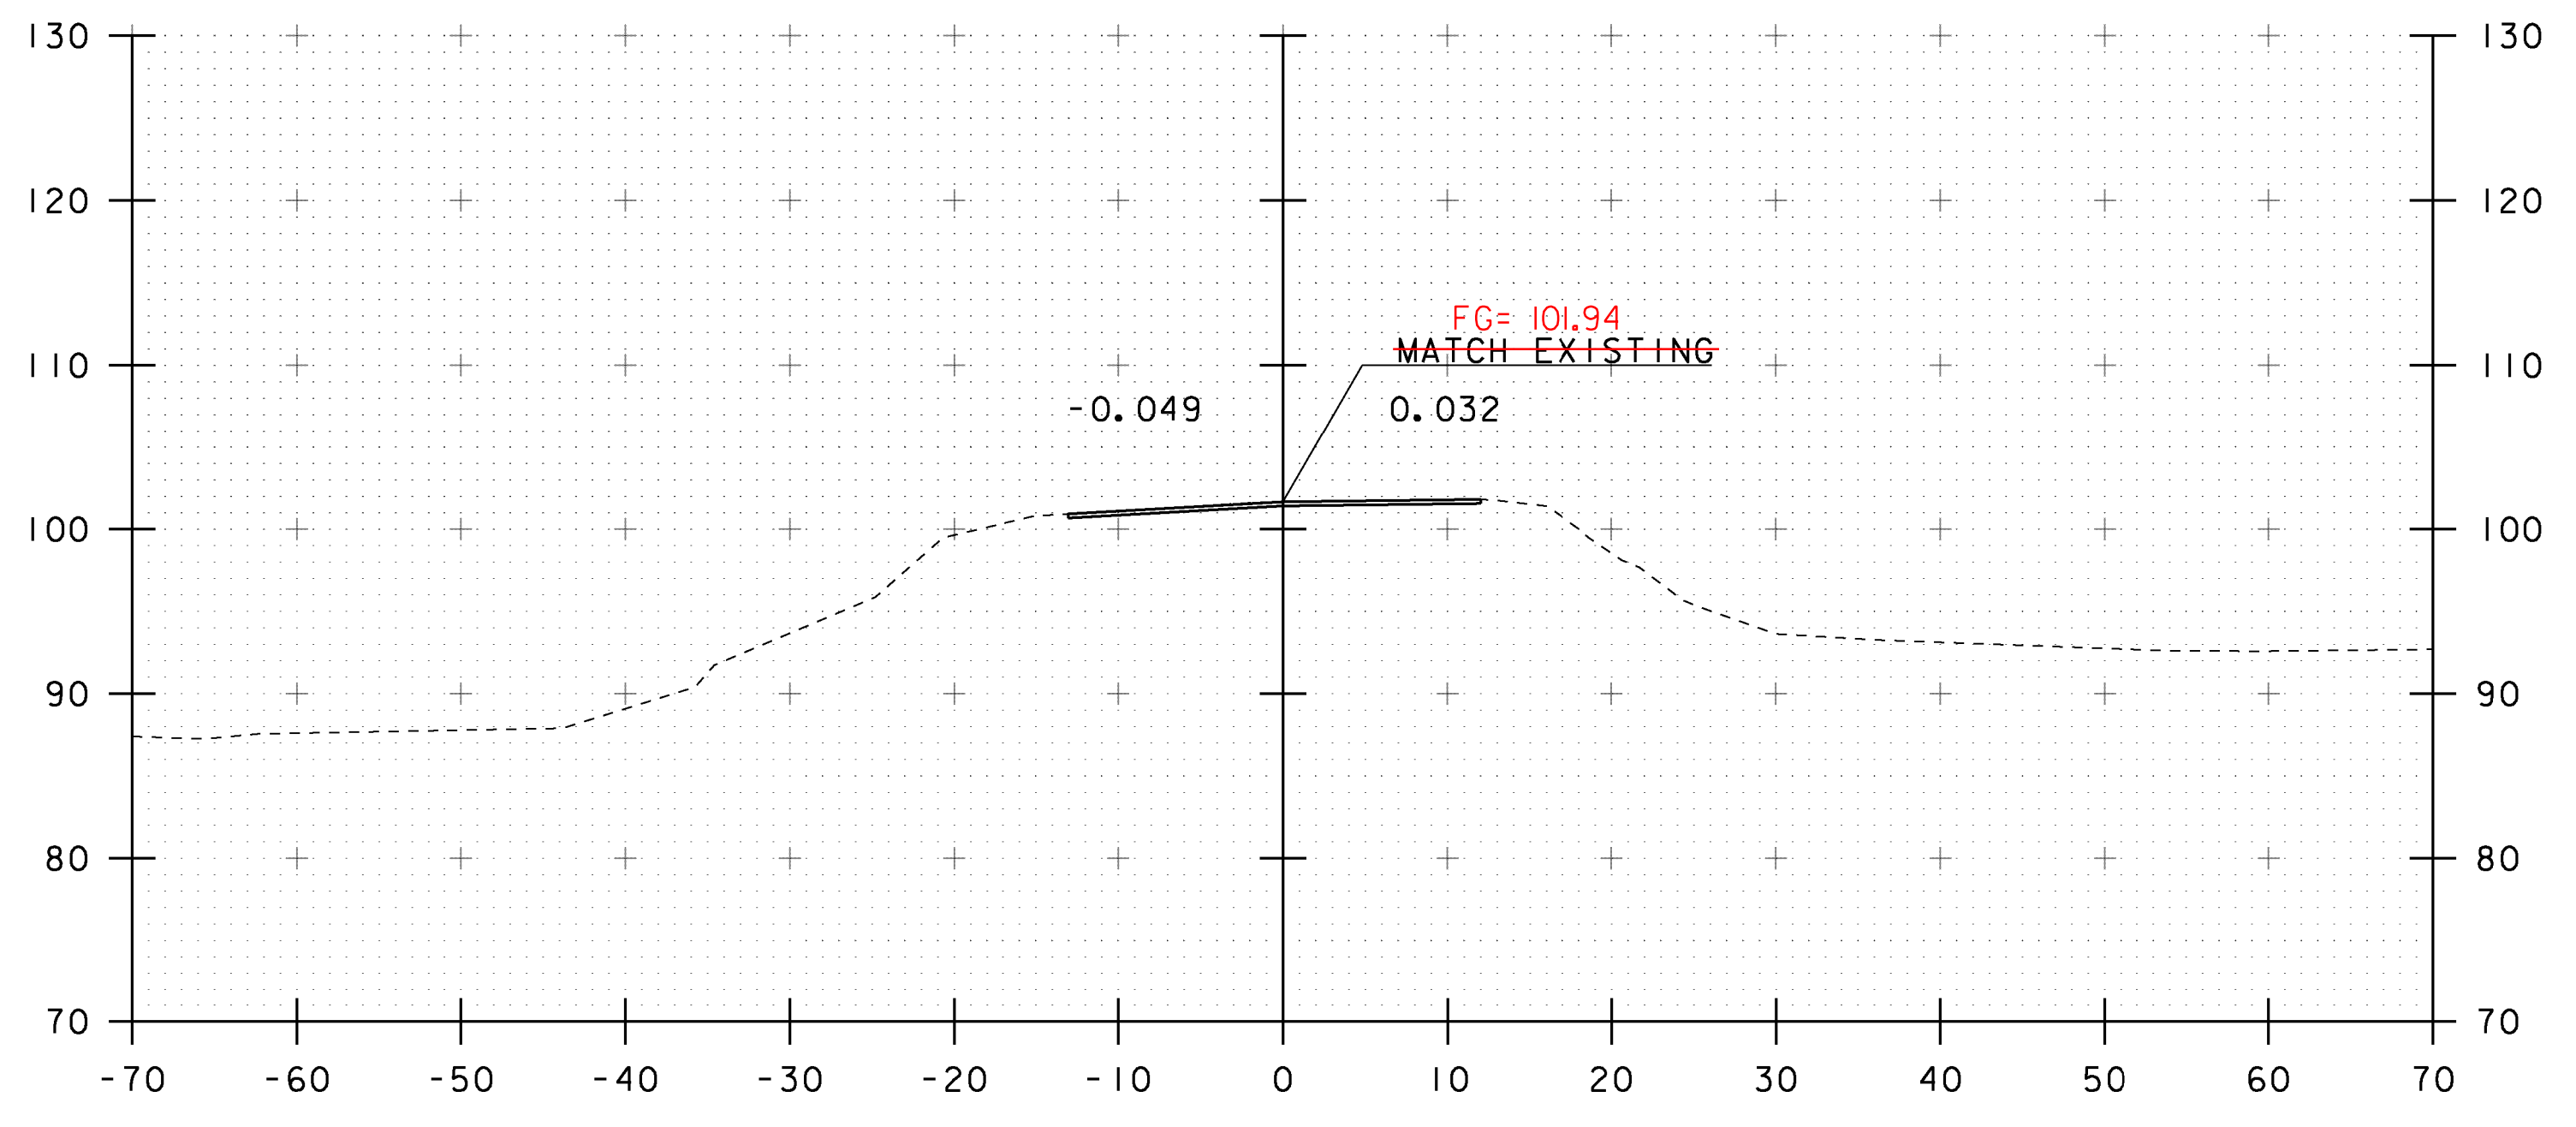

37+75

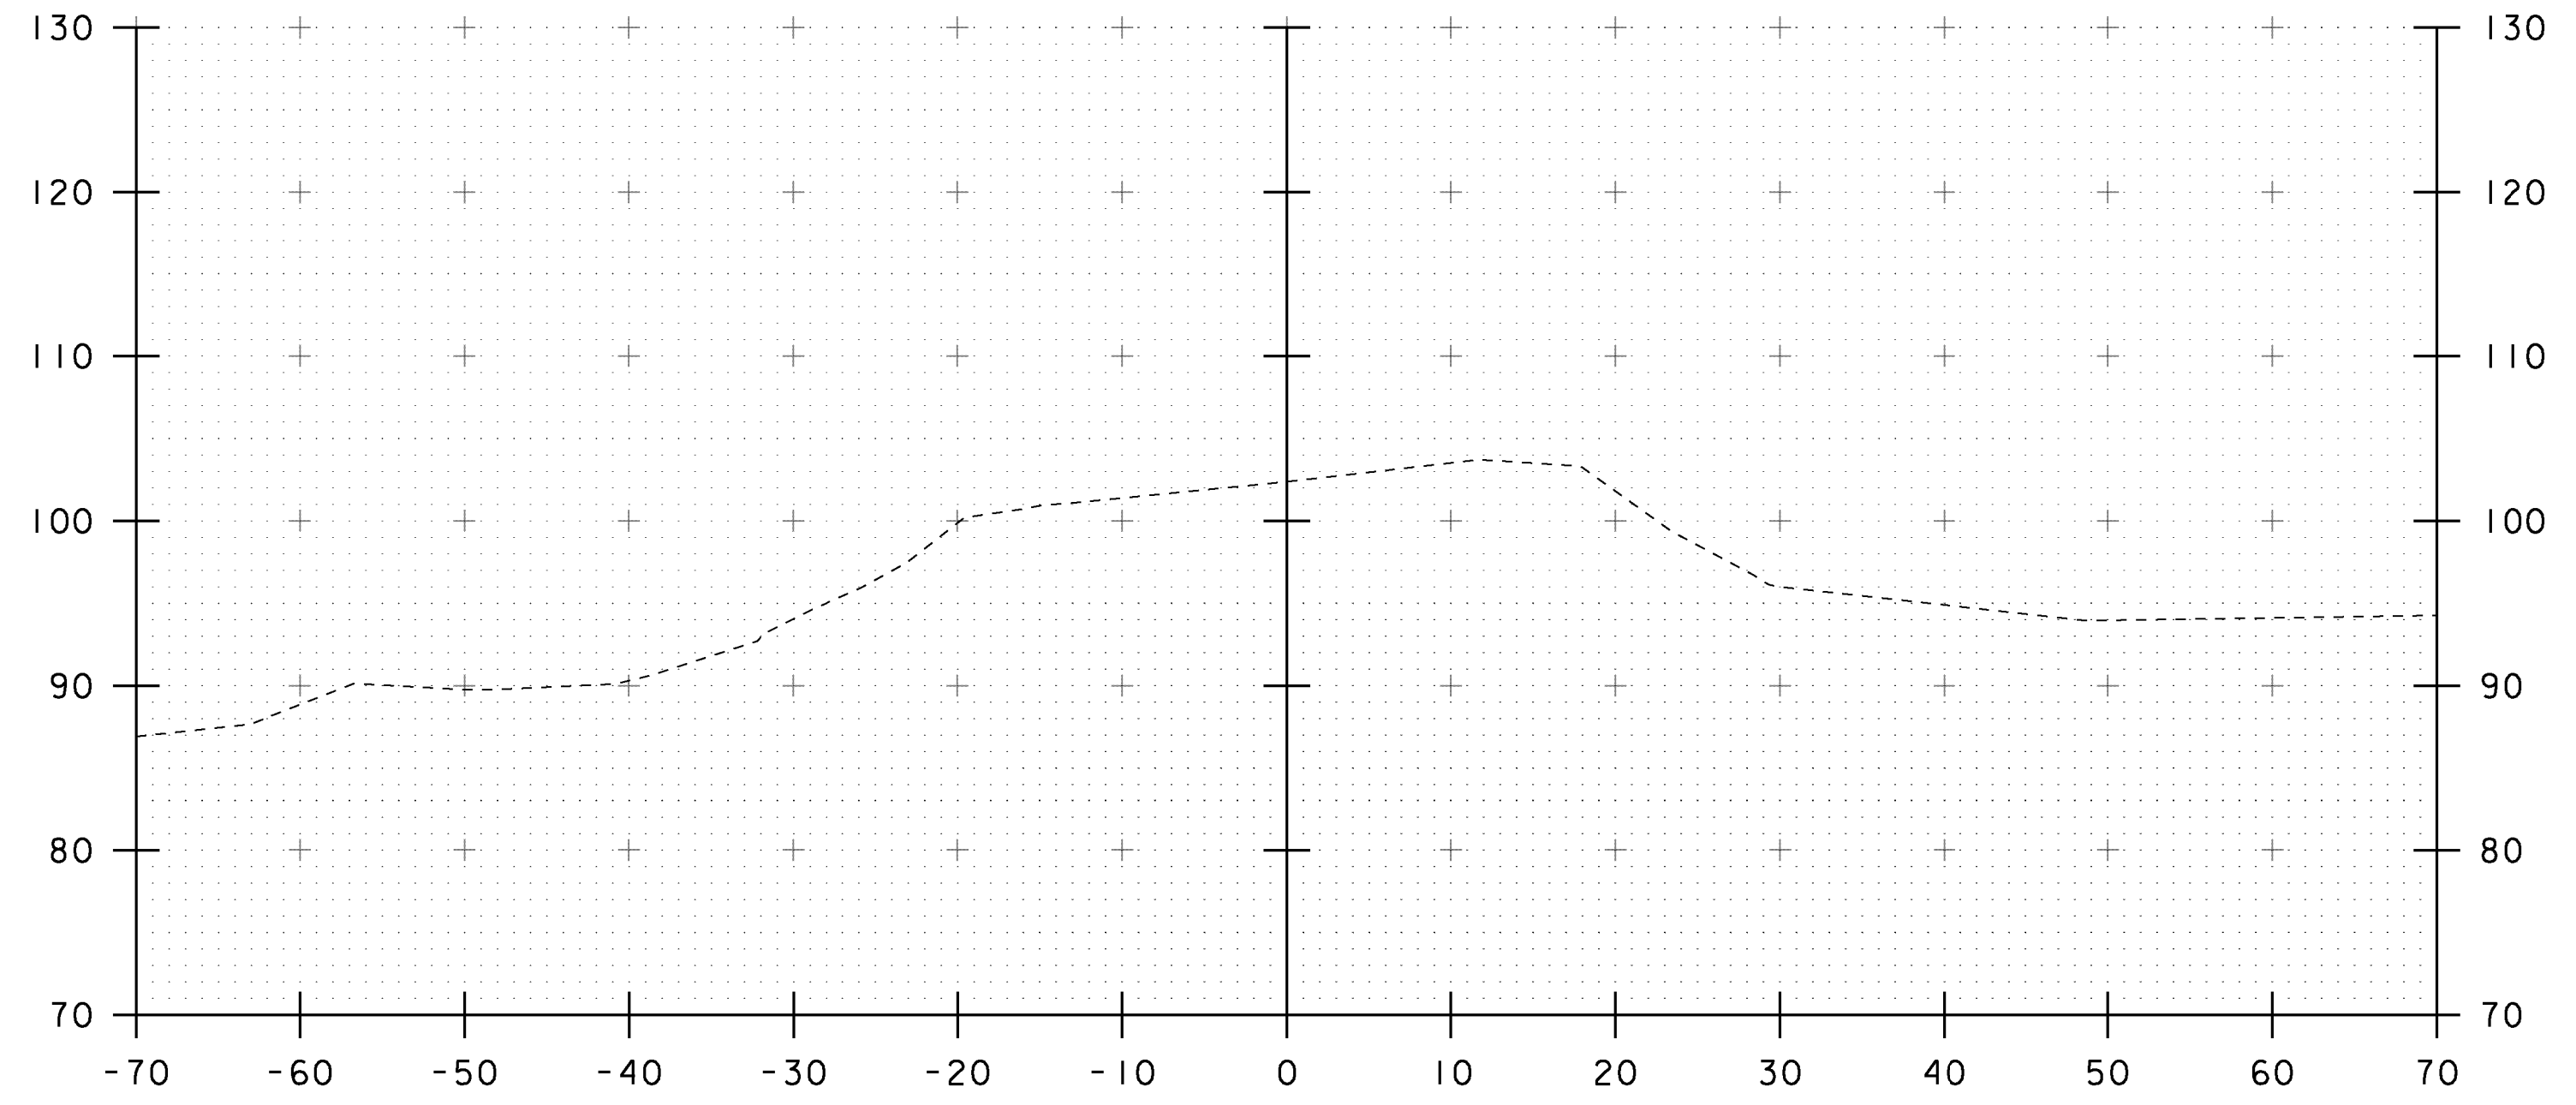

37+00

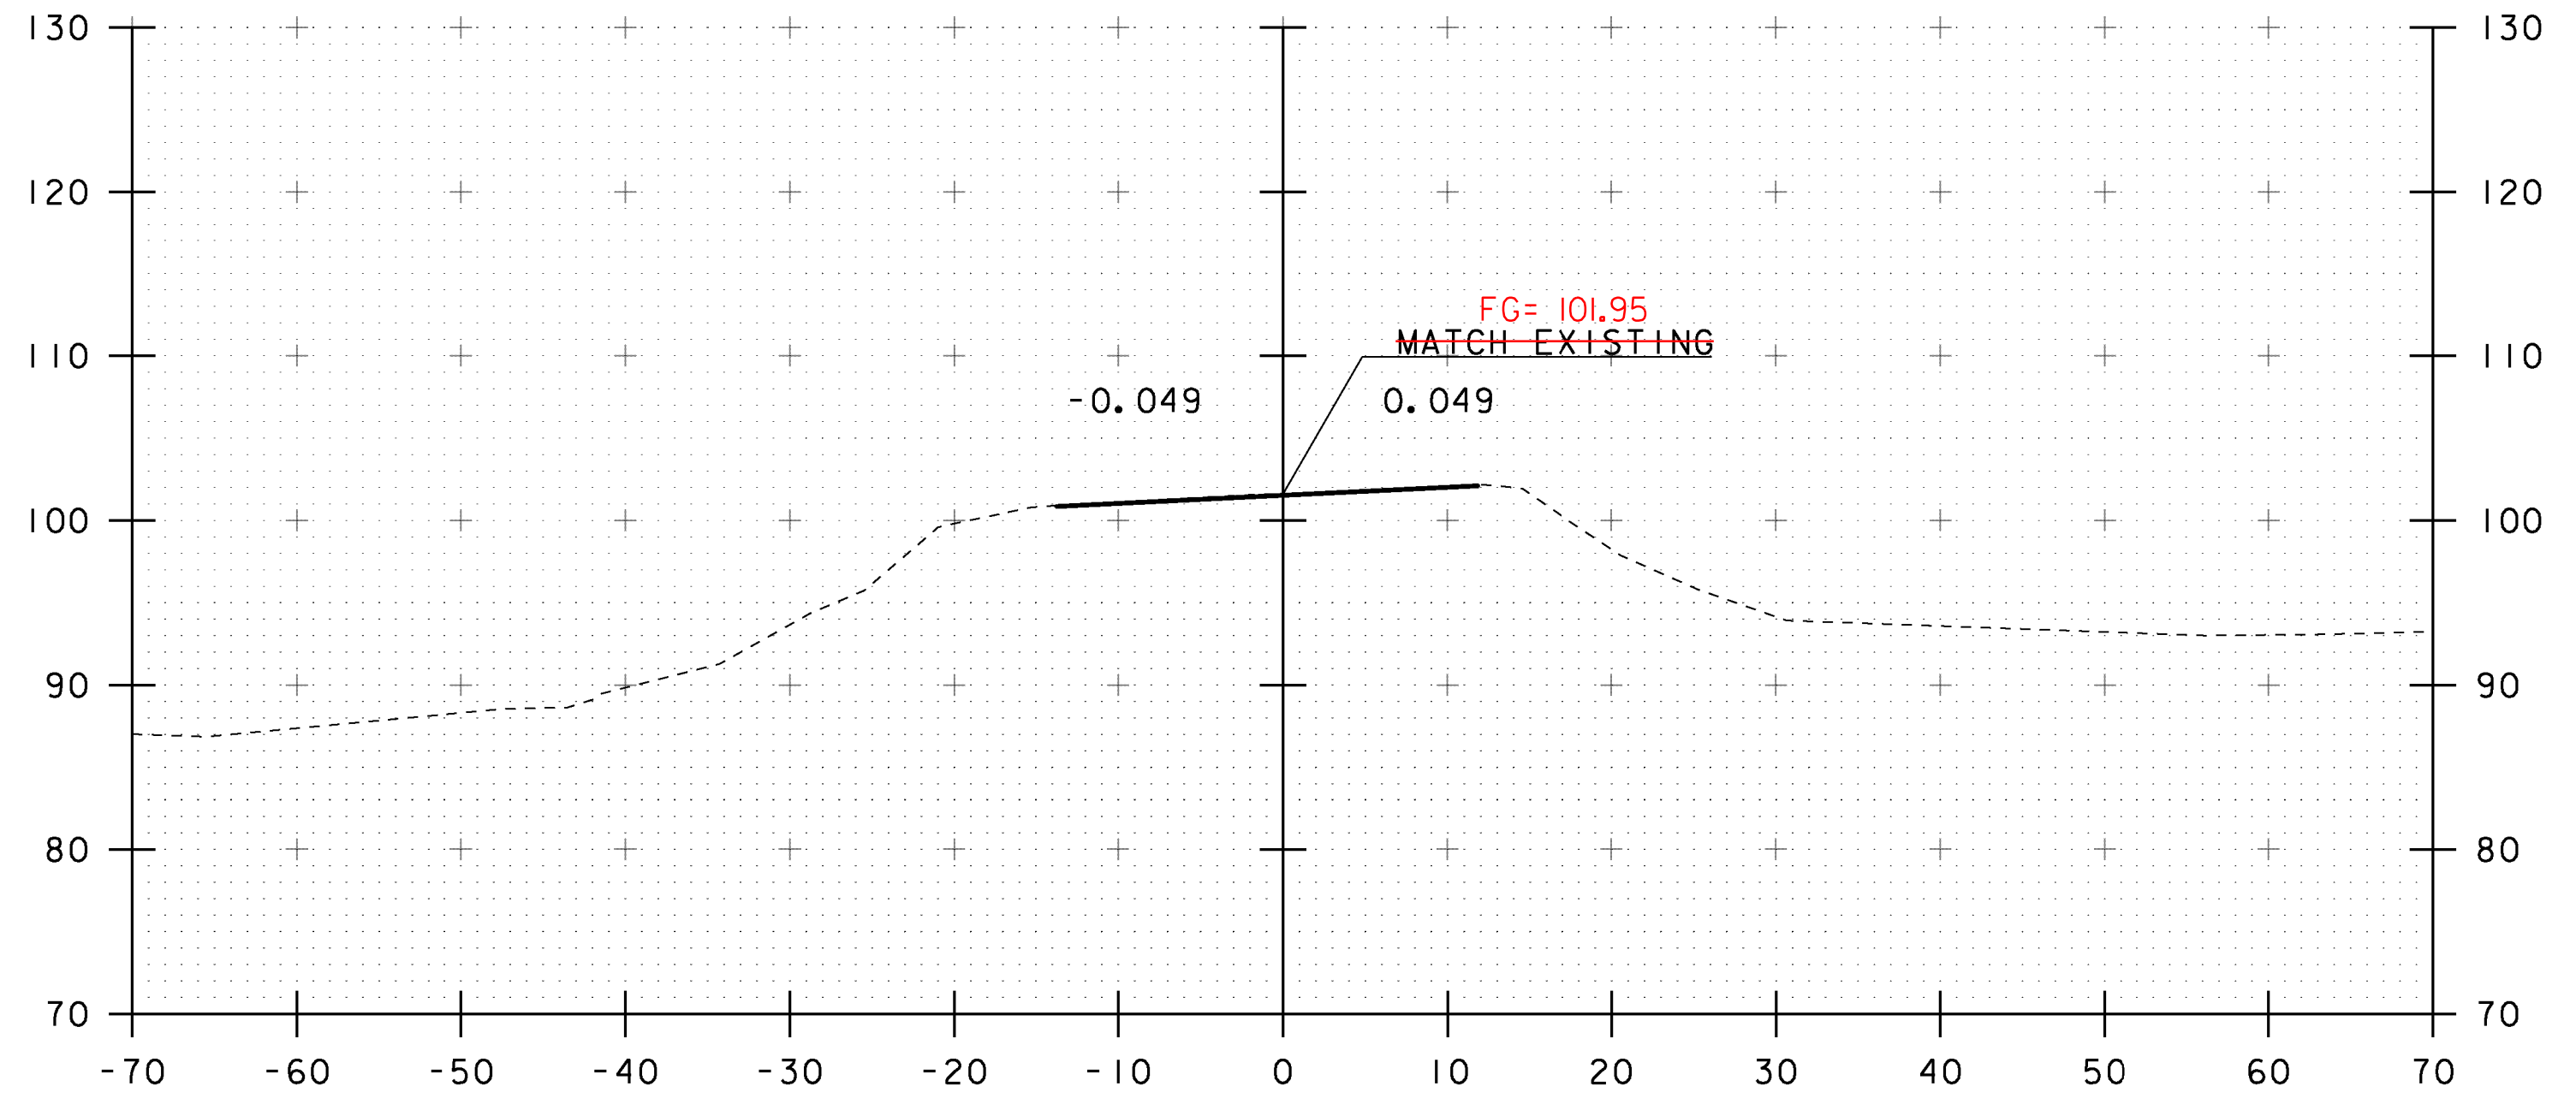

BEGIN APPROACH
37+50

STA. 37+00 TO STA. 37+75

PROJECT NAME: ADDISON	PLOT DATE: 09-MAR-2013
PROJECT NUMBER: STP CULV(14)	DRAWN BY: J. SALVATORI
FILE NAME: s08b062xs.dgn	CHECKED BY: W. LAMMER
PROJECT LEADER: K. HIGGINS	SHEET 20 OF 28
DESIGNED BY: J. SALVATORI	
MAINLINE SECTIONS - 1	